



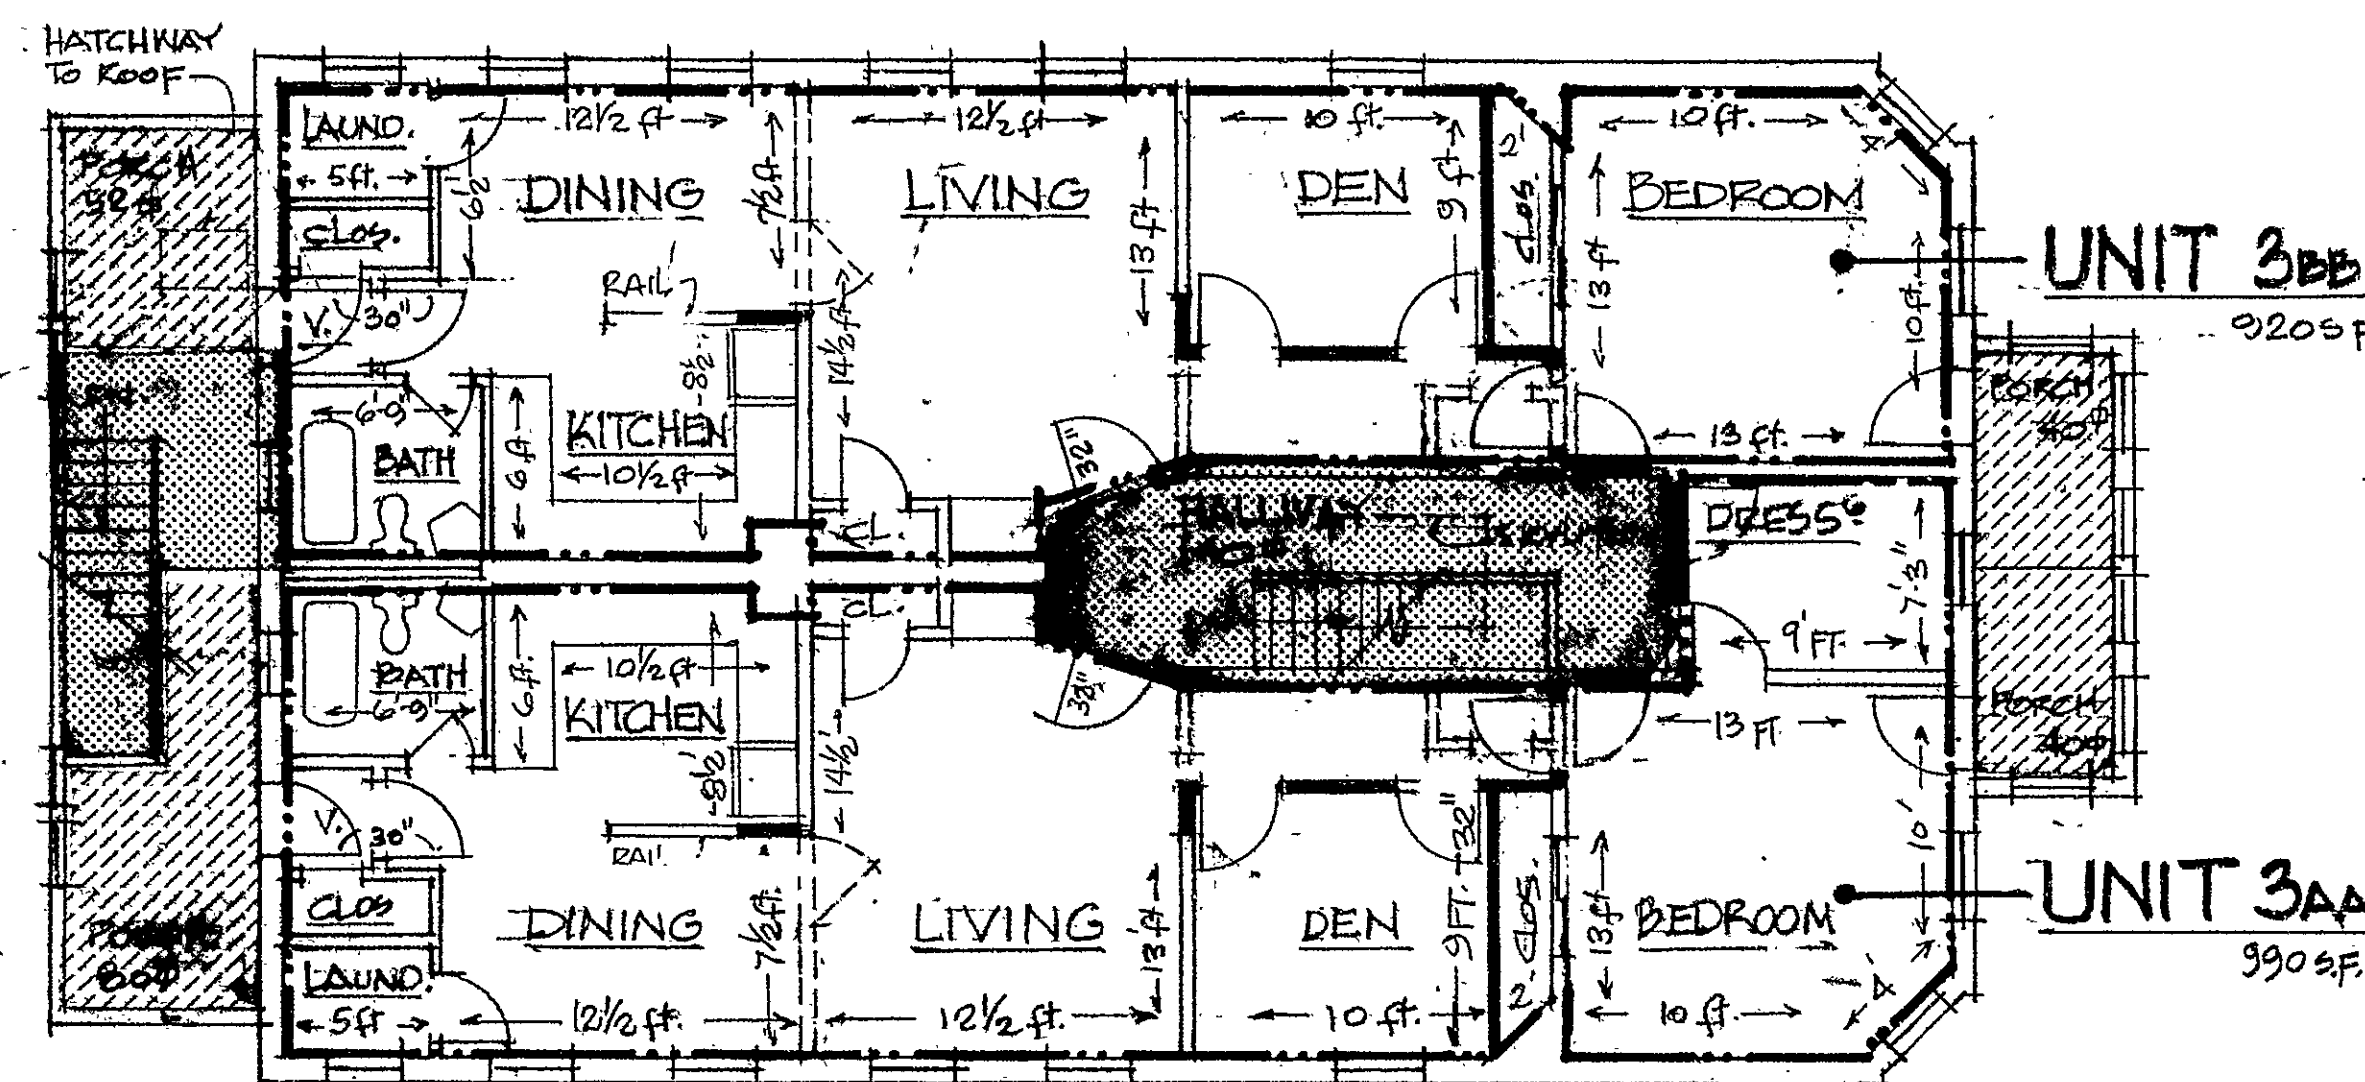


**THIRD FLOOR**

CEILING HEIGHT 9'-0"  
 LOWER BOUNDARY EL 73.19 UPPER BOUNDARY EL 82.19

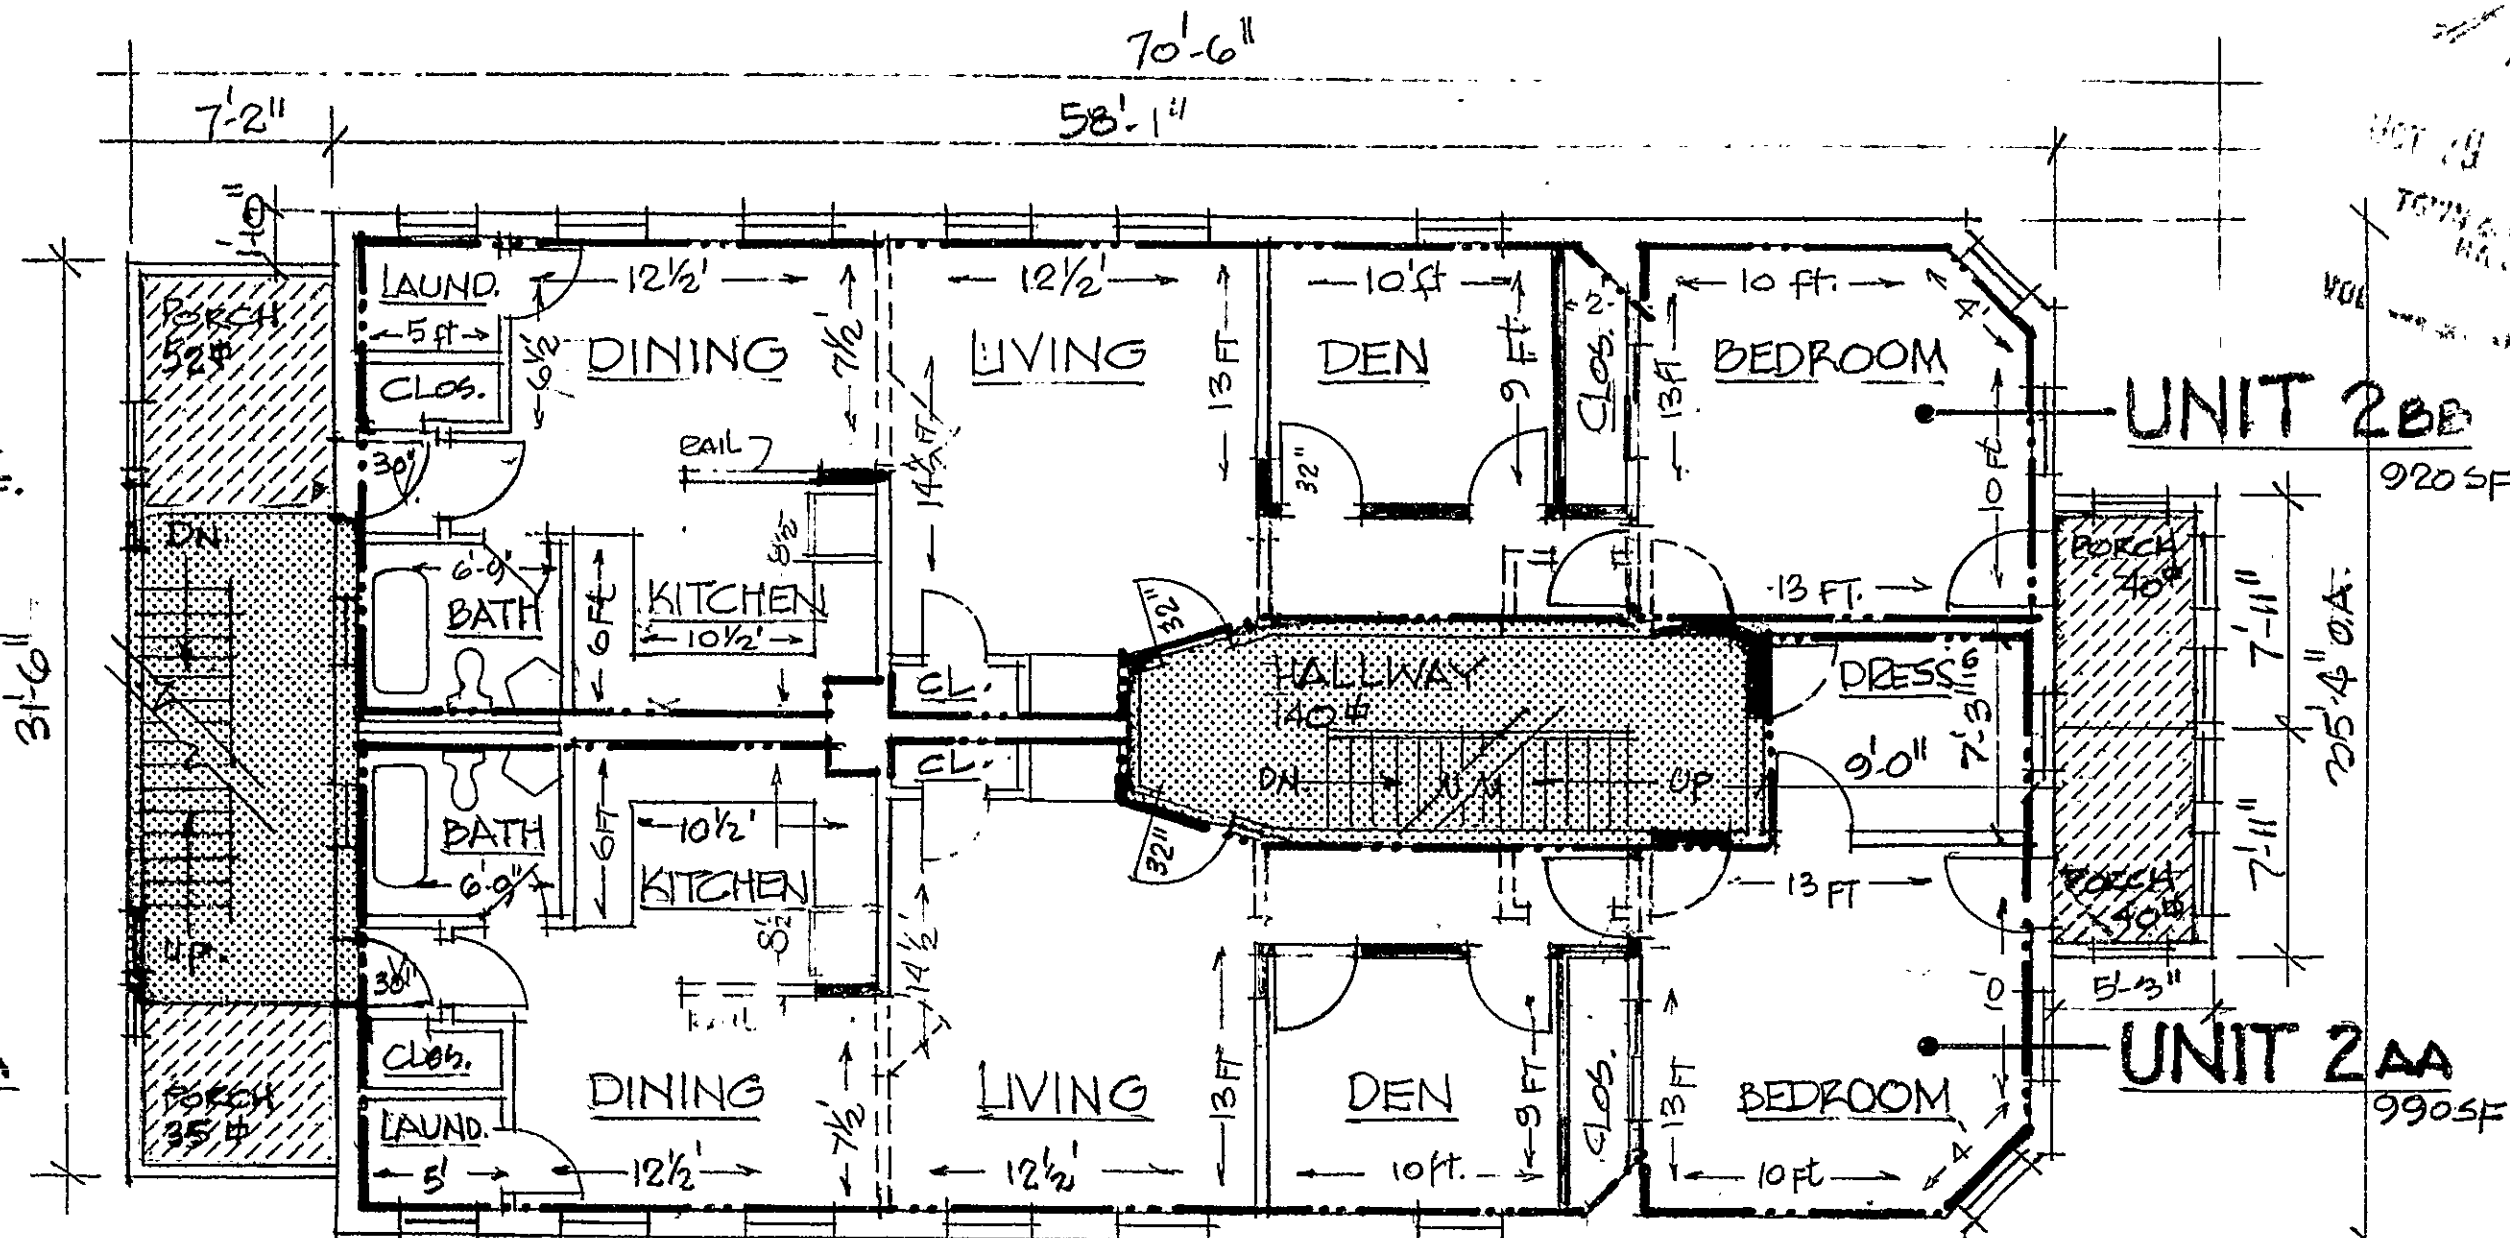


**SECOND FLOOR**

CEILING HEIGHT 9'-0"  
 LOWER BOUNDARY EL 63.19 UPPER BOUNDARY EL 72.19

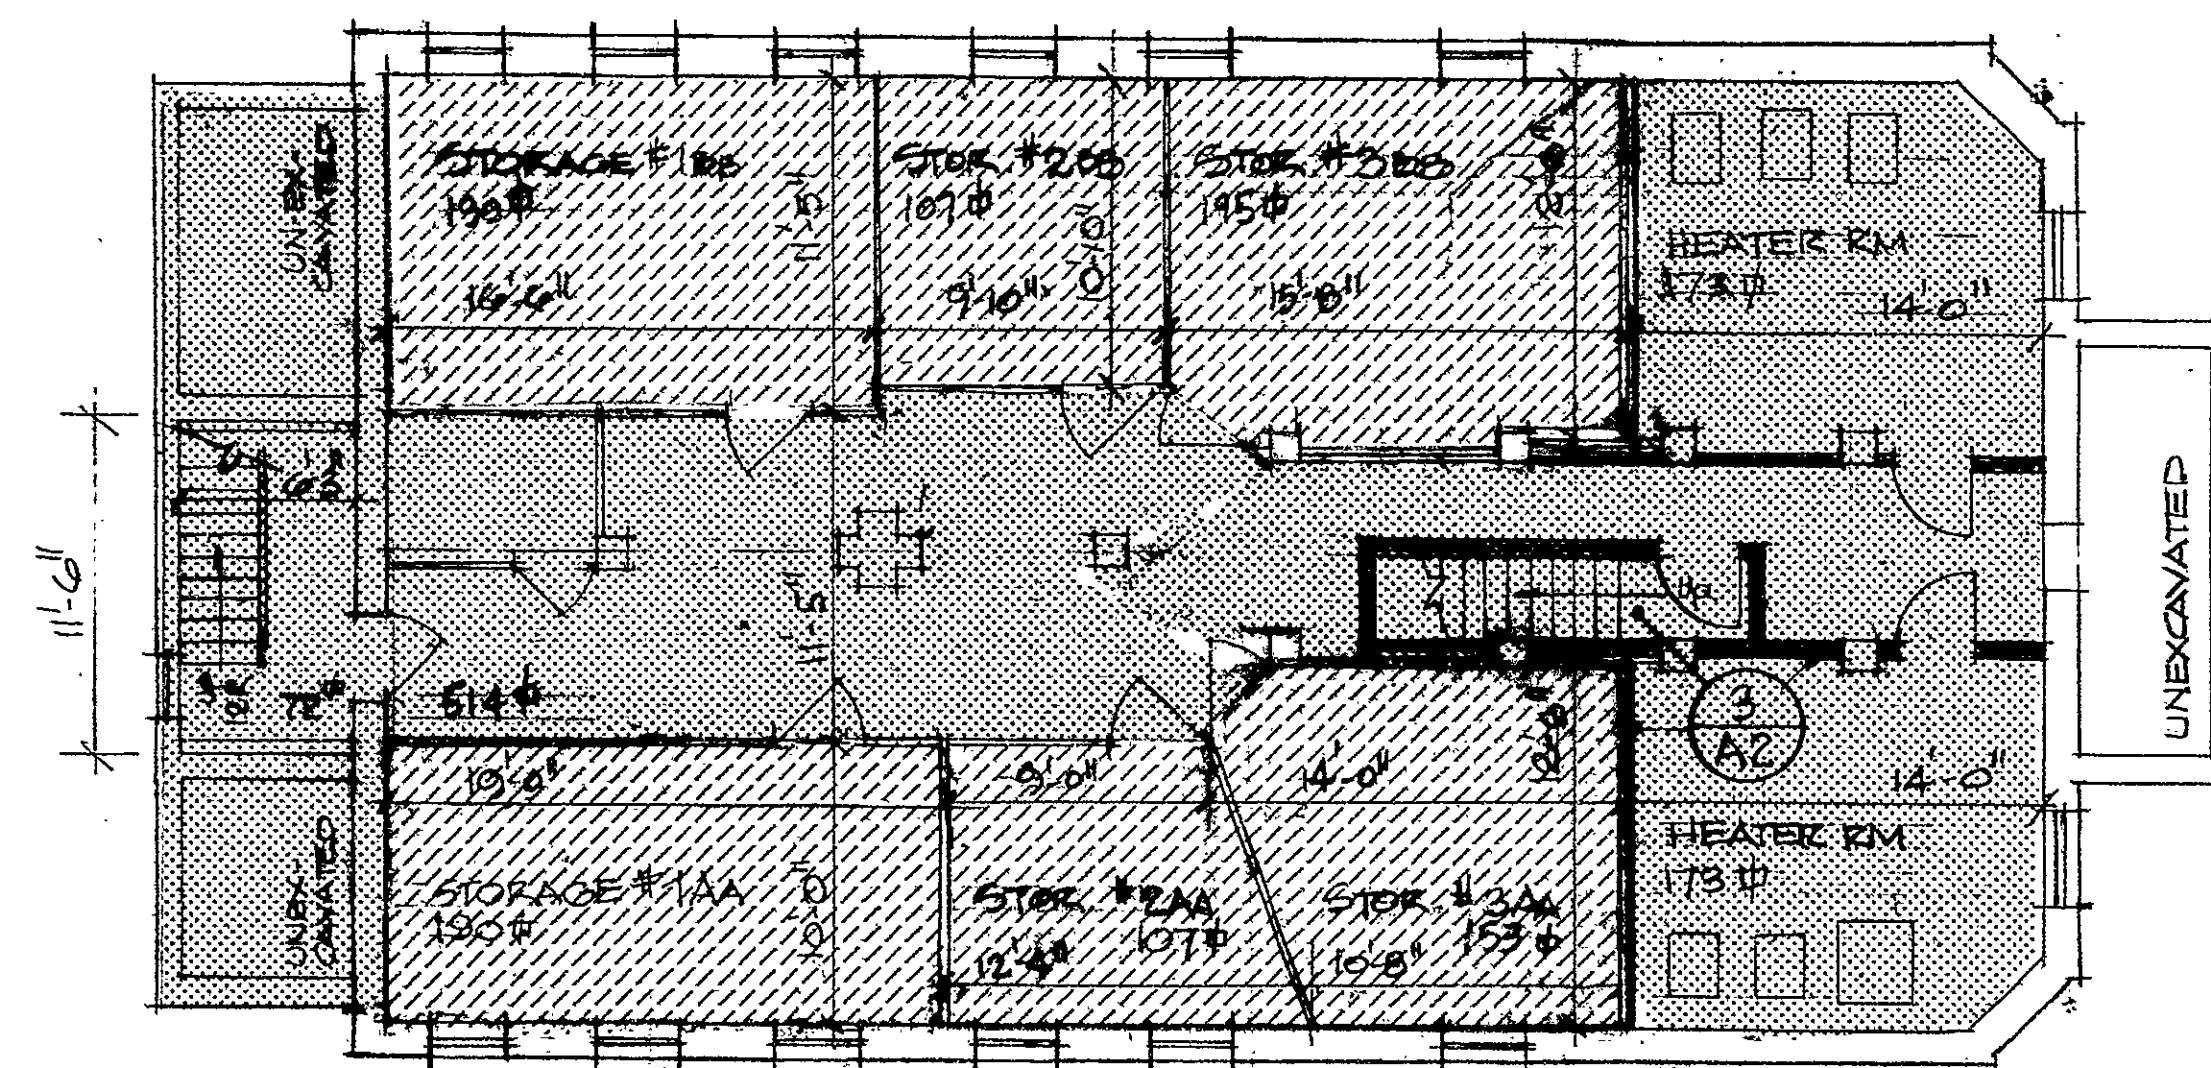


**BASEMENT**

CEILING HEIGHT 6'-10"  
 LOWER BOUNDARY EL 45.56, UPPER BOUNDARY EL 52.40

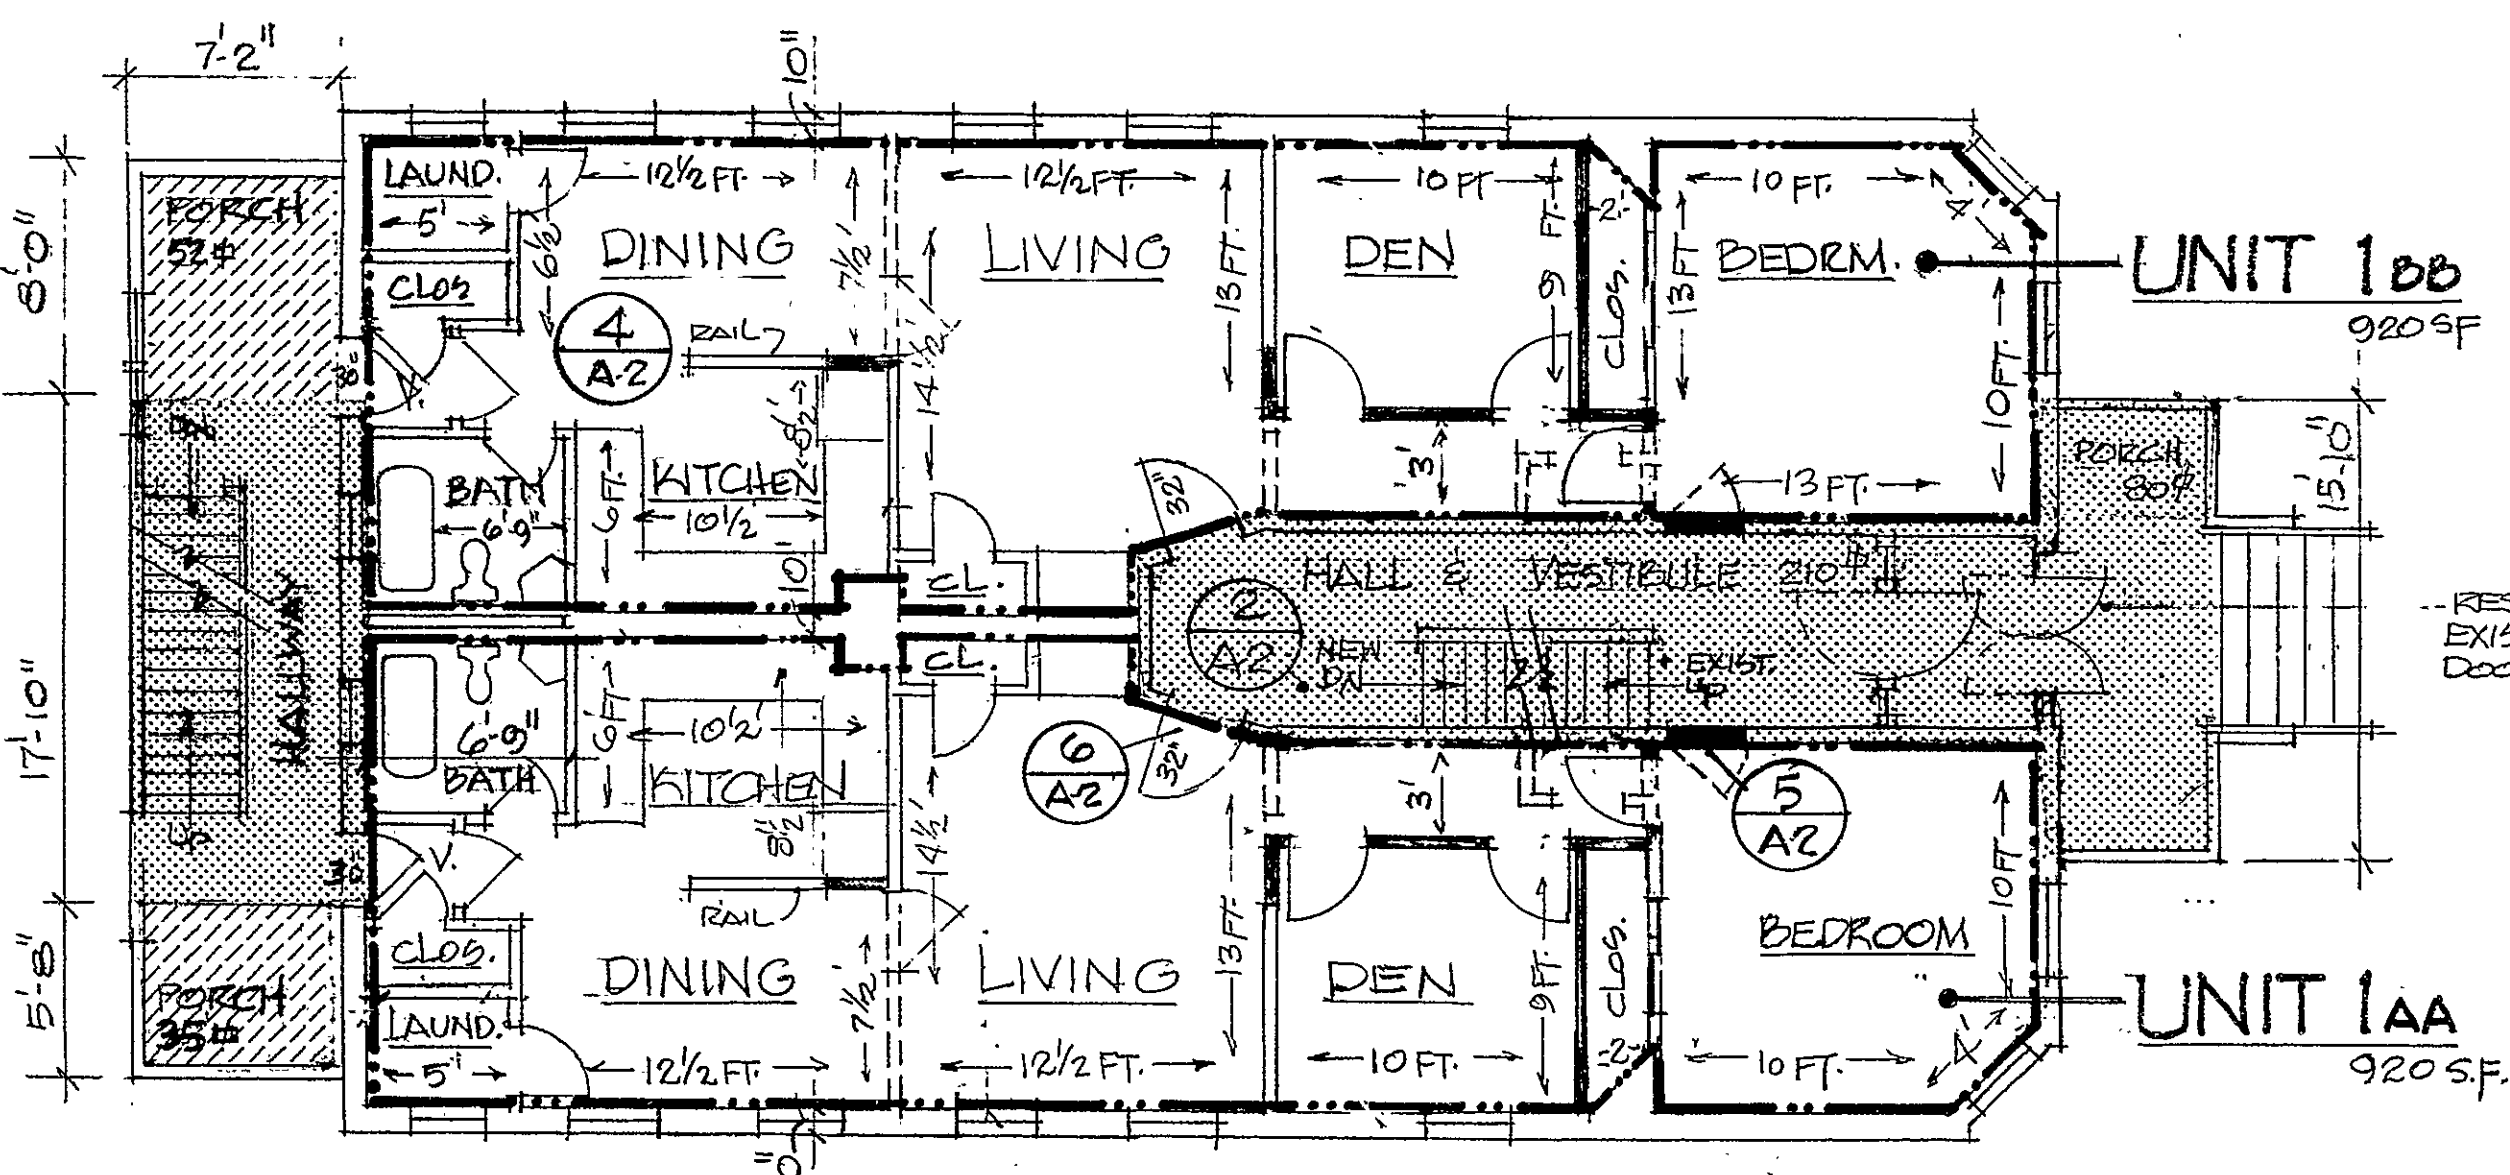

**FIRST FLOOR**

CEILING HEIGHT 9'-0"  
 LOWER BOUNDARY EL 53.19 UPPER BOUNDARY EL 62.19

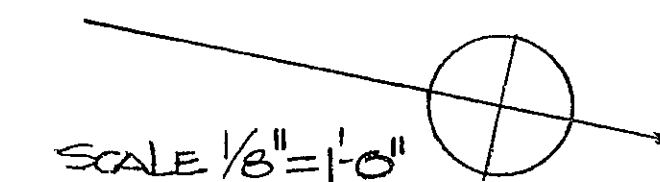

KEY:

- UNIT DEMISING WALL
- COMMON ELEMENT
- LIMITED COMMON ELEMENT


- PARTITION REMOVED
- PARTITION ADDED

- \* REVISIONS:
- 1. ADDED ROOM TITLES & DIMENSIONS, ALL PLANS
  - 2. ADDED PARTITION CHANGES (REMOVED & ADDED) KEY
  - 3. ADDED KITCHEN COUNTERTOPS, SLIDING DOORS
- \*\* 1. ADDED DETAIL SHEET A-2 & REVISION LISTED A-2

**MARK ONES CONDOMINIUM**  
 AN EXPANDABLE CONDOMINIUM  
 47-49 BOND STREET • HARTFORD, CT

I CERTIFY THAT THESE PLANS ARE AN ACCURATE COPY OF REVISIONS OF PLANS FILED WITH THE TOWN CLERK, CITY OF HARTFORD, CONNECTICUT.

**A-1**  
**PLANS**

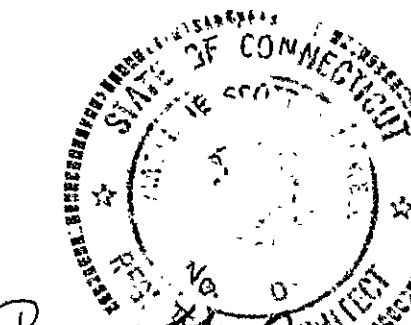

*Mark Ono*  
 REVISED 3 APR 81 25 MAY 81 17 OCT 1981

