

THIS IS TO CERTIFY THAT THIS PLAN AND THE PLANS FOLLOWING, DATED "MAPLE AVENUE CONDOMINIUM, HARTFORD, CONN. TYPICAL DIAGRAMATIC FLOOR PLAN" IS AN ACCURATE COPY OF THE PORTIONS OF THE PLANS FILED WITH THE RECORDS OF THE CITY OF HARTFORD, DATED AT HARTFORD, CONNECTICUT, THIS 15th DAY OF JUNE 1981.

John N. Elbow
 JOHN N. ELBOW
 ARCHITECT

MAPLE VIEW CONDOMINIUM
HARTFORD, CONN

TYPICAL DIAGRAMATIC FLOOR PLAN


CEILING IS 8'-9" ABOVE FLOOR WHICH IS AT ELEVATION 72.0'

APPROXIMATE FLOOR AREA 1050 SQ. FT.
 APPROXIMATE COMMON AREA 244 SQ. FT.

3 BEDROOMS + 1 BATH



UNIT TYPE 1A

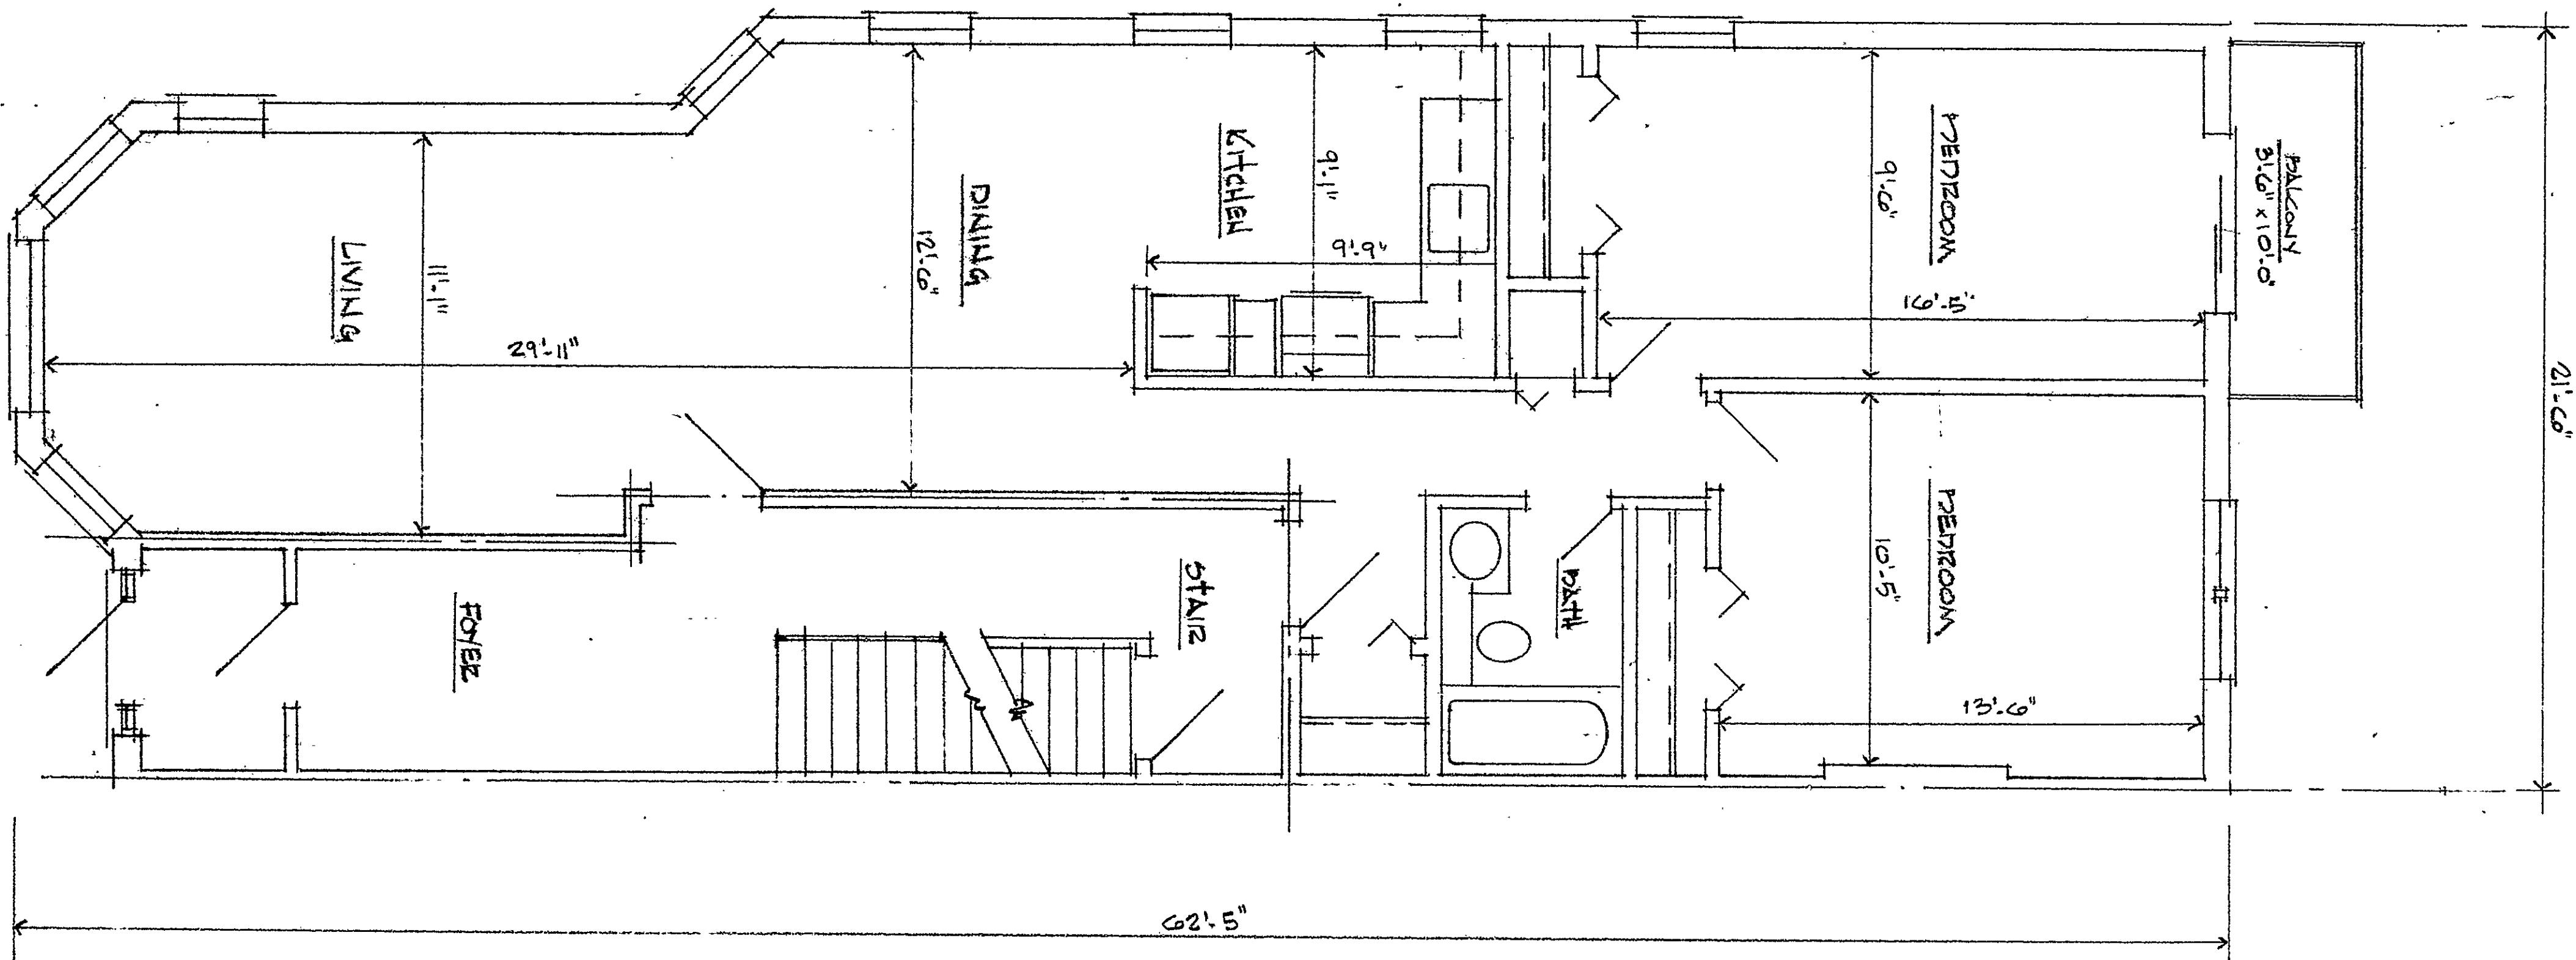

Conrad Zboron 7-59