


RECEIVED BY
 AUG 12 2 54 PM '81
 TOWN & CITY OF
 HARTFORD
 VOL PAGE


Condo Plan # 60

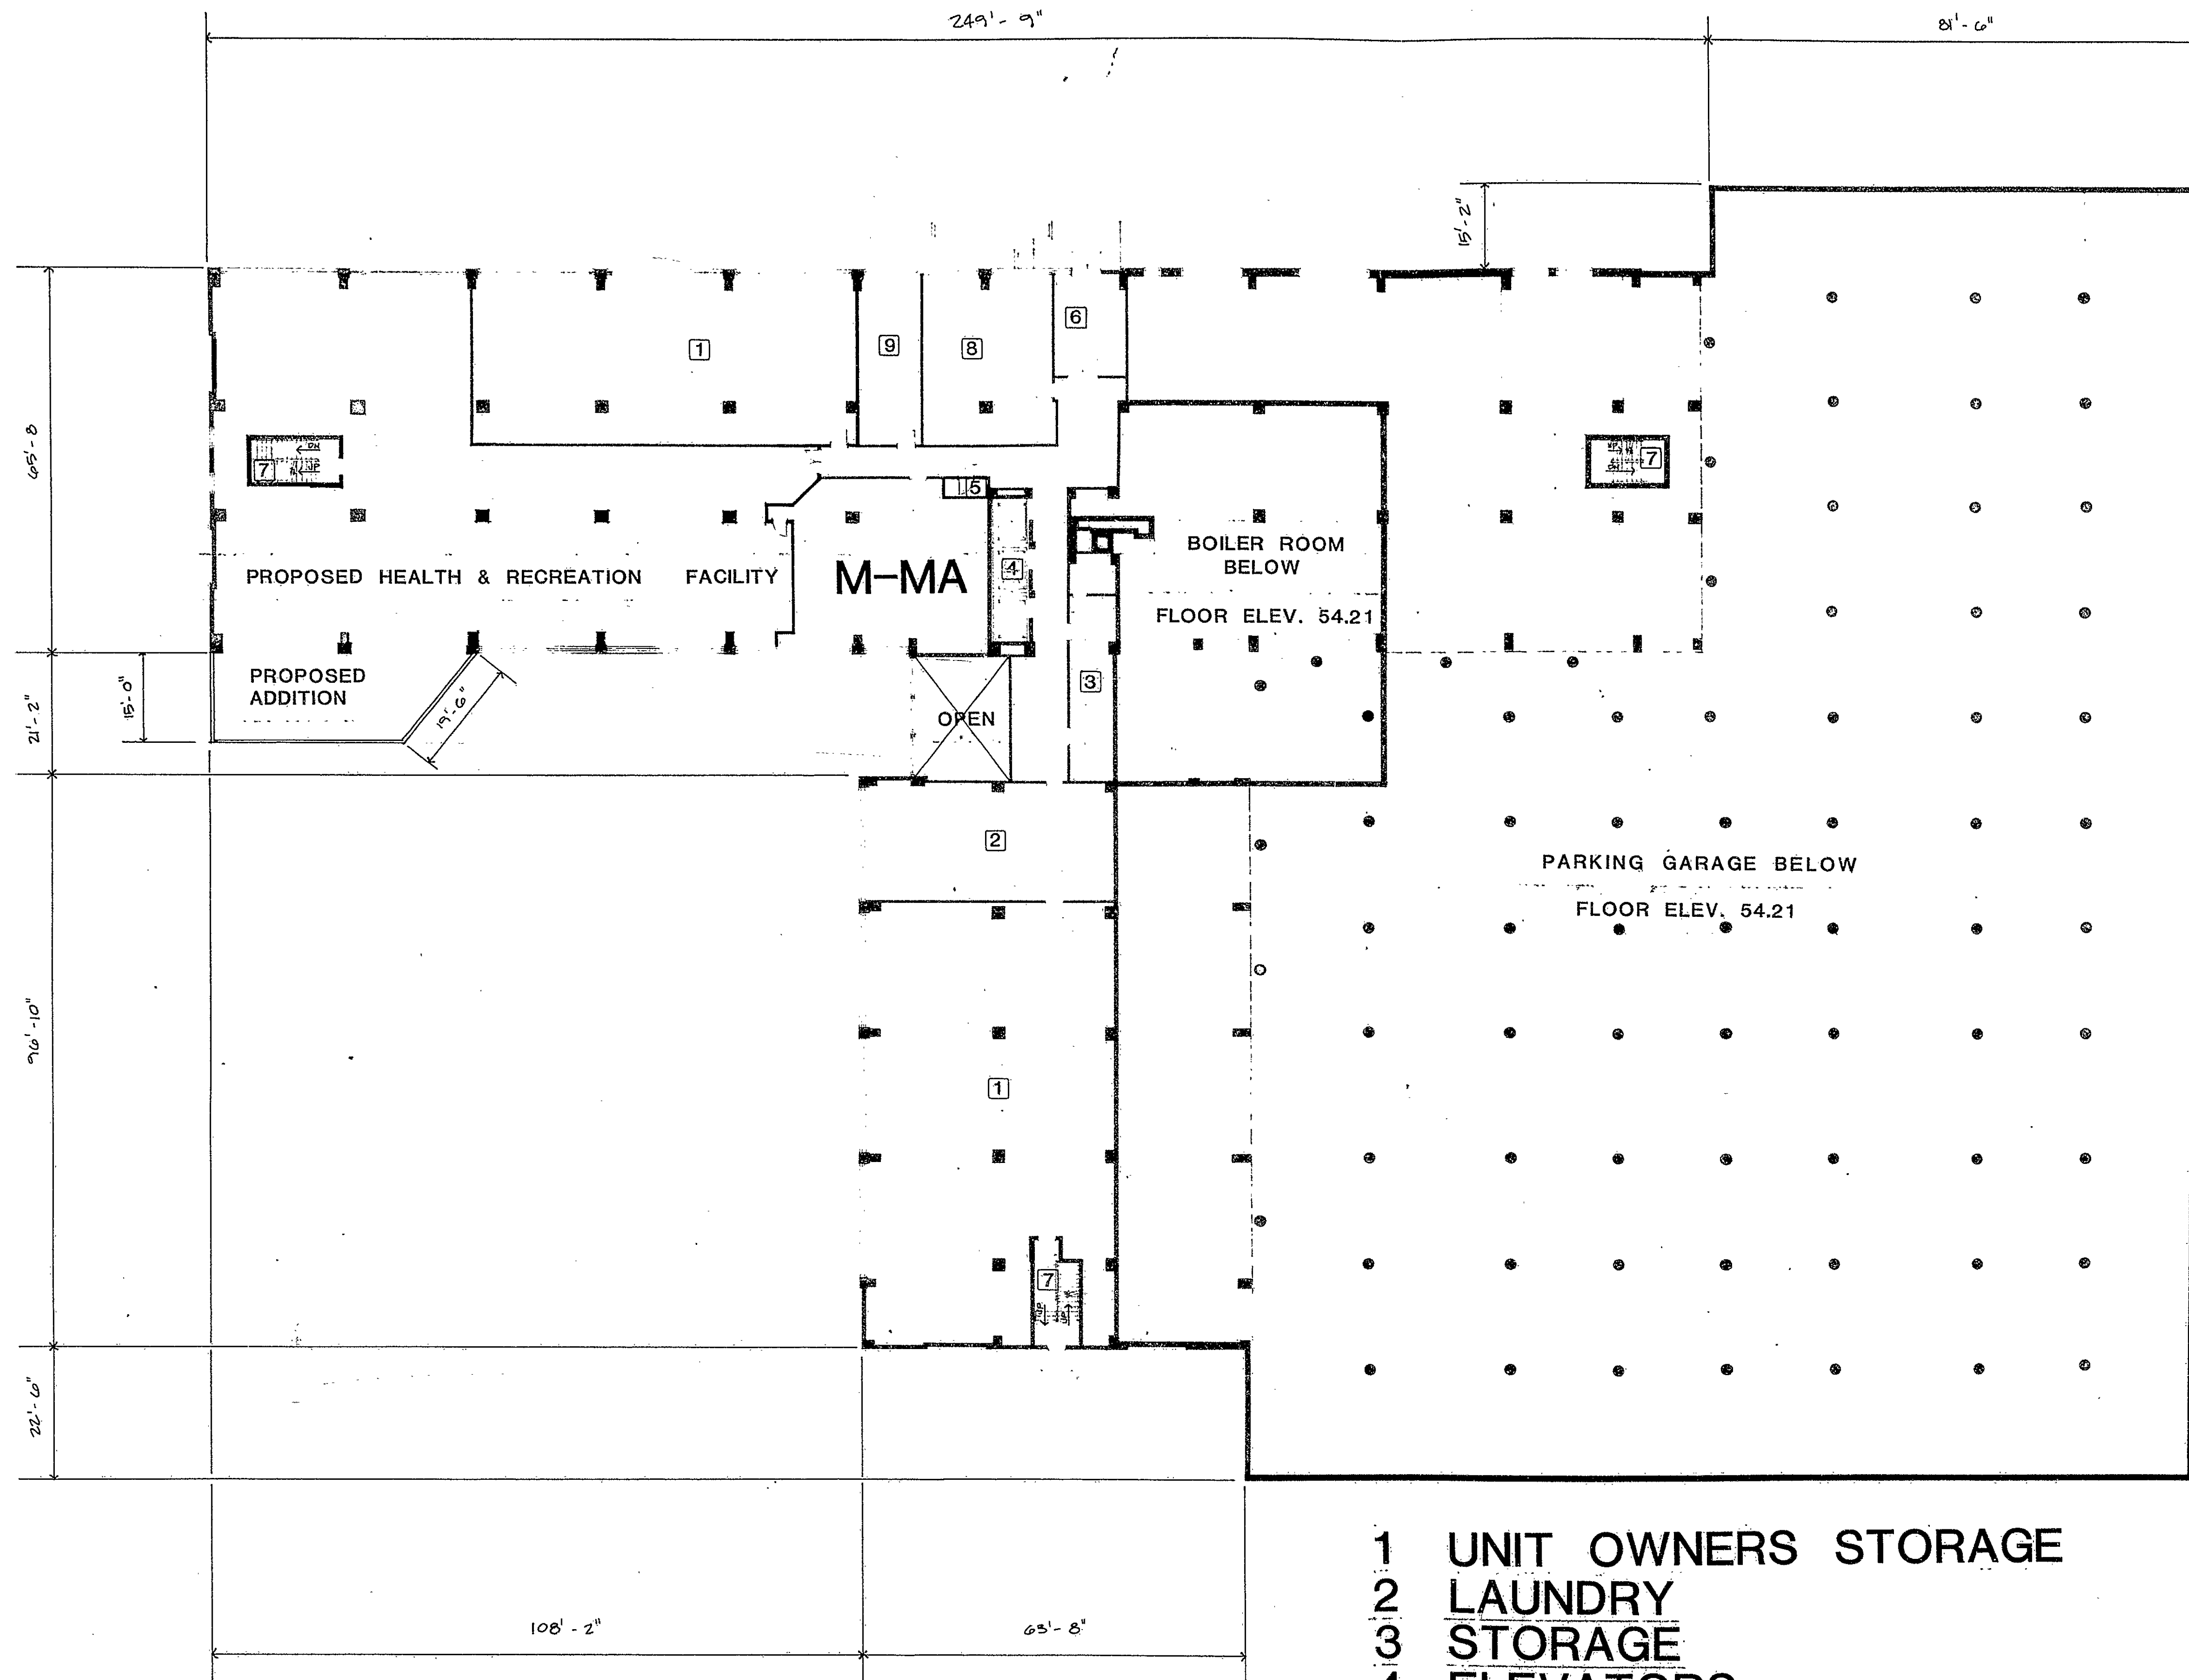

- 1 UNIT OWNERS STORAGE
- 2 LAUNDRY
- 3 STORAGE
- 4 ELEVATORS
- 5 JANITOR CLOSET
- 6 VESTIBULE
- 7 STAIR
- 8 OFFICE
- 9 BUILDING SHOP

MEZZANINE FLOOR PLAN

FL. ELEV. 62.60'
 CLG. ELEV. 72.35'

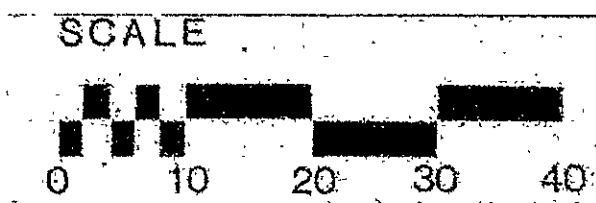

General Notes:
 All elevations taken from
 M.D.C. datum
 Each unit is separately
 designated by adding the
 floor on which it is located
 as a prefix to the unit type.
 Example: 5-T is a unit type
 "T" located on the 5th Floor.

Certified to be an accurate copy of portions
 of the original plan as shown to the
 Building Inspector of the City of Hartford
 in accordance with Section 19-396 of the
 Connecticut General Statutes.
 Harvey M. White, Registered Architect #11560
 State of Connecticut, s.s. Hartford
 County of Hartford) s.s. Hartford
 Subscribed and sworn to before me this 2nd
 day of March 1981
 Charles W. O'Leary
 Notary Public - My commission expires 3/31/81.

**woodland
 house the
 condominium**

31 woodland st.
 hartford, ct.

1/16" = 1'-0"	
2-9-81	
34-80	

**Hane & White
 Architects**

Exhibit C
 Declaration of Condominium
 Woodland House Condominium
 31 Woodland Street
 Hartford, Connecticut
 Sheet 8 of 20

60

