


RECEIVED BY
ARCHITECT
SEP 15 2 31 PM '01
TOWN & CITY CLERK
HARTFORD
VOL. _____ PAGE _____

63-1



63
CITY OF HARTFORD
TOWN & CITY CLERK

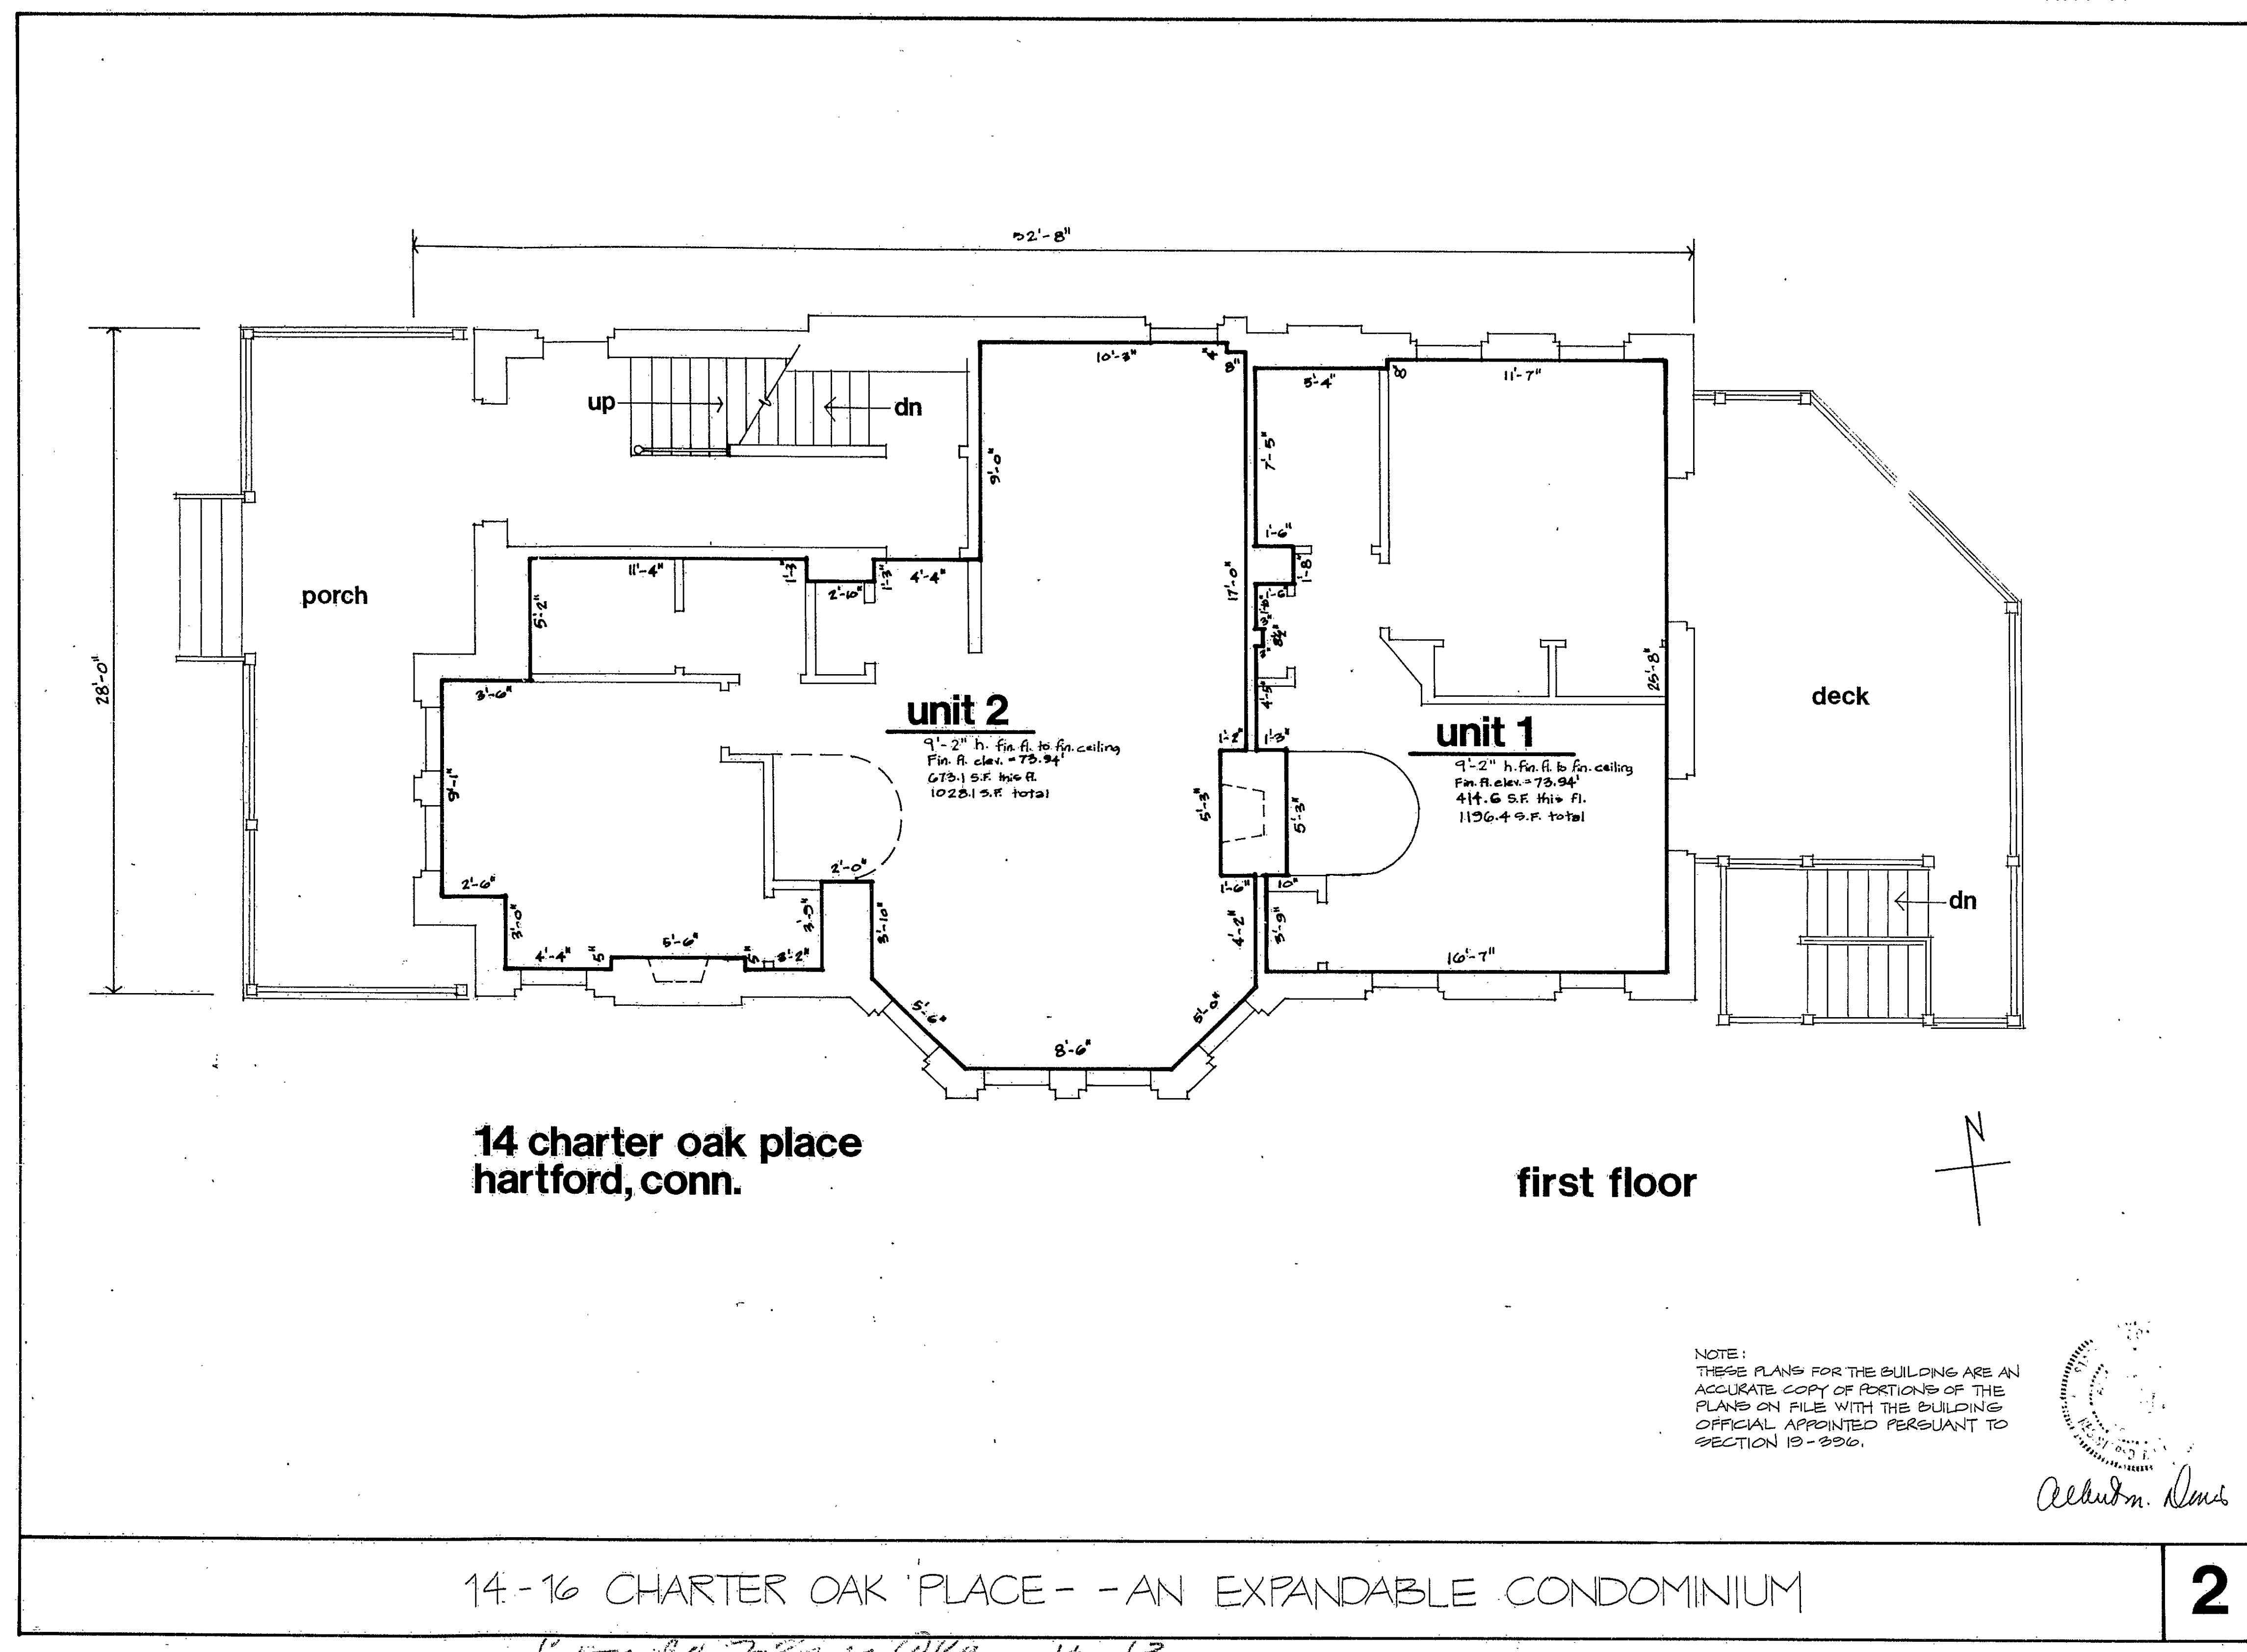