


RECEIVED BY
SEP 15 2 10 PM '91
TOWN & CITY OF
HARTFORD
VOL. PAGE


63-2

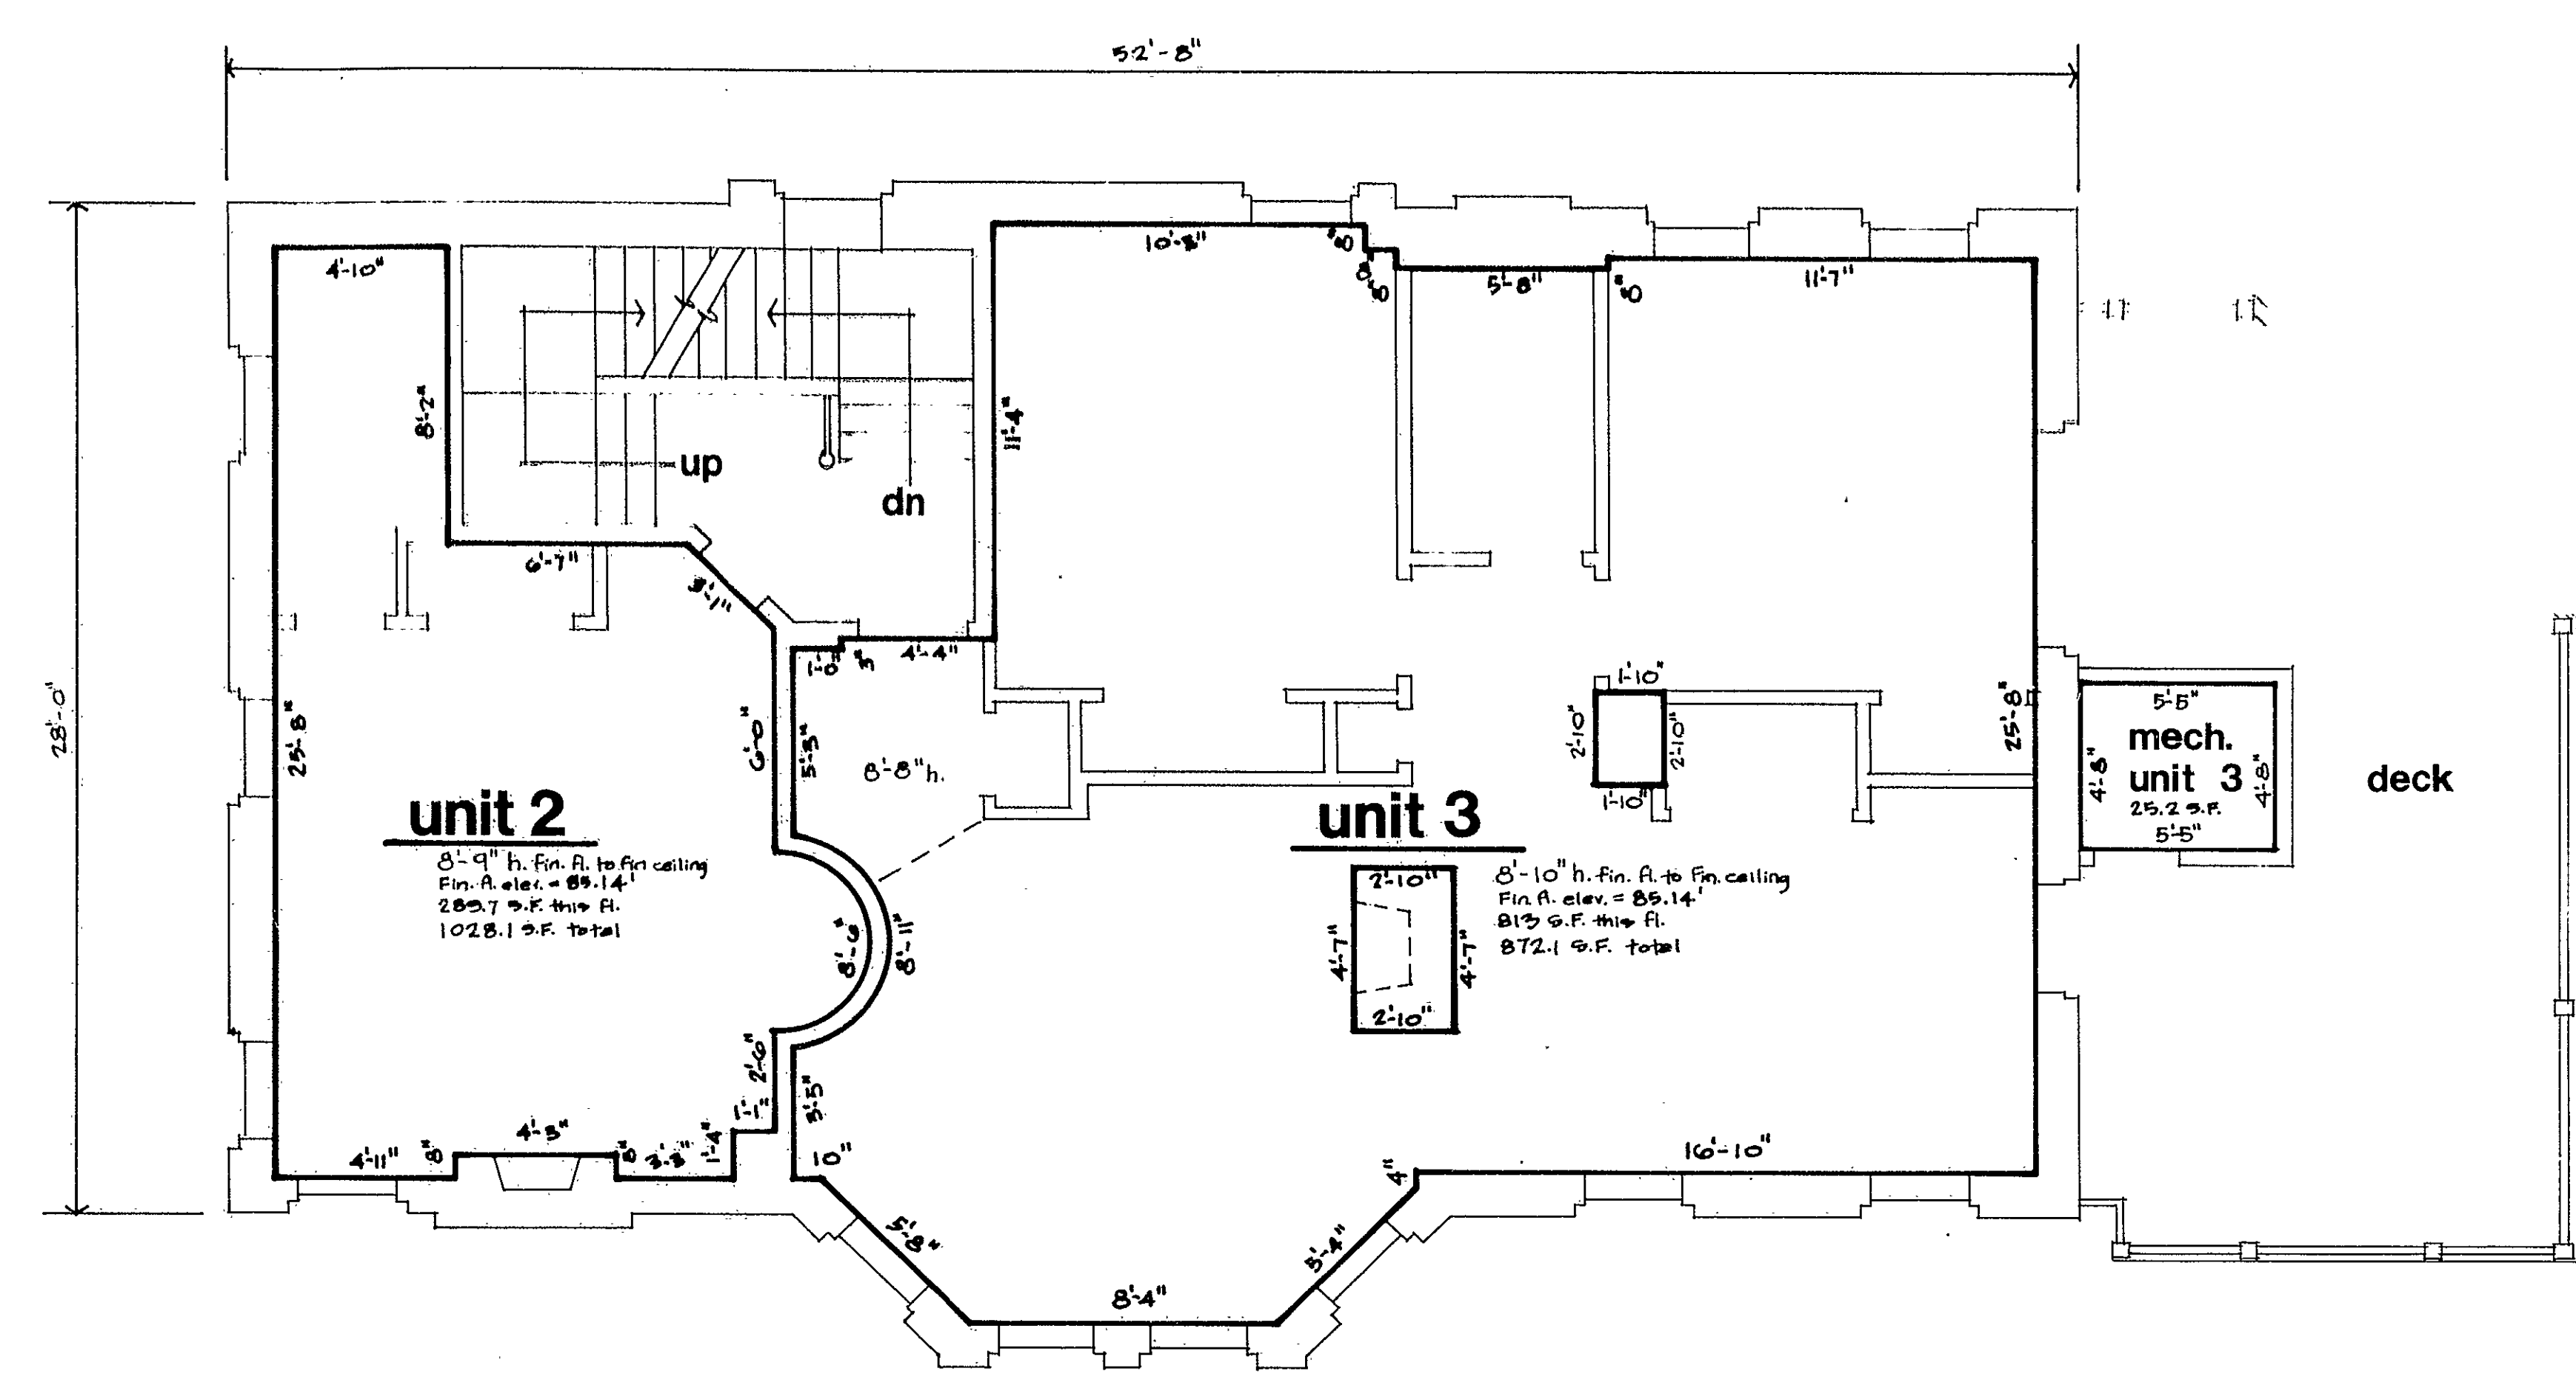

14 charter oak place
hartford, conn.

second floor

NOTE:
THESE PLANS FOR THE BUILDING ARE AN
ACCURATE COPY OF PORTIONS OF THE
PLANS ON FILE WITH THE BUILDING
OFFICIAL APPOINTED PURSUANT TO
SECTION 19-356.

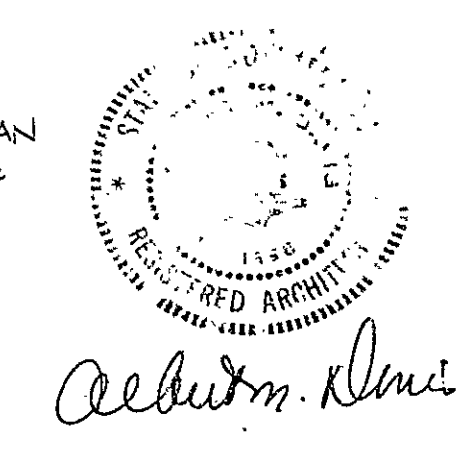

14-16 CHARTER OAK PLACE - - AN EXPANDABLE CONDOMINIUM

3

Cond Floor Plan # 13



63
14-16