


63-5

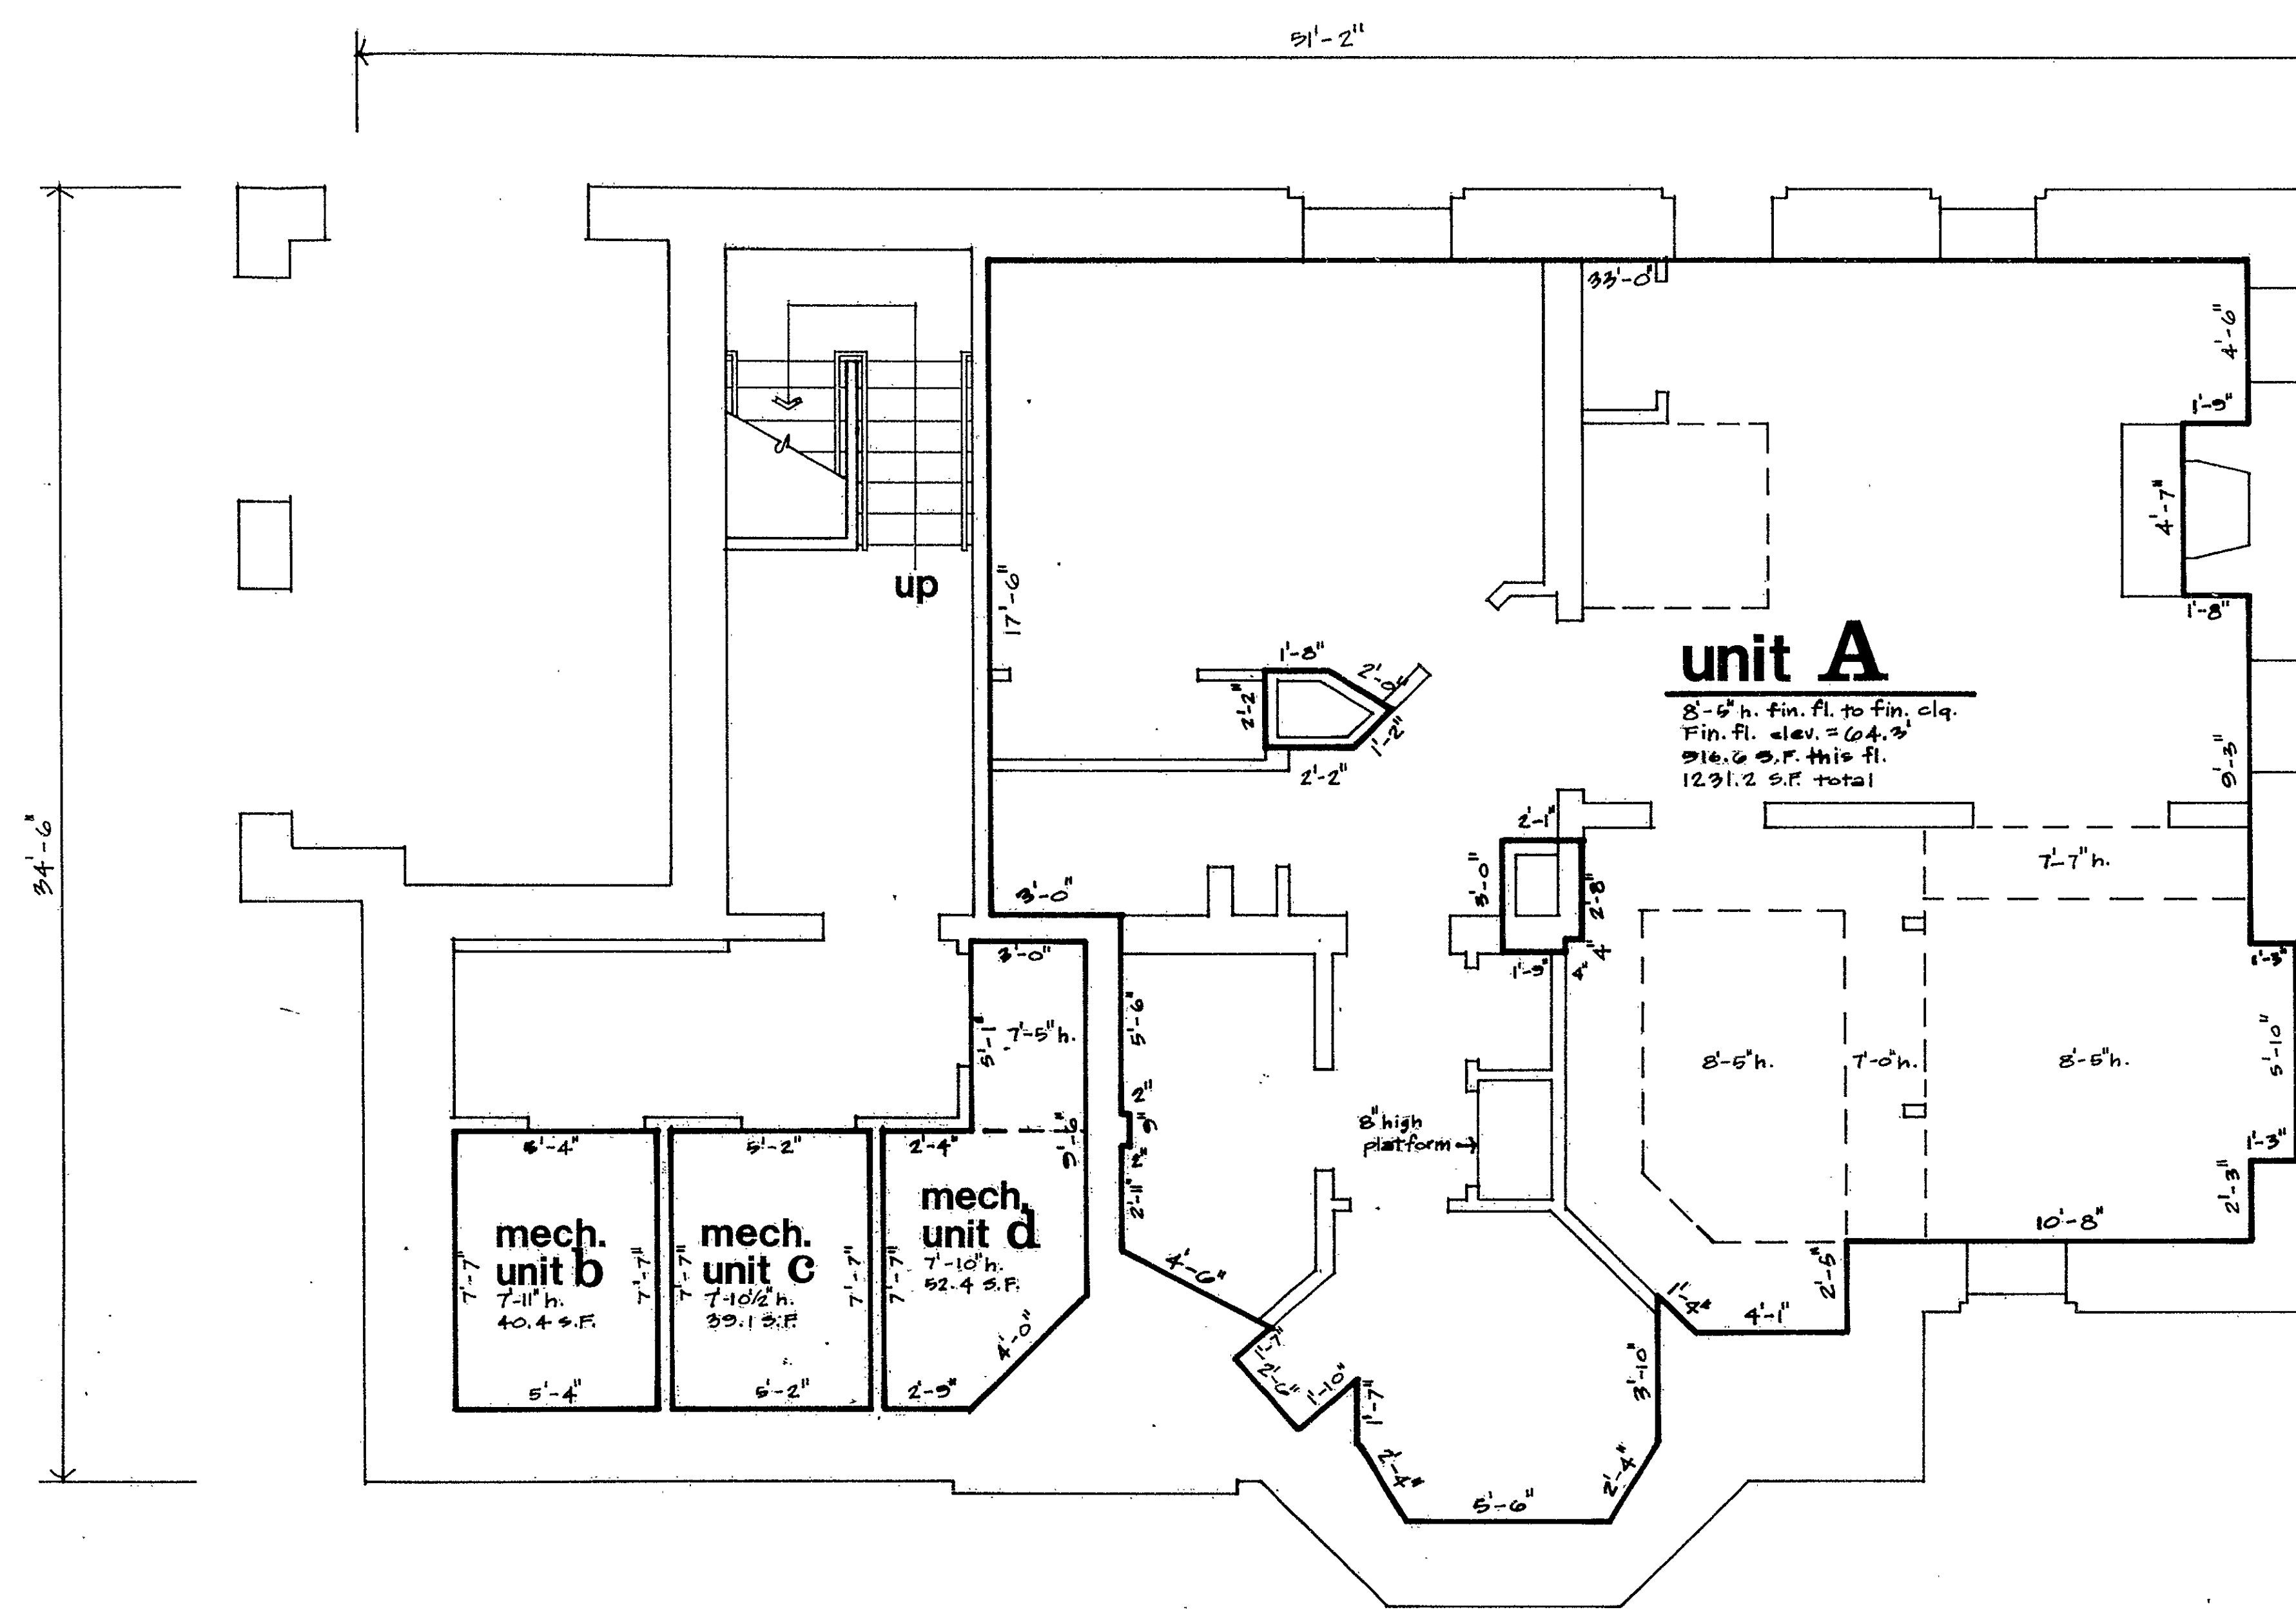

14-16 CHARTER OAK PLACE -- AN EXPANDABLE CONDOMINIUM

1

Condo floor plan # 6313

63

EAST FILE CORP. JENNIE CH