



63-7

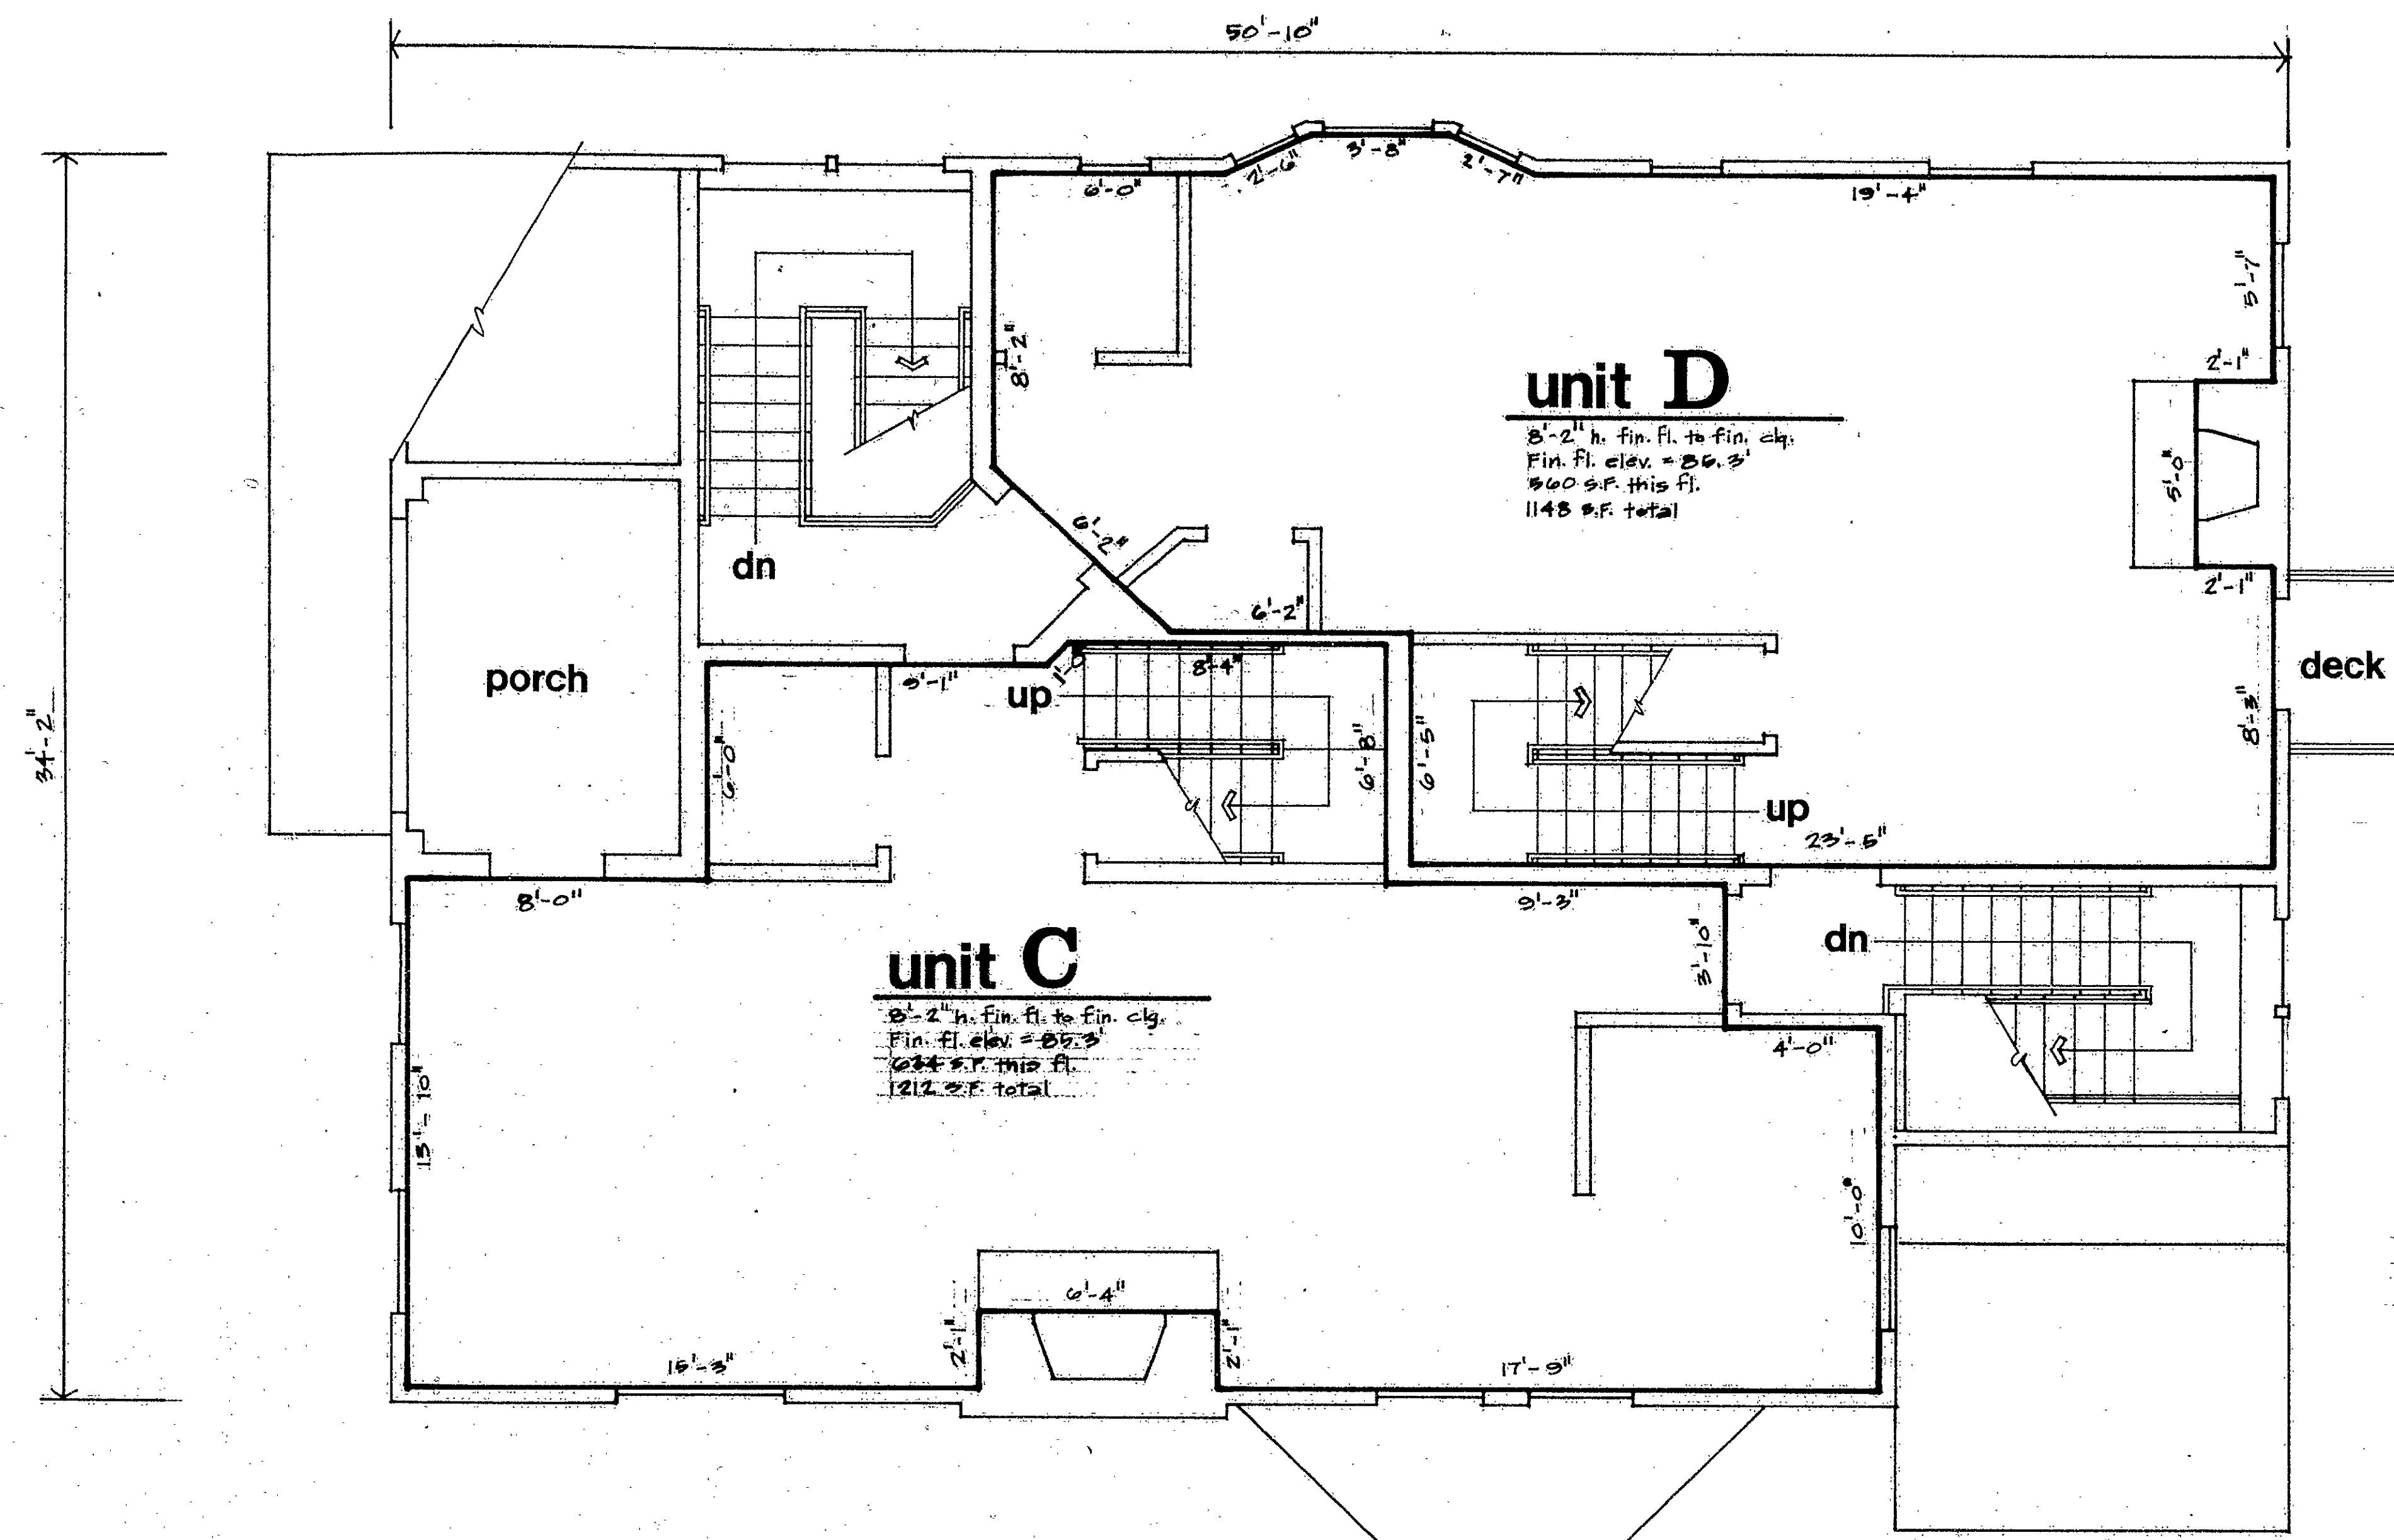

16 charter oak place
hartford, conn.

second floor

NOTE:
THESE PLANS FOR THE BUILDING
ARE FOR THE PURPOSE OF RECORD
AND SHALL NOT BE USED FOR
CONSTRUCTION WITHOUT THE
APPROVAL OF THE TOWN ENGINEER
AND THE TOWN CLERK.

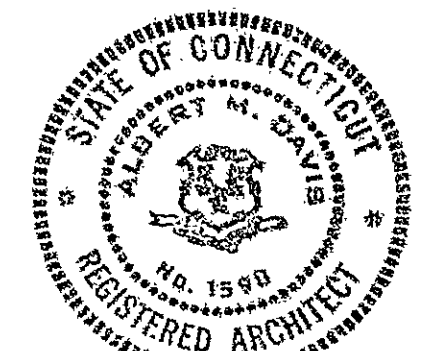


Arthur J. Almes

14-16 CHARTER OAK PLACE - - AN EXPANDABLE CONDOMINIUM

3

Condo Floor Plan # 63 B

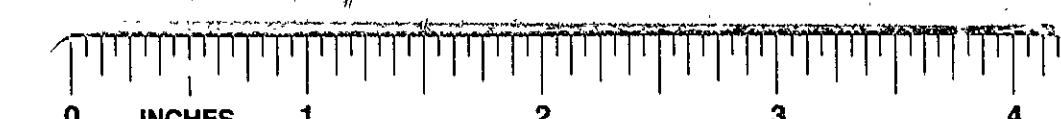

63-7