




RECEIVED BY
UNIT 13 2 UNITS
TOWN OF HARTFORD
JAN 1978
PAGE 1

NOTE:
THESE PLANS FOR THE BUILDING ARE AN
ACCURATE COPY OF PORTIONS OF THE
PLANS ON FILE WITH THE BUILDING
OFFICIAL APPOINTED PURSUANT TO
SECTION 19-296.

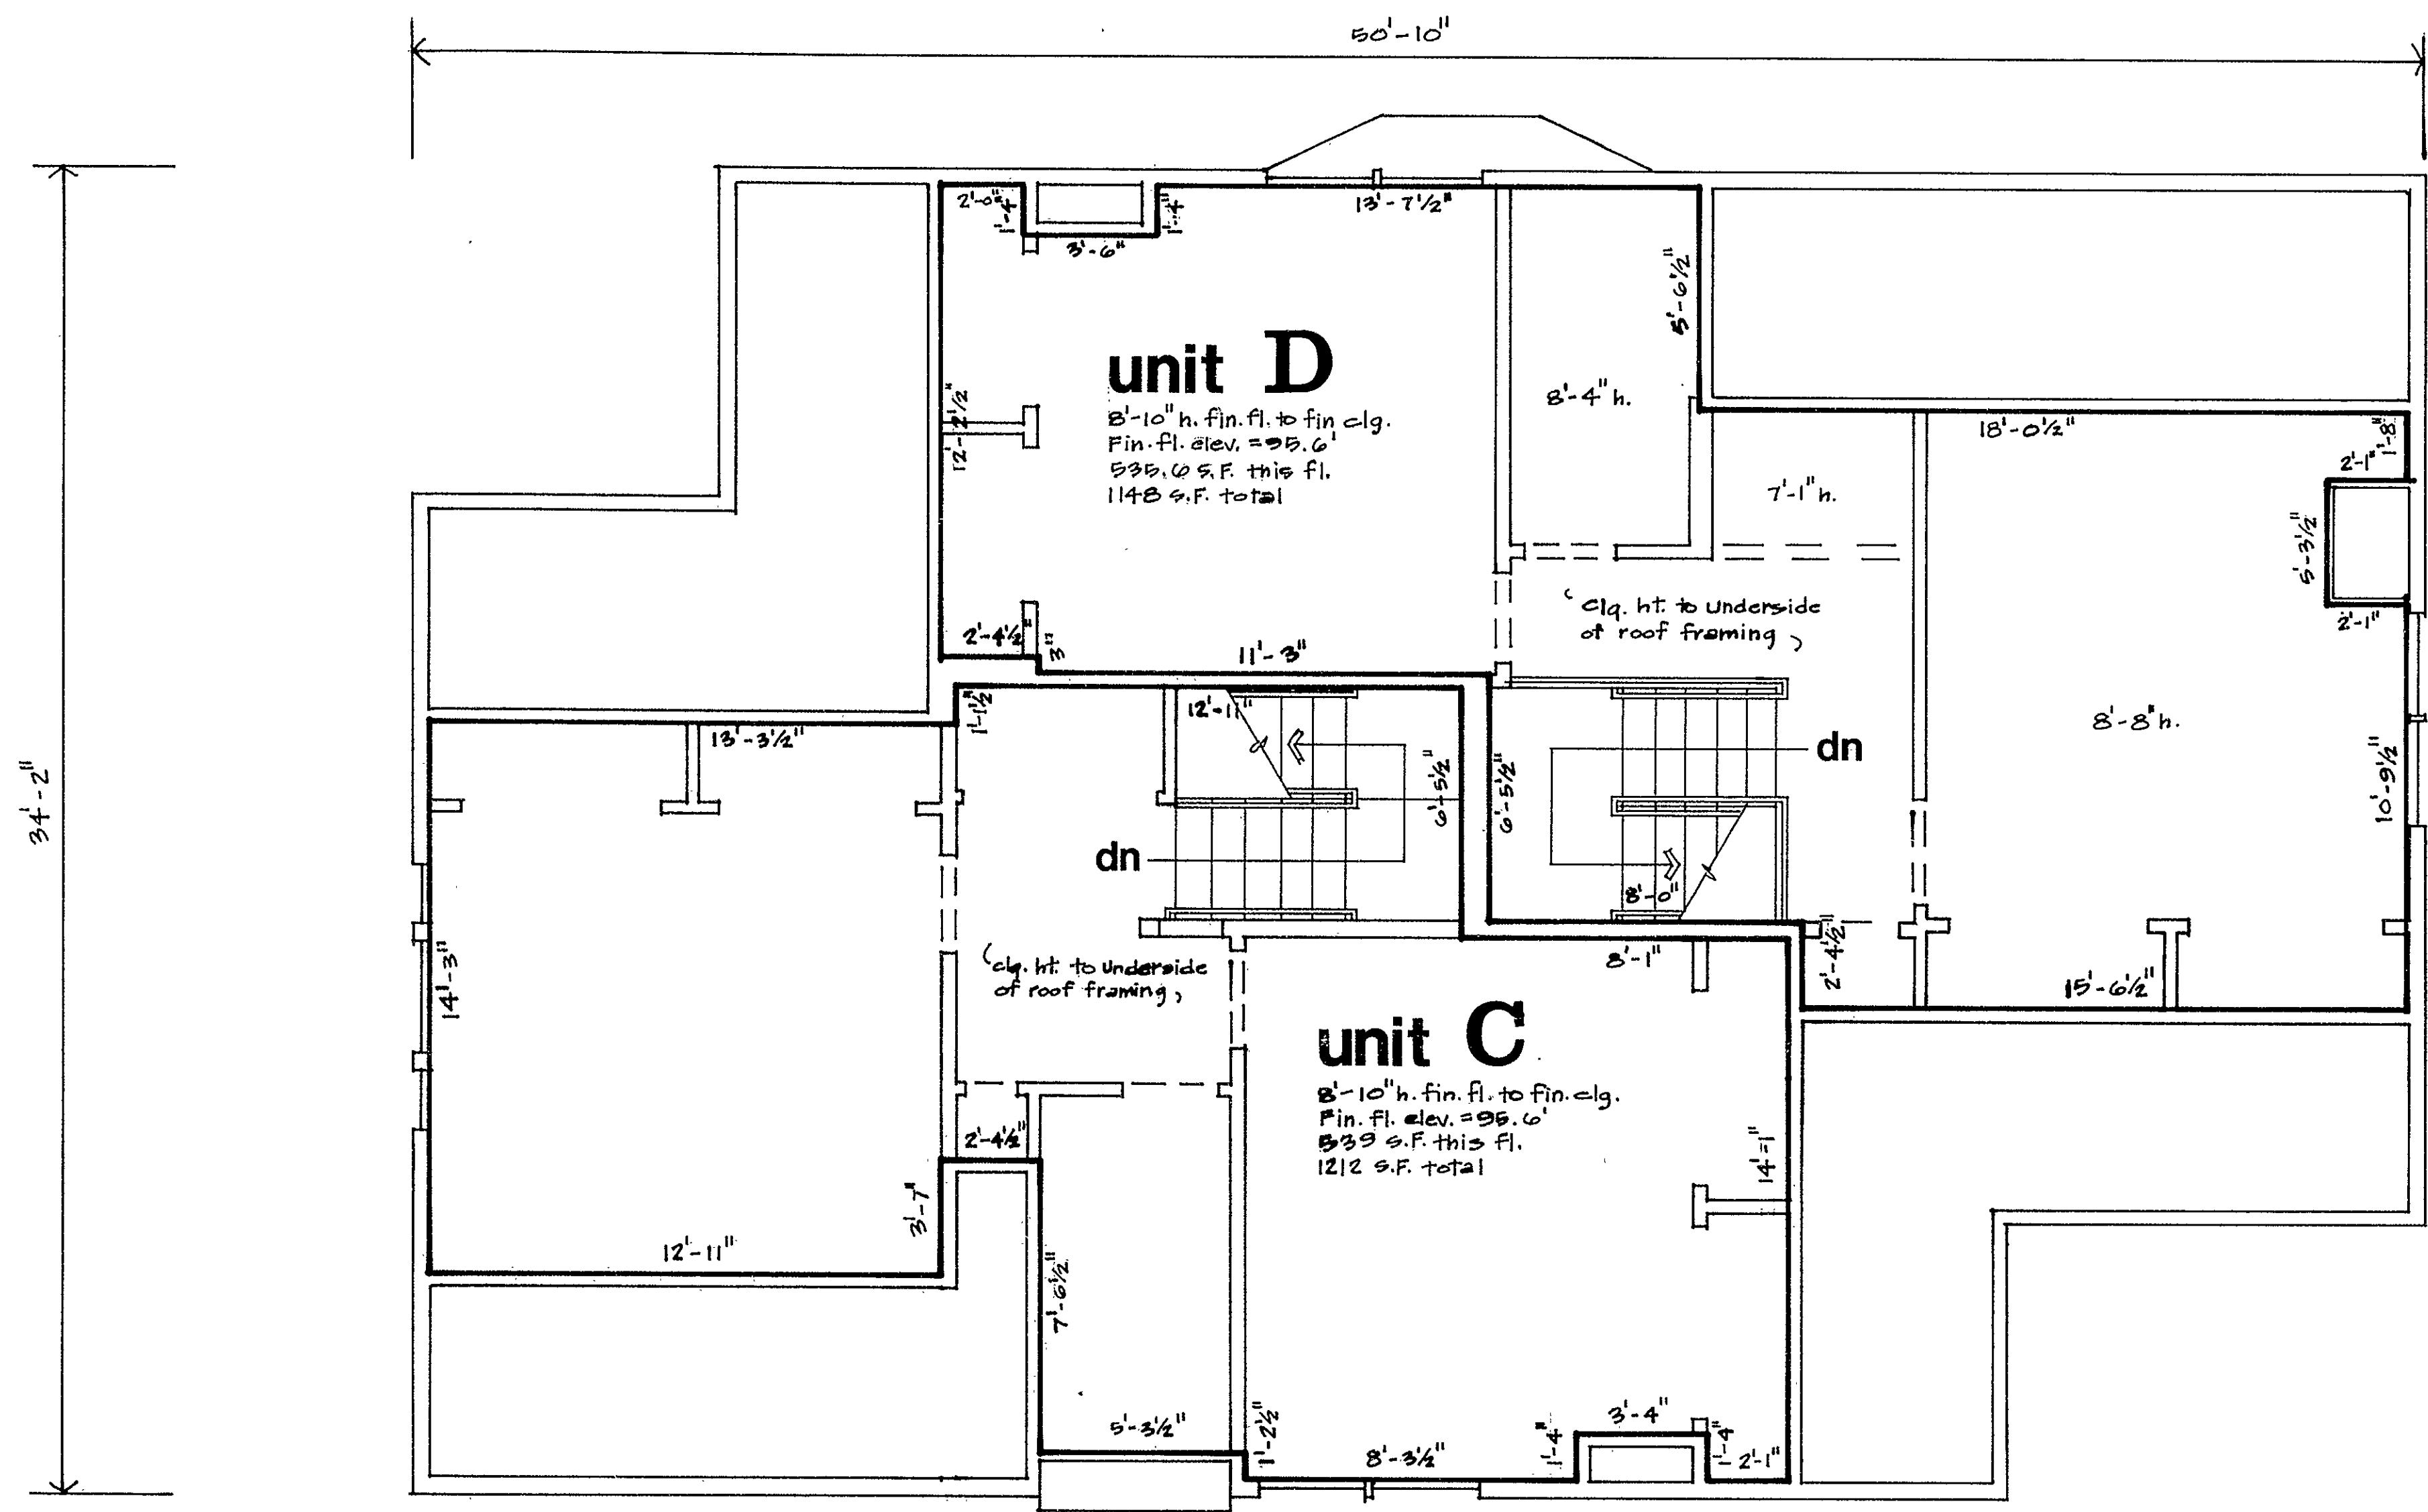

16 charter oak place
hartford, conn.

third floor

14-16 CHARTER OAK PLACE - - AN EXPANDABLE CONDOMINIUM

4

Cond Floor Plan # 63 B

