




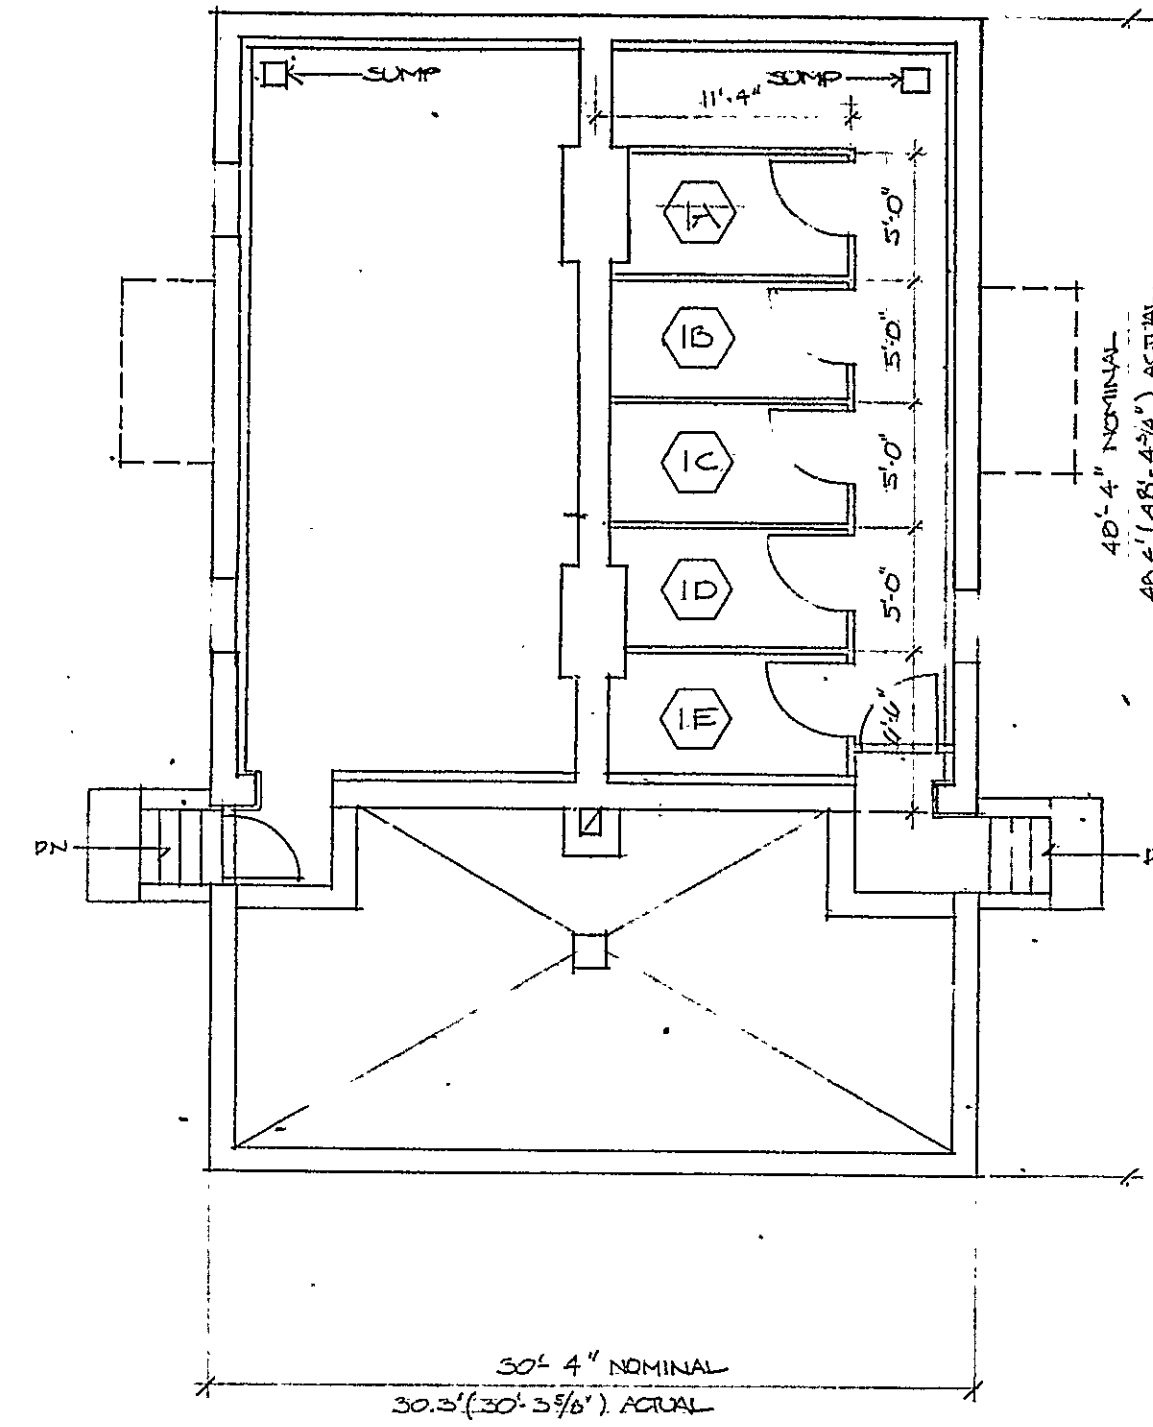


1 BASEMENT BLDG 1
1/8" = 1'-0"

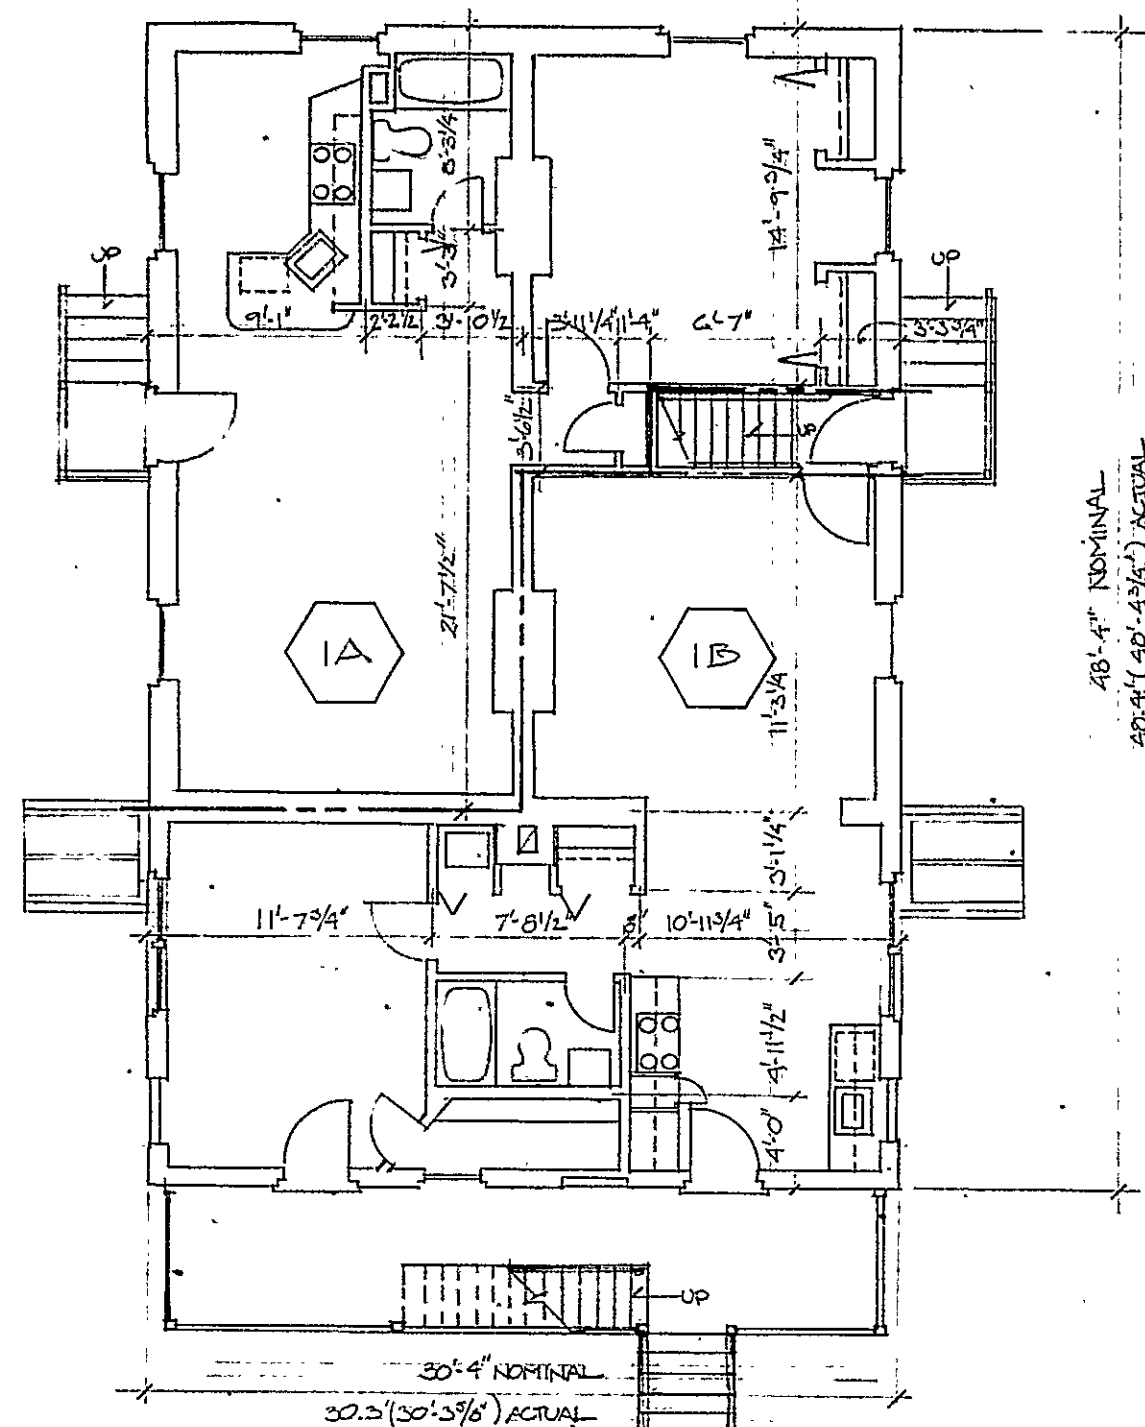

2 FIRST FLOOR BLDG 1
1/8" = 1'-0"

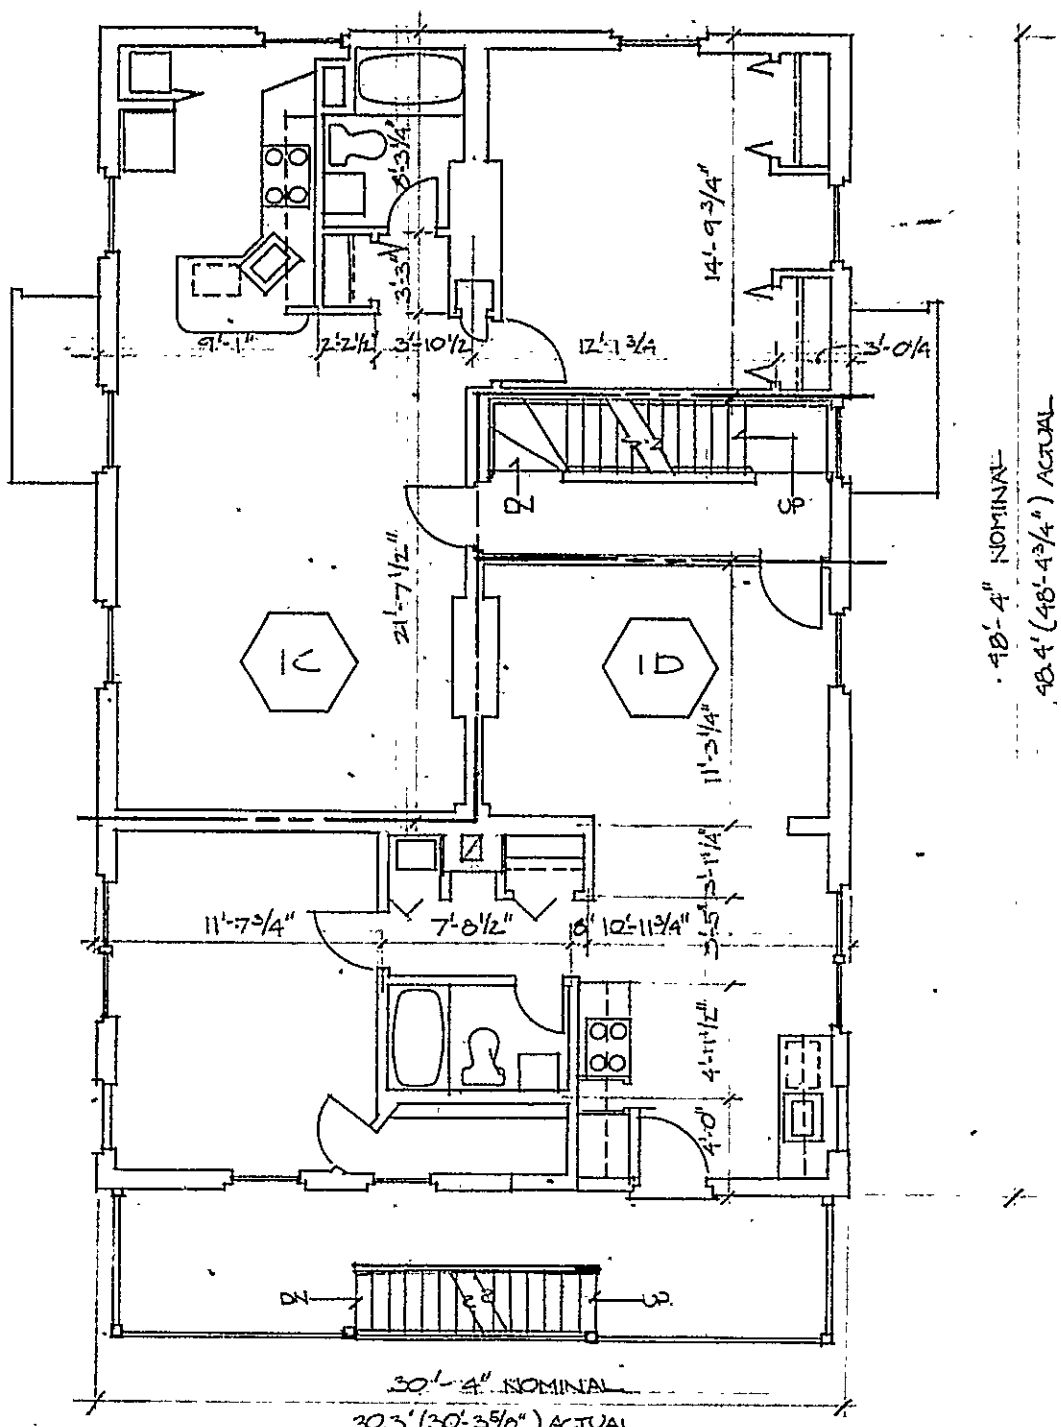

3 SECOND FLOOR BLDG 1
1/8" = 1'-0"

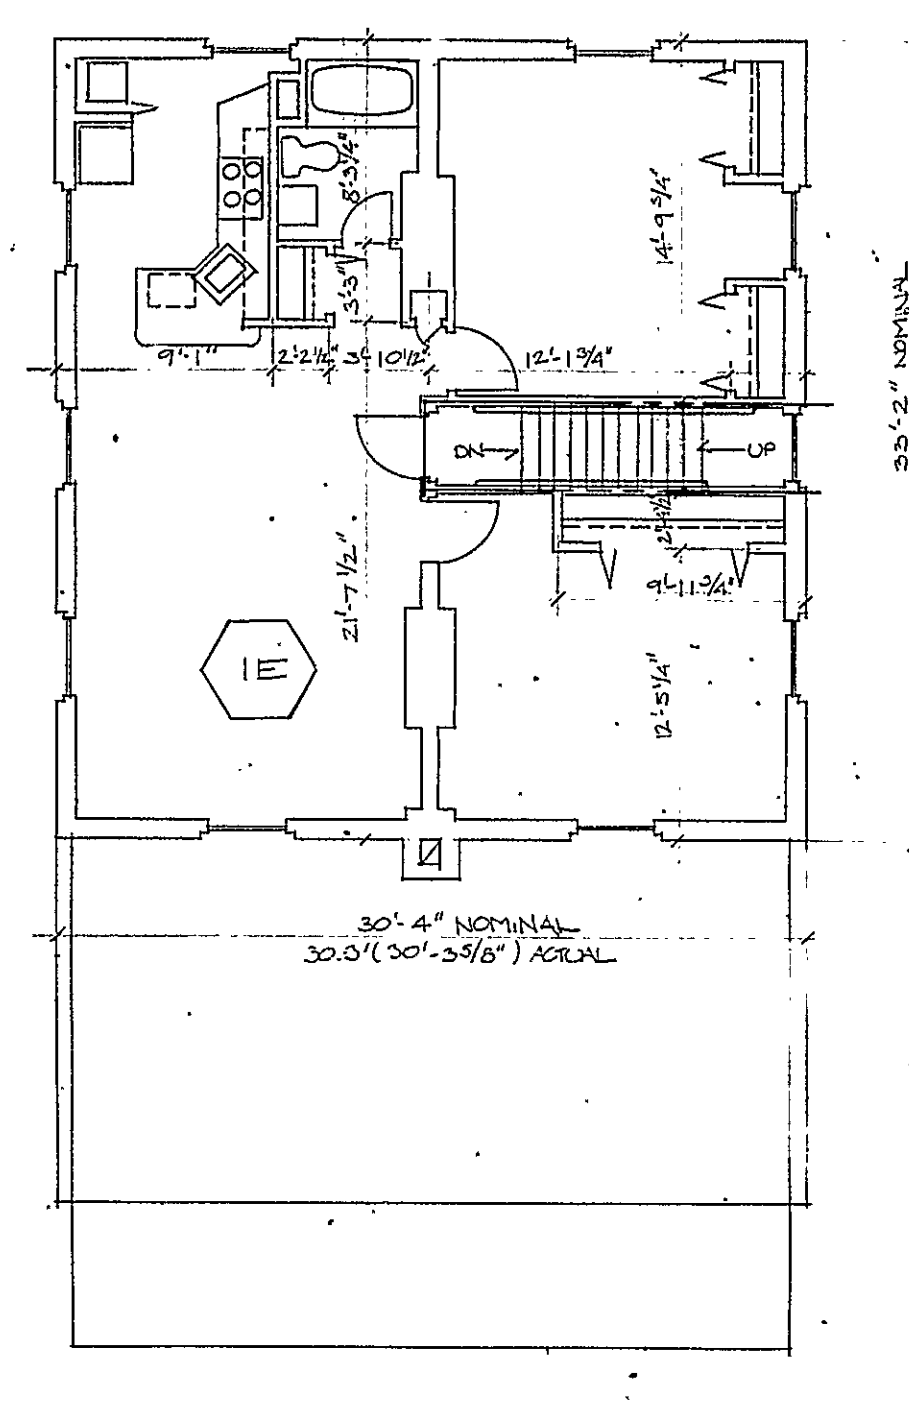


4 THIRD FLOOR BLDG 1
1/8" = 1'-0"

NOTE: DIMENSIONAL TOLERANCES


PLANS SHOW RENOVATED BUILDINGS APPROXIMATELY 100 YEARS OLD. EXTERIOR OVERALL DIMENSIONS SHOWN AS ACTUAL ARE EXACT. ALL INTERIOR DIMENSIONS AND NOMINAL EXTERIOR OVERALL DIMENSIONS ARE BASED ON OBSERVATIONS AND MEASUREMENTS OF TYPICAL BUILDINGS, CHIEFLY BUILDINGS NO. 5 AND NO. 10.

SOME VARIATIONS IN WINDOW LOCATIONS OCCUR. ACTUAL EXTERIOR OVERALL DIMENSIONS ARE FROM THE SURVEY OF COLT ESTATES PREPARED BY JAMES J. LOZZI RE AND L.S., CONN. REG. NO. 9415, DATED SEPT. 10, 1900.


THE LOCATION AND AMOUNT OF VARIATION BETWEEN THE TYPICAL INTERIOR DIMENSIONS SHOWN AND ACTUAL INTERIOR DIMENSIONS ARE NOT SHOWN IN THESE PLANS.

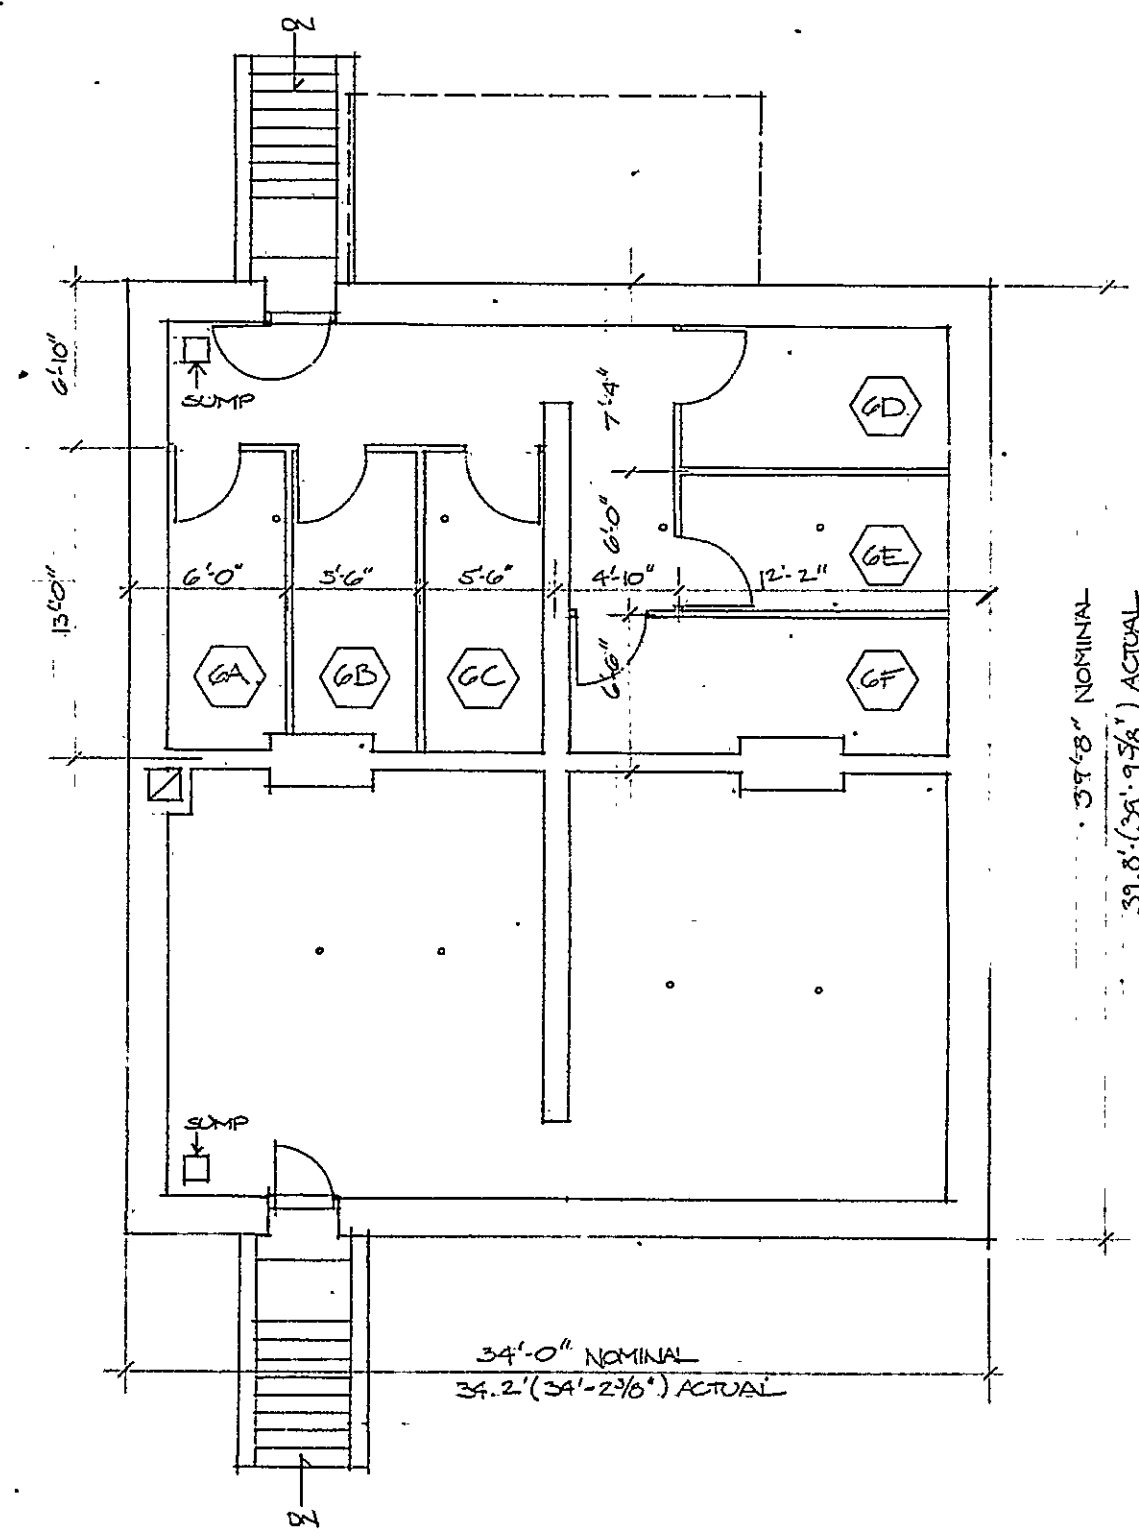


5 BASEMENT BLDG 6
1/8" = 1'-0"

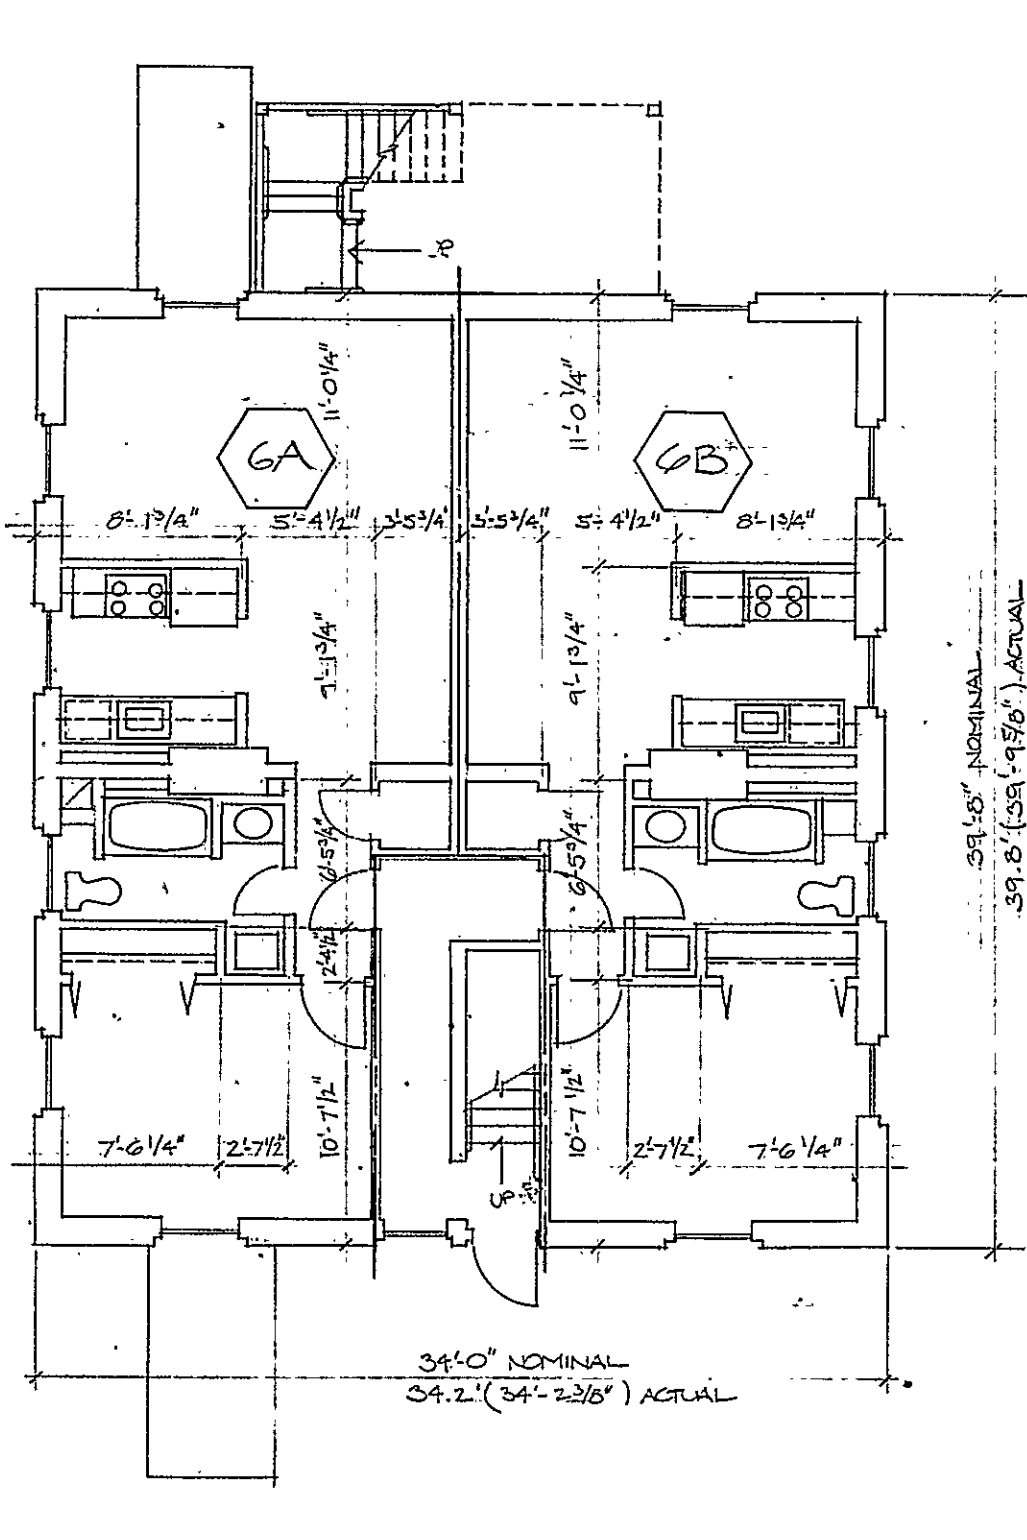


6 FIRST FLOOR BLDG 6
1/8" = 1'-0"

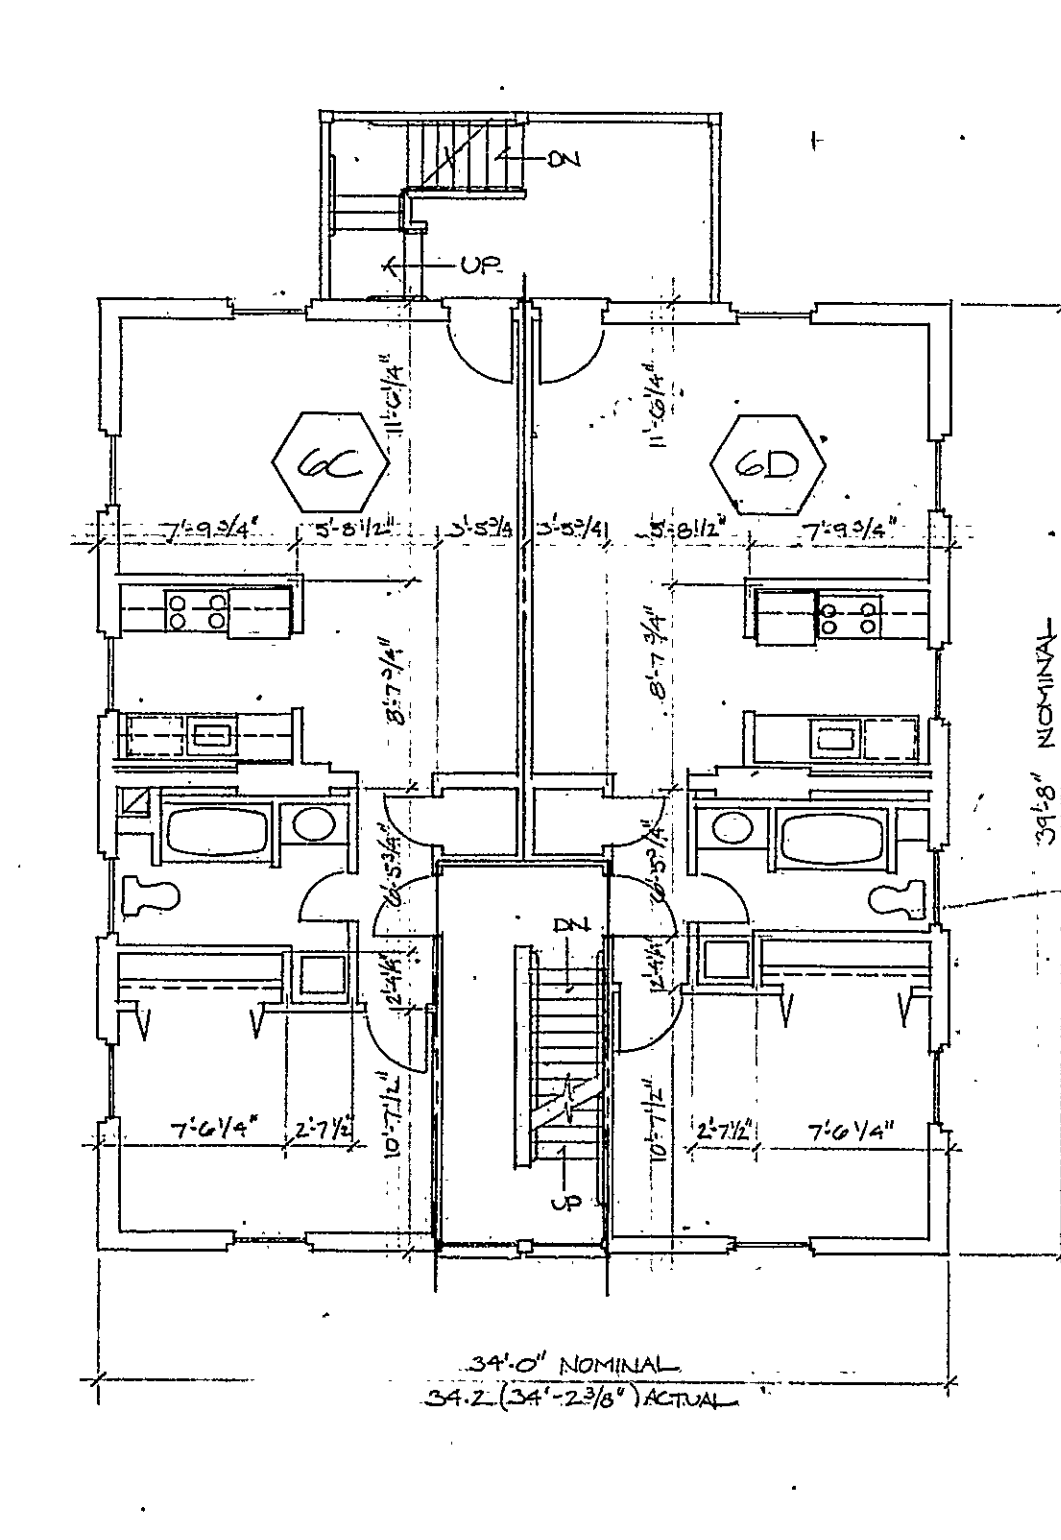

7 SECOND FLOOR BLDG 6
1/8" = 1'-0"

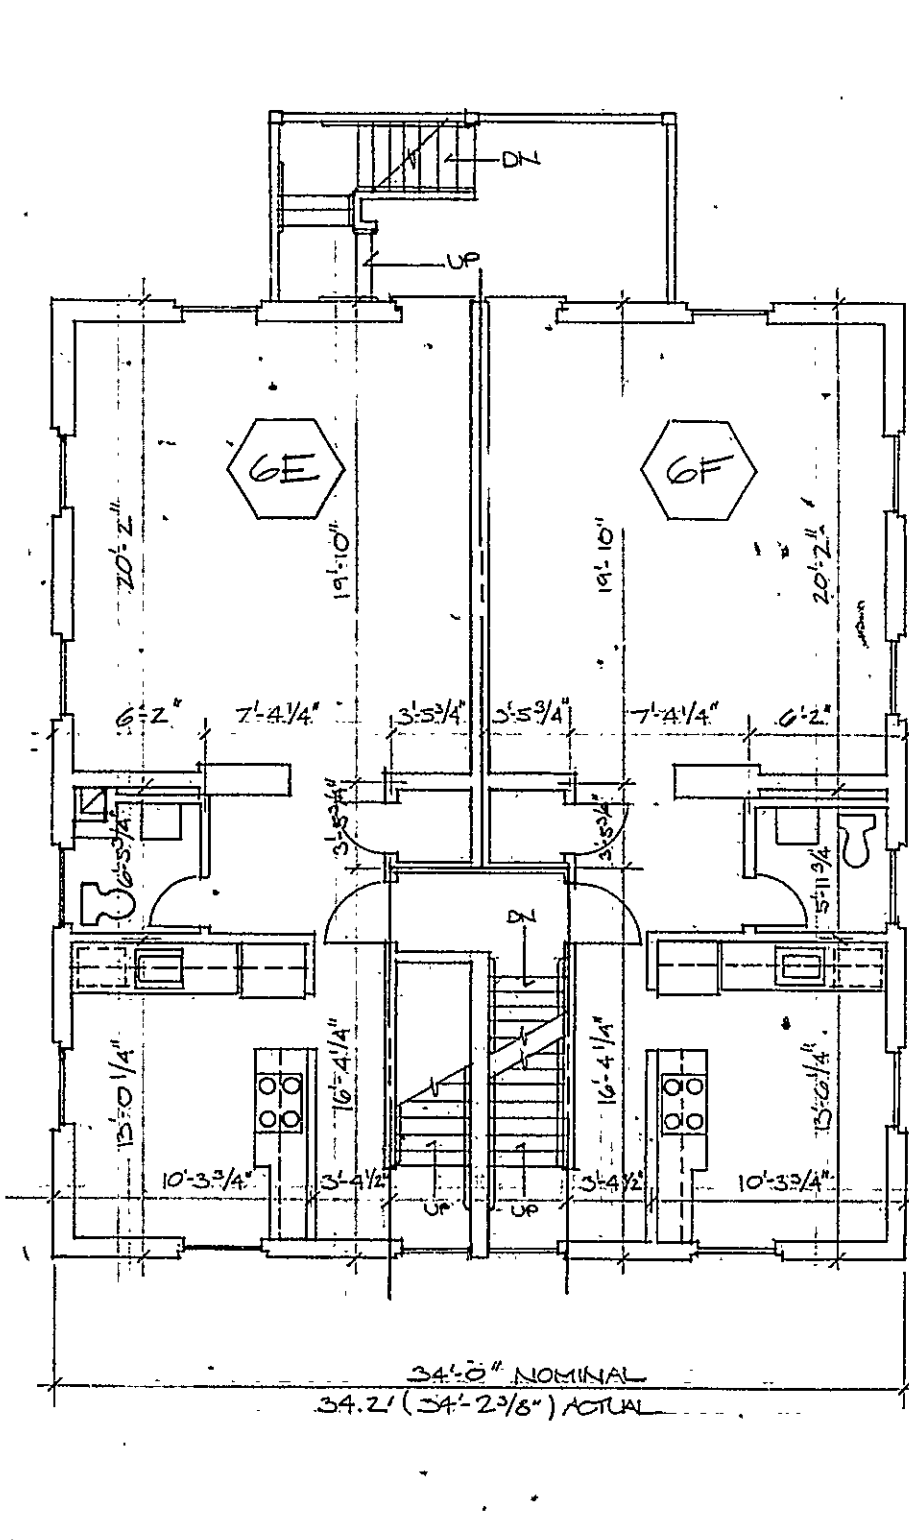

8 THIRD FLOOR BLDG 6
1/8" = 1'-0"

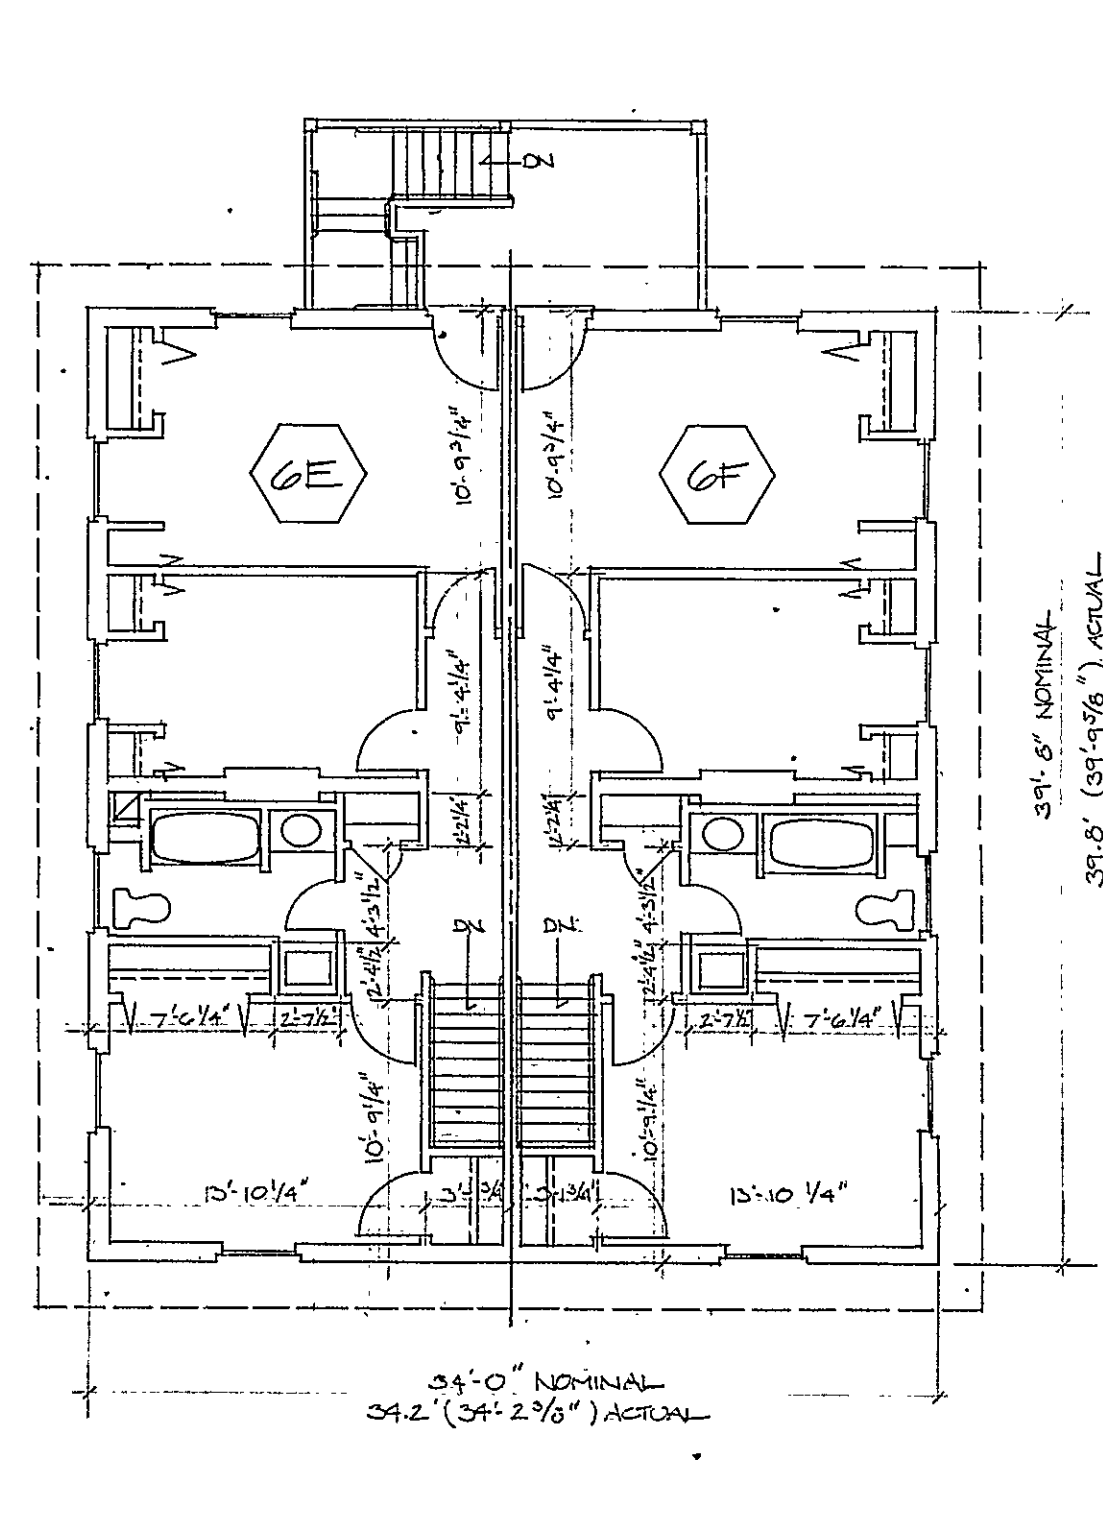

9 FOURTH FLOOR BLDG 6
1/8" = 1'-0"

REVISIONS	BY

RECEIVED BY
SEP 11 4 07 PM '81
TOWN & CITY CLERK
HARTFORD, CT
VOL. _____ PAGE _____

CONDOMINIUM
PLANS
BLDGs. 1 AND 6

COLT ESTATES II
HARTFORD, CT 06103

DATE
CHECKED
DRAWN
JOB
SHEET
C1
OF 116

100% SUBMISSION - NOT FOR LEGAL USE
NOV 12, 1980

Condo Plan

65

0 INCHES 1 2 3 4