

RECEIVED BY  
SEP 21 4 07 PM '81  
TOWN & CITY CLERK  
HARTFORD  
VOL. 1000 PAGE 1

| REVISIONS |
|-----------|
|           |
|           |
|           |
|           |

88 WILLOW STREET  
NEW HAVEN, CONNECTICUT 06511  
TEL. 203-787-5887  
**WILLIAM PETCHLER**  
ARCHITECT



CONDOMINIUM  
PLANS  
BLDG 3 AND 8

COLT ESTATES II  
HARTFORD HUD CT 061-24625  
SZENTKUTYI ASSOCIATES  
REAL ESTATE DEVELOPMENT

|         |  |
|---------|--|
| DATE    |  |
| CHECKED |  |
| DRAWN   |  |
| JOB     |  |
| SHEET   |  |

C3


**NOTES**

**DIMENSIONAL TOLERANCES:**


PLANS SHOW RENOVATED BUILDINGS APPROX. 120 YEARS OLD. ONLY EXTERIOR OVERALL DIMENSIONS SHOWN, AS ACTUAL ARE EXACT. ALL INTERIOR DIMENSIONS AND NOMINAL EXTERIOR OVERALL DIMENSIONS ARE BASED ON OBSERVATIONS AND MEASUREMENTS OF TYPICAL BUILDINGS, CHIEFLY BUILDINGS NO. 5 AND NO. 10.

SOME VARIATIONS IN WINDOW LOCATIONS OCCUR. ACTUAL EXTERIOR OVERALL DIMENSIONS ARE FROM THE SURVEY OF COLT ESTATES, PROPERTY OF SZENTKUTYI ASSOCIATES, PREPARED BY JAMES J. LUZZI, JR. AND L.S. CONN. REG. NO. 9415 DATED SEPT 10, 1980.


THE LOCATION AND AMOUNT OF VARIATION BETWEEN THE TYPICAL INTERIOR DIMENSIONS SHOWN AND ACTUAL INTERIOR DIMENSIONS ARE NOT SHOWN IN THESE PLANS.

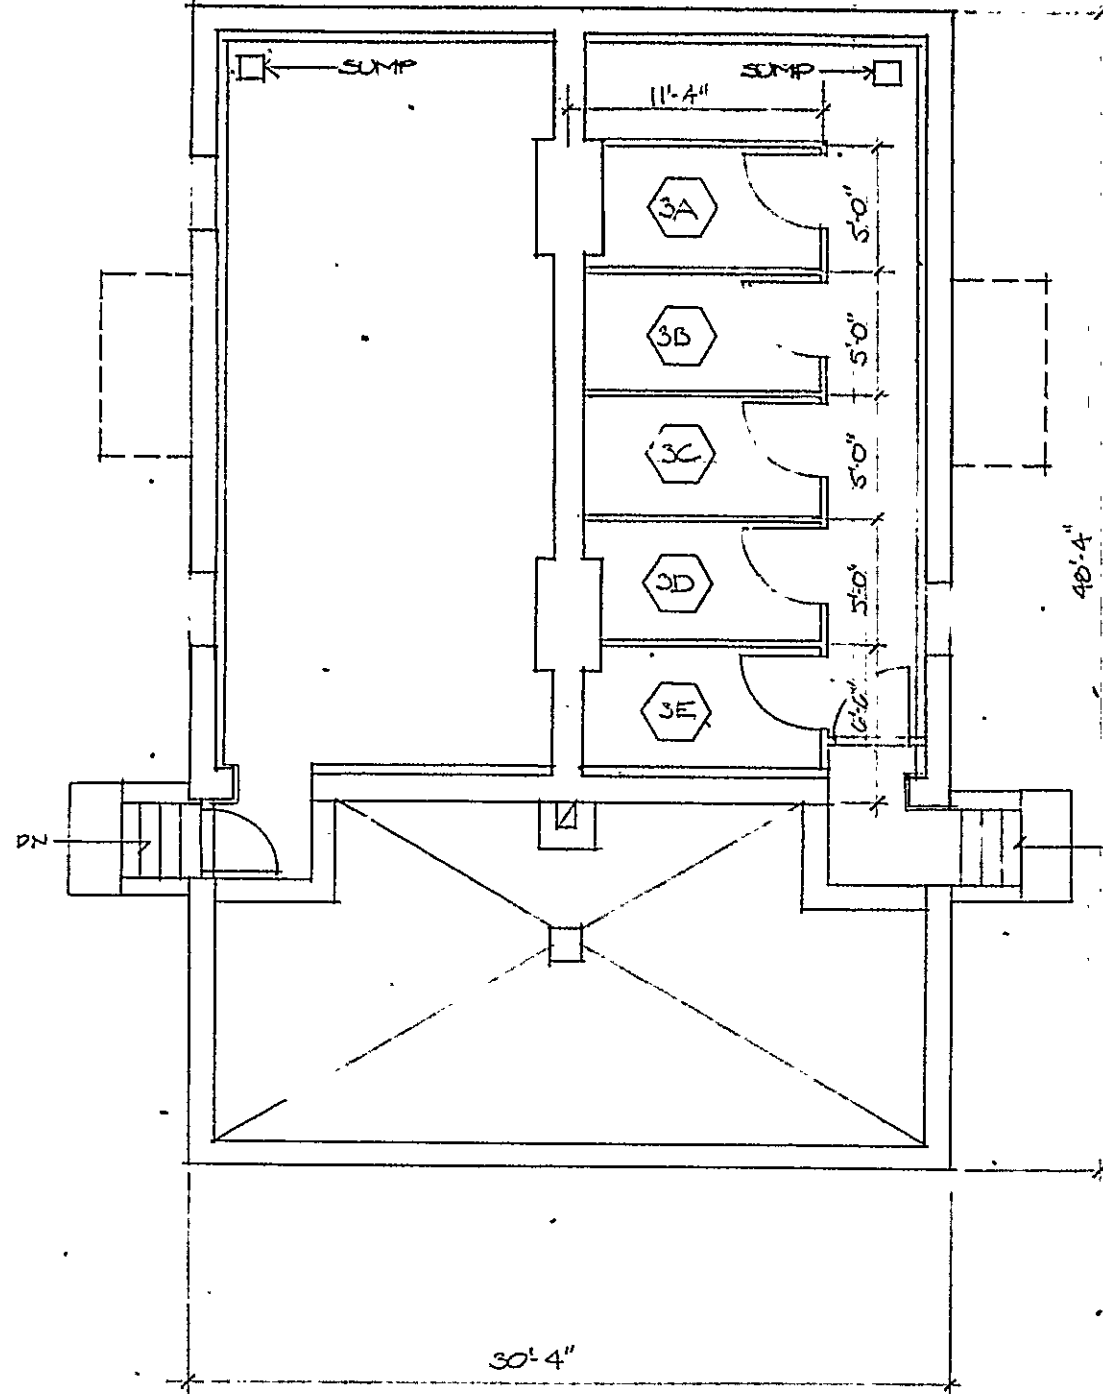


1 BASEMENT BLDG 3  
1/8" = 1'-0"

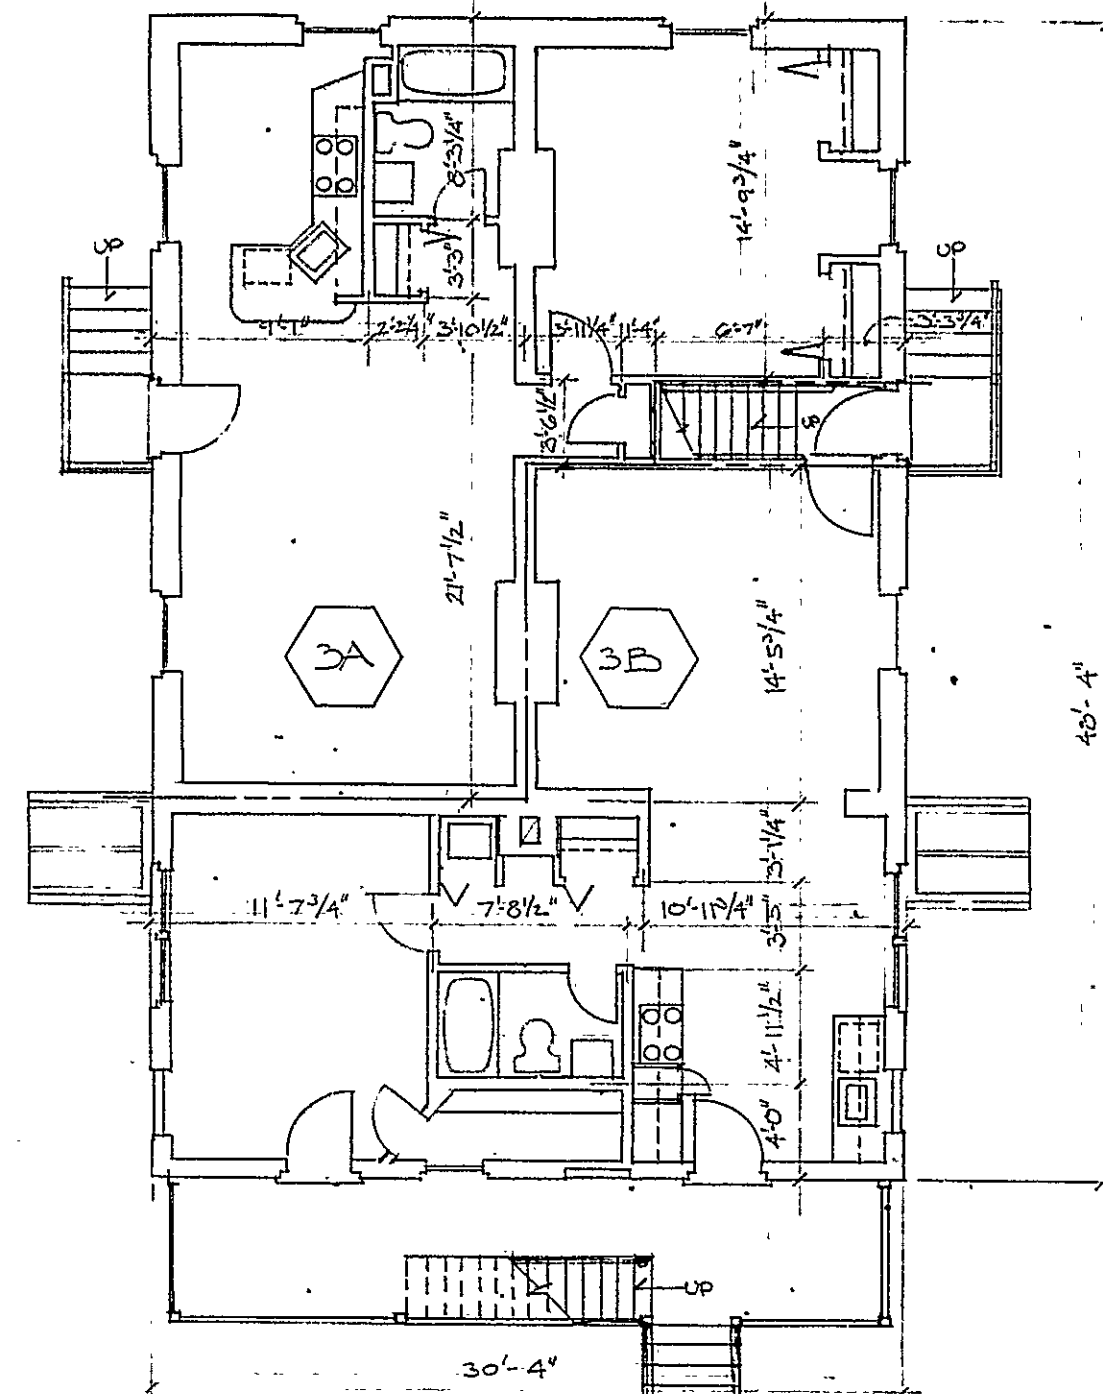


2 FIRST FLOOR BLDG 3  
1/8" = 1'-0"

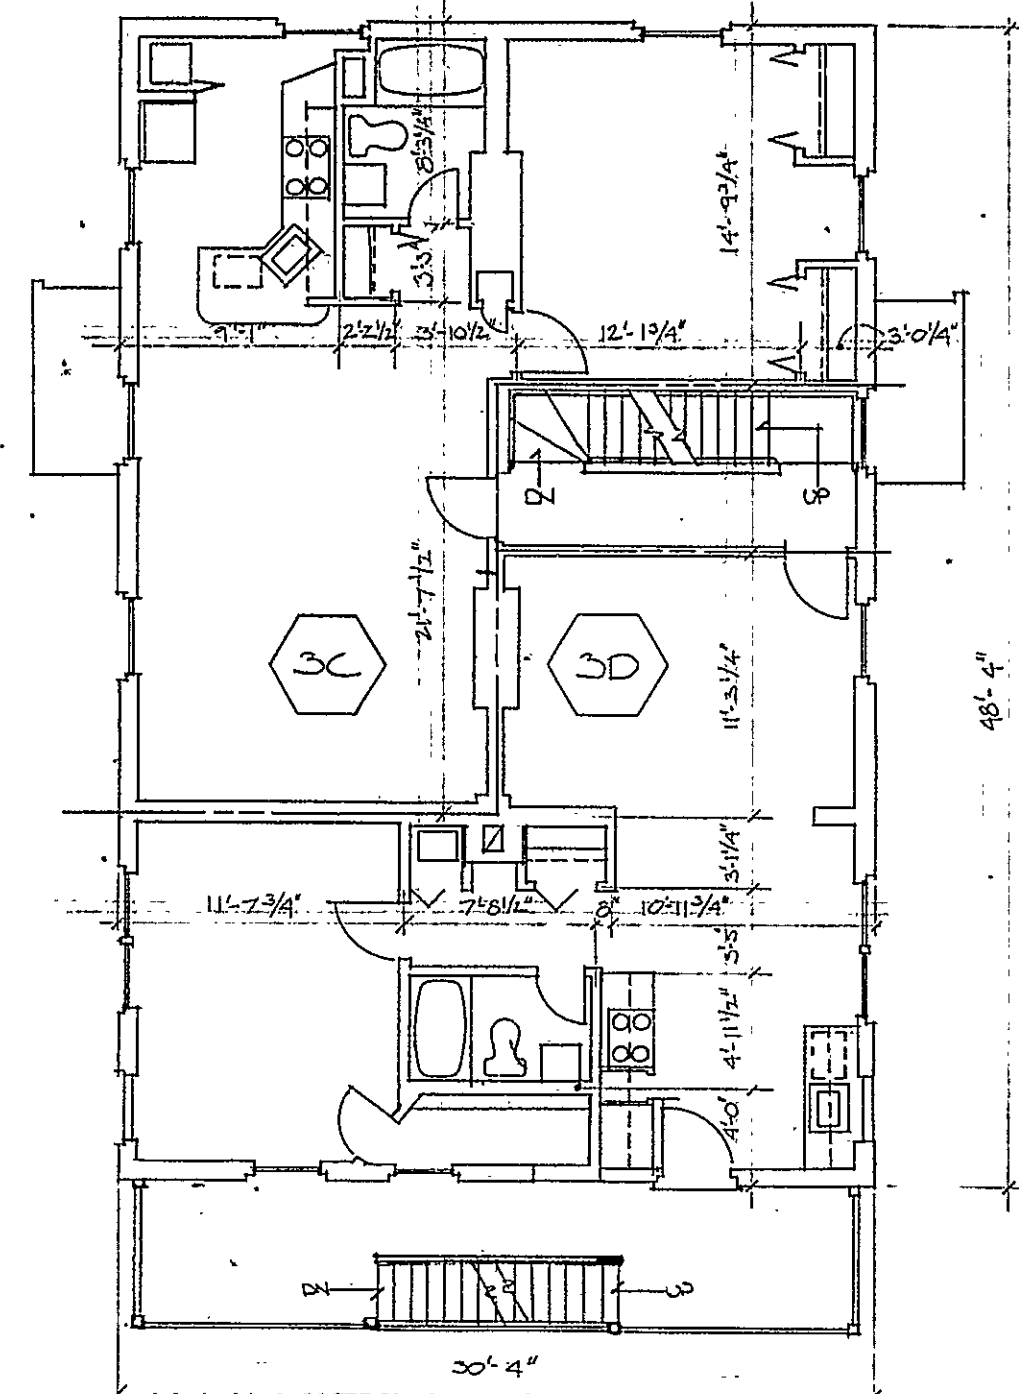


3 SECOND FLOOR BLDG 3  
1/8" = 1'-0"

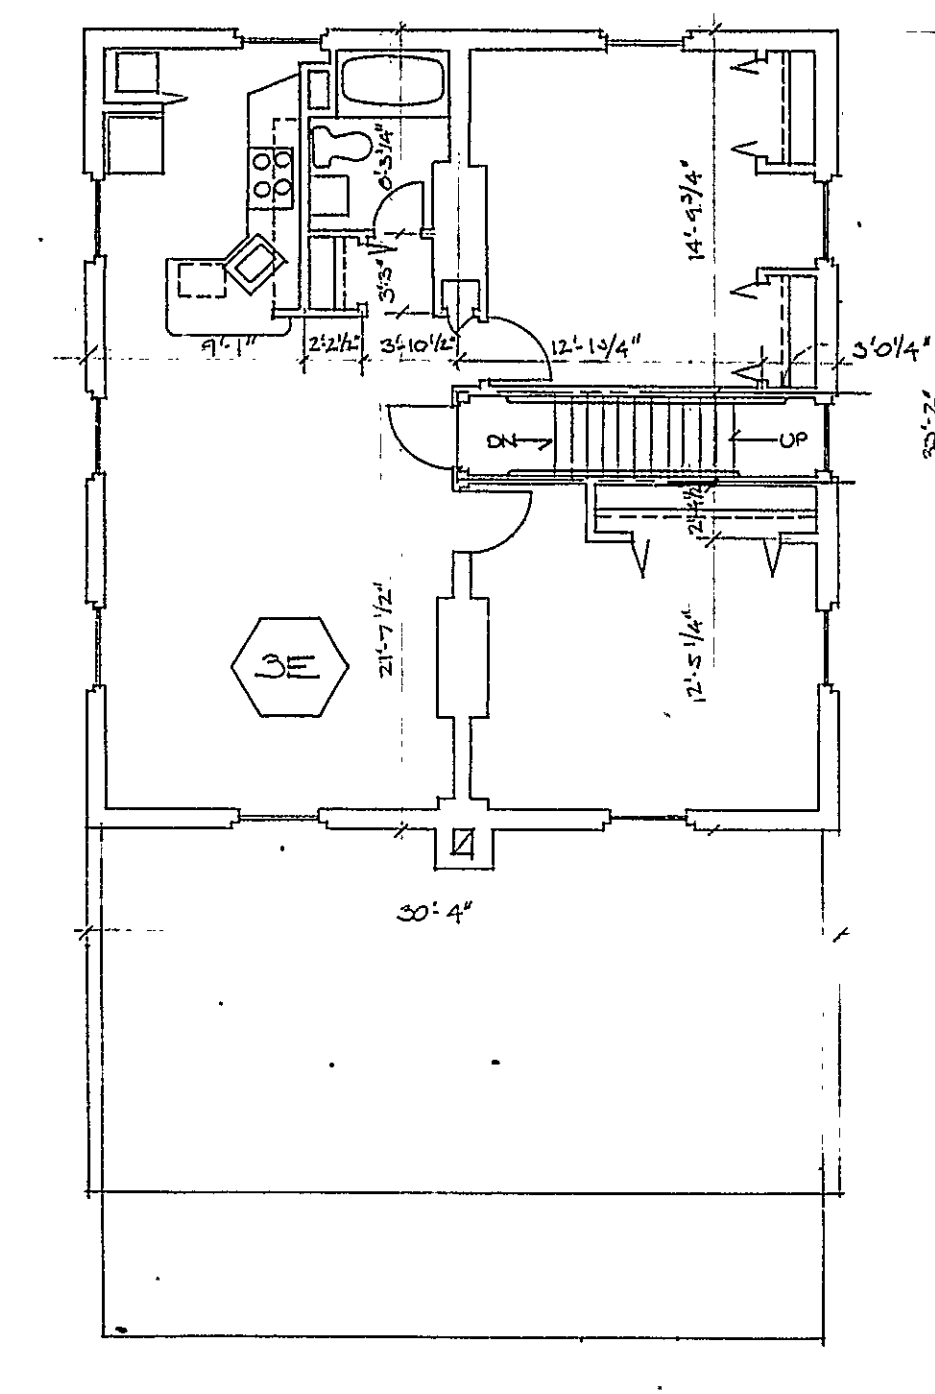


4 THIRD FLOOR BLDG 3  
1/8" = 1'-0"

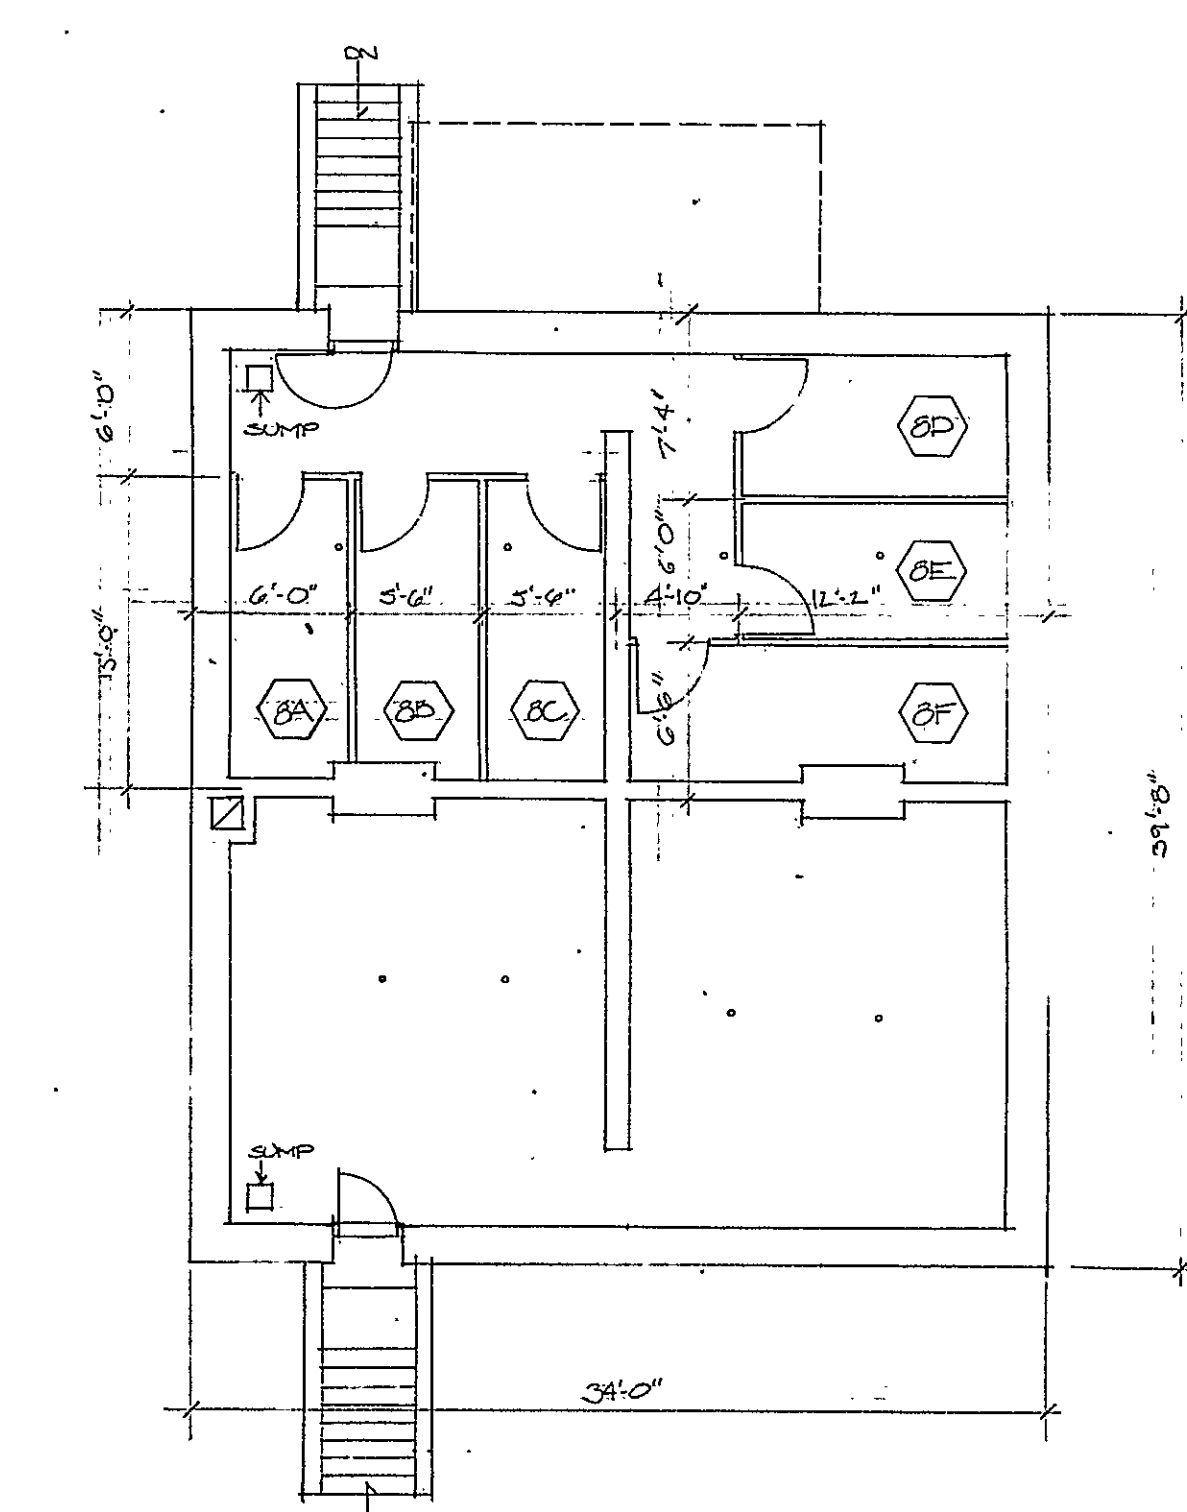


5 BASEMENT BLDG 8  
1/8" = 1'-0"  
CEILING HEIGHT -

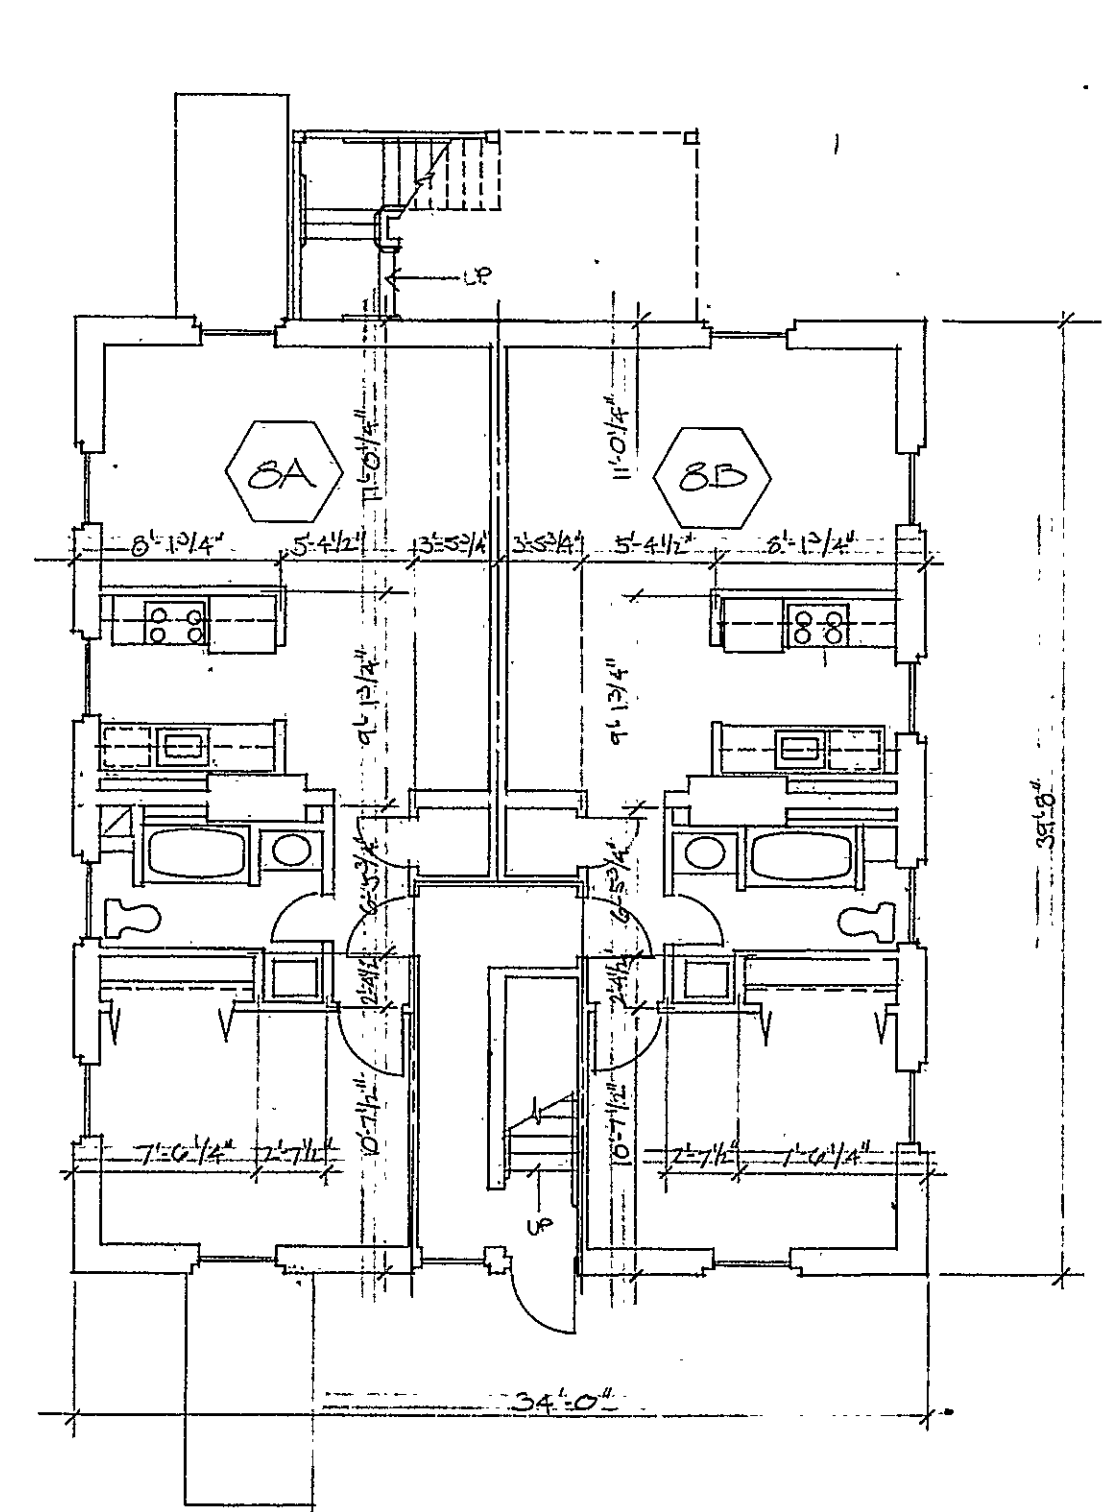


6 FIRST FLOOR BLDG 8  
1/8" = 1'-0"  
CEILING HEIGHT 7'-0 1/2"

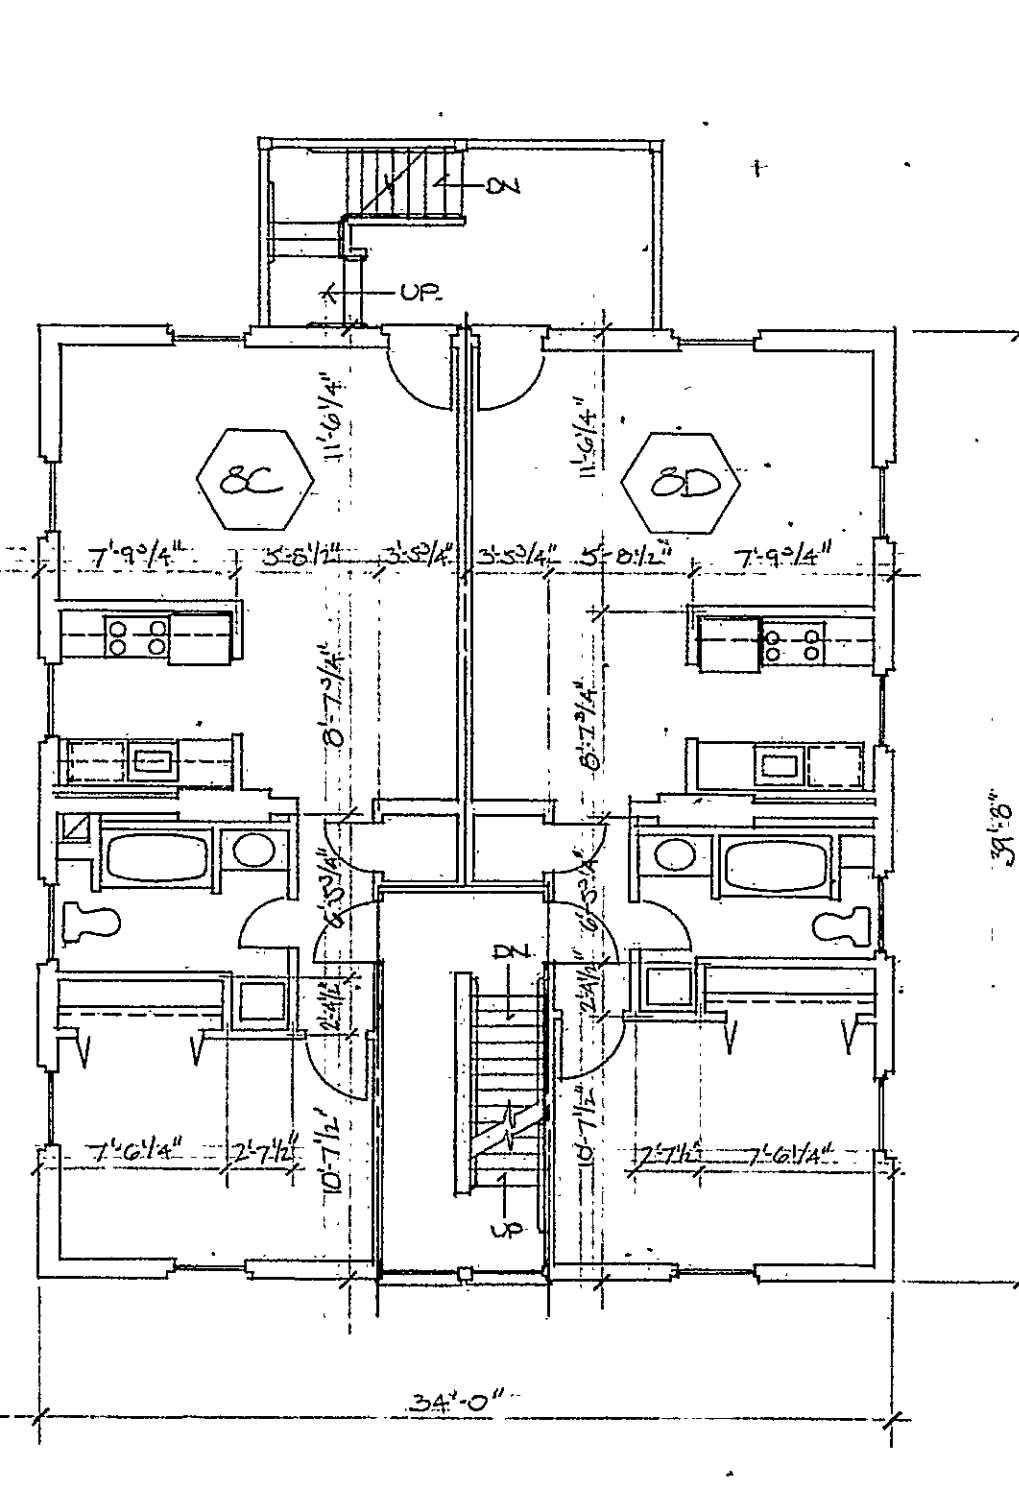

7 SECOND FLOOR BLDG 8  
1/8" = 1'-0"  
CEILING HEIGHT 8'-0"

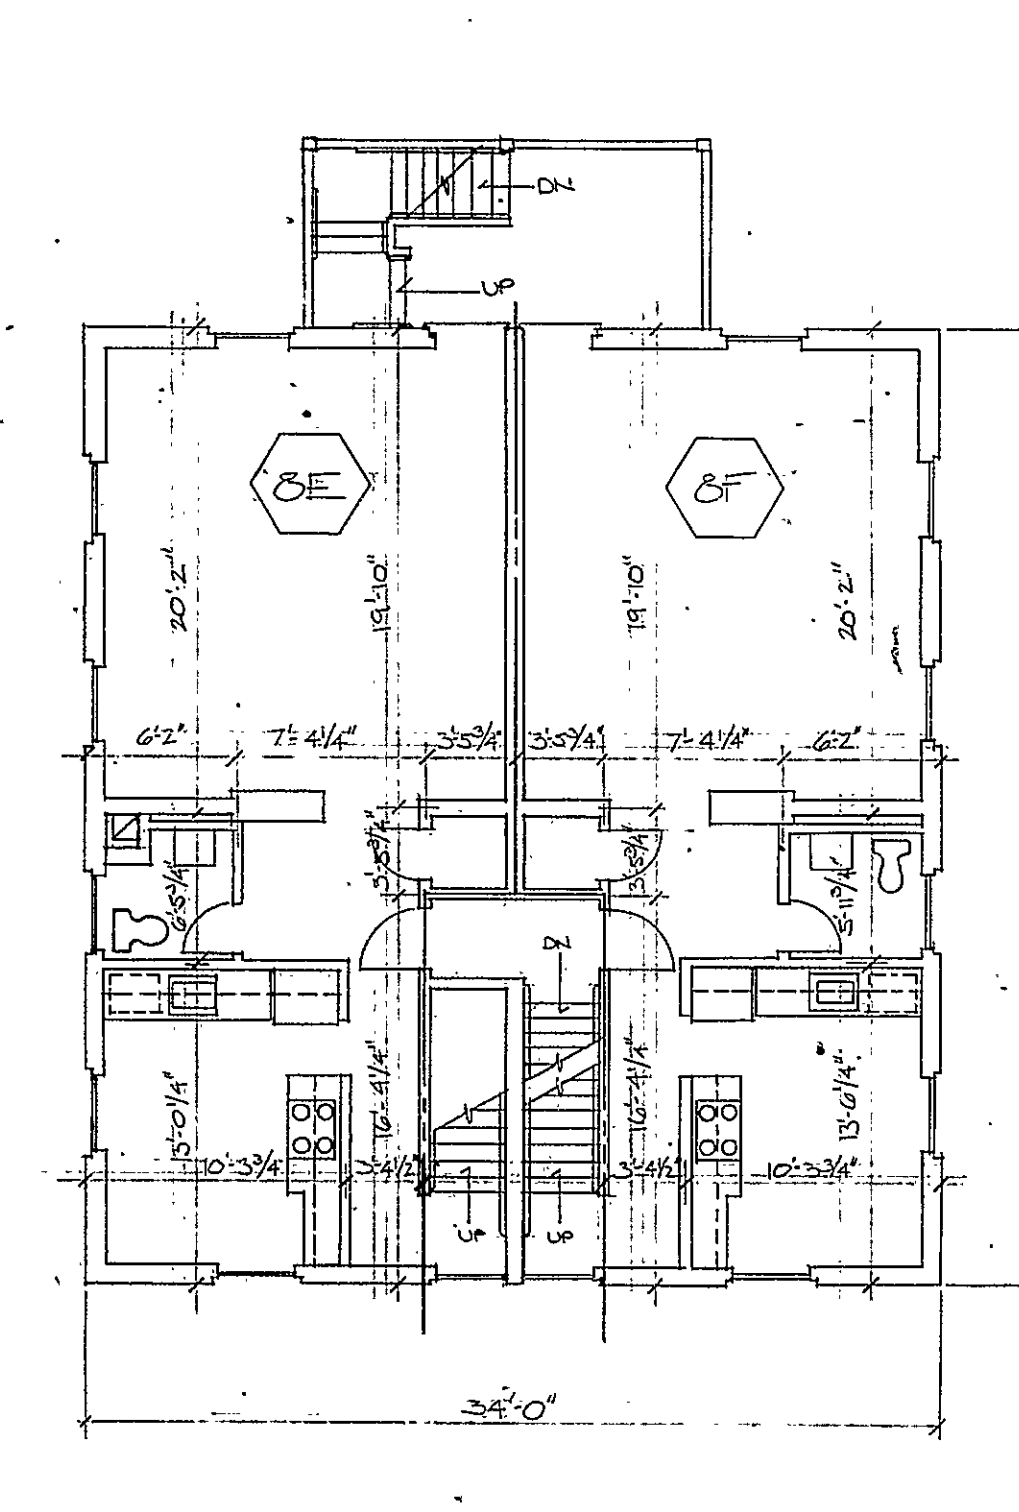

8 THIRD FLOOR BLDG 8  
1/8" = 1'-0"  
CEILING HEIGHT 7'-0"

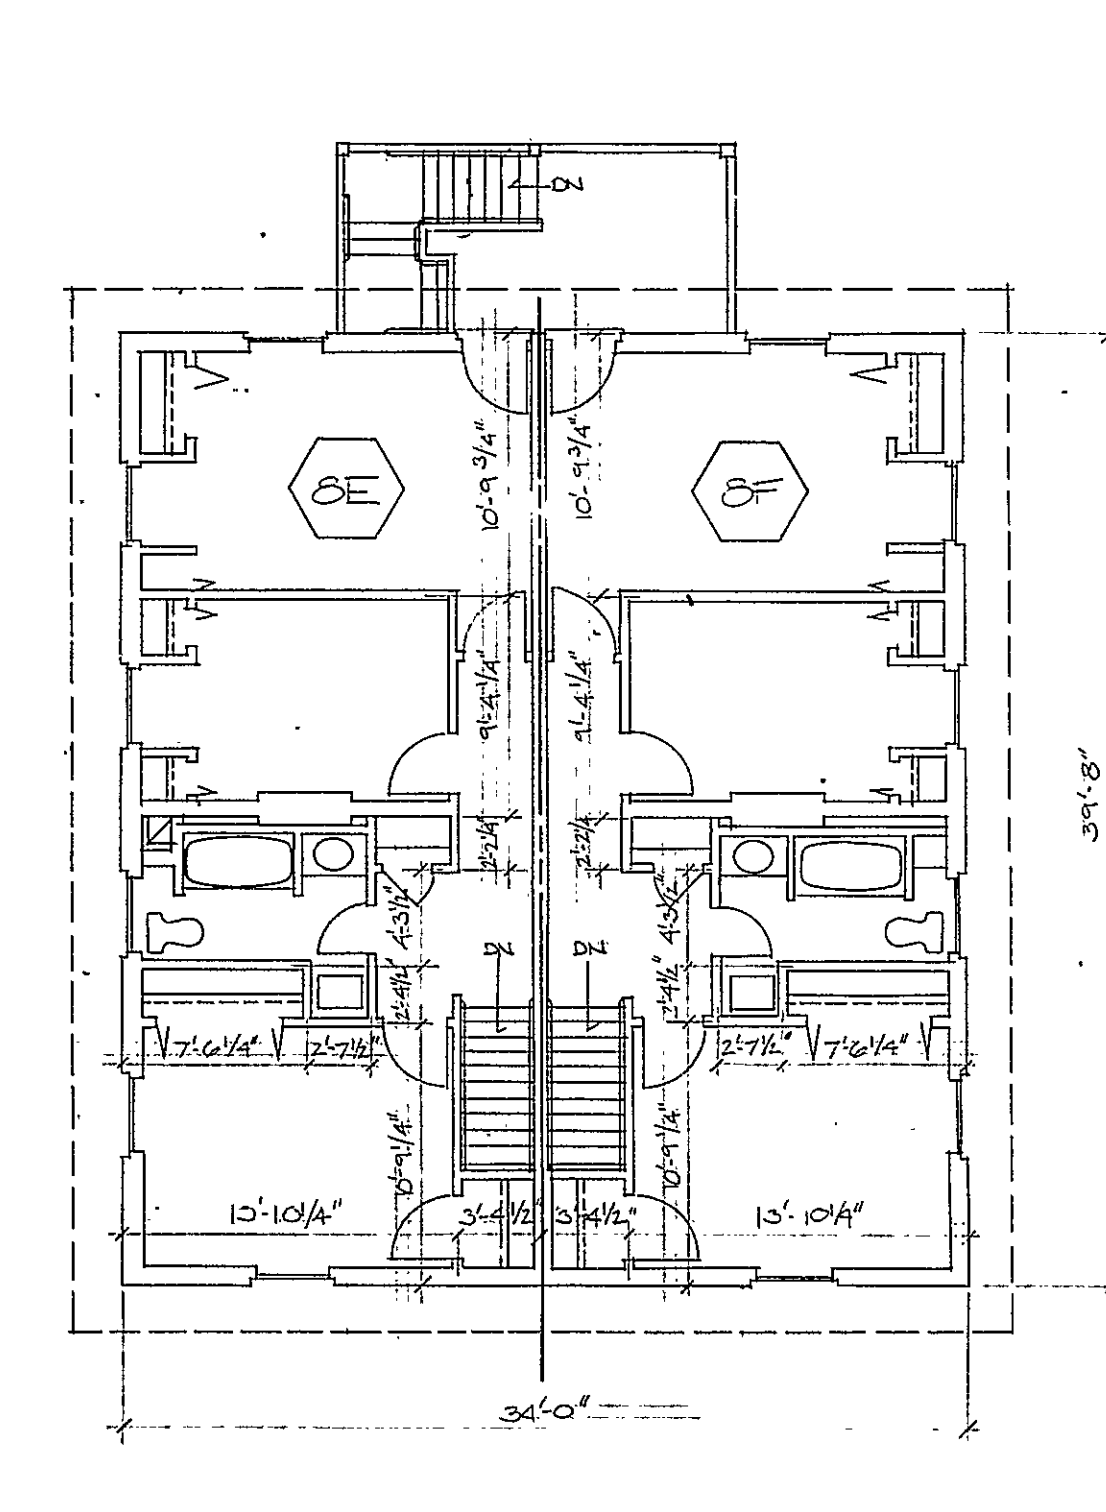

9 FOURTH FLOOR BLDG 8  
1/8" = 1'-0"  
CEILING HEIGHT 5'-6 1/2" TO 7'-9"

HUD SUBMISSION - NOT FOR LEGAL USE Nov 12, 1980

