
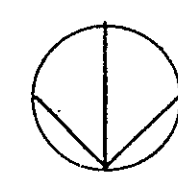
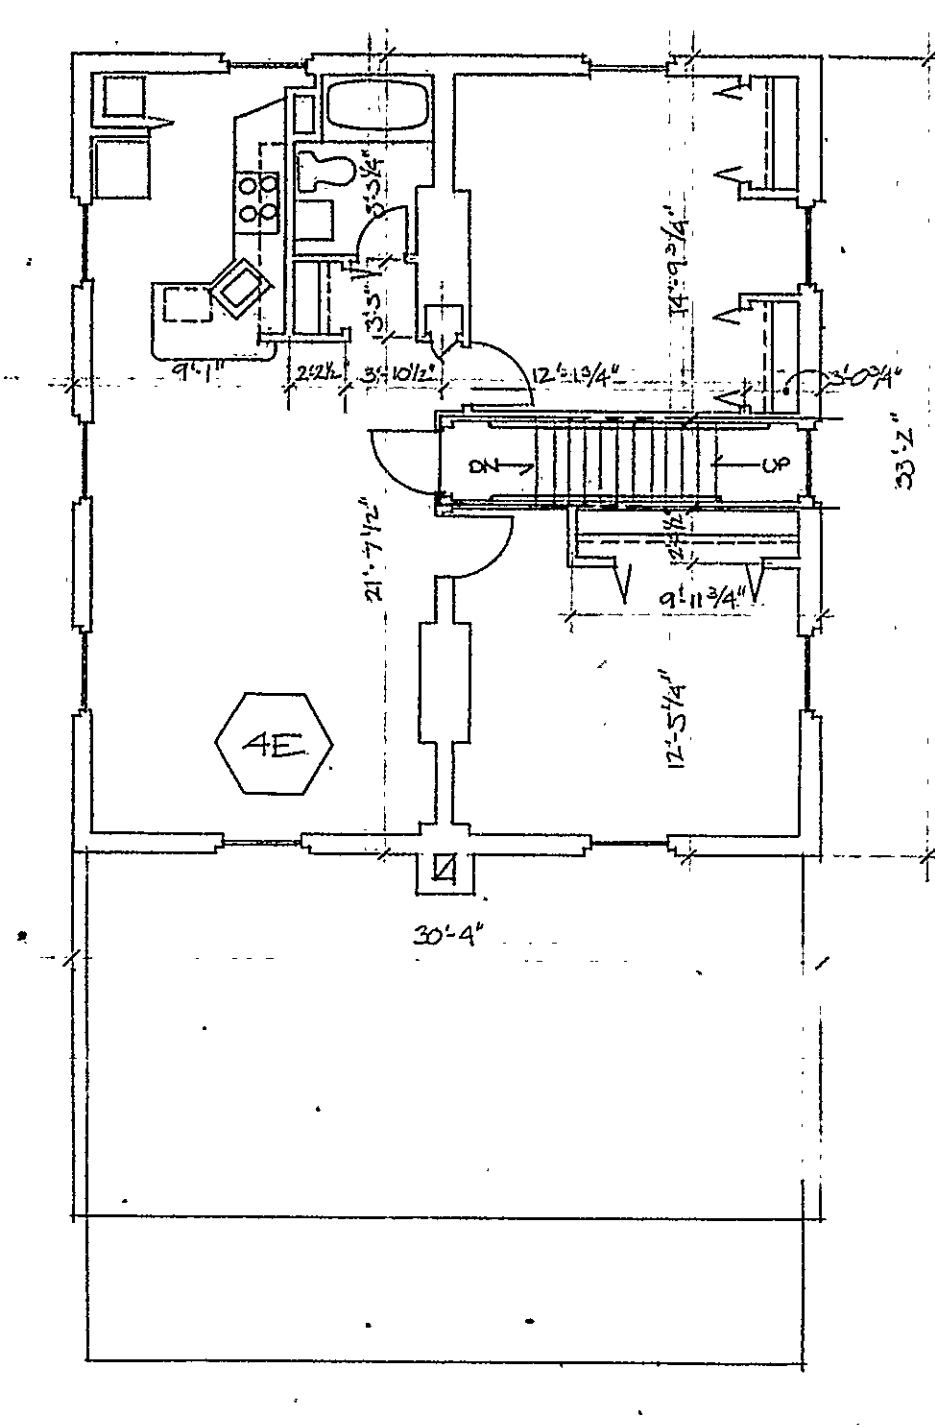
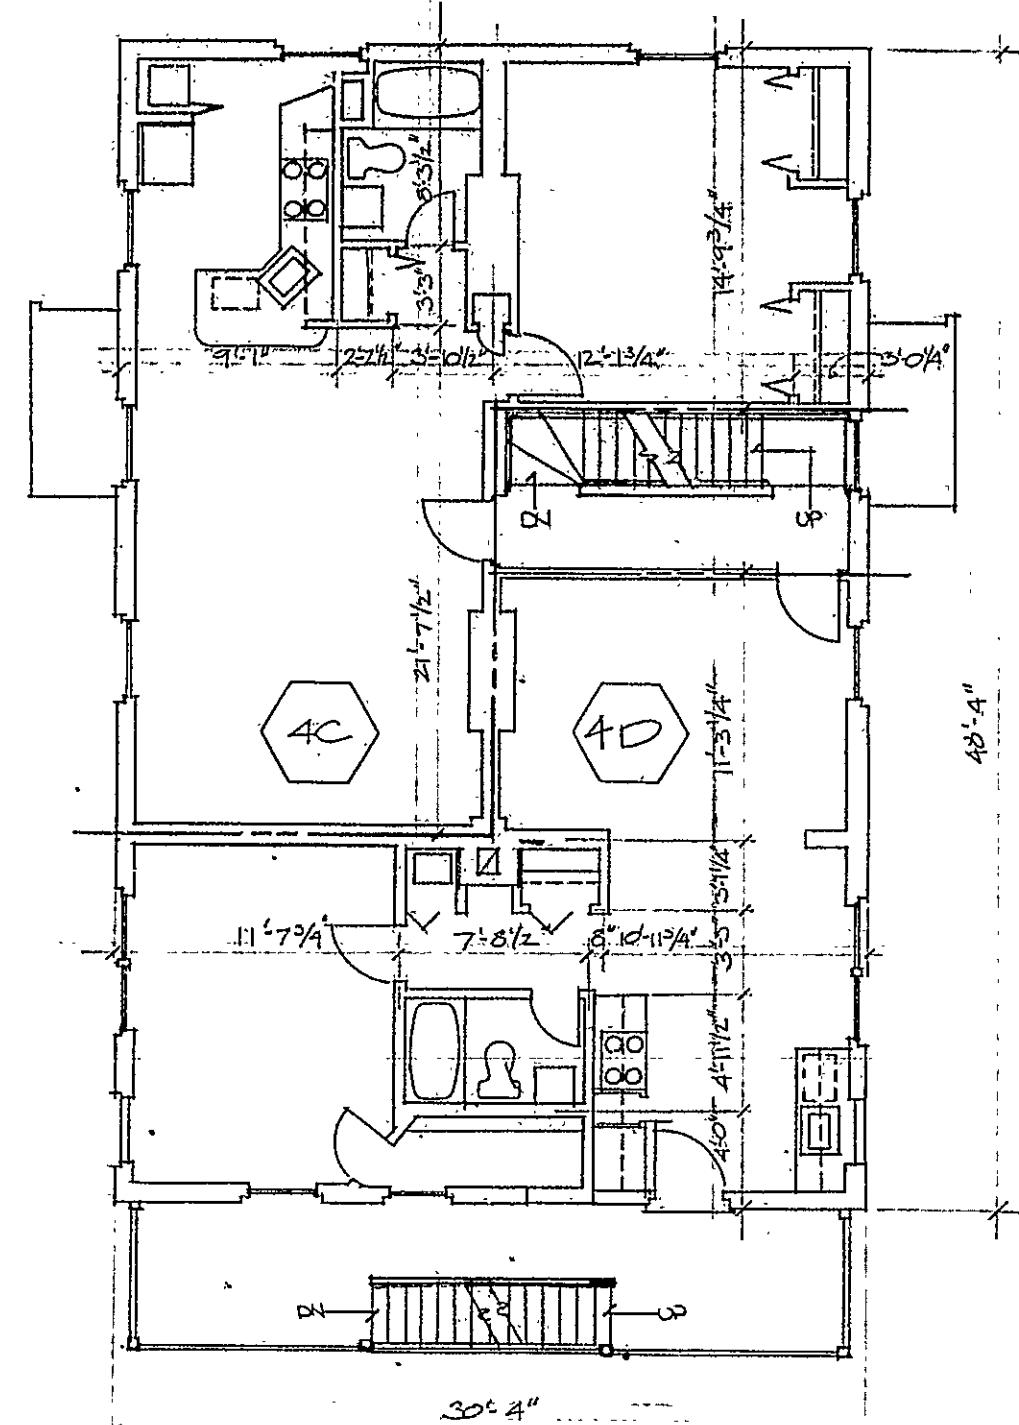
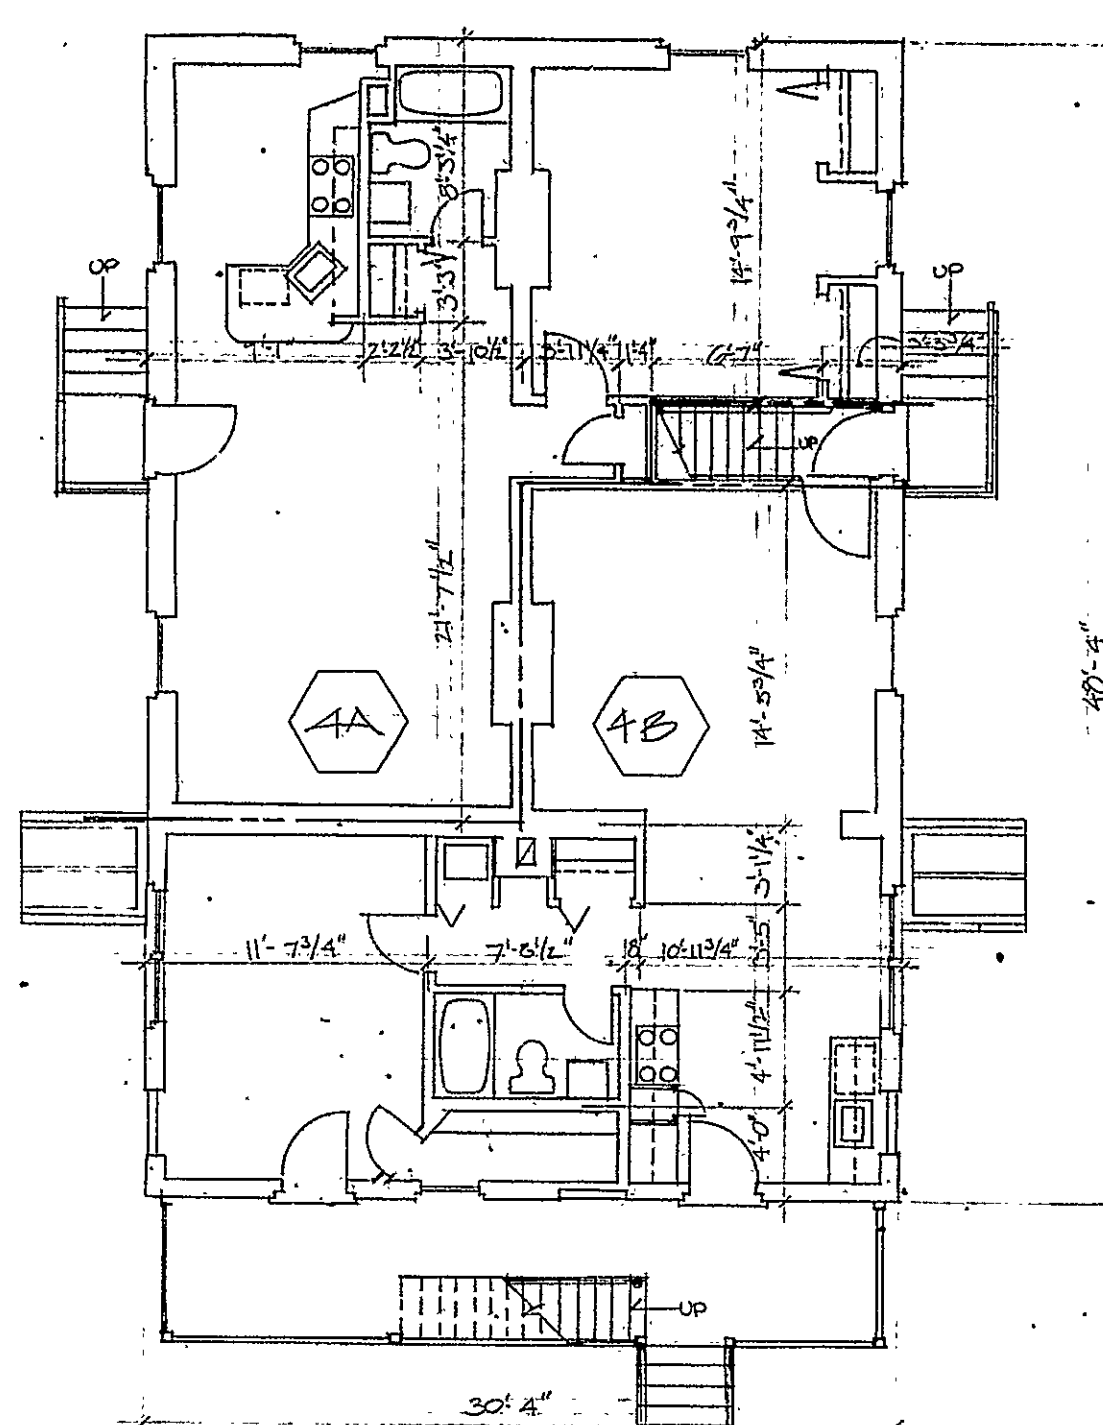


RECEIVED BY
SEP 21 4 05 PM '81
TOWN & CITY CLERK
HARTFORD
VOL. _____ PAGE _____

NOTE: DIMENSIONAL TOLERANCES

PLANS SHOW RENOVATED BUILDINGS APPROXIMATELY 100 YEARS OLD. ONLY EXTERIOR OVERALL DIMENSIONS SHOWN AS ACTUAL ARE EXACT. ALL INTERIOR DIMENSIONS AND NOMINAL EXTERIOR OVERALL DIMENSIONS ARE BASED ON OBSERVATIONS AND MEASUREMENTS OF TYPICAL BUILDINGS, CHIEFLY BUILDINGS NO. 5 AND NO. 10.
SOME VARIATIONS IN WINDOW LOCATIONS OCCUR.
ACTUAL EXTERIOR OVERALL DIMENSIONS ARE FROM THE SURVEY OF COLT, ESTATE OF SEVENTH TRUST ASSOCIATES, PREPARED BY JAMES J. LUZZI RE. AND L.S., CONN. REG. NO. 9415 DATED SEPT 10, 1980.
THE LOCATION AND AMOUNT OF VARIATION BETWEEN THE TYPICAL INTERIOR DIMENSIONS SHOWN AND ACTUAL INTERIOR DIMENSIONS ARE NOT SHOWN IN THESE PLANS.






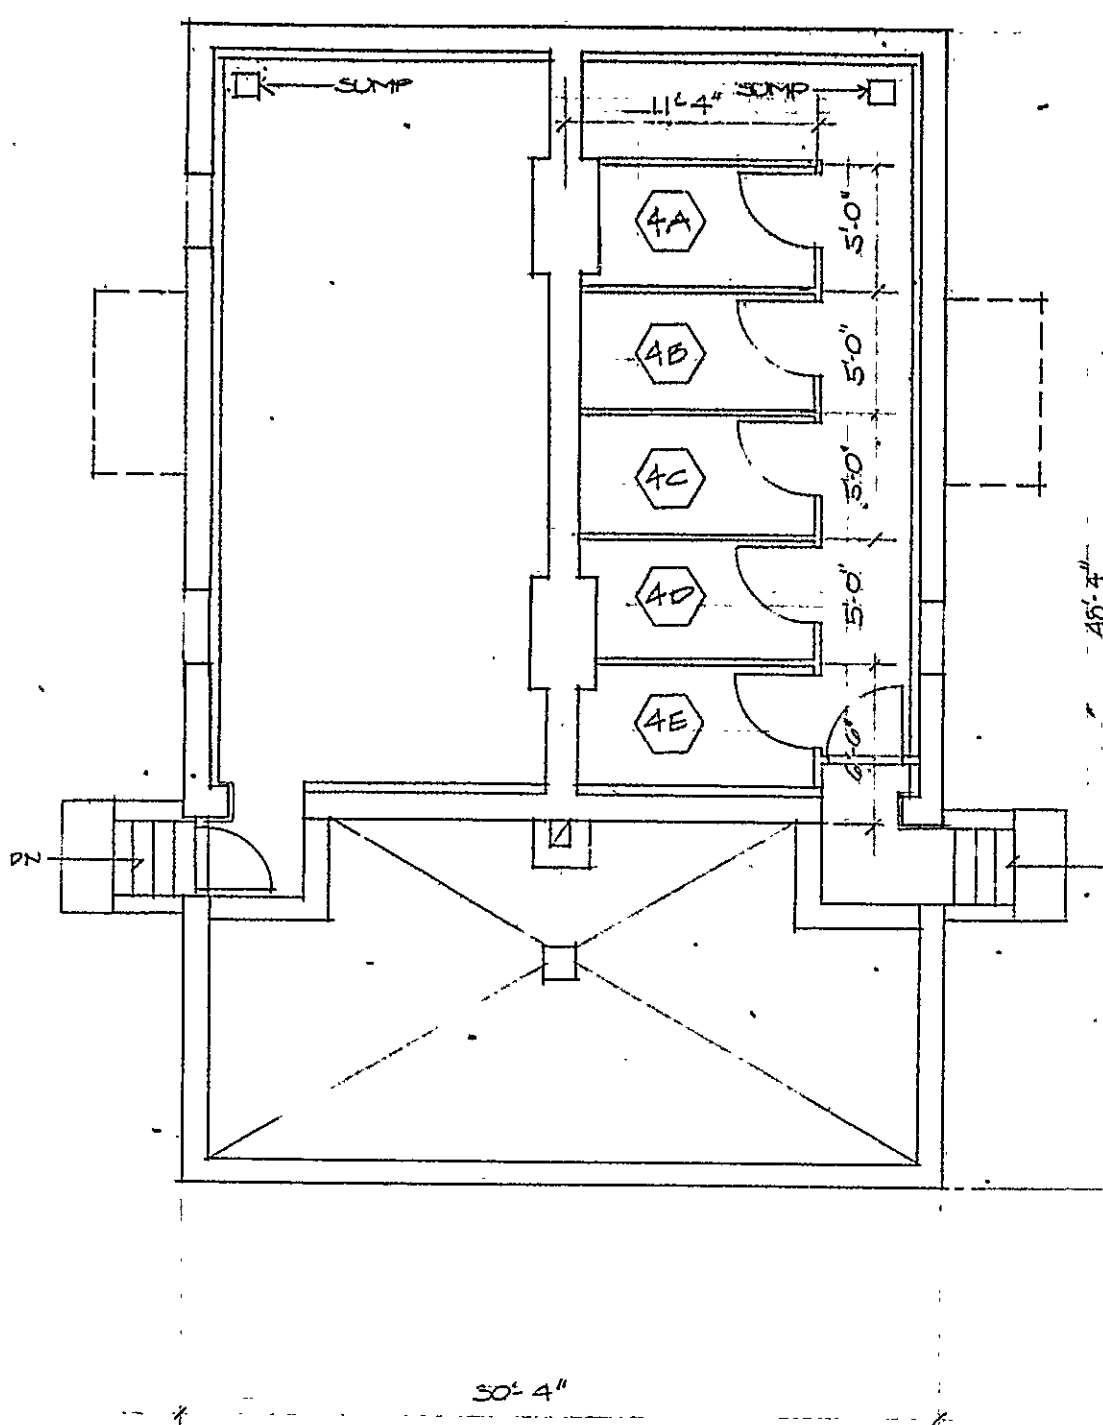


1 BASEMENT BLDG 4
1/8" = 1'-0"
CEILING HEIGHT 6'-1 1/4"

2 FIRST FLOOR BLDG 4
1/8" = 1'-0"
CEILING HEIGHT 8'-3 3/4"

3 SECOND FLOOR BLDG 4
1/8" = 1'-0"
CEILING HEIGHT 7'-9 1/4"

4 THIRD FLOOR BLDG 4
1/8" = 1'-0"
CEILING HEIGHT 6'-3" TO 7'-5 1/2"

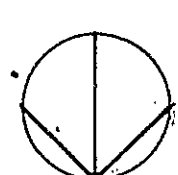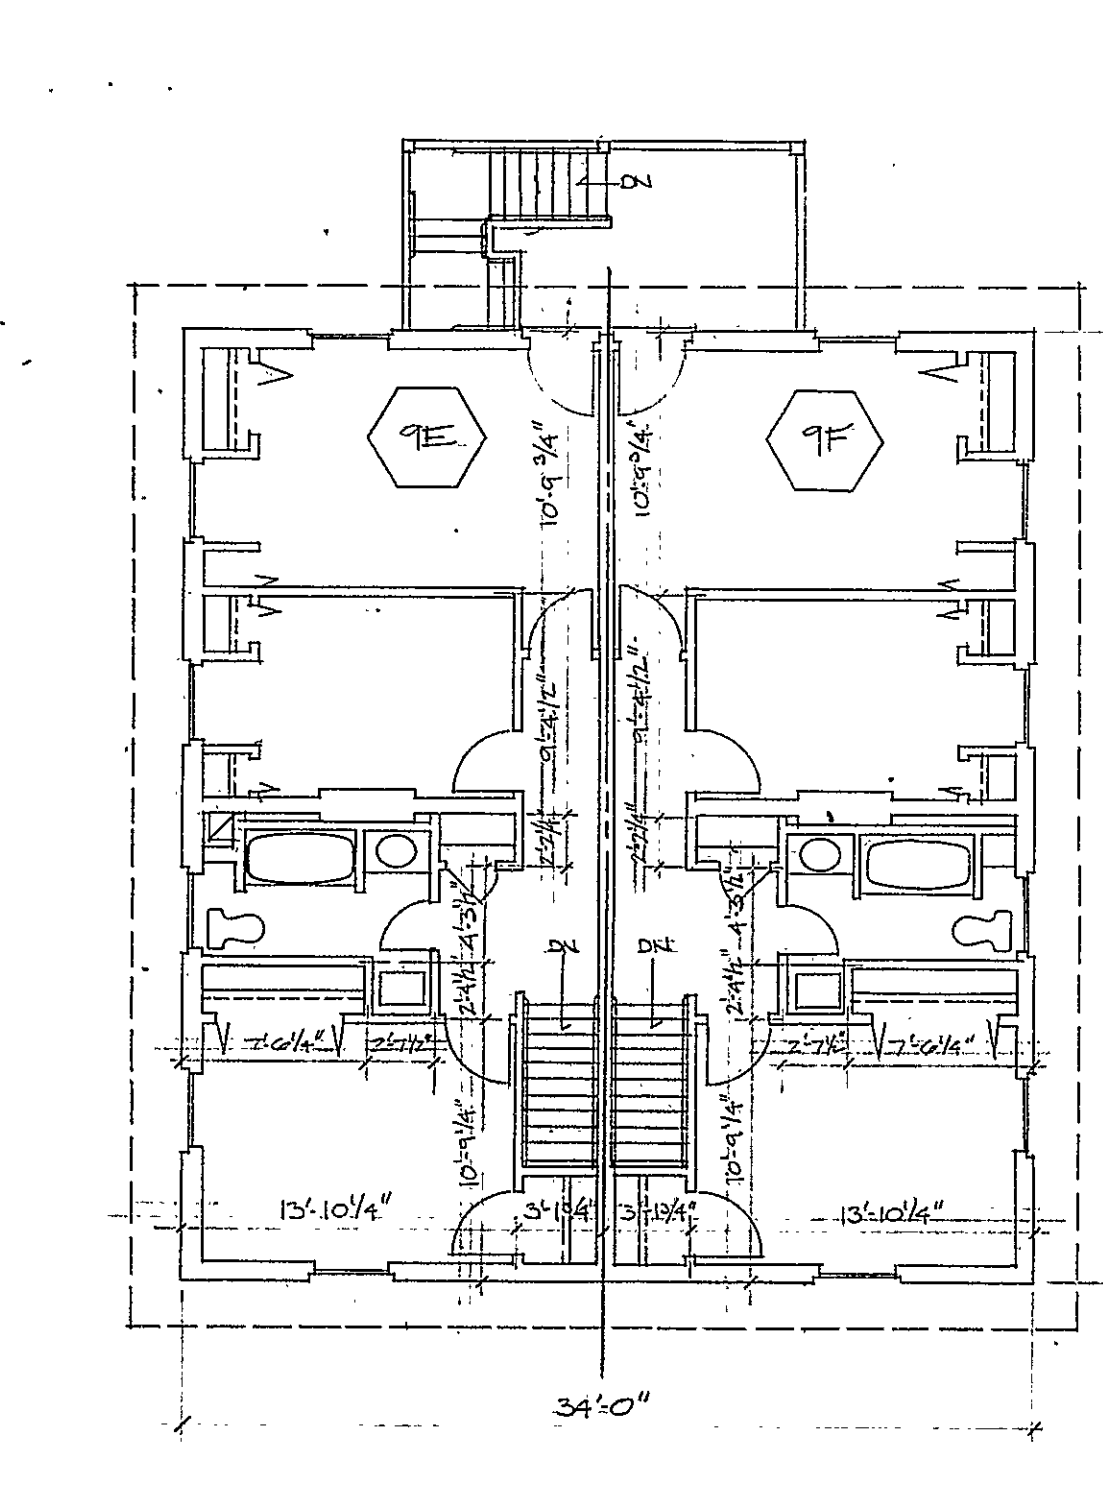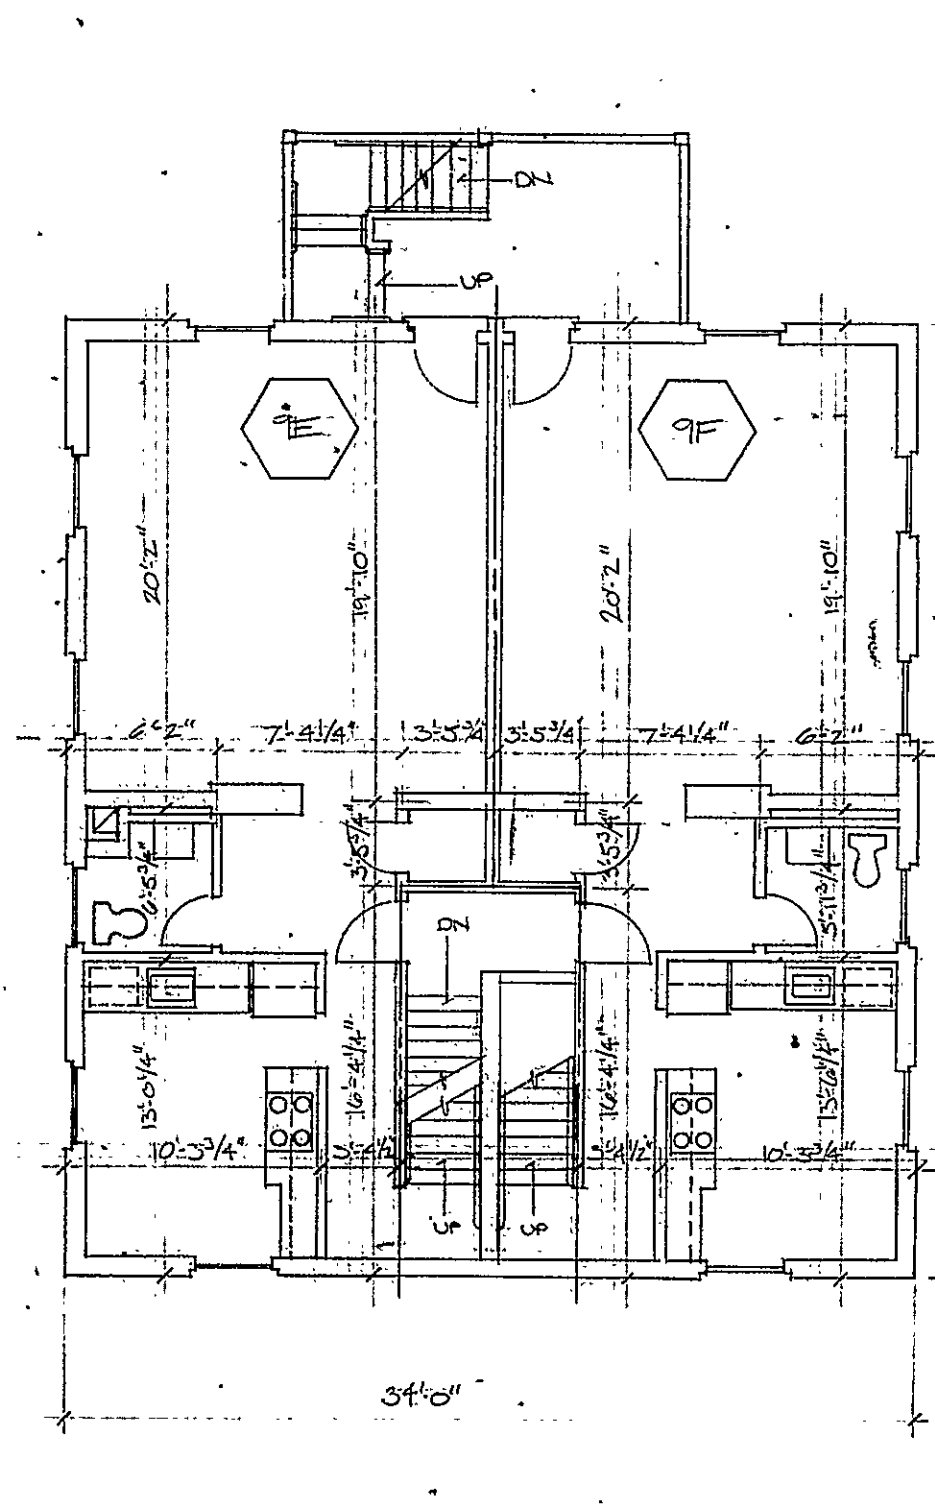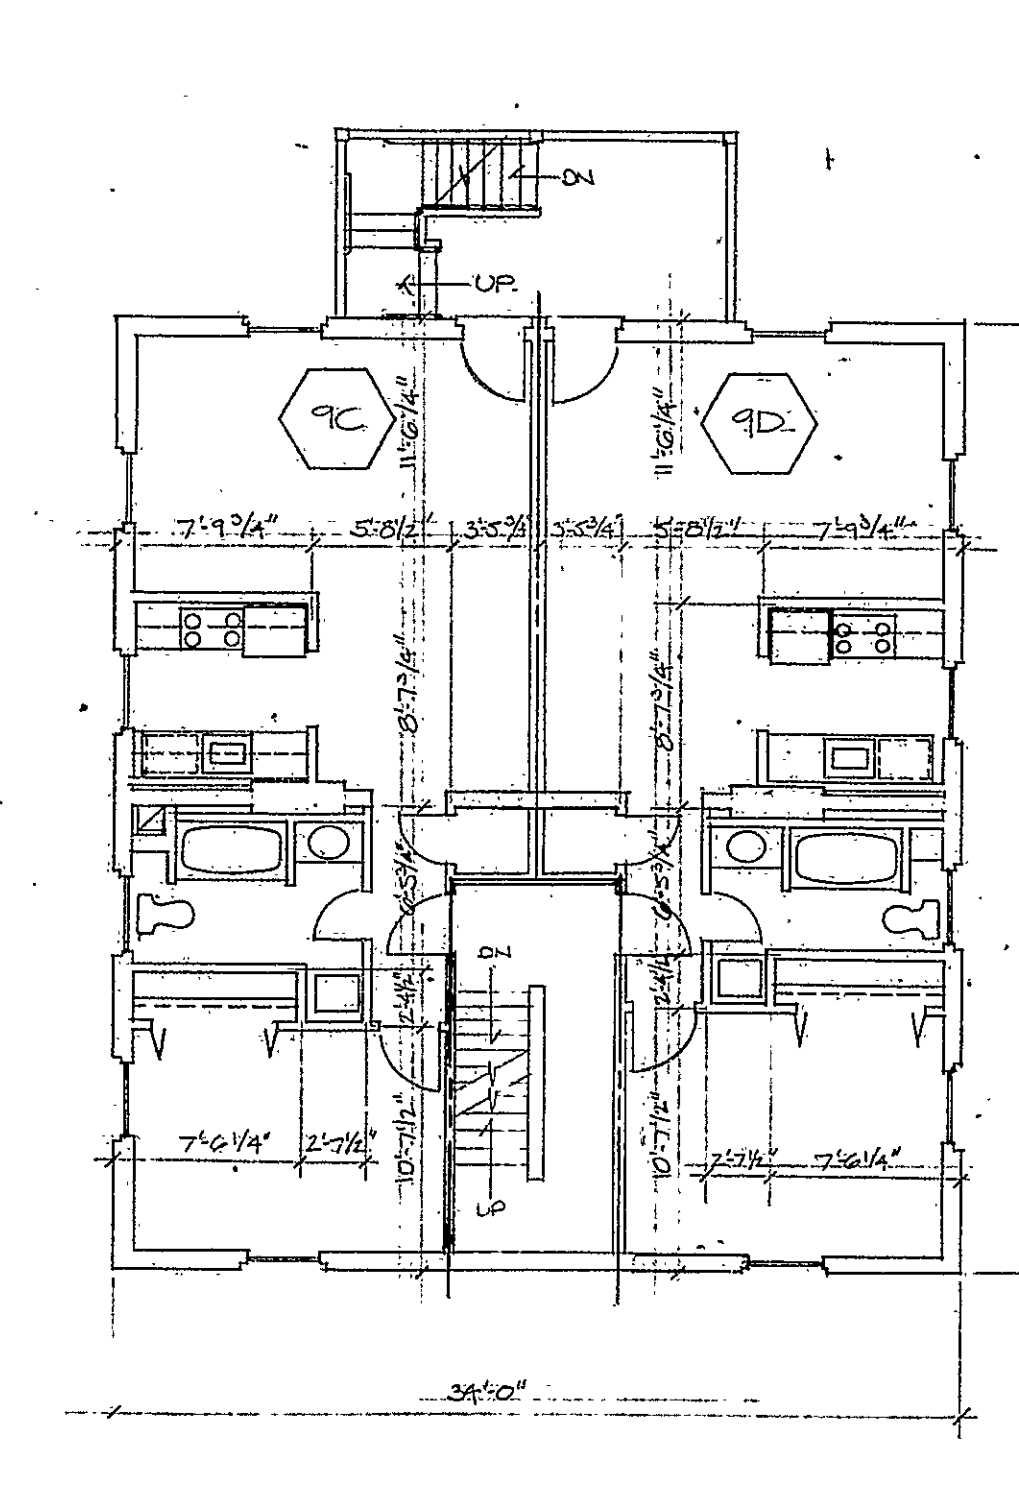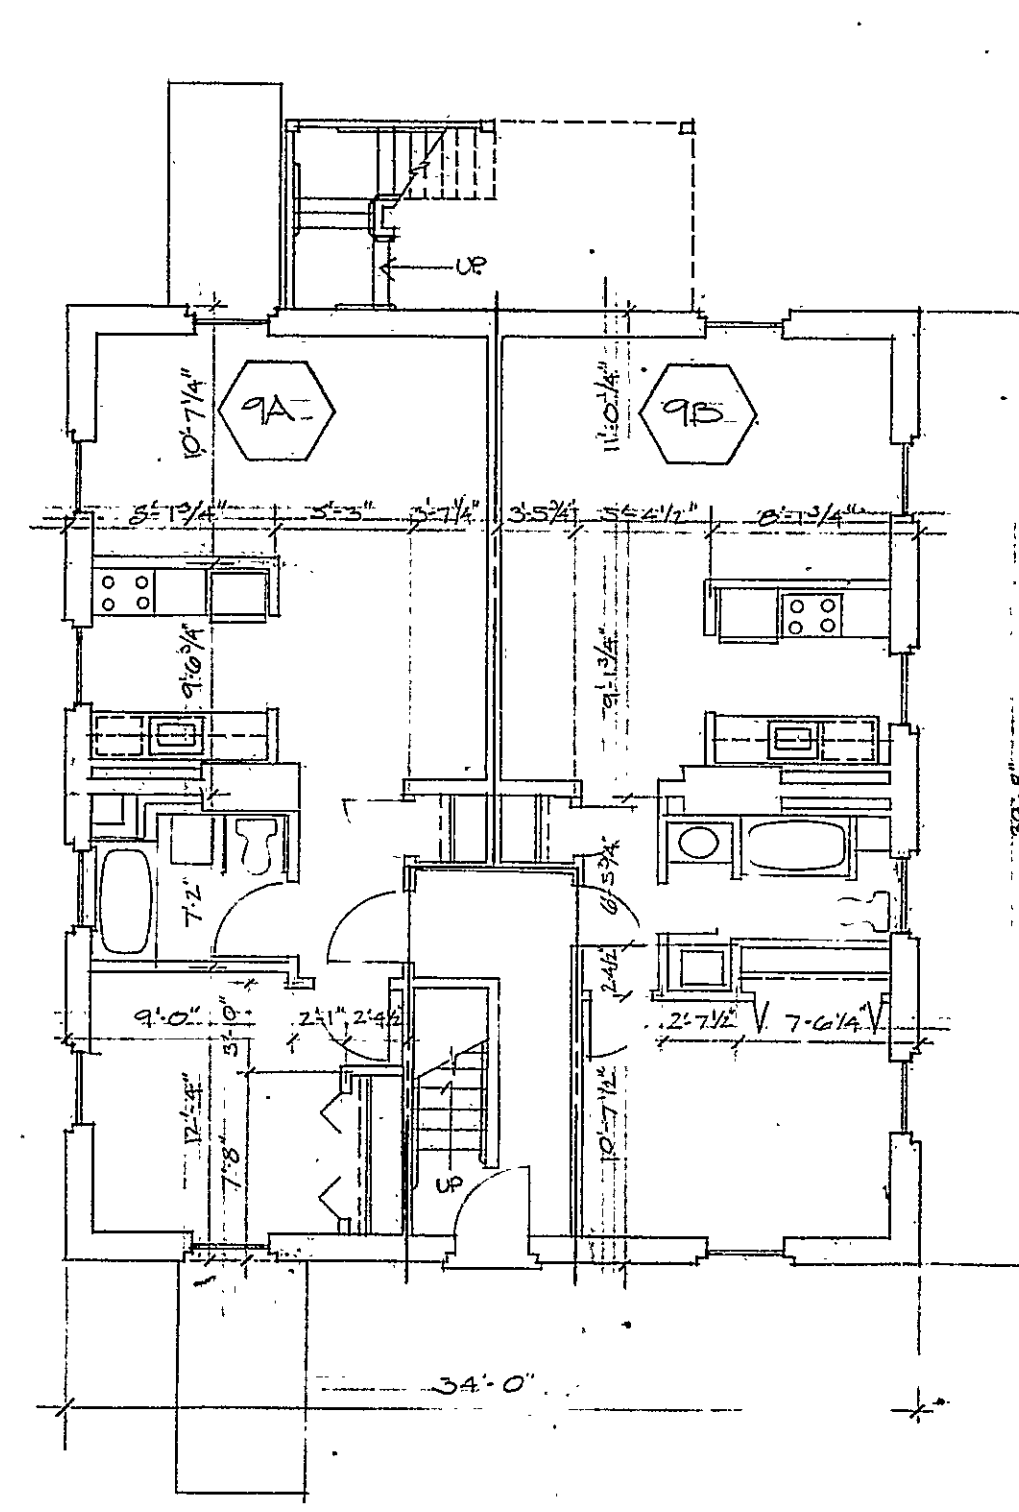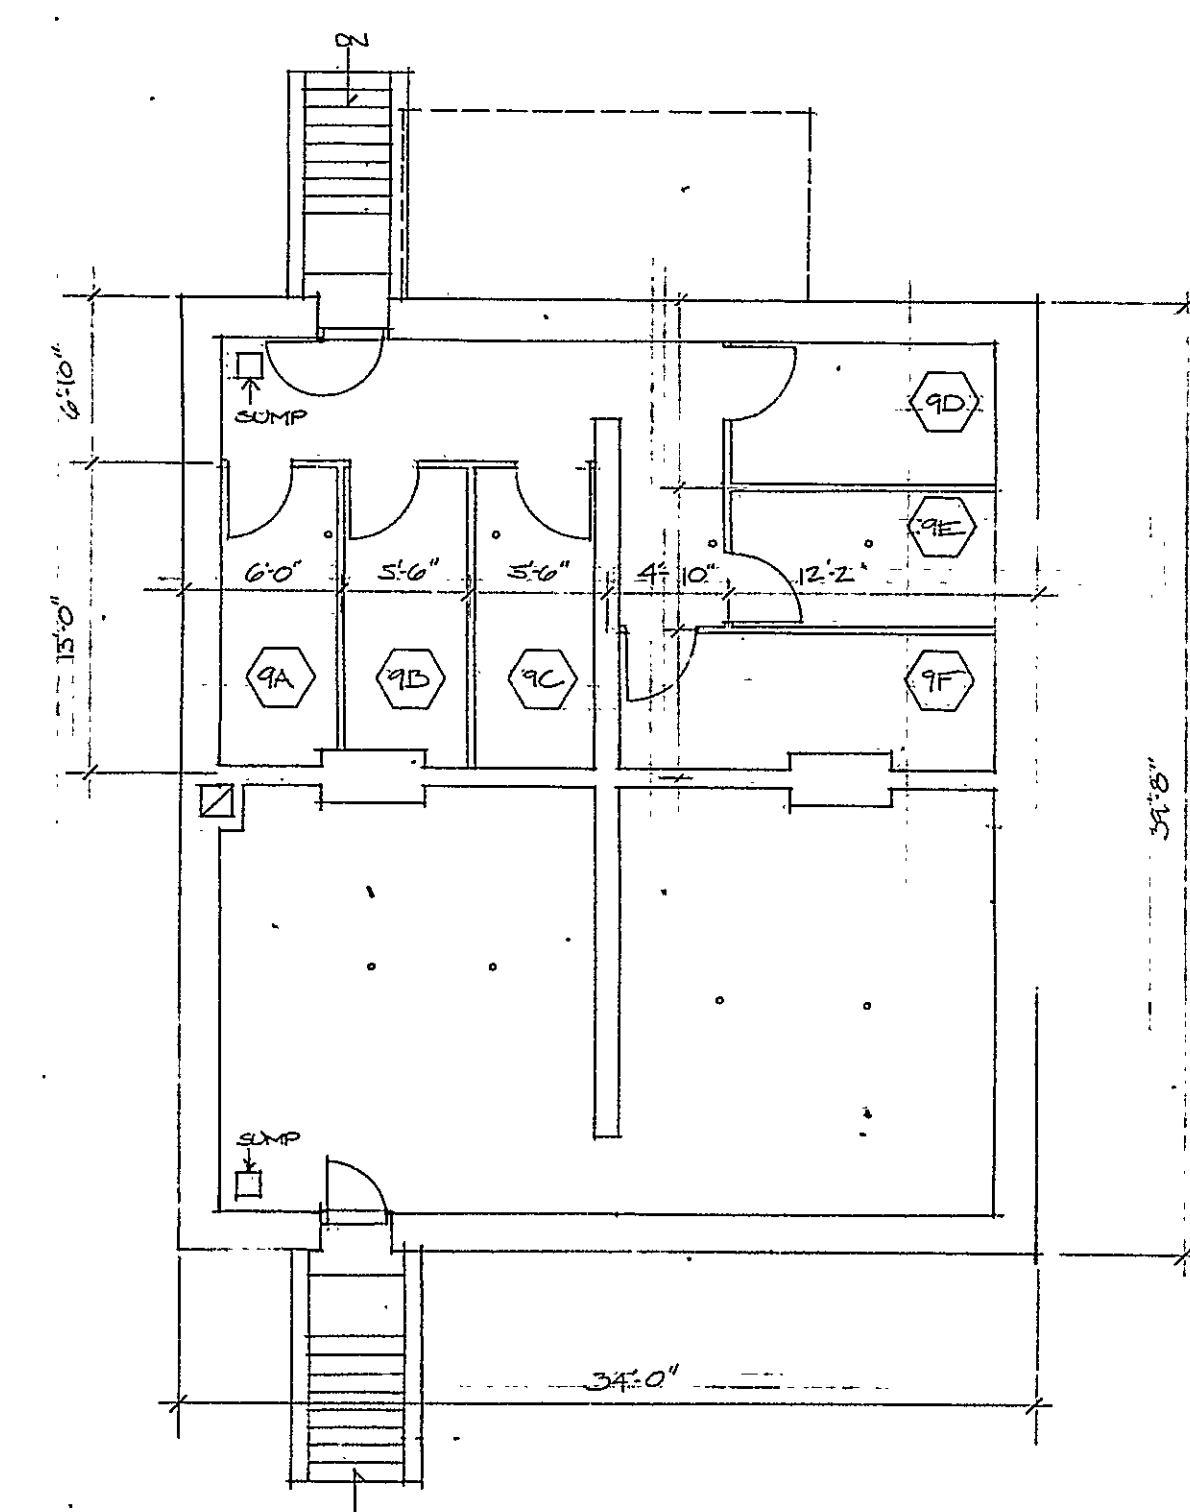

5 BASEMENT BLDG 9
1/8" = 1'-0"
CEILING HEIGHT 7'-11 3/4"

6 FIRST FLOOR BLDG 9
1/8" = 1'-0"
CEILING HEIGHT 7'-11 3/4"


7 SECOND FLOOR BLDG 9
1/8" = 1'-0"
CEILING HEIGHT 8'-10 1/4"

8 THIRD FLOOR BLDG 9
1/8" = 1'-0"
CEILING HEIGHT 7'-11 3/4"

9 FOURTH FLOOR BLDG 9
1/8" = 1'-0"
CEILING HEIGHT 6'-0" TO 6'-7"

REVISIONS	BY


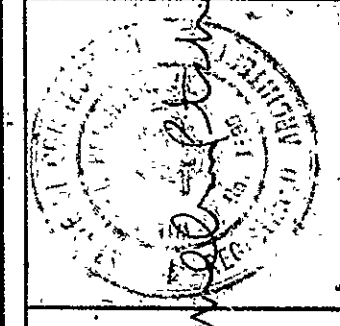

CONDOMINIUM
PLANS
BLDG 4 AND 9

COLT ESTATES I
HARTFORD
AND CT DEED-94024

DATE	
CHECKED	
DRAWN	
JOB	
SHEET	
SHEETS	

HOD SUBMISSION - NOT FOR LEGAL USE NOV 12, 1980