

RECEIVED BY
SEP 14 4 06 PM '81
TOWN & CITY CLERK
HARTFORD
VOL. _____ PAGE _____

REVISIONS	BY


84 WILLOW STREET NEW HAVEN, CONNECTICUT 06511
TELEPHONE 767-8887
WILLIAM PEITCHER
ARCHITECT

CONDOMINIUM
PLANS
FLOORS 5 AND 10


COLT ESTATES I
HARTFORD HUD CT 06103-0483
SCIENTIFIC ASSOCIATES
FOR ESTATE DEVELOPMENT

DATE
CHECKED
DRAWN
JOB
SHEET
C5
OF SHEETS


NOTE: DIMENSIONAL TOLERANCES
PLANS SHOW RENOVATED BUILDINGS APPROXIMATELY 100 YEARS OLD. ONLY EXTERIOR OVERALL DIMENSIONS SHOWN AS ACTUAL ARE EXACT. ALL INTERIOR DIMENSIONS AND NOMINAL OVERALL DIMENSIONS ARE BASED ON OBSERVATIONS AND MEASUREMENTS OF TYPICAL BUILDINGS, CHIEFLY BUILDINGS NO. 5 AND NO. 10. SOME VARIATIONS IN WINDOW LOCATIONS OCCUR. ACTUAL EXTERIOR OVERALL DIMENSIONS ARE FROM THE SURVEY OF GRANT ESTATES, PROPERTY OF SCIENTIFIC ASSOCIATES, PREPARED BY JAMES J. LUZZI, P.E. AND L.S. CONN. REG. NO. 1415 DATED SEPT. 10, 1980. THE LOCATION AND AMOUNT OF VARIATION BETWEEN THE TYPICAL INTERIOR DIMENSIONS SHOWN AND ACTUAL INTERIOR DIMENSIONS ARE NOT SHOWN ON THESE PLANS.

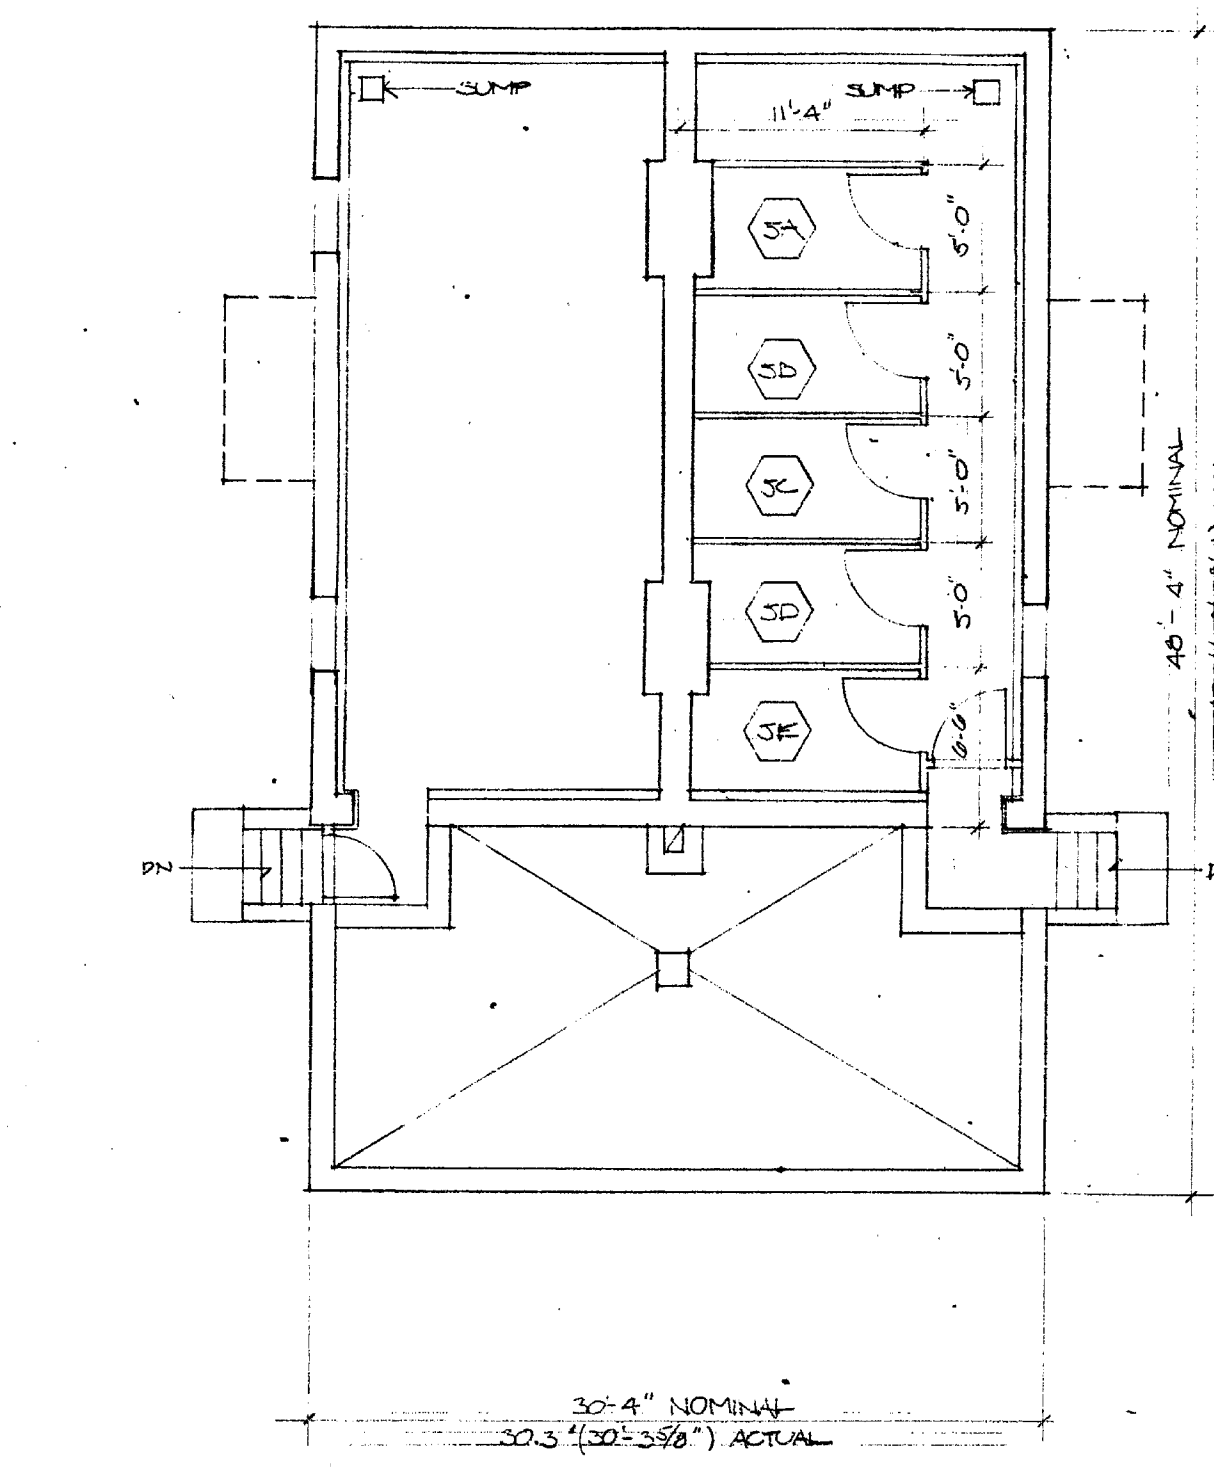


1 BASEMENT FLOOR 5
1/8" = 1'-0"

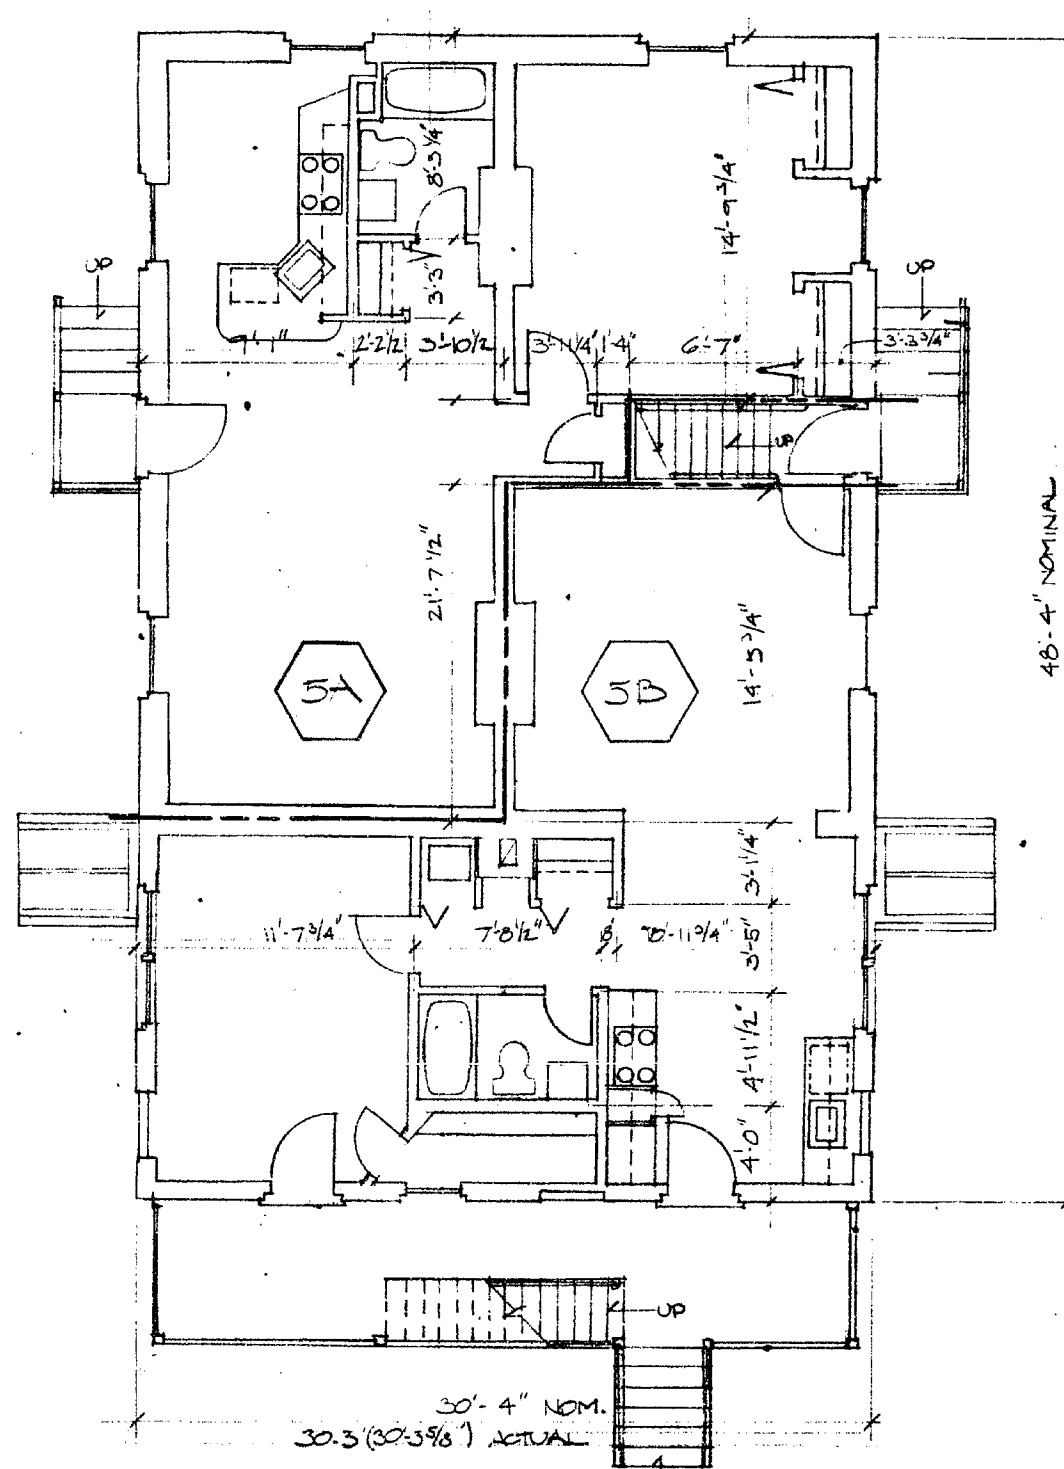


2 FIRST FLOOR FLOOR 5
1/8" = 1'-0"

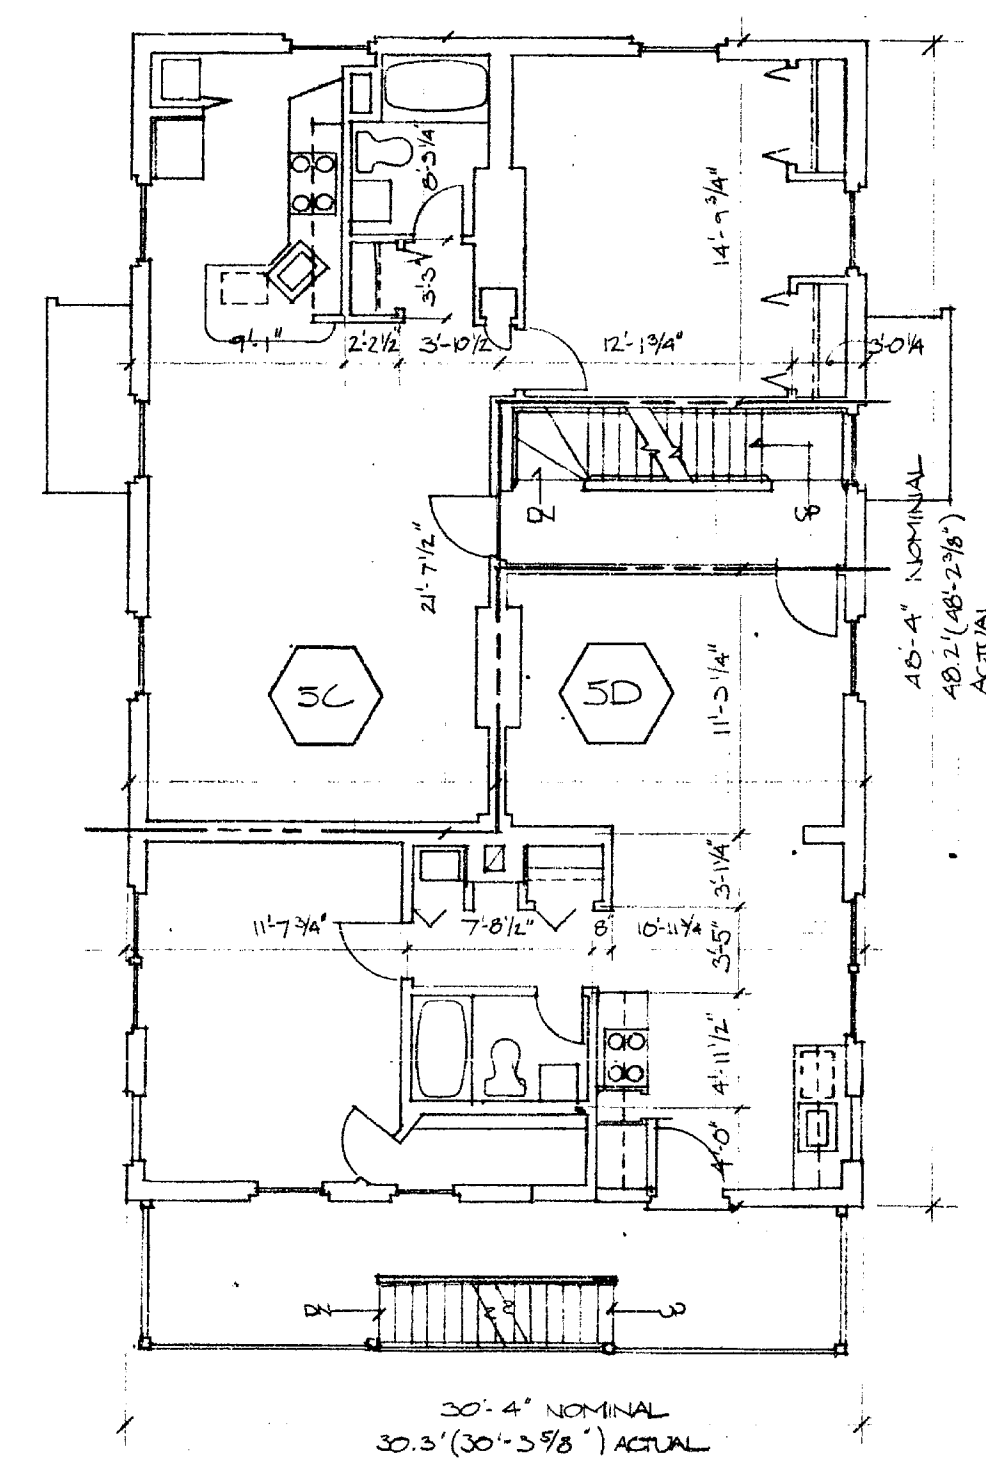


3 SECOND FLOOR FLOOR 5
1/8" = 1'-0"

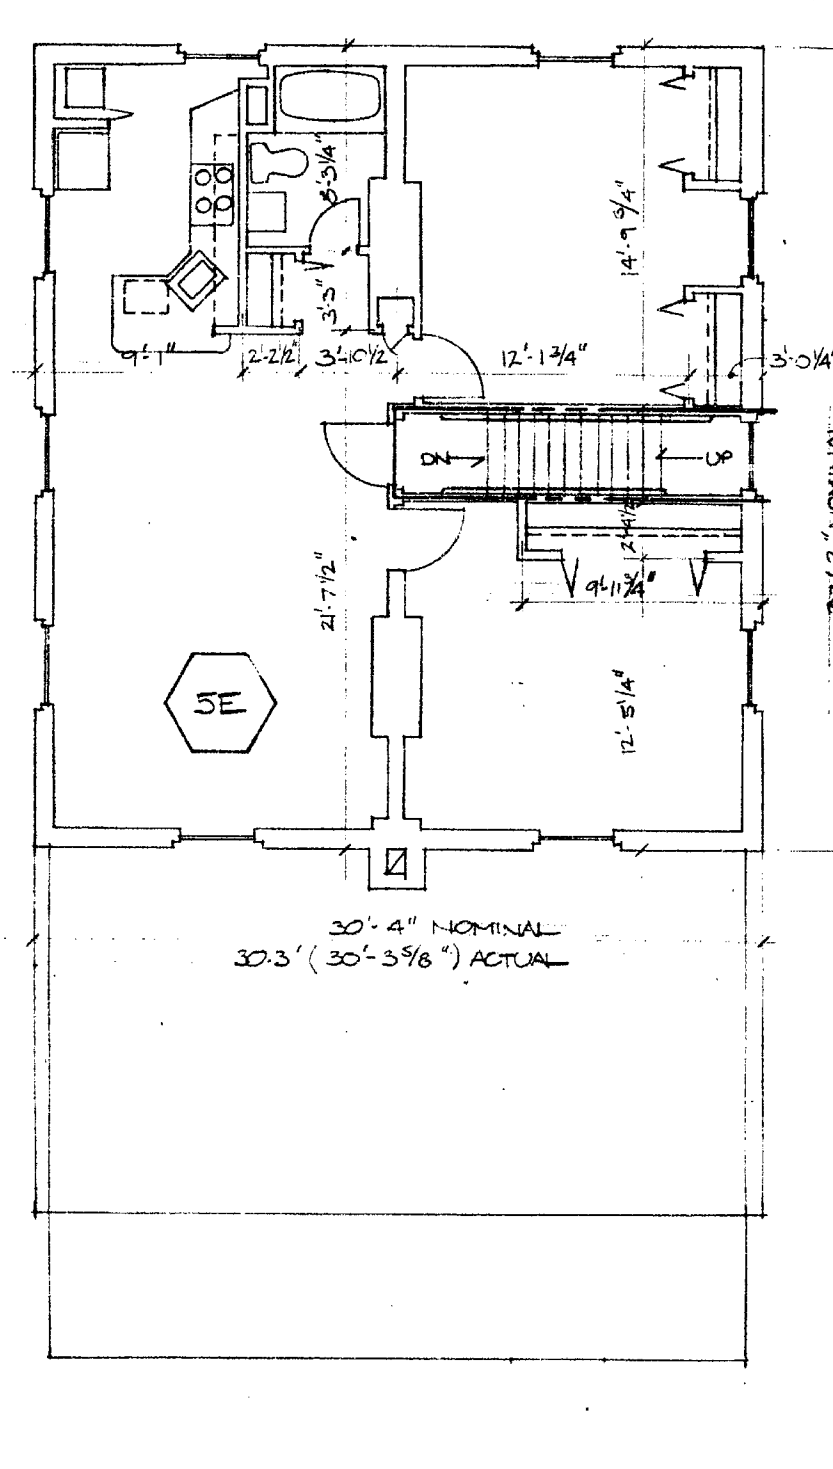


4 THIRD FLOOR FLOOR 5
1/8" = 1'-0"

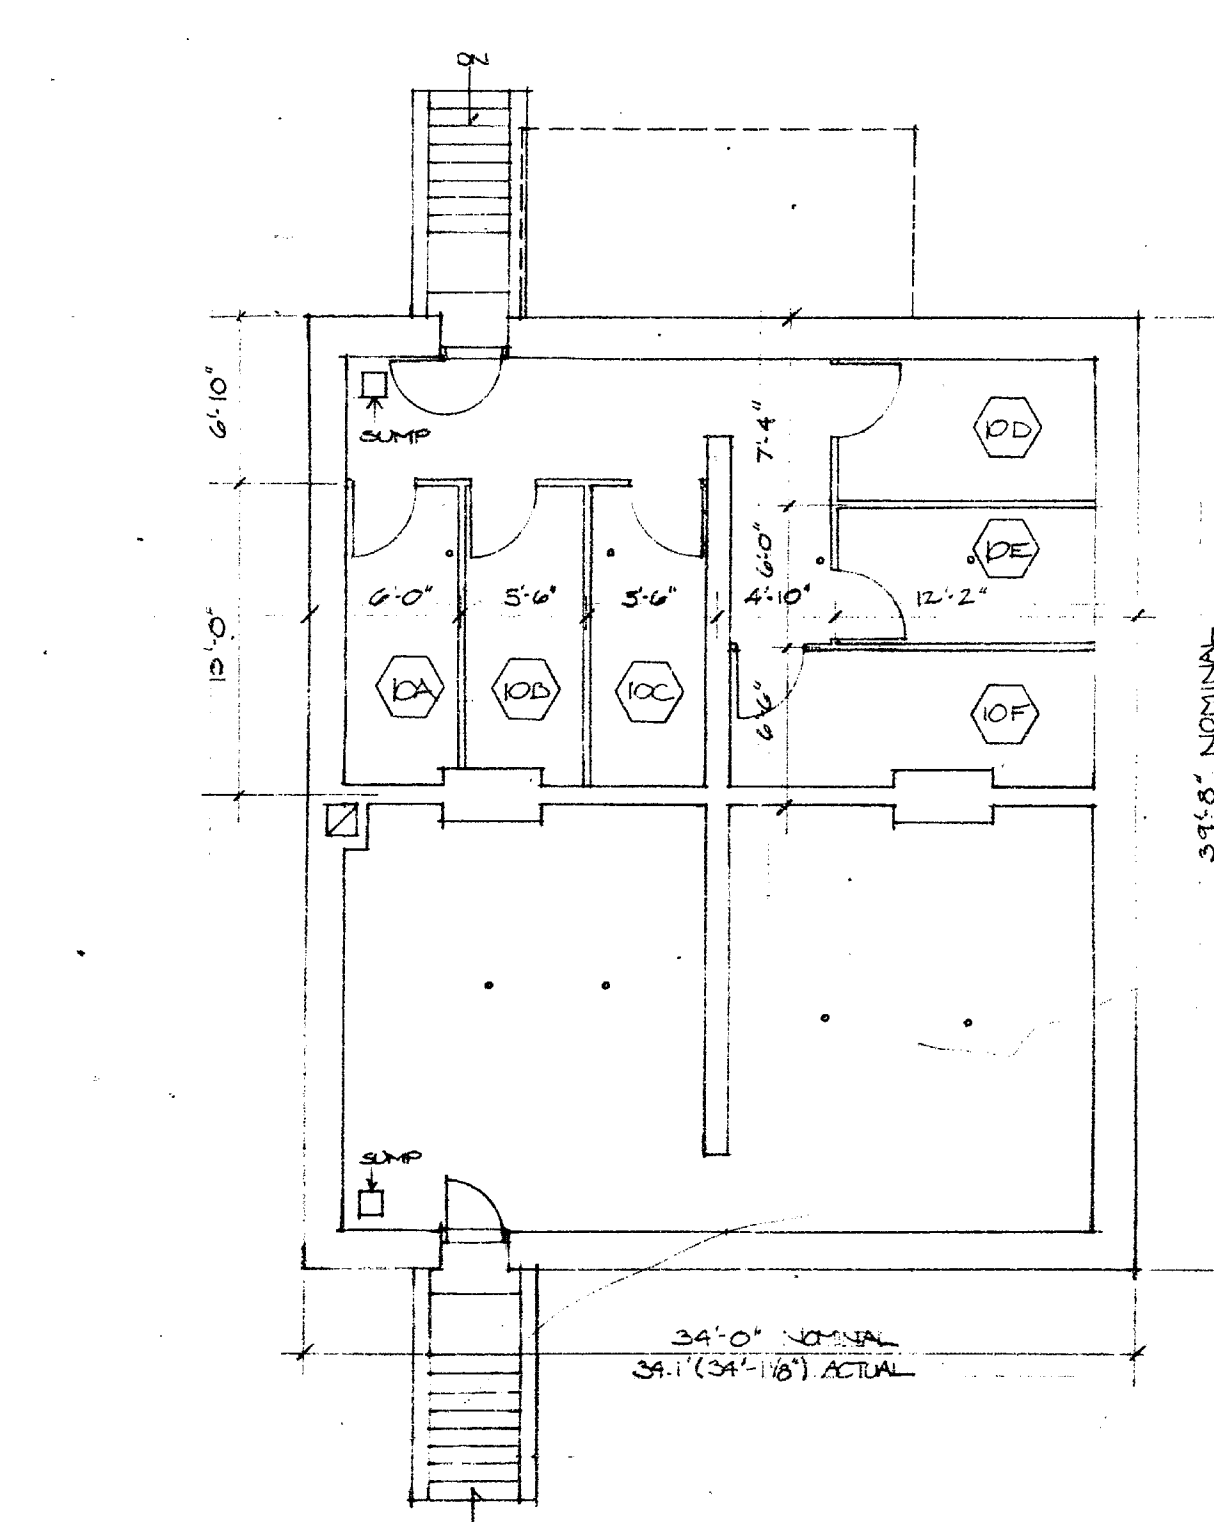


5 BASEMENT FLOOR 10
1/8" = 1'-0"
CEILING HEIGHT 6'-4 3/4"

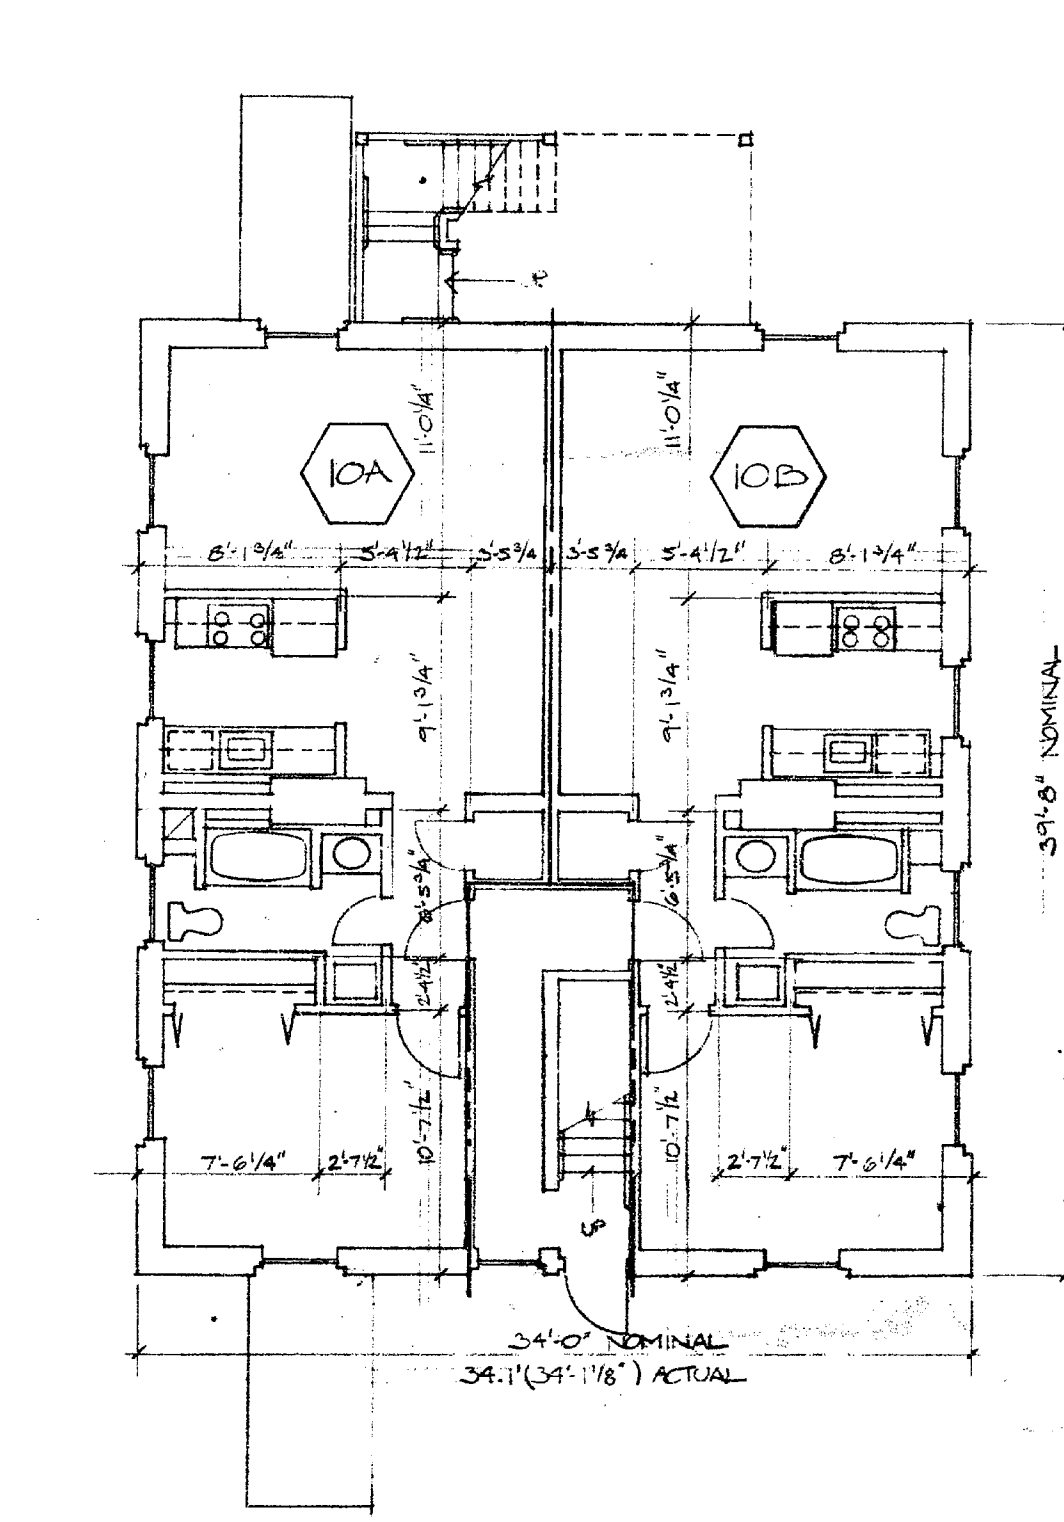


6 FIRST FLOOR FLOOR 10
1/8" = 1'-0"
CEILING HEIGHT 11'-11 1/4"

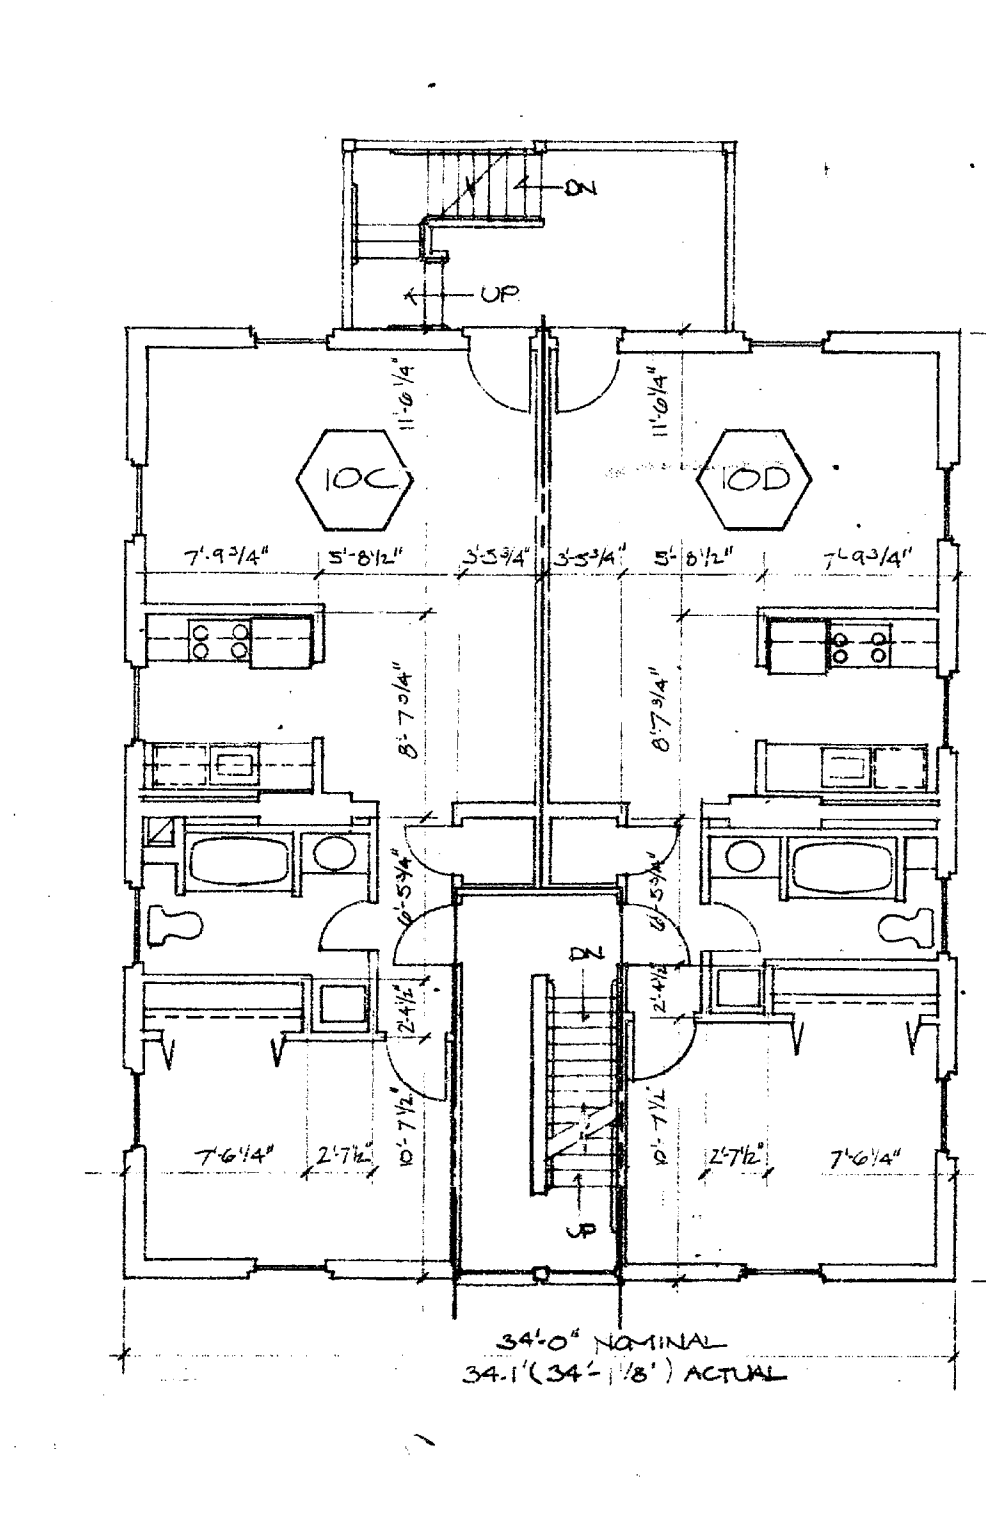

7 SECOND FLOOR FLOOR 10
1/8" = 1'-0"
CEILING HEIGHT 10'-9 3/4"

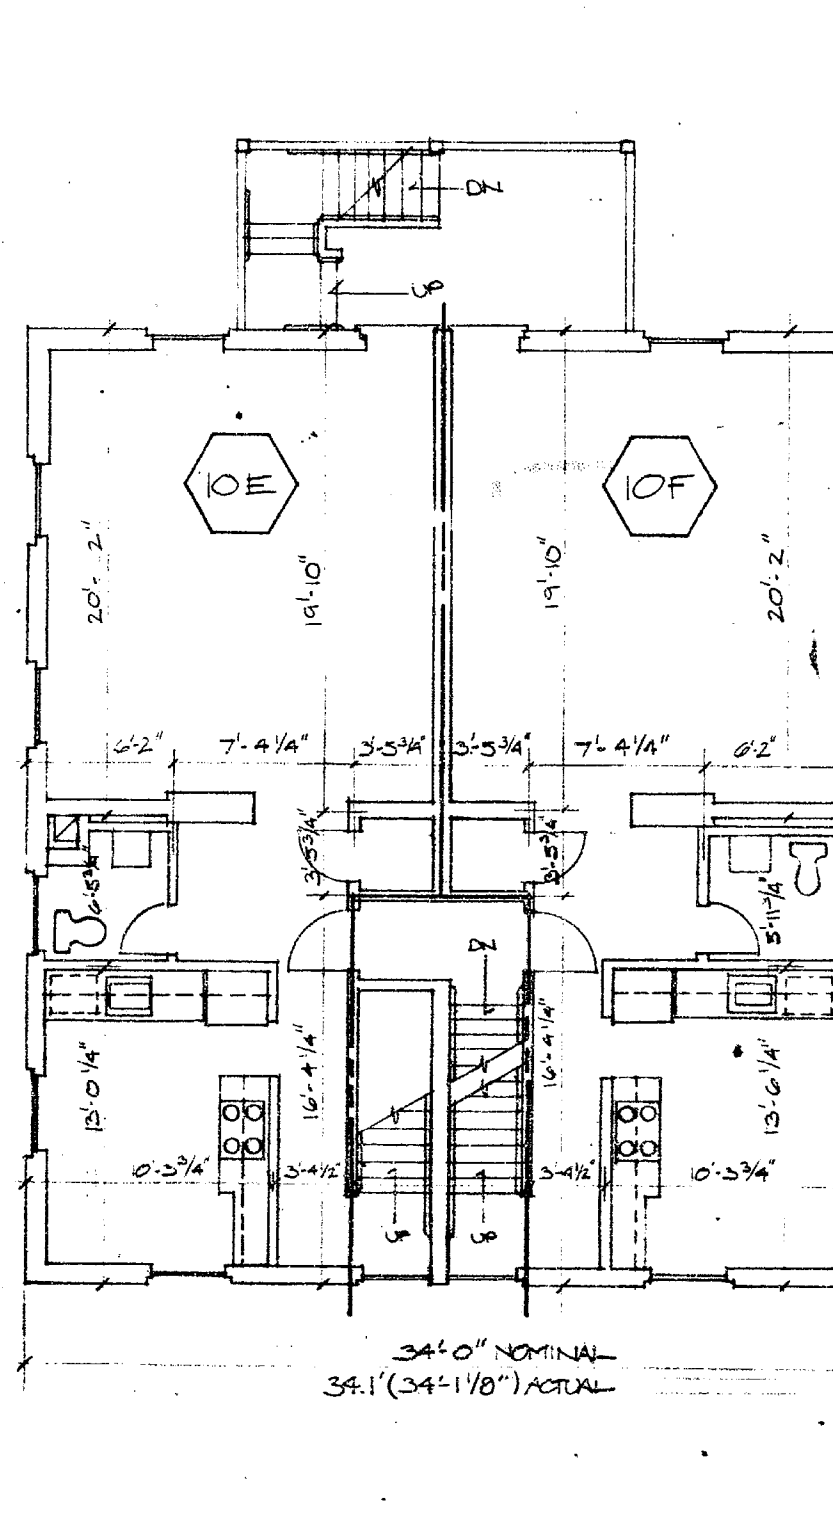

8 THIRD FLOOR FLOOR 10
1/8" = 1'-0"
CEILING HEIGHT 7'-11 1/4"

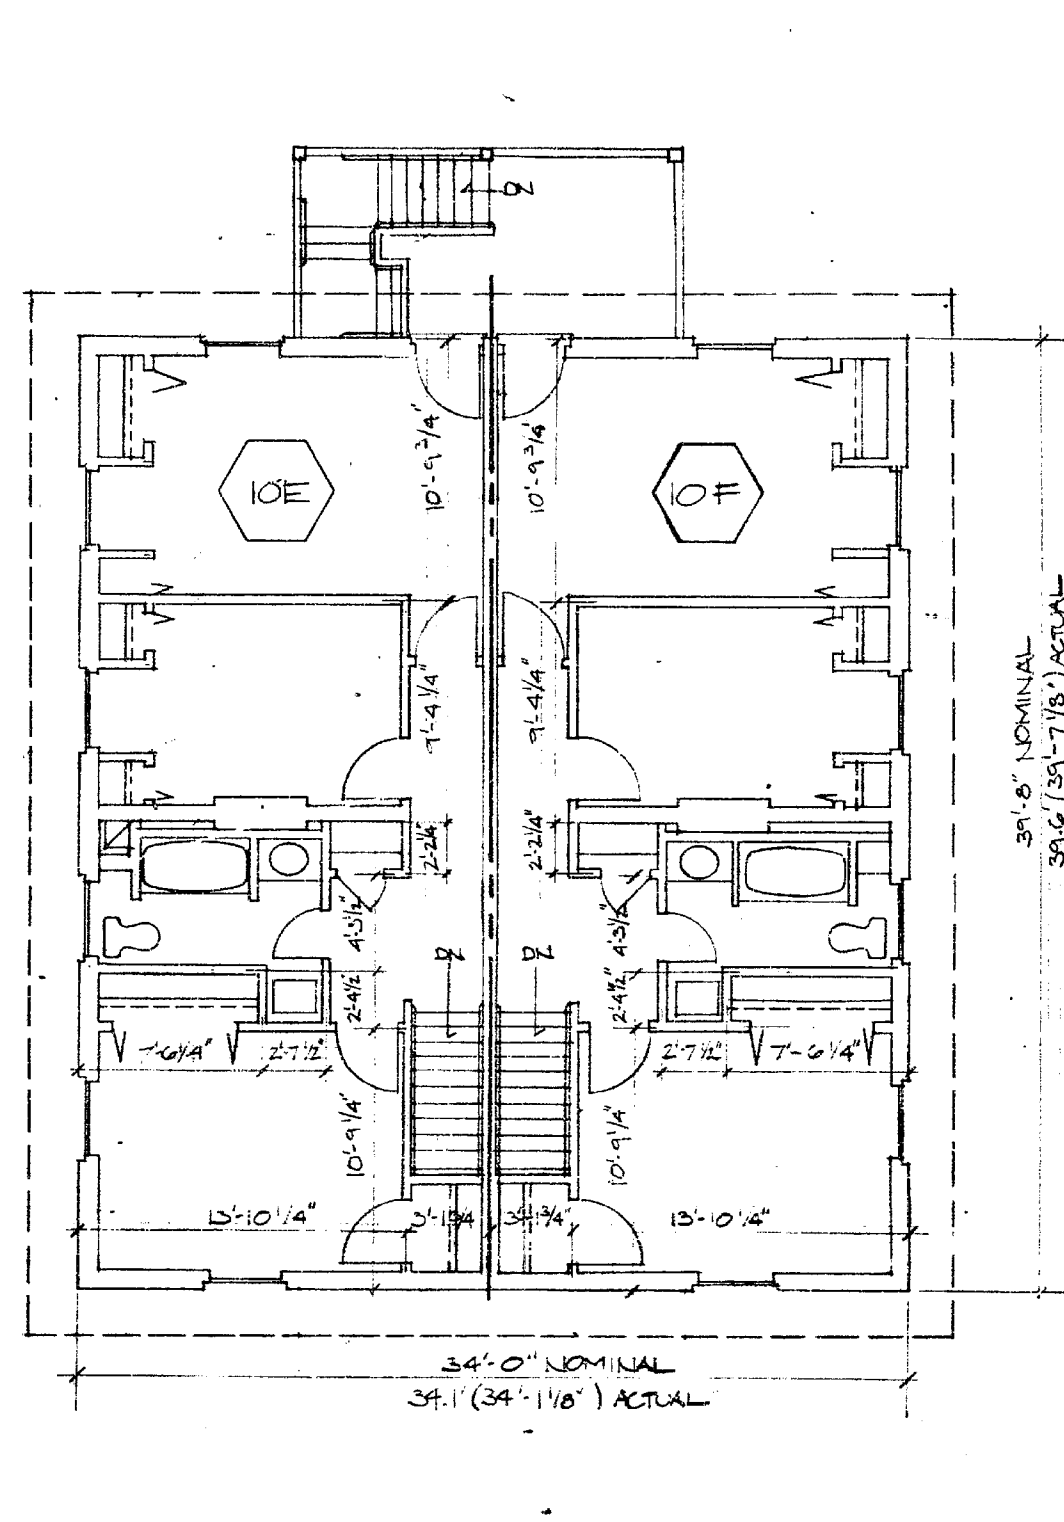

9 FOURTH FLOOR FLOOR 10
1/8" = 1'-0"
CEILING HEIGHT 6'-1 1/2" TO 8'-2"

HUD NOTATION - NOT FOR LEGAL USE