


UNIT NOTES:
UNIT A - 1st FLOOR NORTH
UNIT B - 1st FLOOR SOUTH
UNIT C - 2ND FLOOR NORTH
UNIT D - 2ND FLOOR SOUTH
UNIT E - 3RD FLOOR NORTH
UNIT F - 3RD FLOOR SOUTH

NOTES:

REMOVE ALL EXISTING APPLIED FLOORING DOWN TO WOOD FLOORS.
REMOVE EXISTING WOOD WINDOWS (EXCEPT BASEMENT), INCLUDING BASEMENT.
ALL DIMENSIONS, NOTES, ETC. SHOWN ON ONE UNIT ARE TYPICAL FOR BOTH UNITS AND ON ALL FLOORS EXCEPT 1ST FLOOR SOUTH (SEE DETAILS).
ALL GYP. BD. SHALL BE TAPED AND PAINTED WITH ONE COAT PRIMER/SEALER AND ONE COAT FINISH COLOR TO BE DETERMINED BY THE OWNER.
ALL DOORS ENTERING STAIRWAYS SHALL BE C-LABEL, 3/4 HOUR FIRE RATED WITH SELF CLOSERS AND POSITIVE LATCHING.
CARPET SHALL BE PLACED (AS DIRECTED BY THE OWNER) IN ALL ROOMS EXCEPT KITCHEN AND BATHROOM.
KITCHEN AND BATHROOM FLOOR SHALL HAVE 1/4" UNDERLAYMENT AND NEW LINOLEUM FLOOR PLACED AS DIRECTED BY THE OWNER.
ALL MOLDINGS WILL BE REMOVED AND NEW TRIM SHALL BE PLACED AT THE DIRECTION OF THE OWNER.

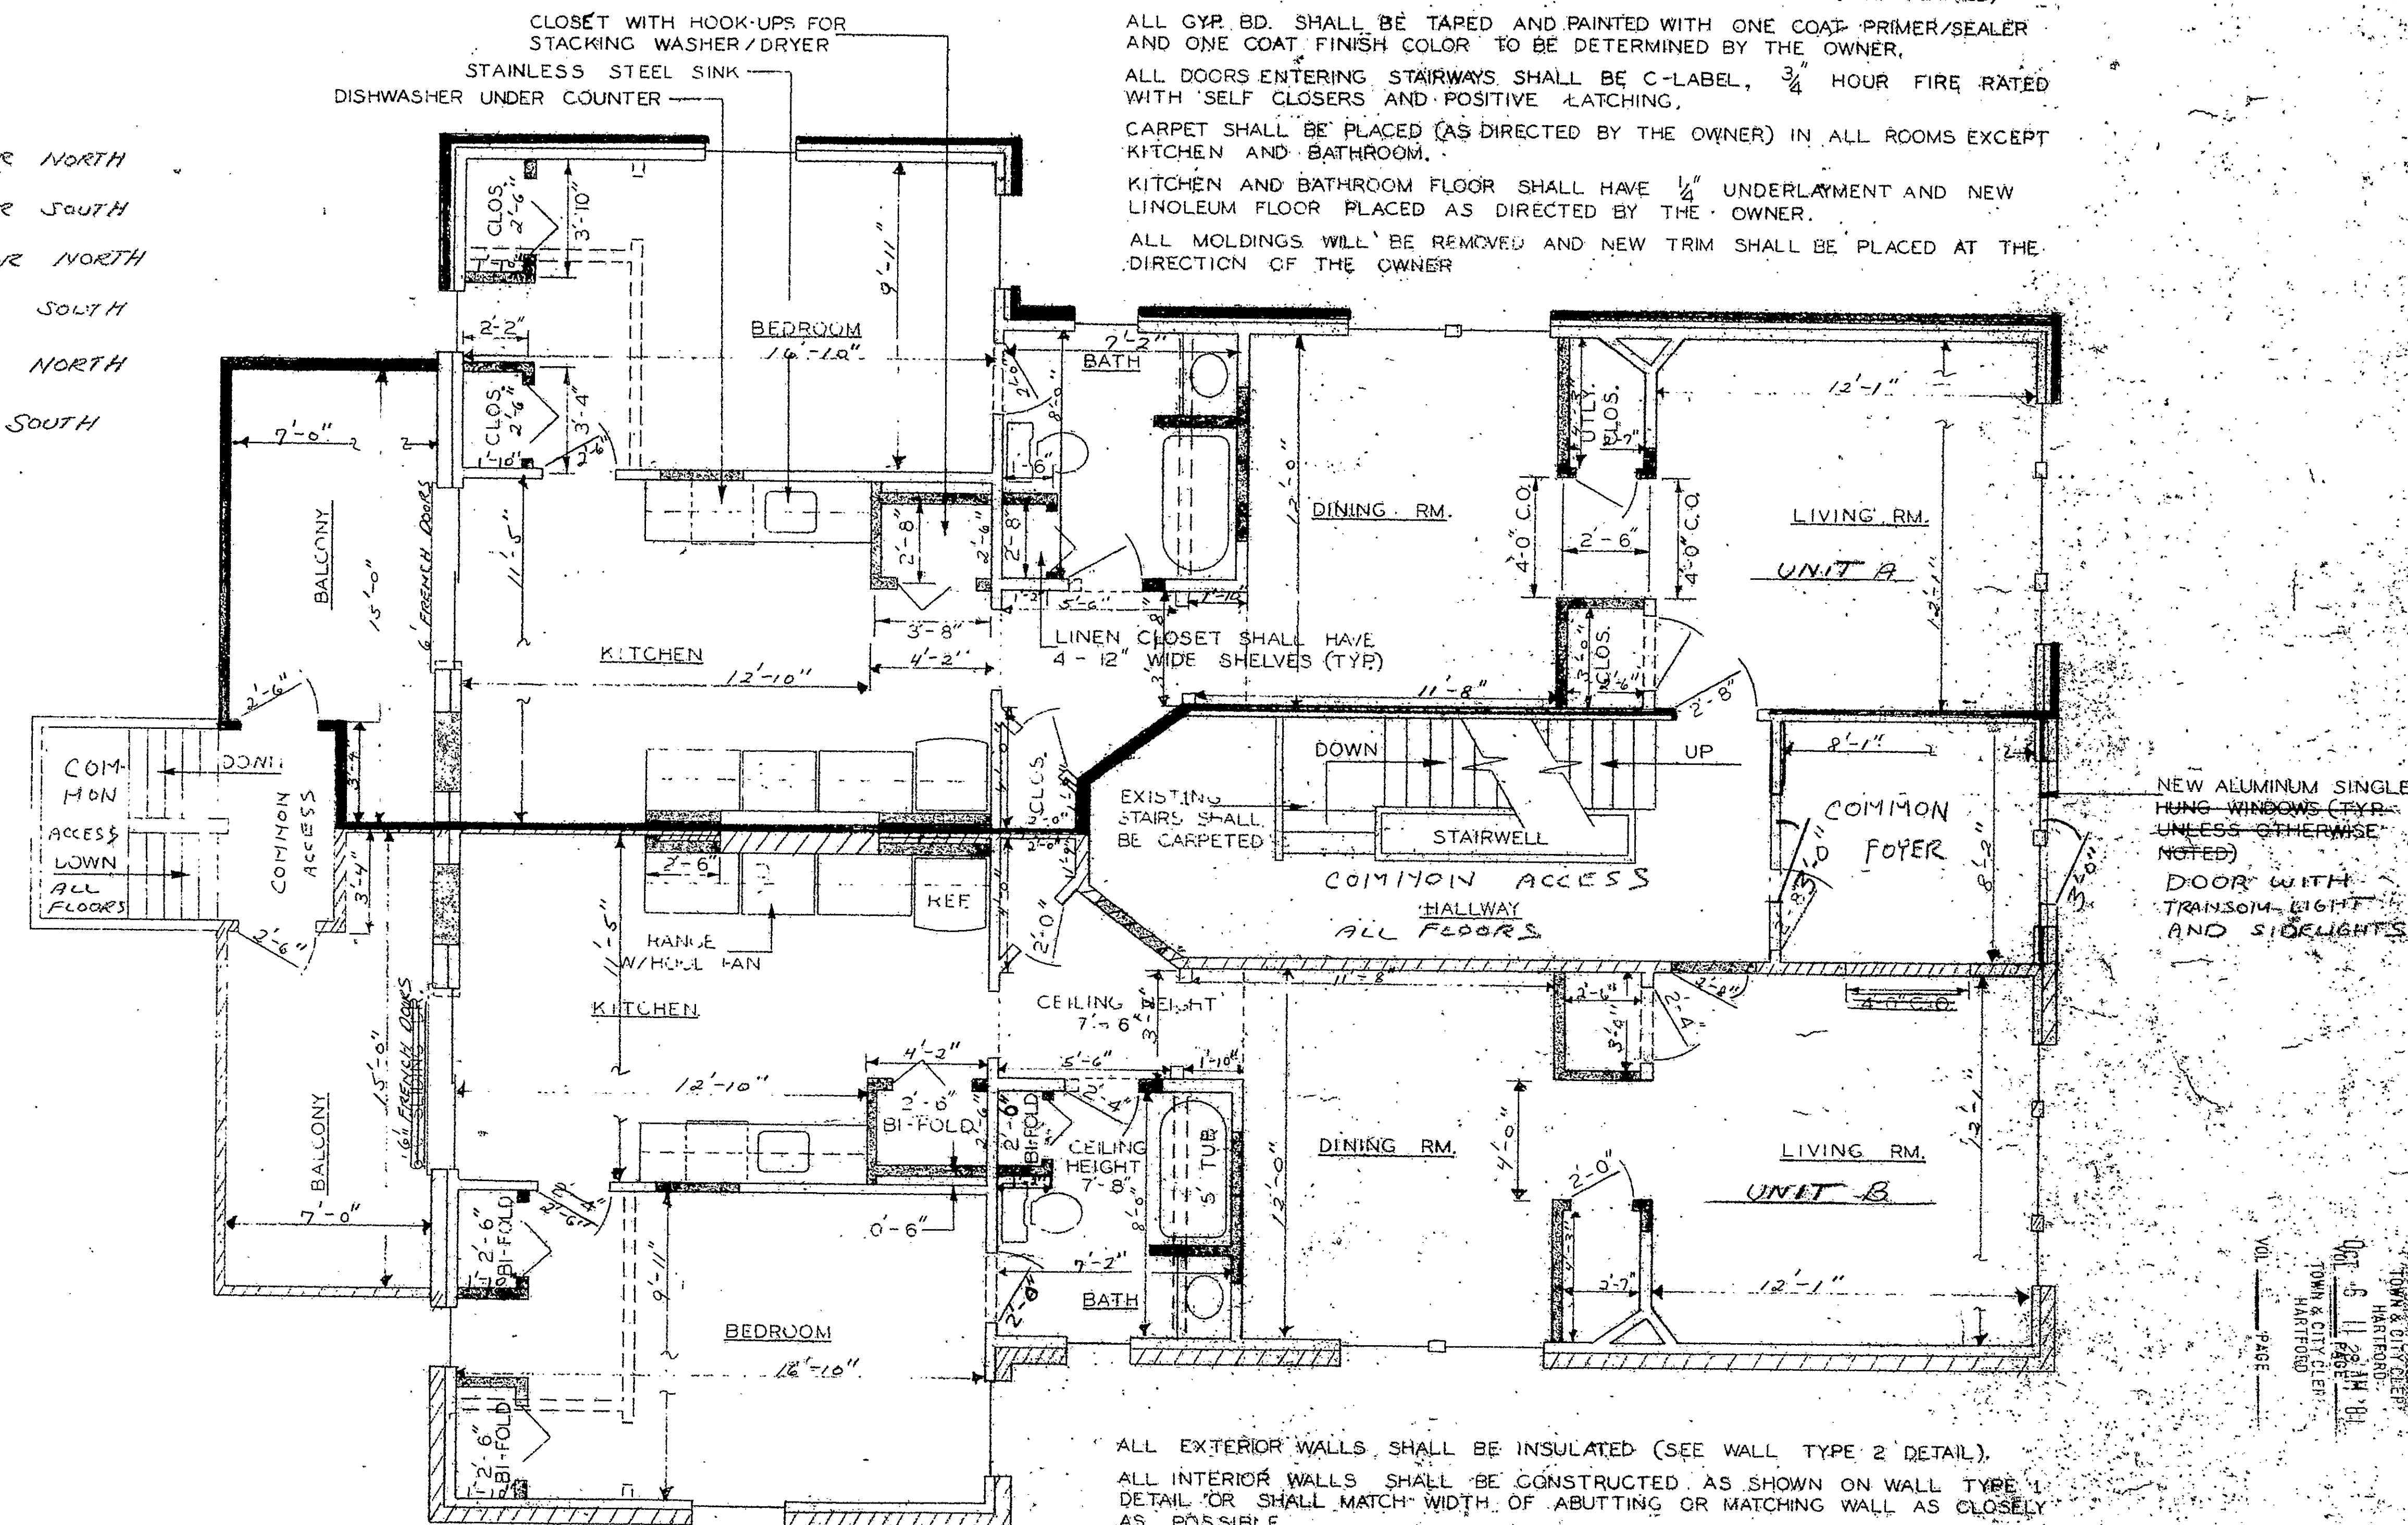

Unit A Floor Plan 70

121 CONDO