




RECEIVED BY
William A. Knight
AUG 29 3 29 PM '83
TOWN CLERK
HARTFORD
VOL. 05-183 PAGE

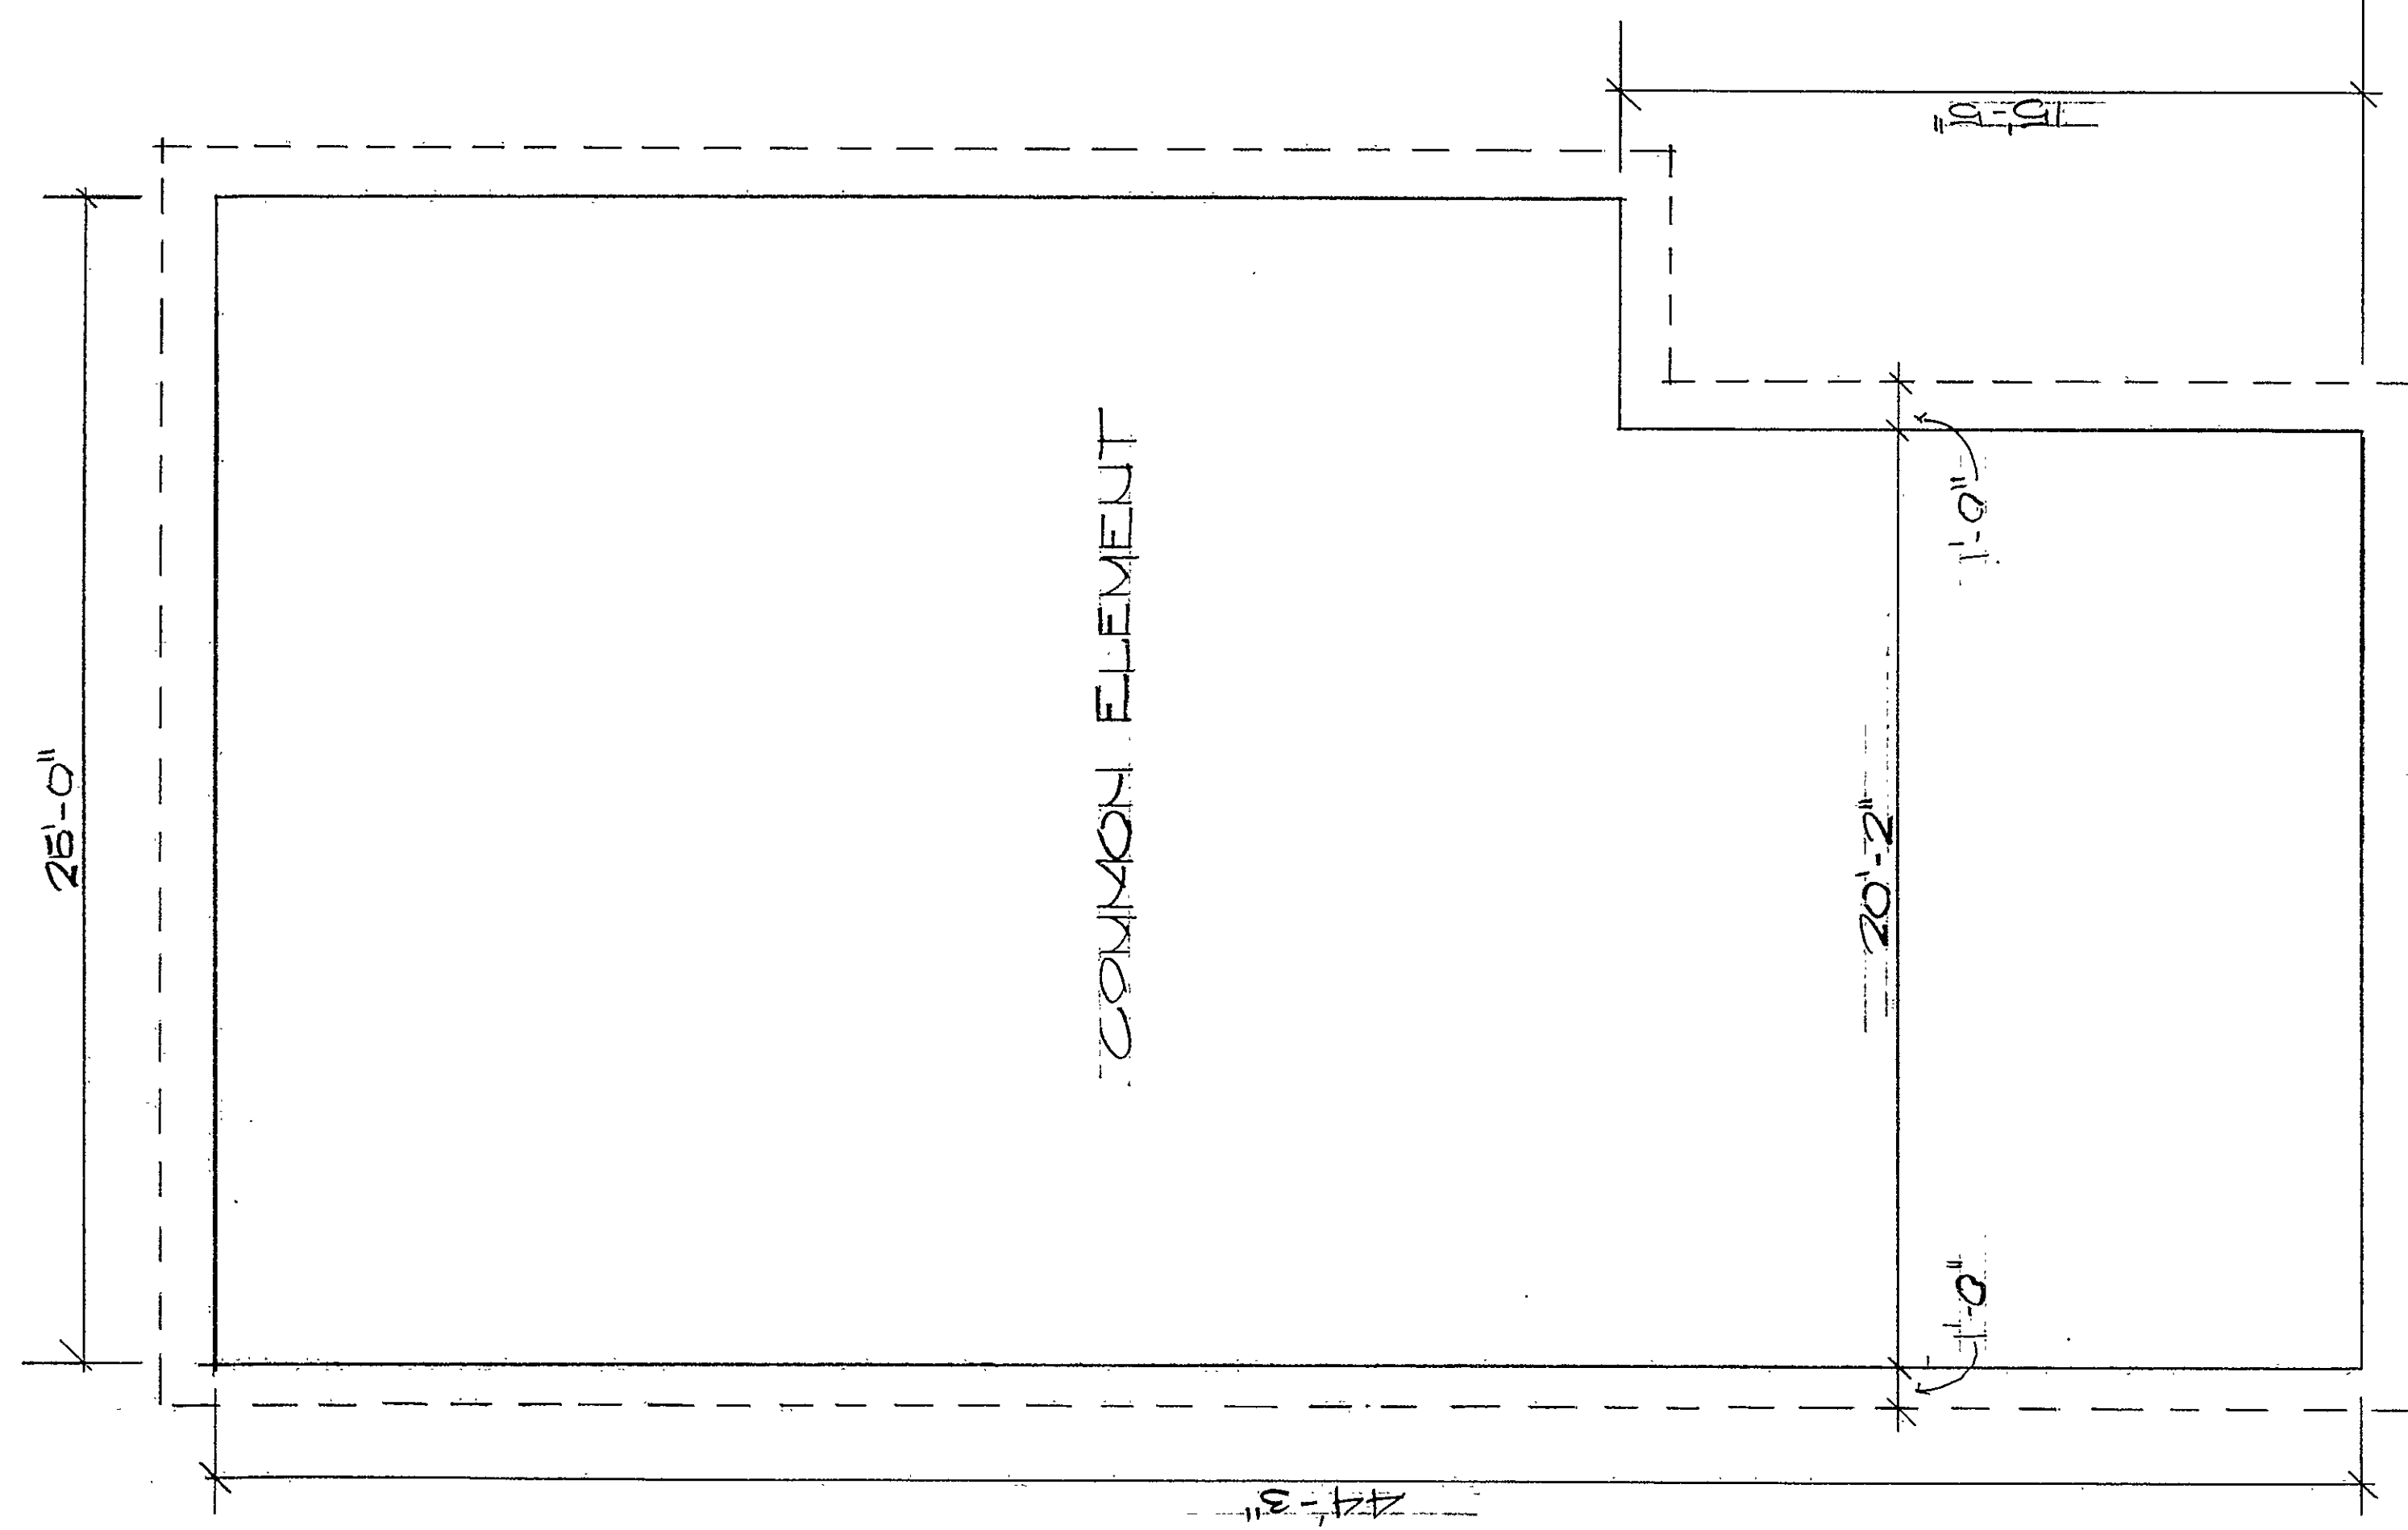

BASEMENT LEVEL

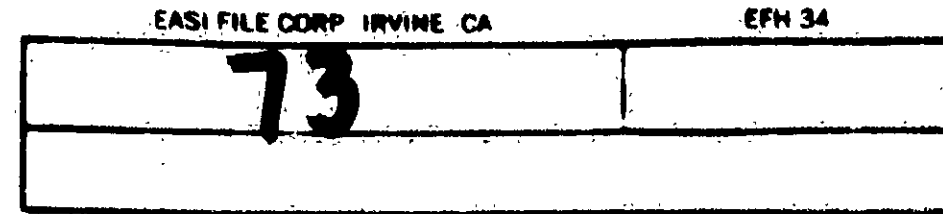

Book 7 Lot Plan # 73

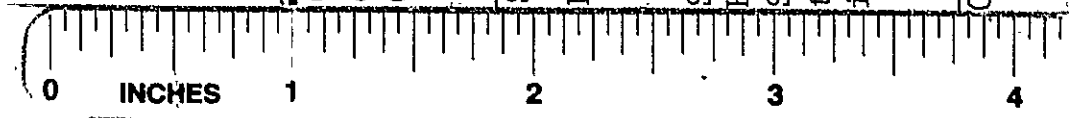

Certified to be accurate floor plans in accordance with Section 47-71 of the Connecticut General Statutes.


Sidar Baloghin - Licensed Engineer

Date: April 26, 1983

VERIFICATION

State of Connecticut, County of Hartford
Hartford, Connecticut, personally appeared
Sidar Baloghin who has solemnly affirmed to
the truth of the statement to which his name
is subscribed.

Philip A. Blodgett
Commissioner of the Superior Court

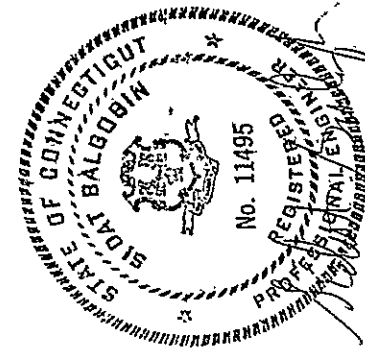

A-E-G
DESIGNBUILDING INC.

SANFORD STREET CONDOMINIUM
28 SANFORD STREET
HARTFORD CONNECTICUT

SCALE 1/4" = 1'-0"
APRIL 22, 1983
LEGAL TECHNICAL DEVELOPMENT INC.

BASEMENT
FLOOR
PLAN

20F5