
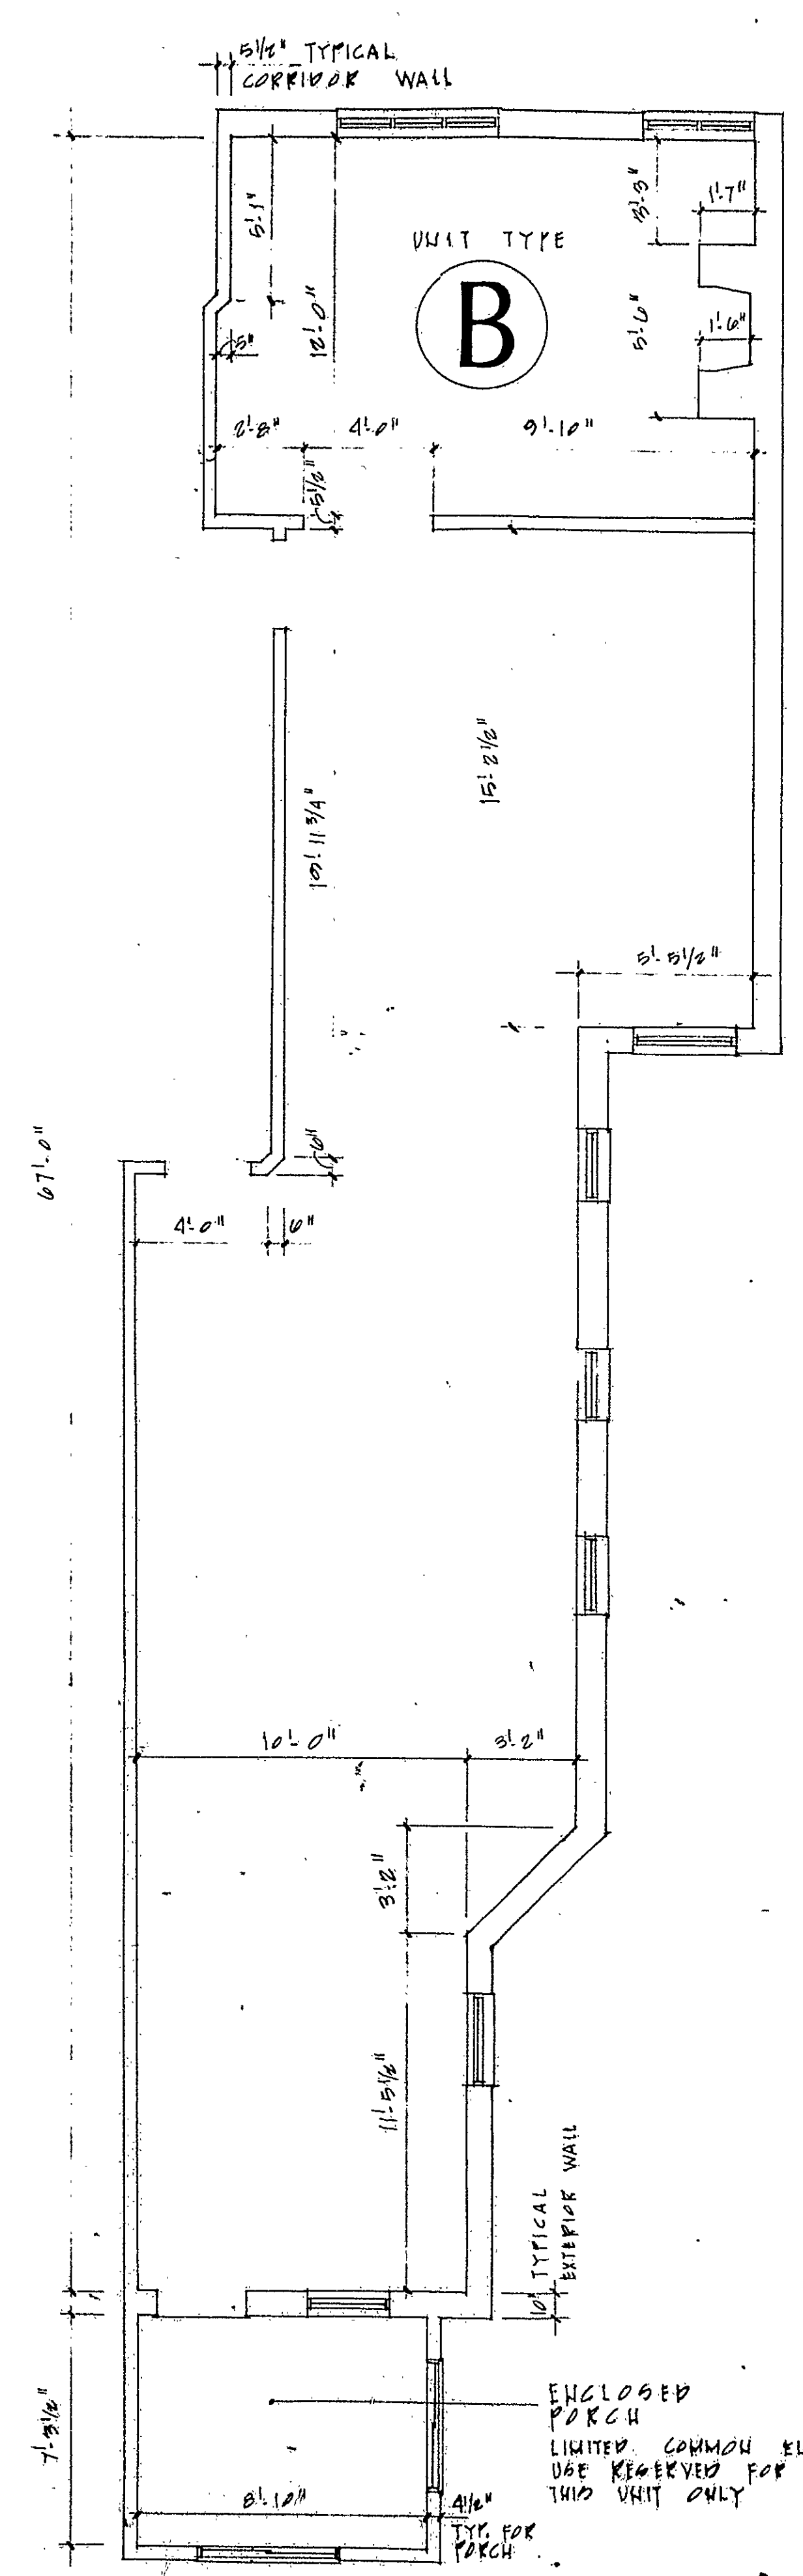


11041
RECEIVED BY
Dec 28 4 07 PM '83
TOWN & CITY CLERK
HARTFORD
VOL. _____ PAGE _____

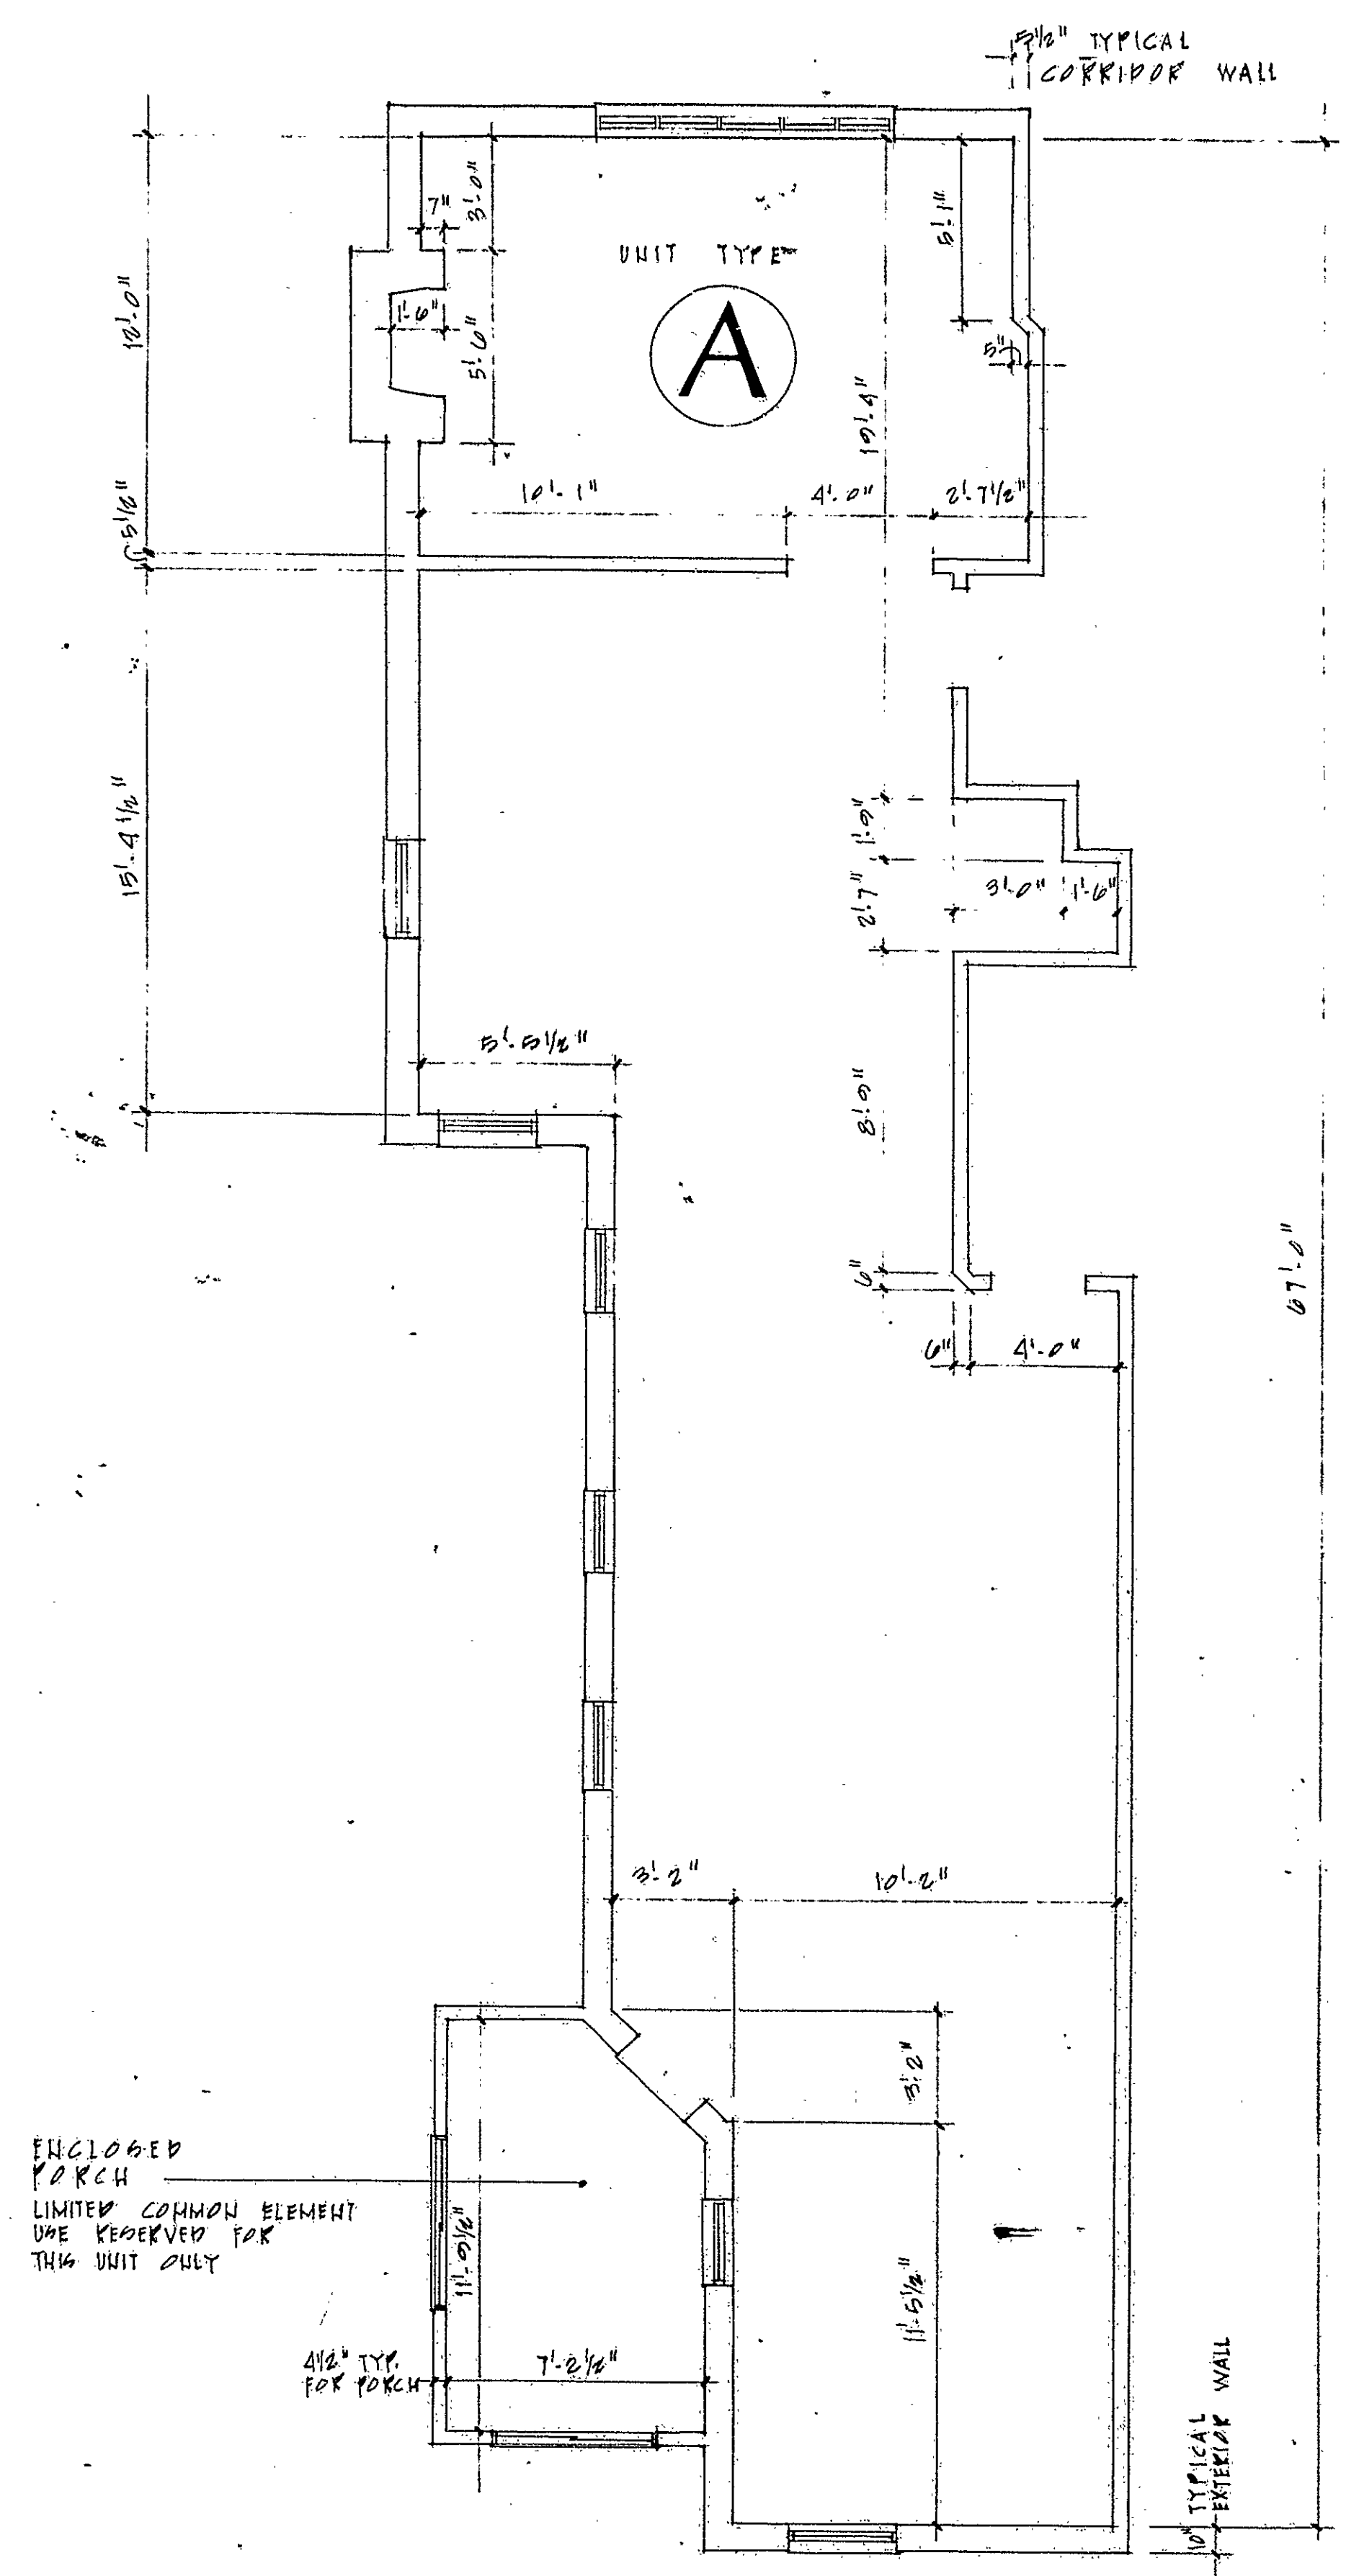

NOTE:
1. REFER TO SHEET 505 FOR FINISHED FLOOR & CEILING ELEVATIONS
2. DIMENSIONS GIVEN TO INTERIOR FINISH

EVERGREEN WEST
CONDOMINIUMS
DESIGN GROUP ONE ARCHITECTS
HARTFORD, CT. • (203) 549-5890

VERIFICATION
State of Conn.) ss: Hartford
County of Hartford) ss: Kravack, agent of the
above statement duly sworn, and the
truth of the statement to which his signature
appears.
Notary Public
10/31/83
Date

Unit Floor Plans (Schematic)
To the Declaration of Condominium
By
Evergreen West, Inc.
Hartford Land Records
10/31/83
Page

UNIT A: 803 S.F.
UNIT B: 807 S.F.
REFER TO SHEET 505 FOR
UNIT LOCATIONS &
NUMBERS

1/4" = 1'-0"
27 03
SHEET
1 OF 5

Condo Floor Plan # 76

