


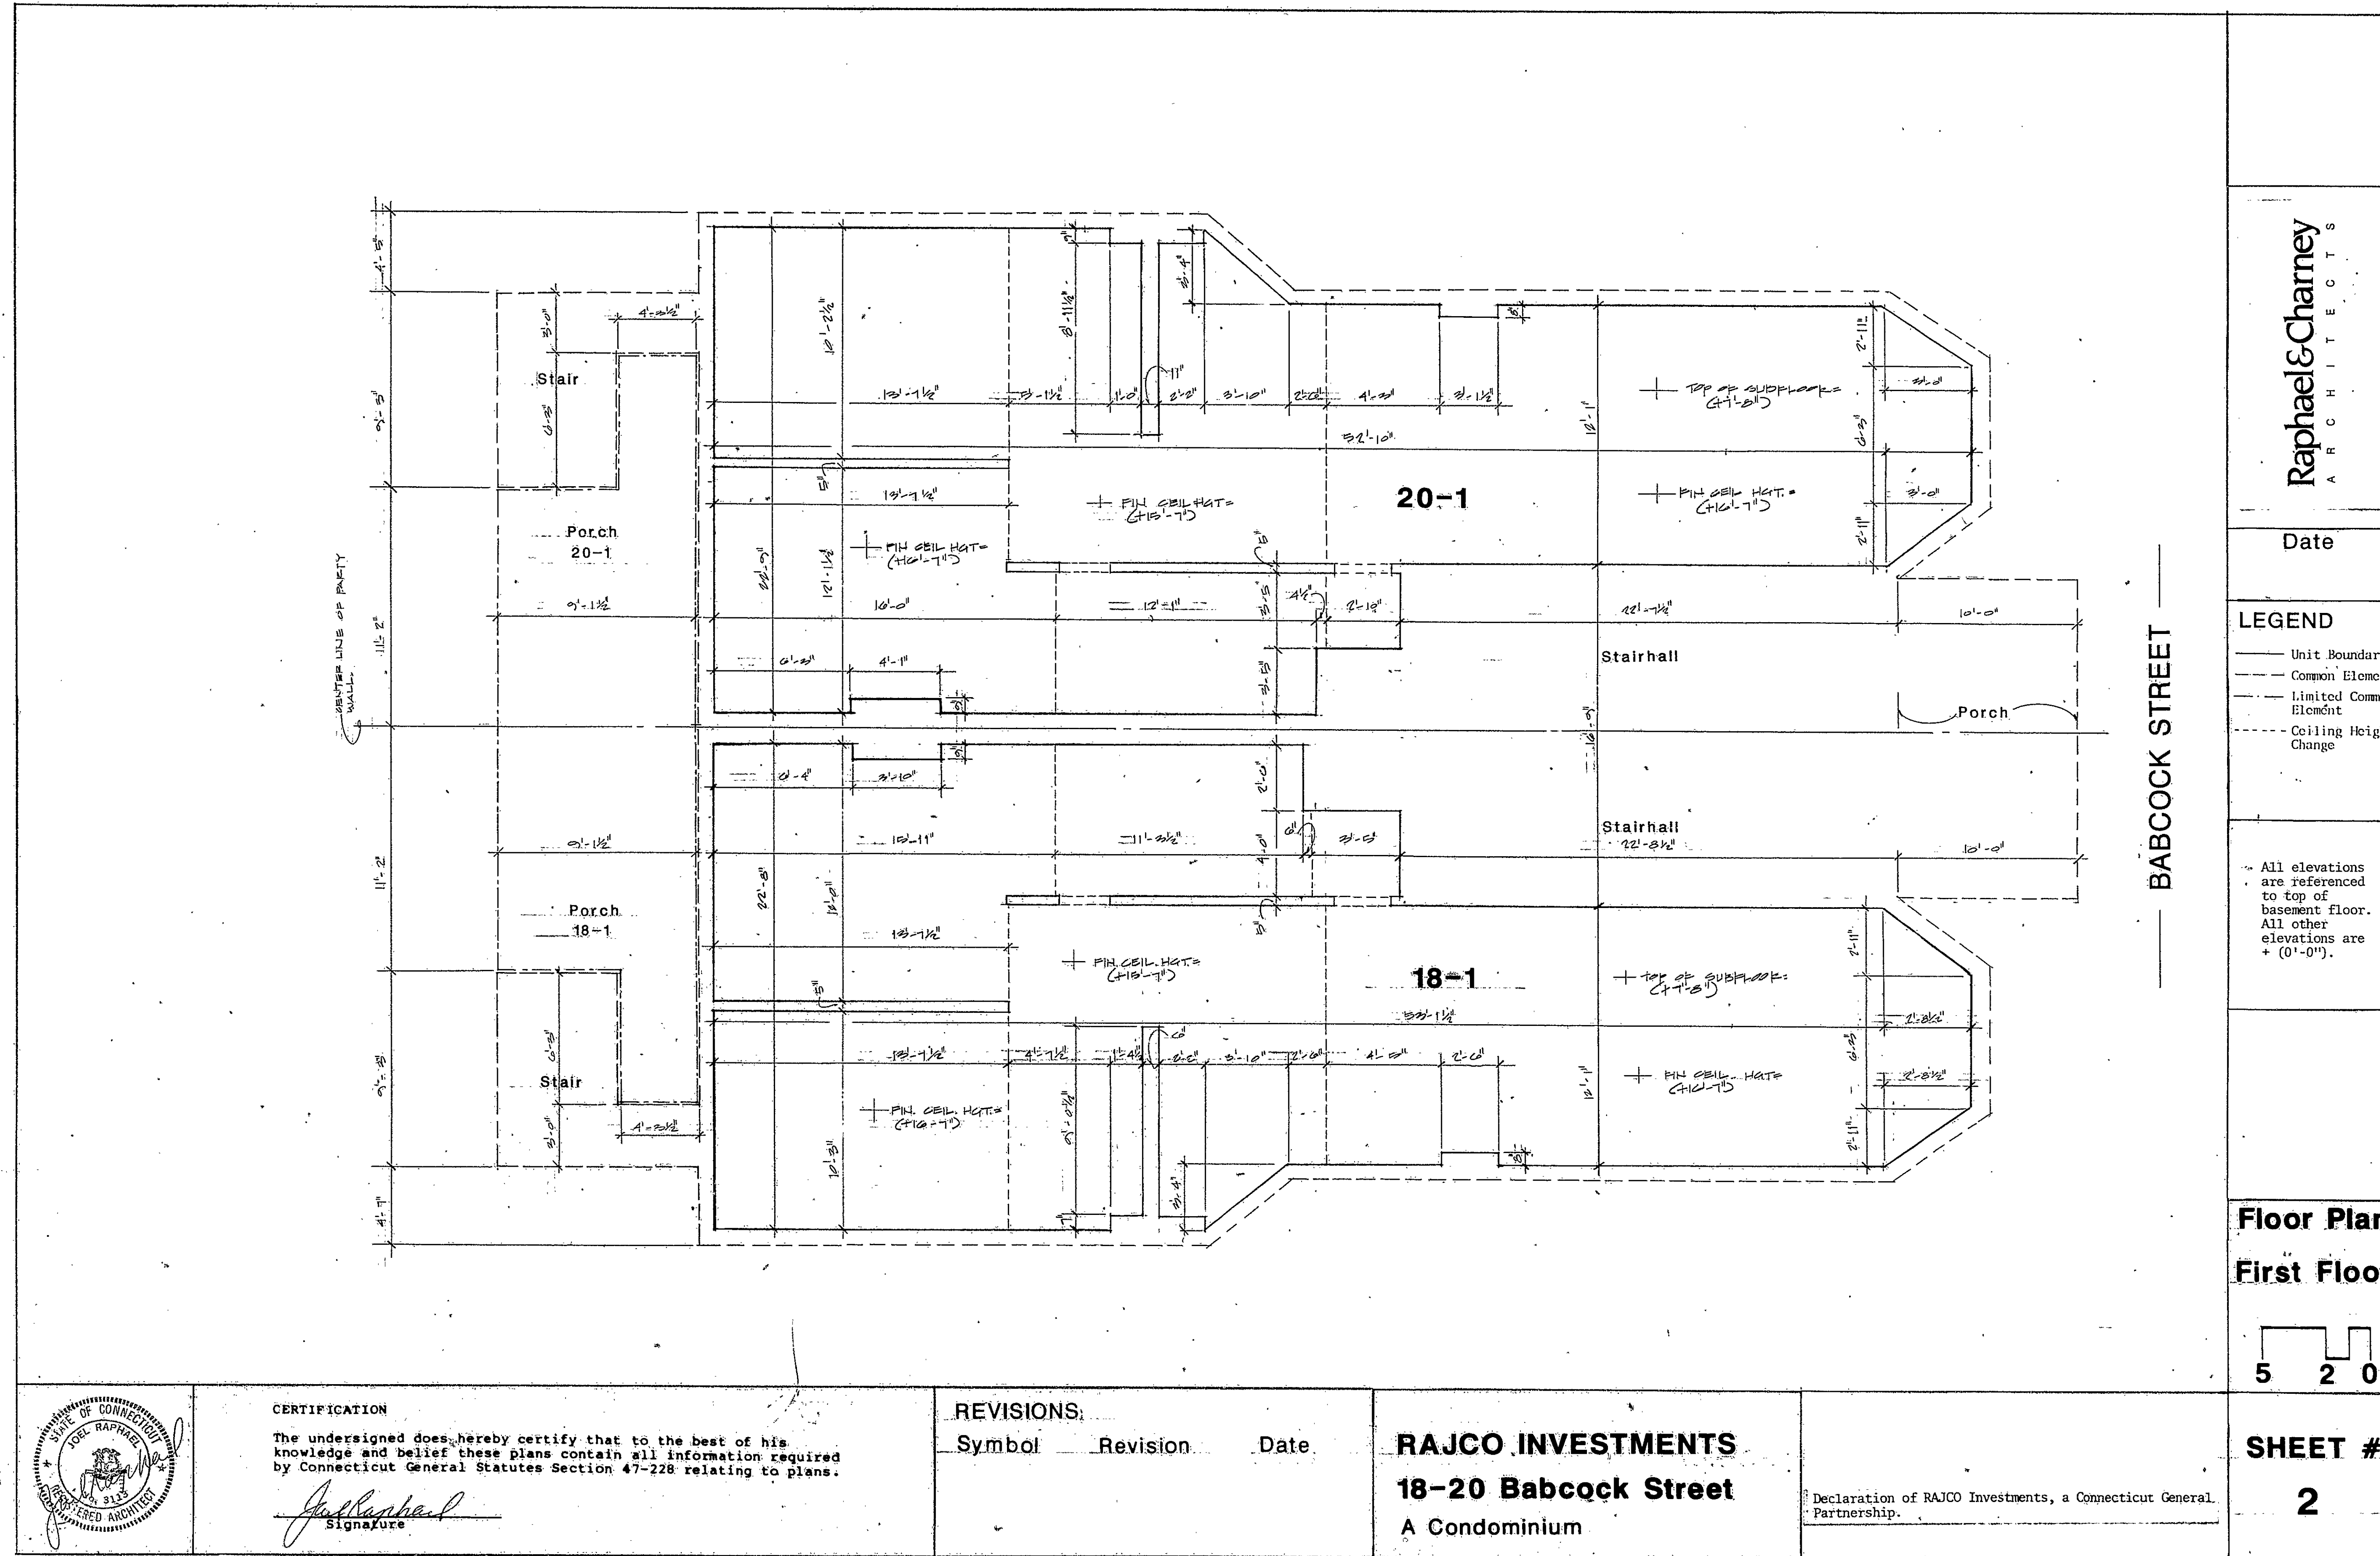

Condo Floor Plan # 78

