


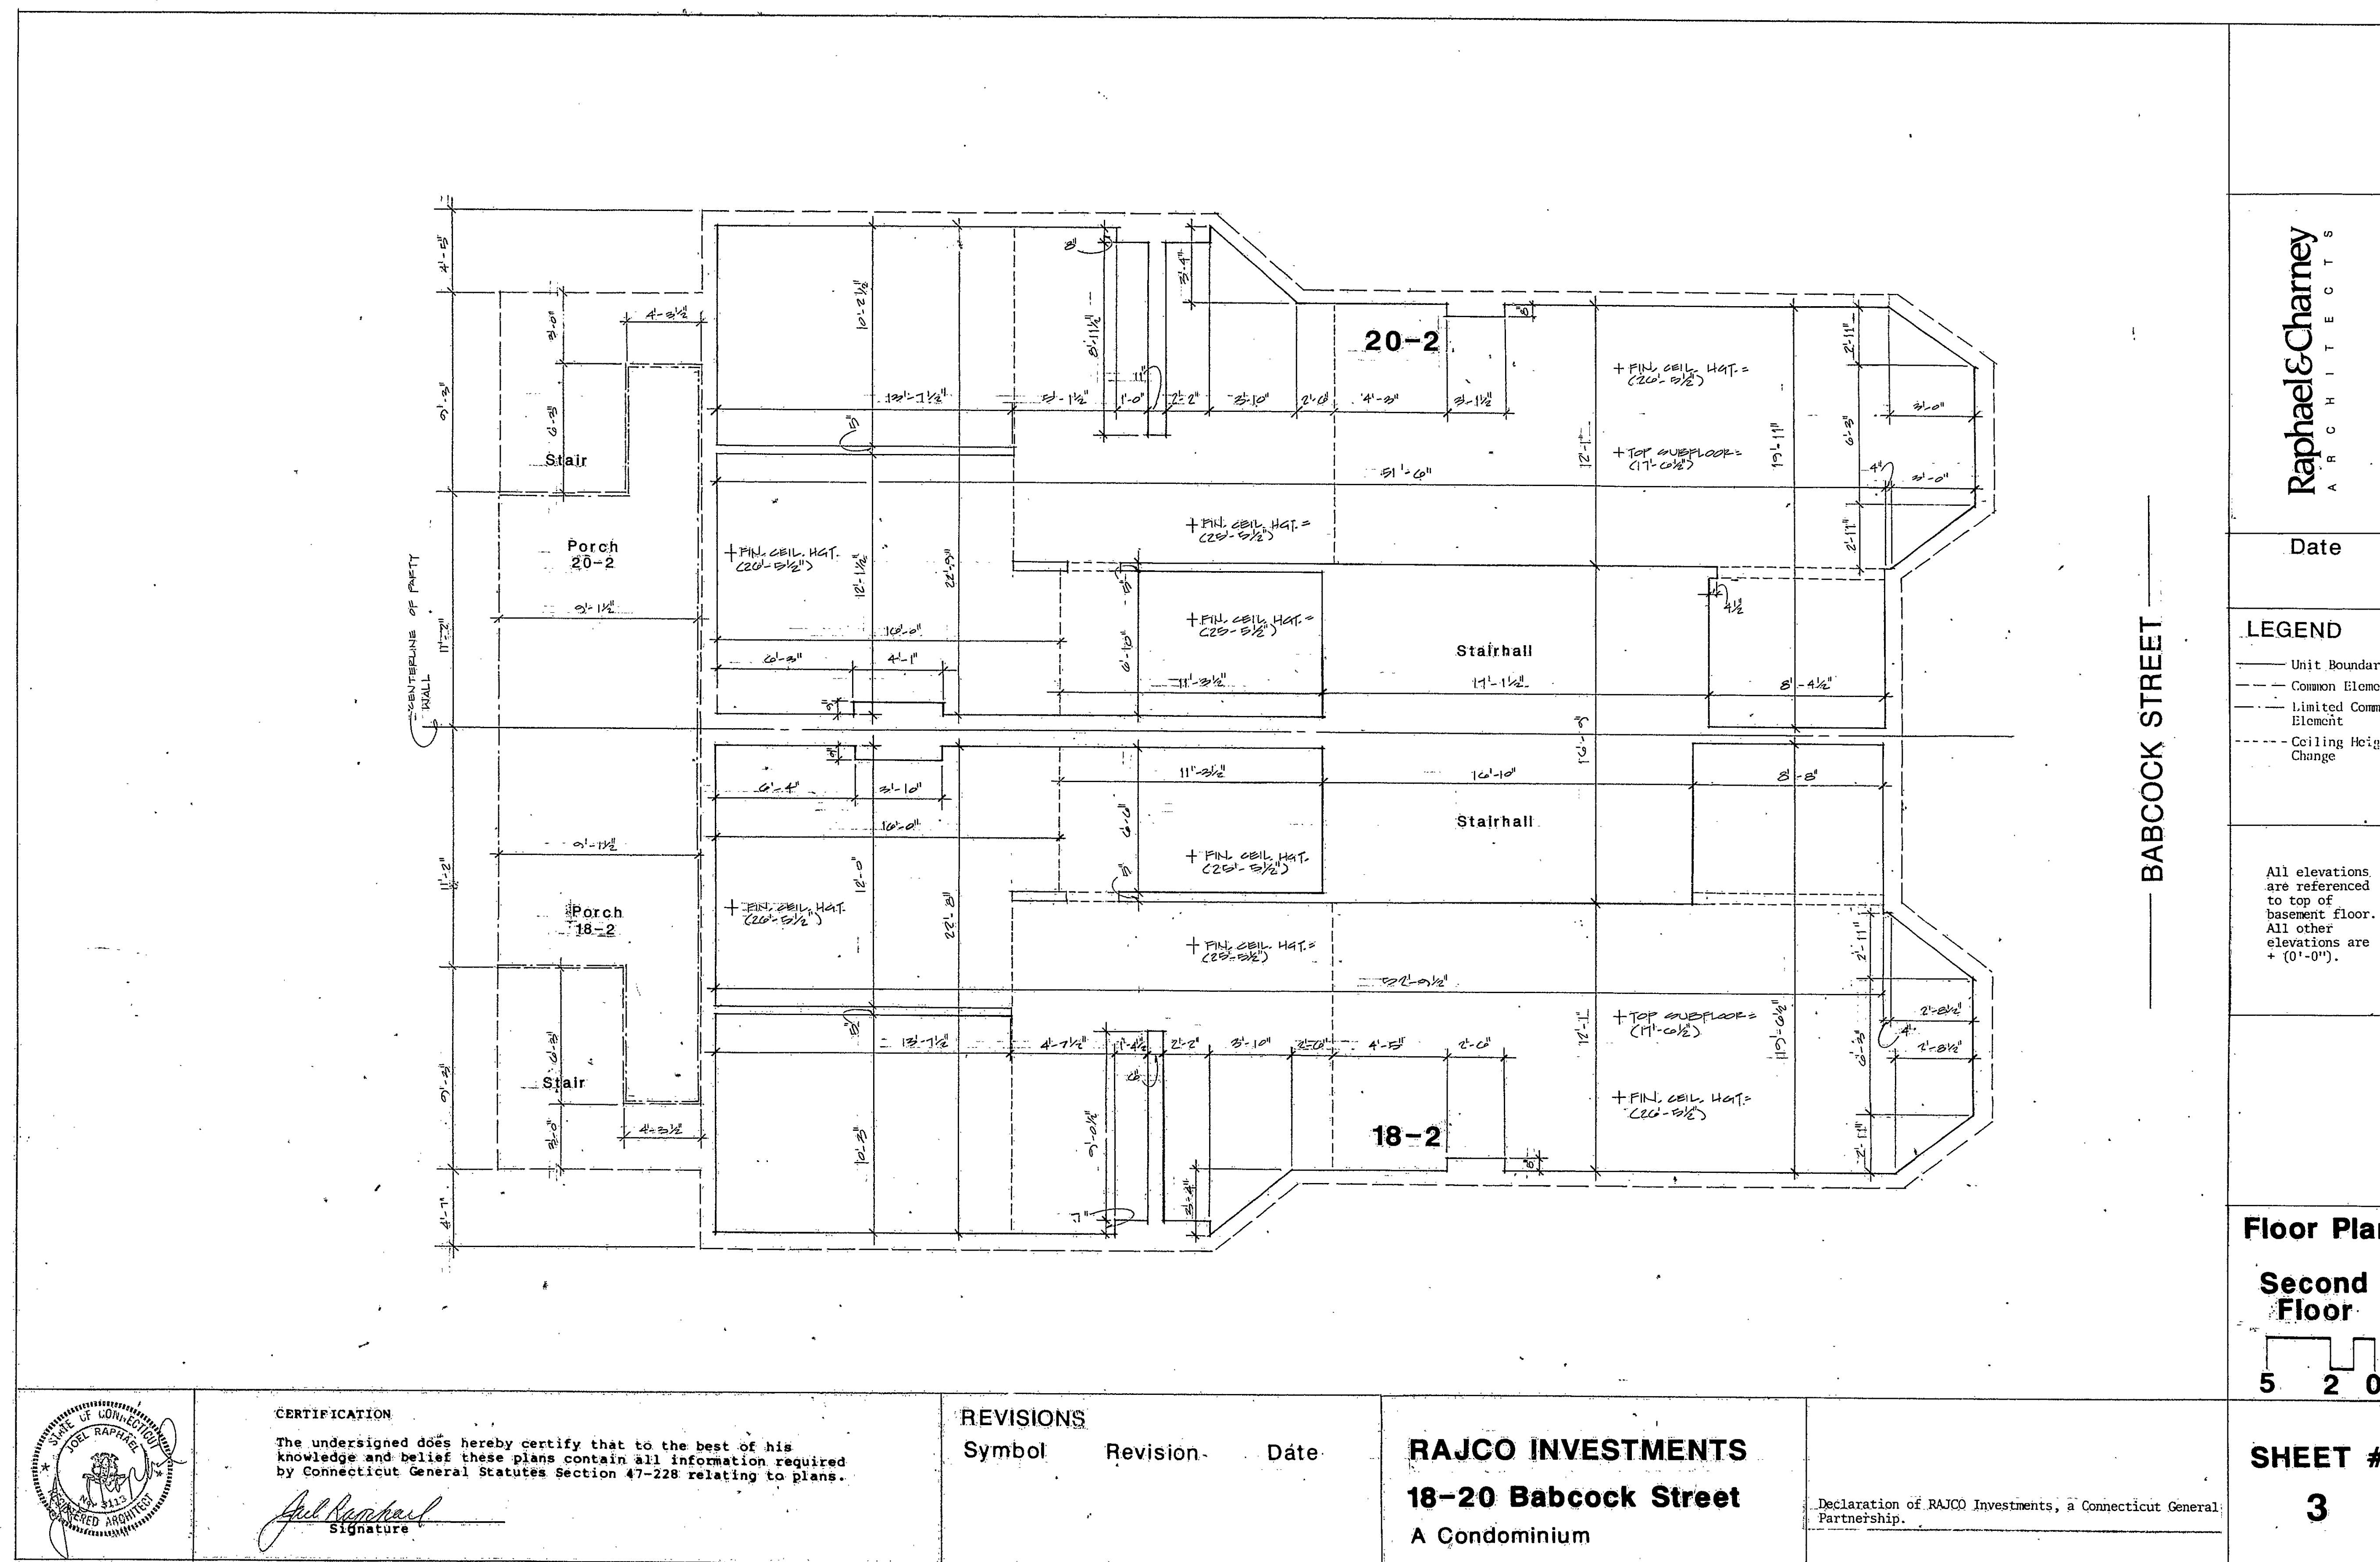

Condo Floor Plan #18-20

