


11146
 RECEIVED BY
[Signature]




DEC 30 3 38 PM '83

TOWN & CITY CLERK
 HARTFORD

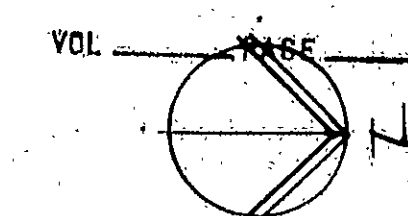

UNIT NET AREA - SQUARE FOOTAGE


UNIT	SQUARE FOOTAGE
A.	1,322
B.	1,207
C.	1,203
D.	1,202
E.	1,235
TOTAL	6,169

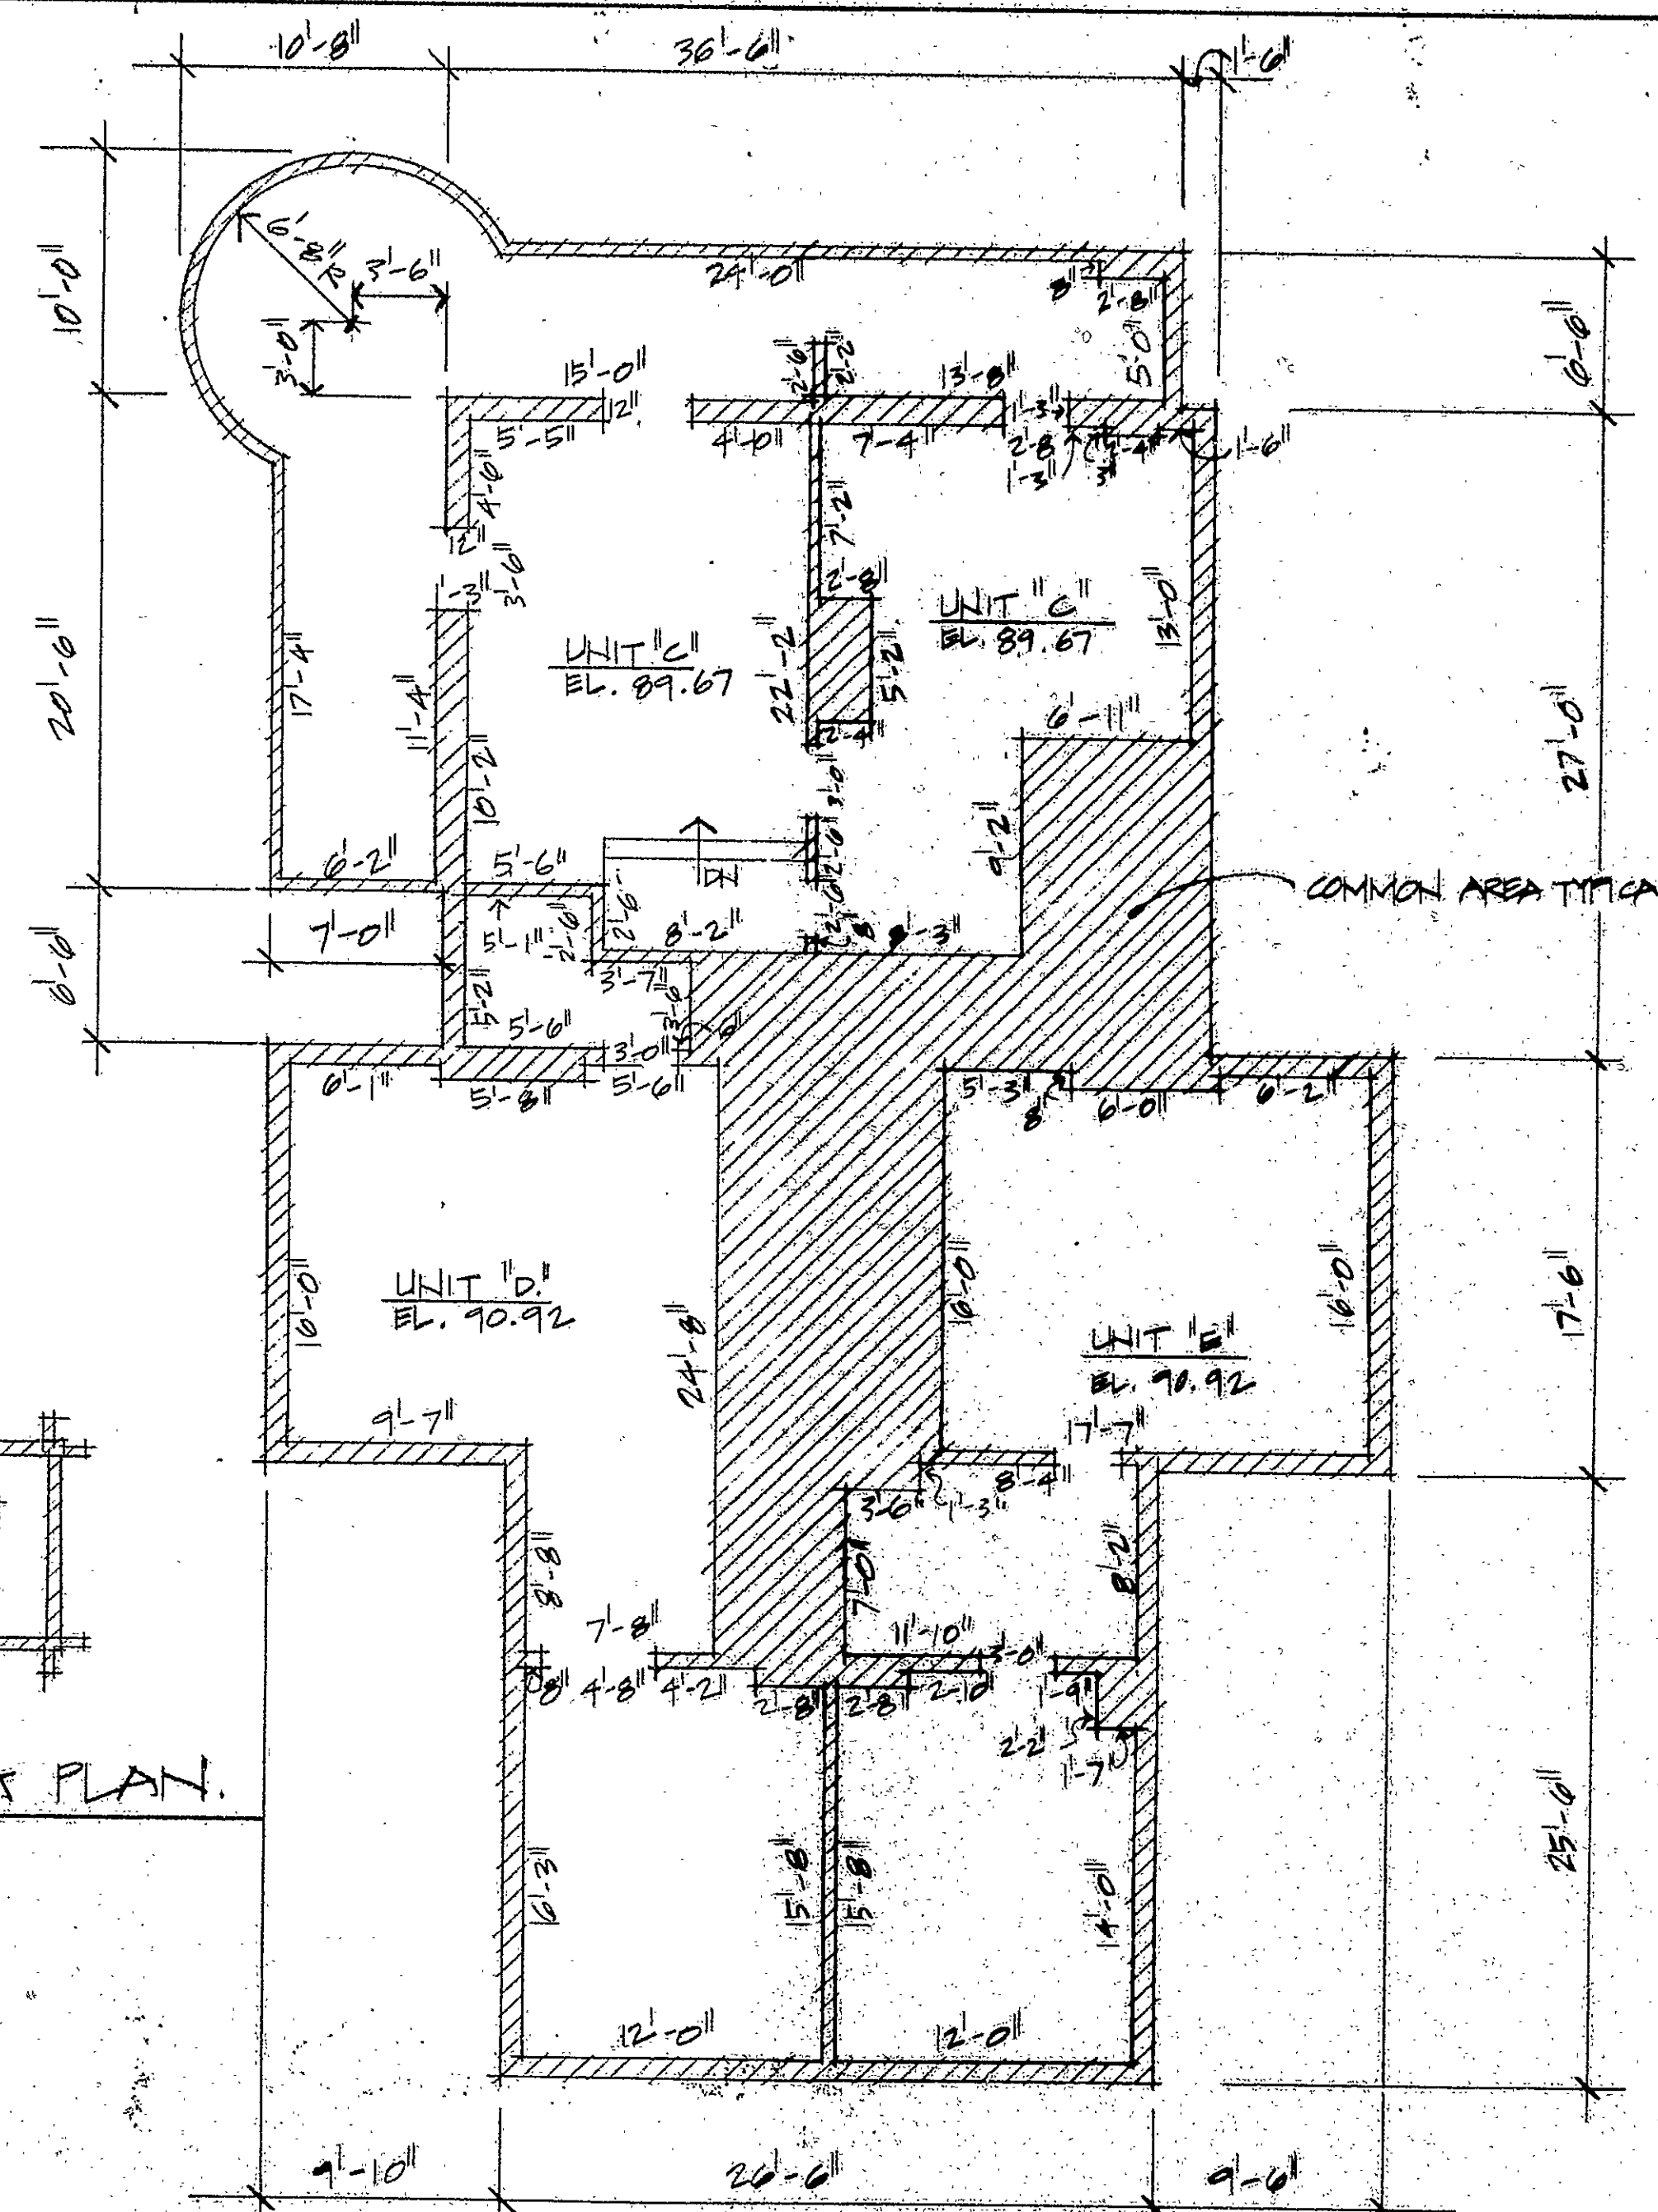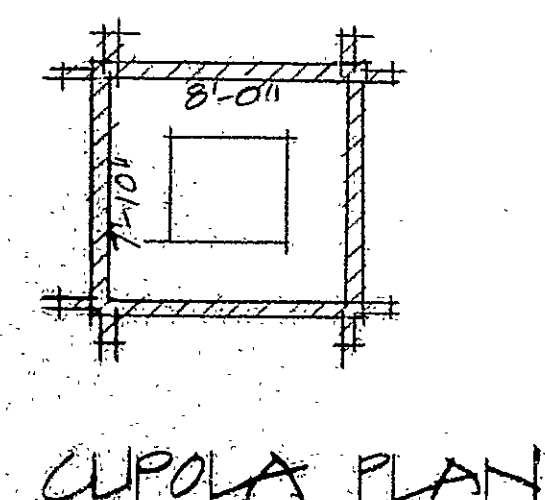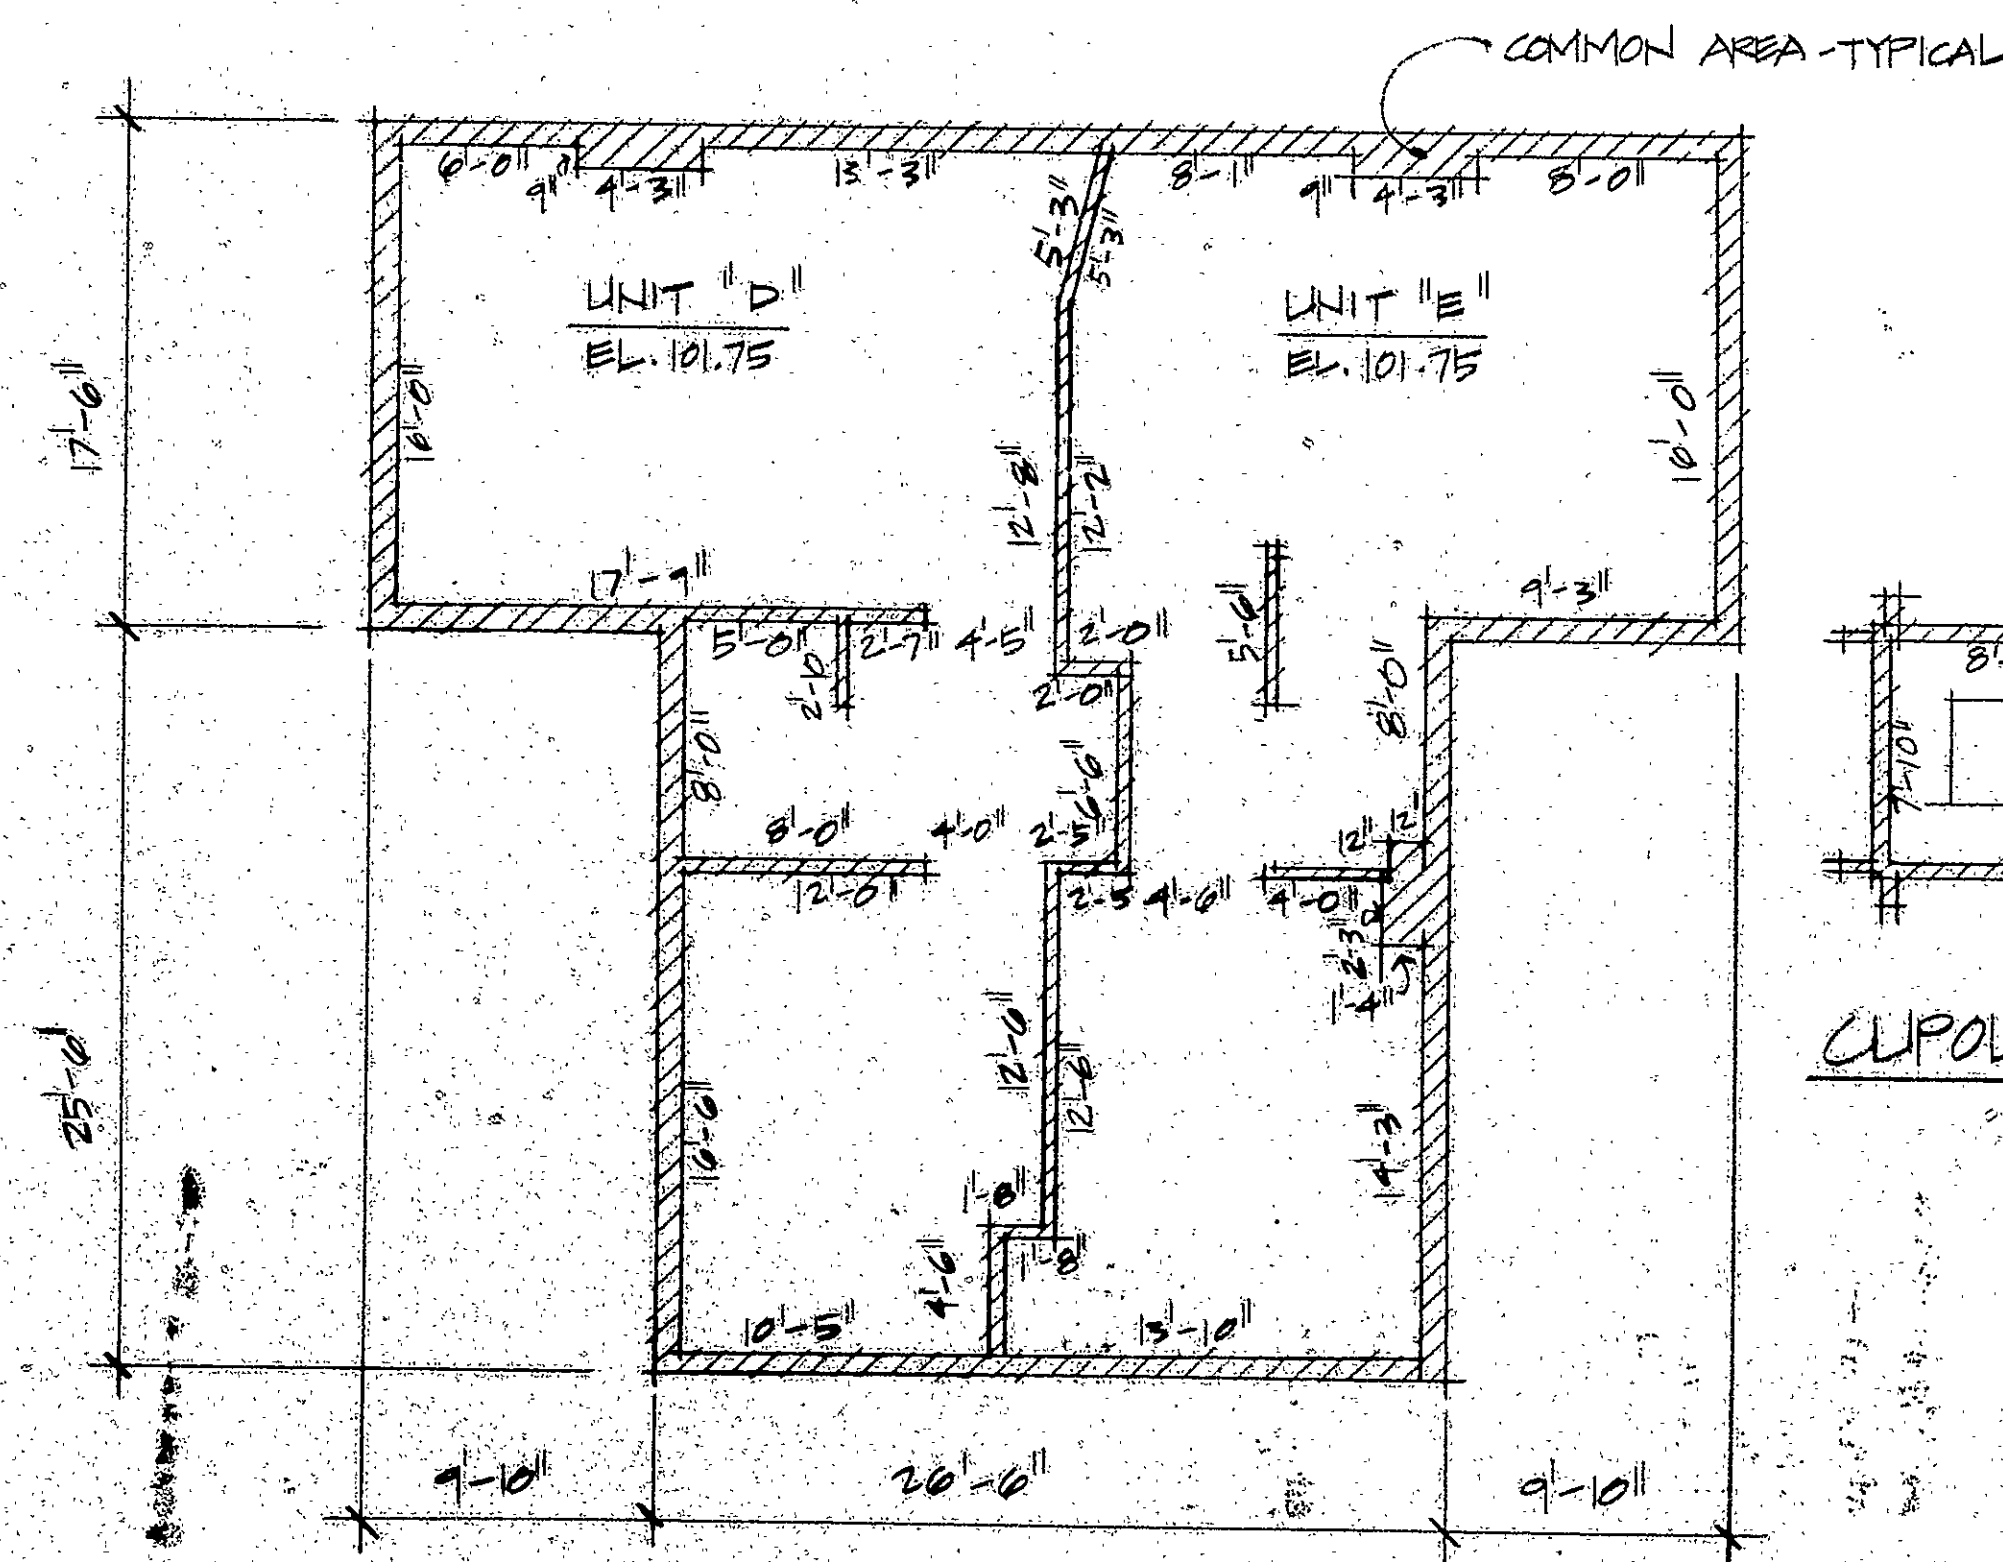

27 CHARTER OAK PLACE
 HARTFORD, CONNECTICUT

SATLING MANSION
 LIMITED PARTNERSHIP

2

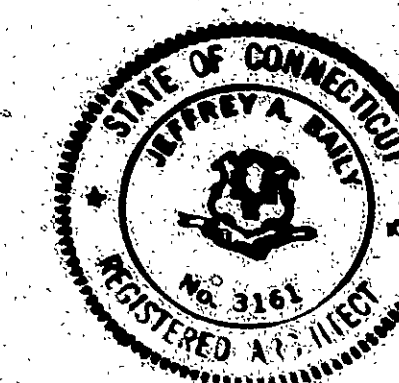

Floor Plan #79

