


Condo #81

[illegible]

100 4 11 55 AM '84
 TOWN & CITY CLERK
 HARTFORD
 PAGE 2
 RECEIVED 91
 100 4 11 55 AM '84

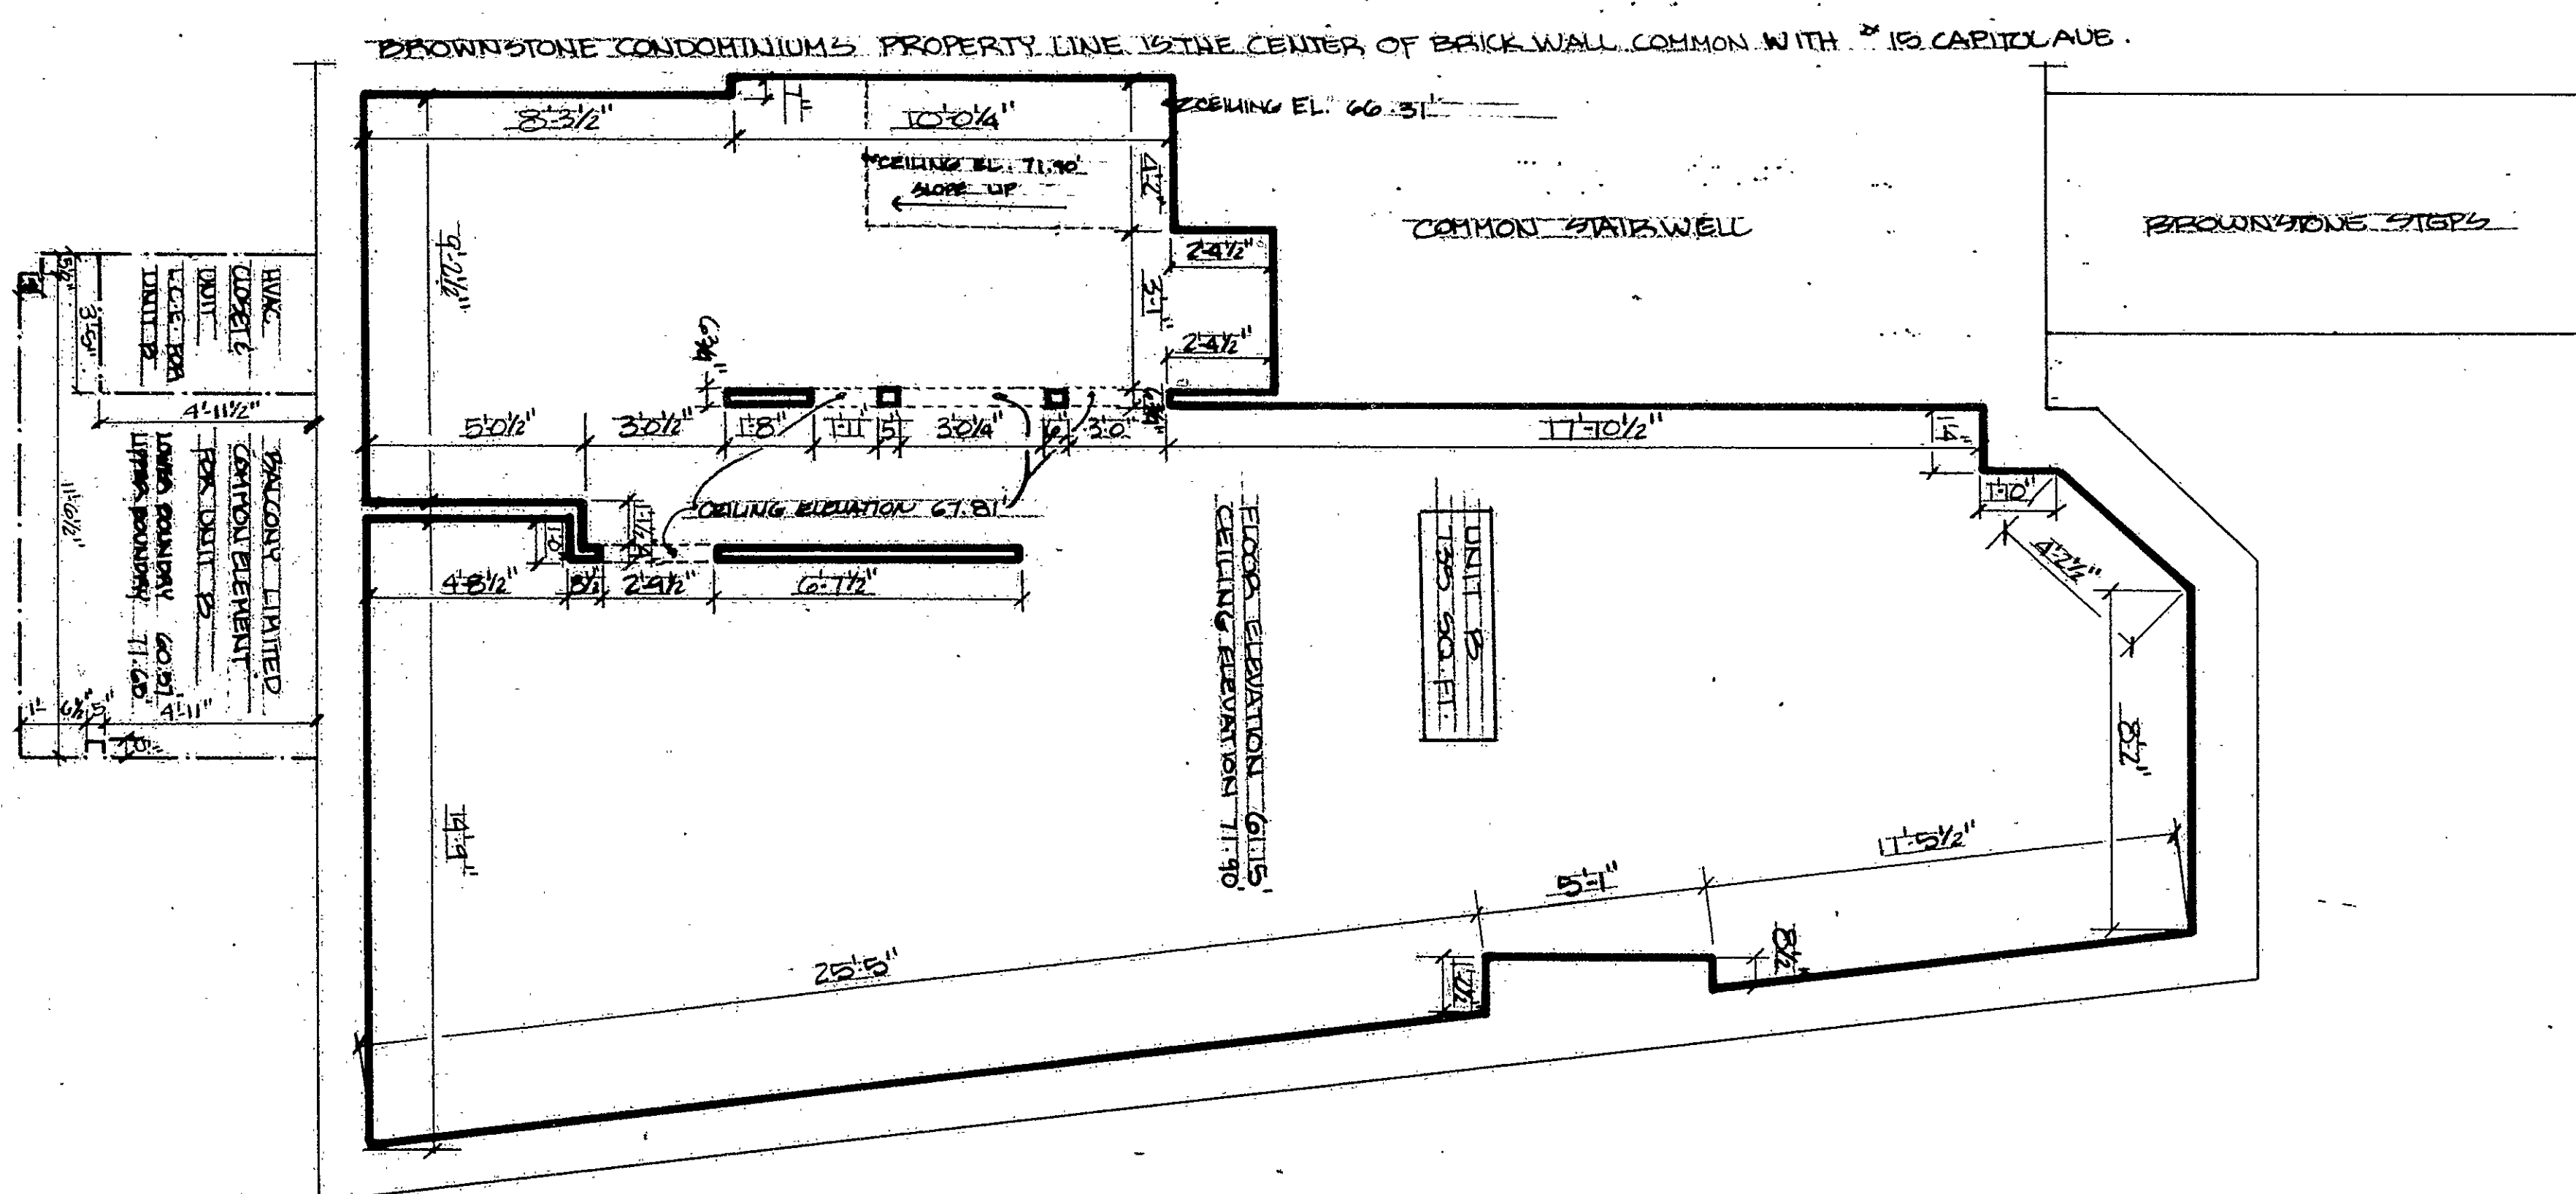