


Comdo #81

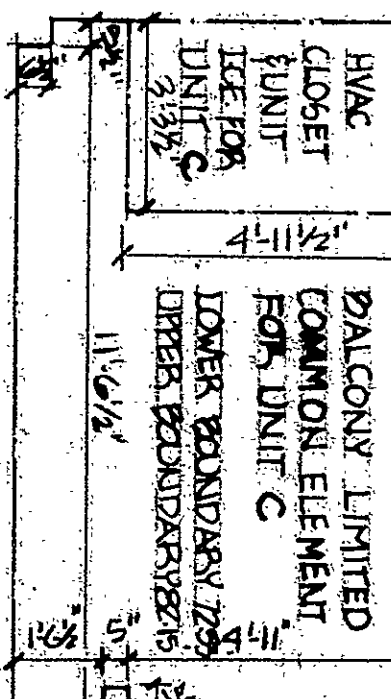

UNIT 'C' BROWNSTONE CONDOMINIUMS SECOND FLOOR
11 CAPITOL AVENUE, HARTFORD, CONNECTICUT

EXTERIOR WALL OF BUILDING
UNIT BOUNDARY
LIMITED COMMON ELEMENT BOUNDARY
CEILING ELEVATION CHANGE

THE PURPOSE OF THESE DRAWINGS IS TO SHOW APPROXIMATE DIMENSIONS, RISE AND FALL, AND LOCATION OF EACH UNIT AND THE LOCATION AND APPROXIMATE DIMENSIONS OF THE UNITED COLLECTOR ELEMENTS.

WITHIN UNITS 1-5 SOLID BLACK OUTLINED SHAPES REPRESENT COMMON ELEMENTS (E.G. PAVING, WALLS AND COLUMNS).


[Signature]

JOSEPH P. KOWLES

CLERK

RECORDED & INDEXED

CT REG 3023

[illegible]

My commission expires 4/1/19

RECEIVED BY
TOWN & CITY CLERK
HARTFORD
OCT 4 11 55 AM '84
PAGE 107

