


Condo #81

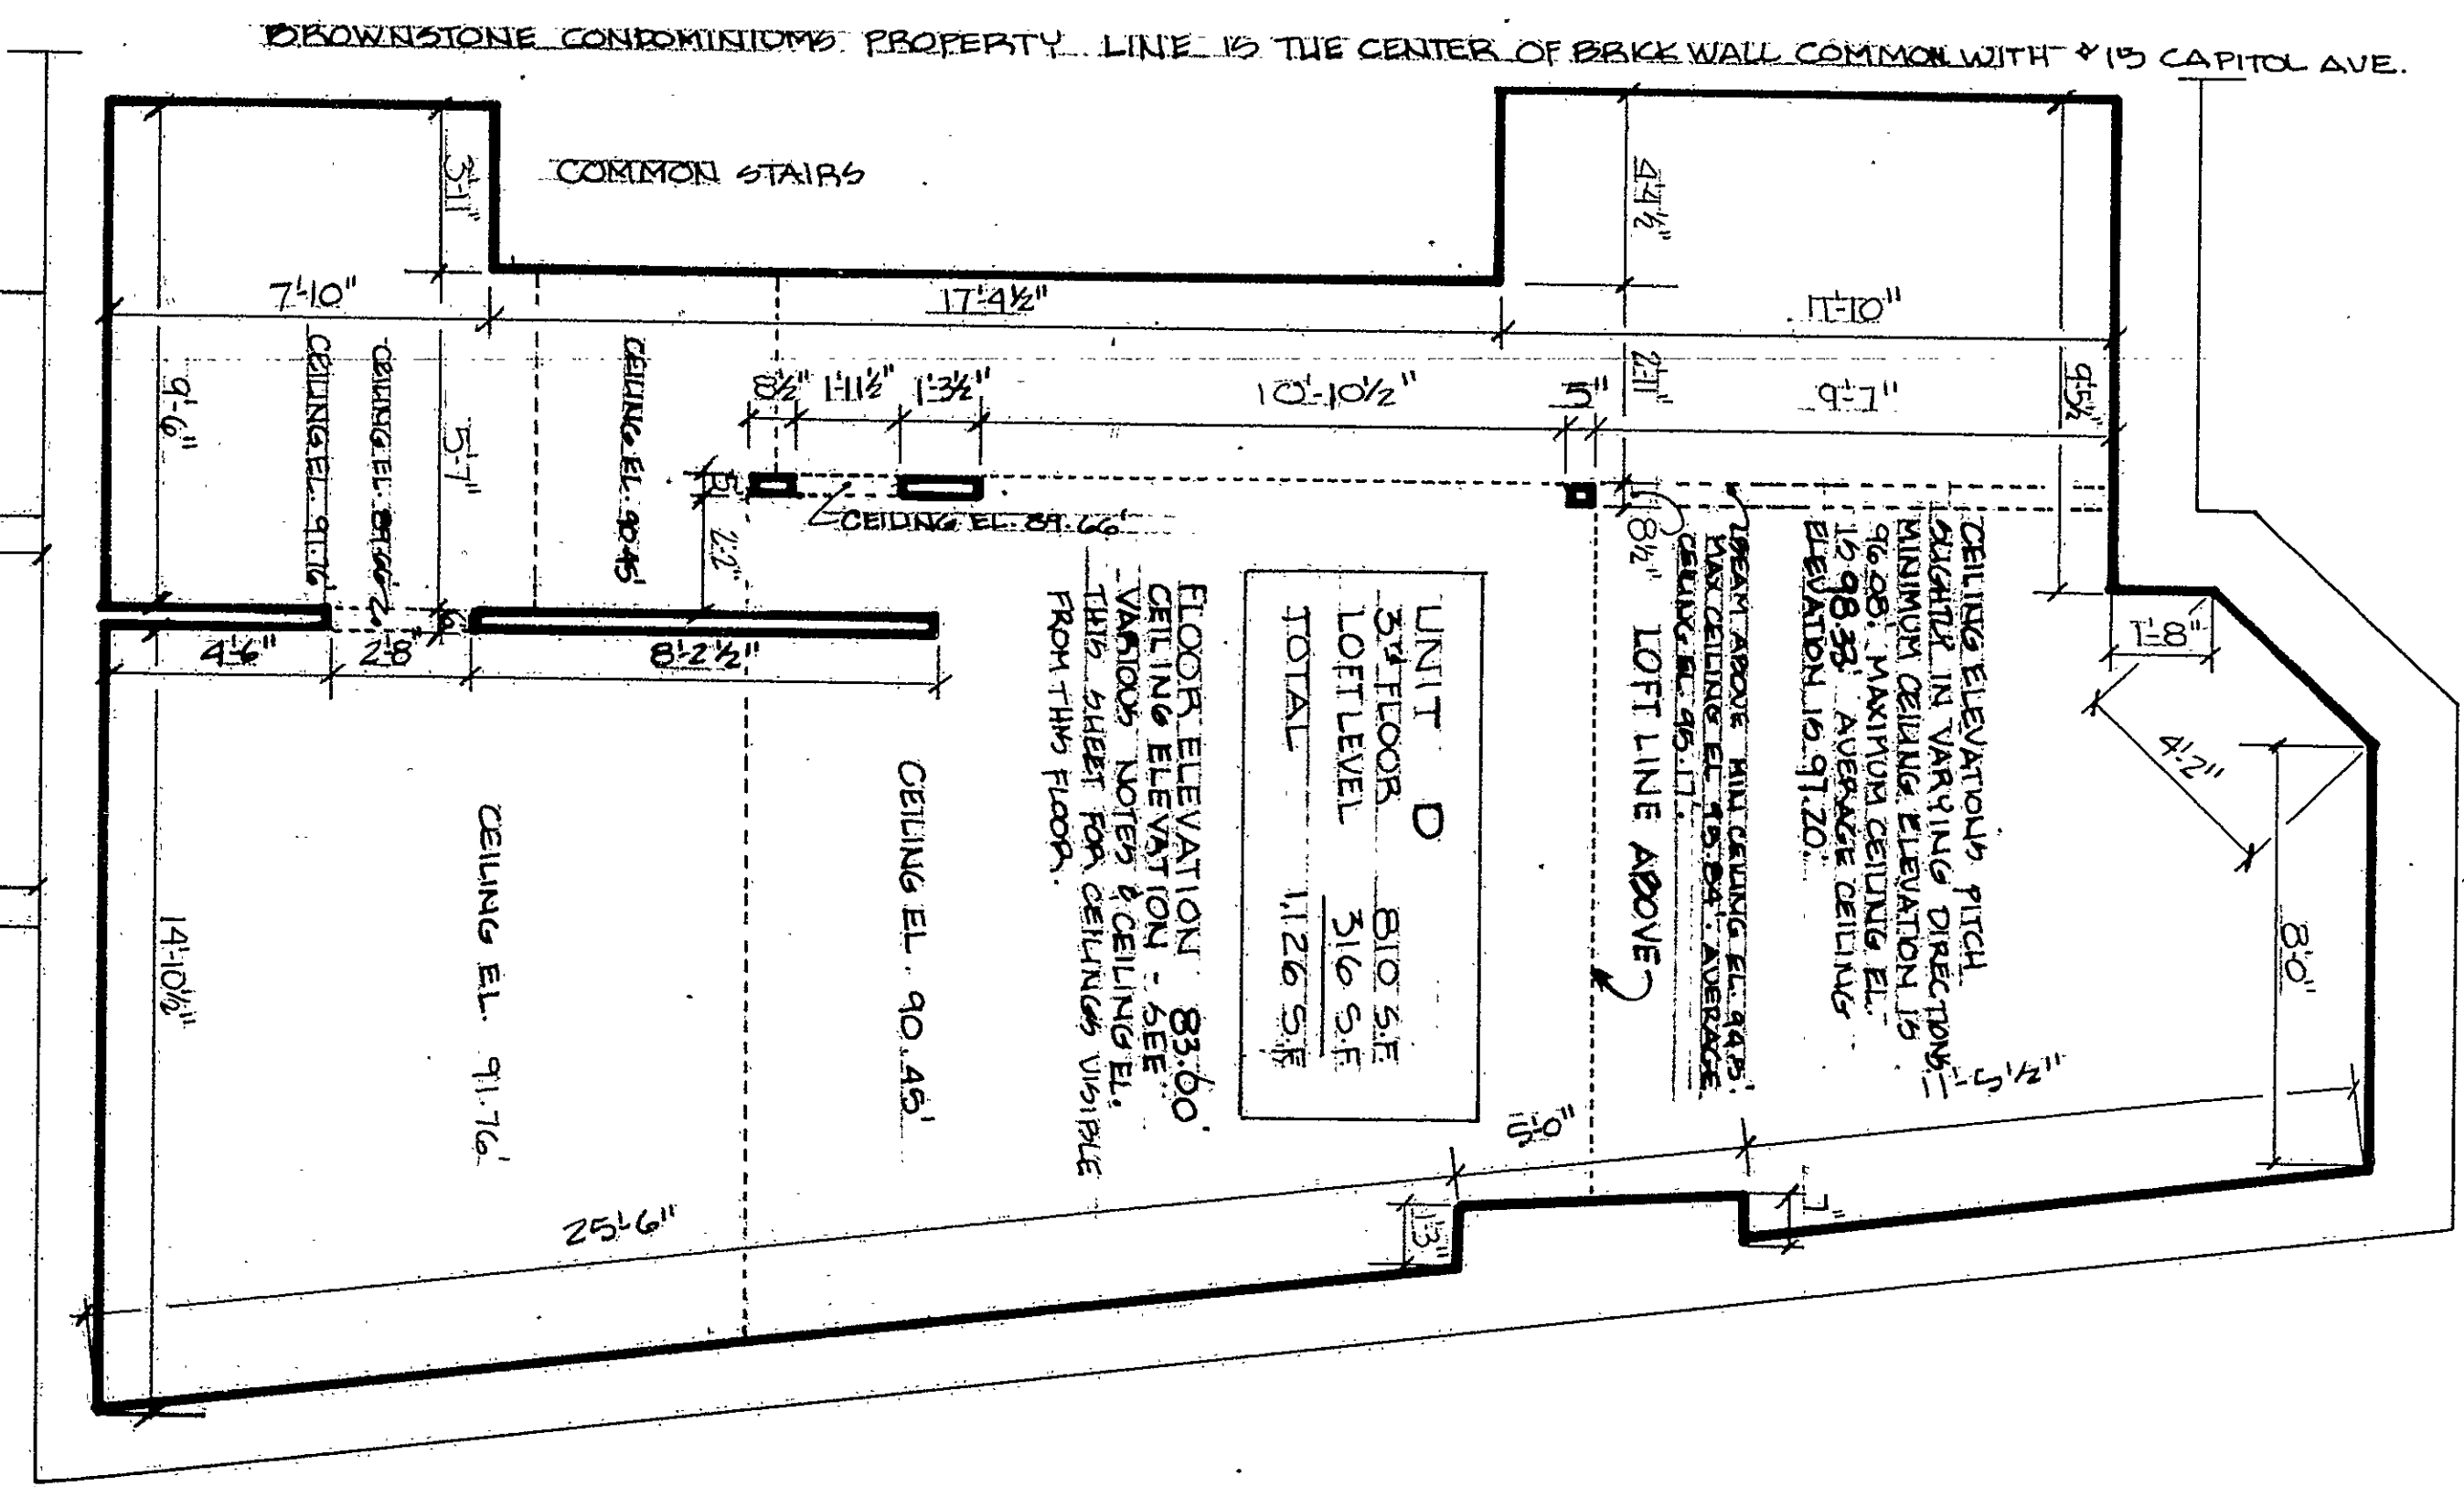

11 CAPITOL AVENUE, HARTFORD, CONNECTICUT

EXTERIOR WALL OF BUILDING
UNIT BOUNDARY
UNITED COMMON ELEMENT BOUNDARY
CEILING ELEVATION CHANGING

ELEVATION BASED TO HOC BEACH MARK T-1, EL. 90.85

I HEREBY CERTIFY THAT THESE PLANS ARE AN ACCURATE COPY OF THE PLAN OF THE BUILDING FILED WITH THE BUILDING OFFICE OF THE CITY OF HARTFORD, AND ARE IN FULL COMPLIANCE WITH THE CITY OF HARTFORD, CONNECTICUT, ORDINANCE NO. 10-119, AS AMENDED.

David R. Lawrence AT 084 35 23
REGISTERED ARCHITECT

PREVIOUSLY APPEARED BEFORE ME, DAVID R. LAWRENCE, ARCHITECT, SIGNER OF THE PREVIOUS CERTIFICATE, AND DAVID R. LAWRENCE, ARCHITECT, SIGNER OF THIS CERTIFICATE, WHOSE NAME IS SUBSCRIBED TO THIS CERTIFICATE, HAS BEEN SUBSCRIBED AND GIVEN TO BEFORE ME THIS 21st DAY OF August 1984.

NOTARY PUBLIC Paul Tarrant MY COMMISSION EXPIRES 4/1/85

PAGE 37
TOWN & CITY CLERK
HARTFORD
OCT 4 11 56 AM '84
RECEIVED AT

