



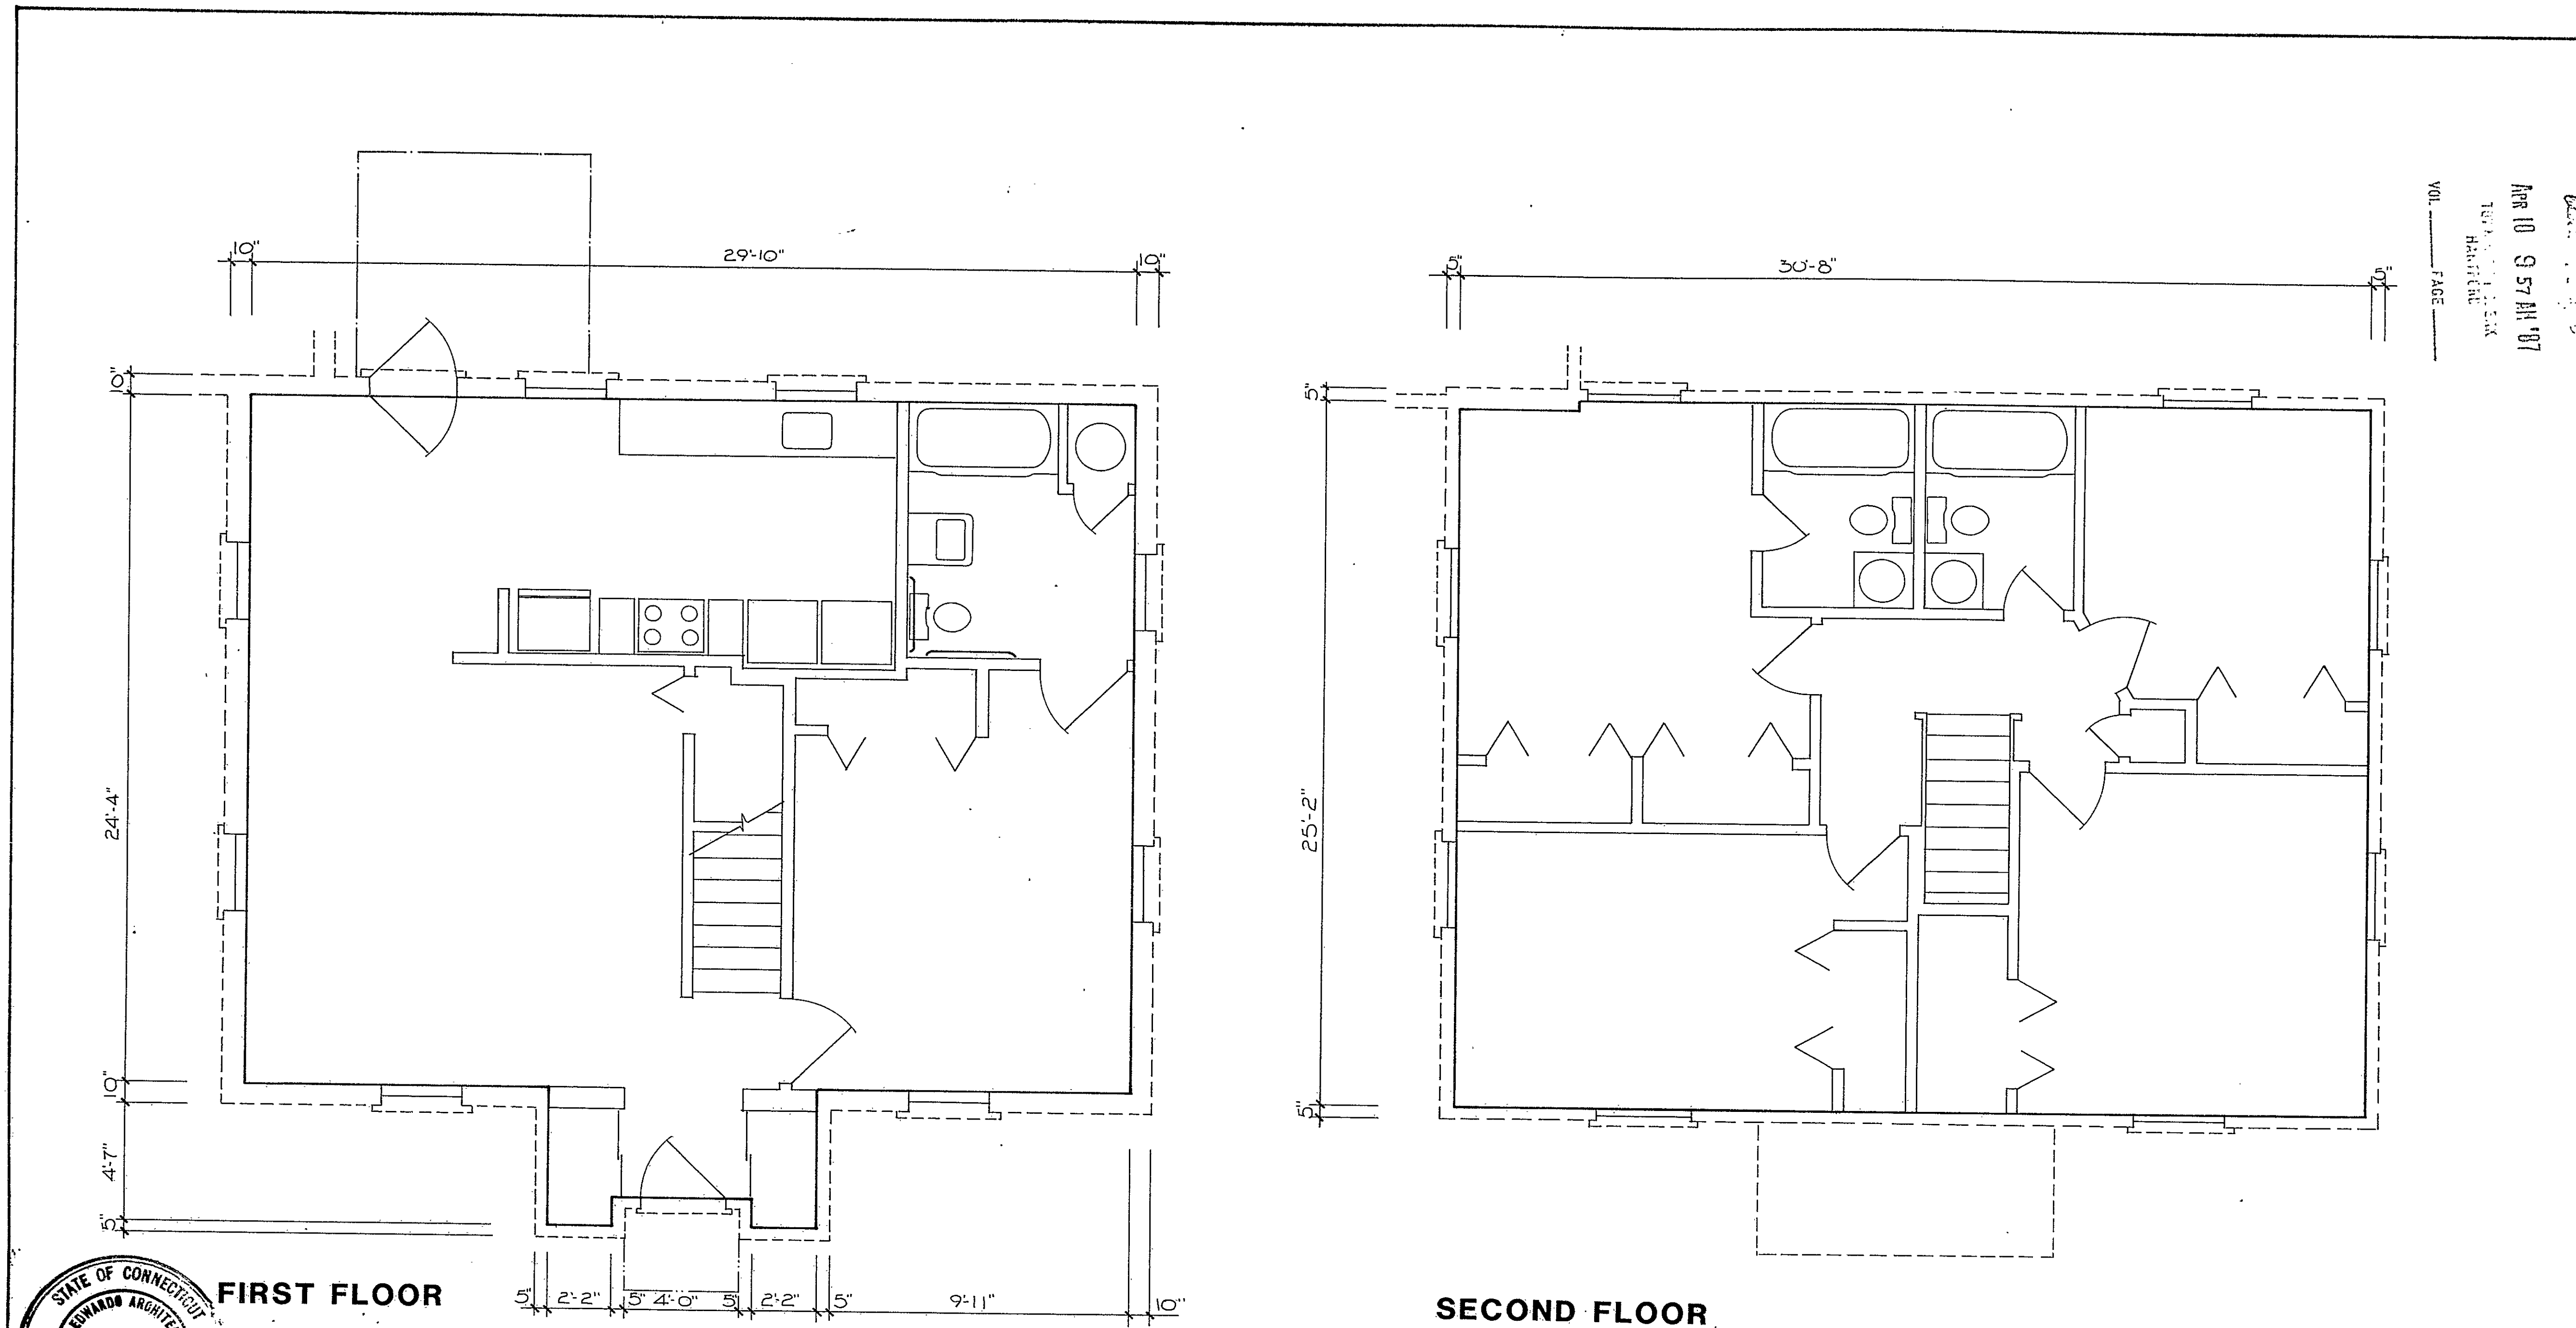

APR 10 9 57 AM '87
 HARTFORD, CT
 VOL. _____ FACE _____

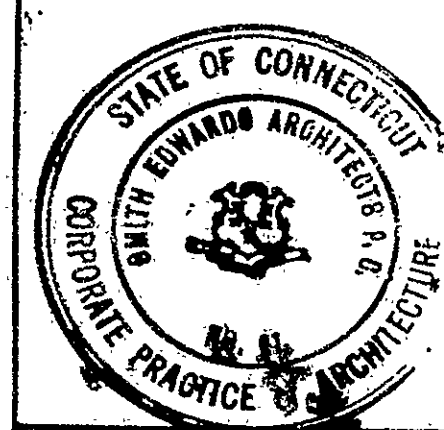

FIRST FLOOR

SECOND FLOOR

**THIS PLAN APPLIES TO THE FOLLOWING UNIT
 37**

CERTIFICATION I certify that these plans contain all information required by Section 47-228 of the Connecticut General Statutes, except for required information which is shown on the survey prepared pursuant to said section for this condominium. <i>Tyler Smith 12/10/85</i> Tyler Smith, Architect The word certify is understood to be an expression of professional opinion by the Architect which is based on his best knowledge, information and belief. As such it constitutes neither a guarantee or a warranty, expressed or implied.	CROWN GARDENS HARTFORD, CONNECTICUT	NOTES: 1. First floor elevations are shown on the site surveys. The ceiling height in major rooms on the first floor is 8'-0" 2. Second floor elevation is 9'-0" above first floor elevation. The ceiling height in major rooms on the second floor is 8'-0"	LEGEND UNIT BOUNDARY EXTERIOR BUILDING SURFACE LIMITED COMMON ELEMENT COMMON ELEMENT TYPICAL DIAGRAMATIC FLOOR PLAN GRAPHIC SCALE 0' 1' 2' 3' 4' 5' 10' NUMBER OF ROOMS 7 ROOMS 2 1/2 BATH APPROXIMATE AREA - SQ. FT. 37 = 1497*	UNIT TYPE G opp. DWG 14 OF 23
--	---	--	--	---

Condo Plan #85

