


88

88-1

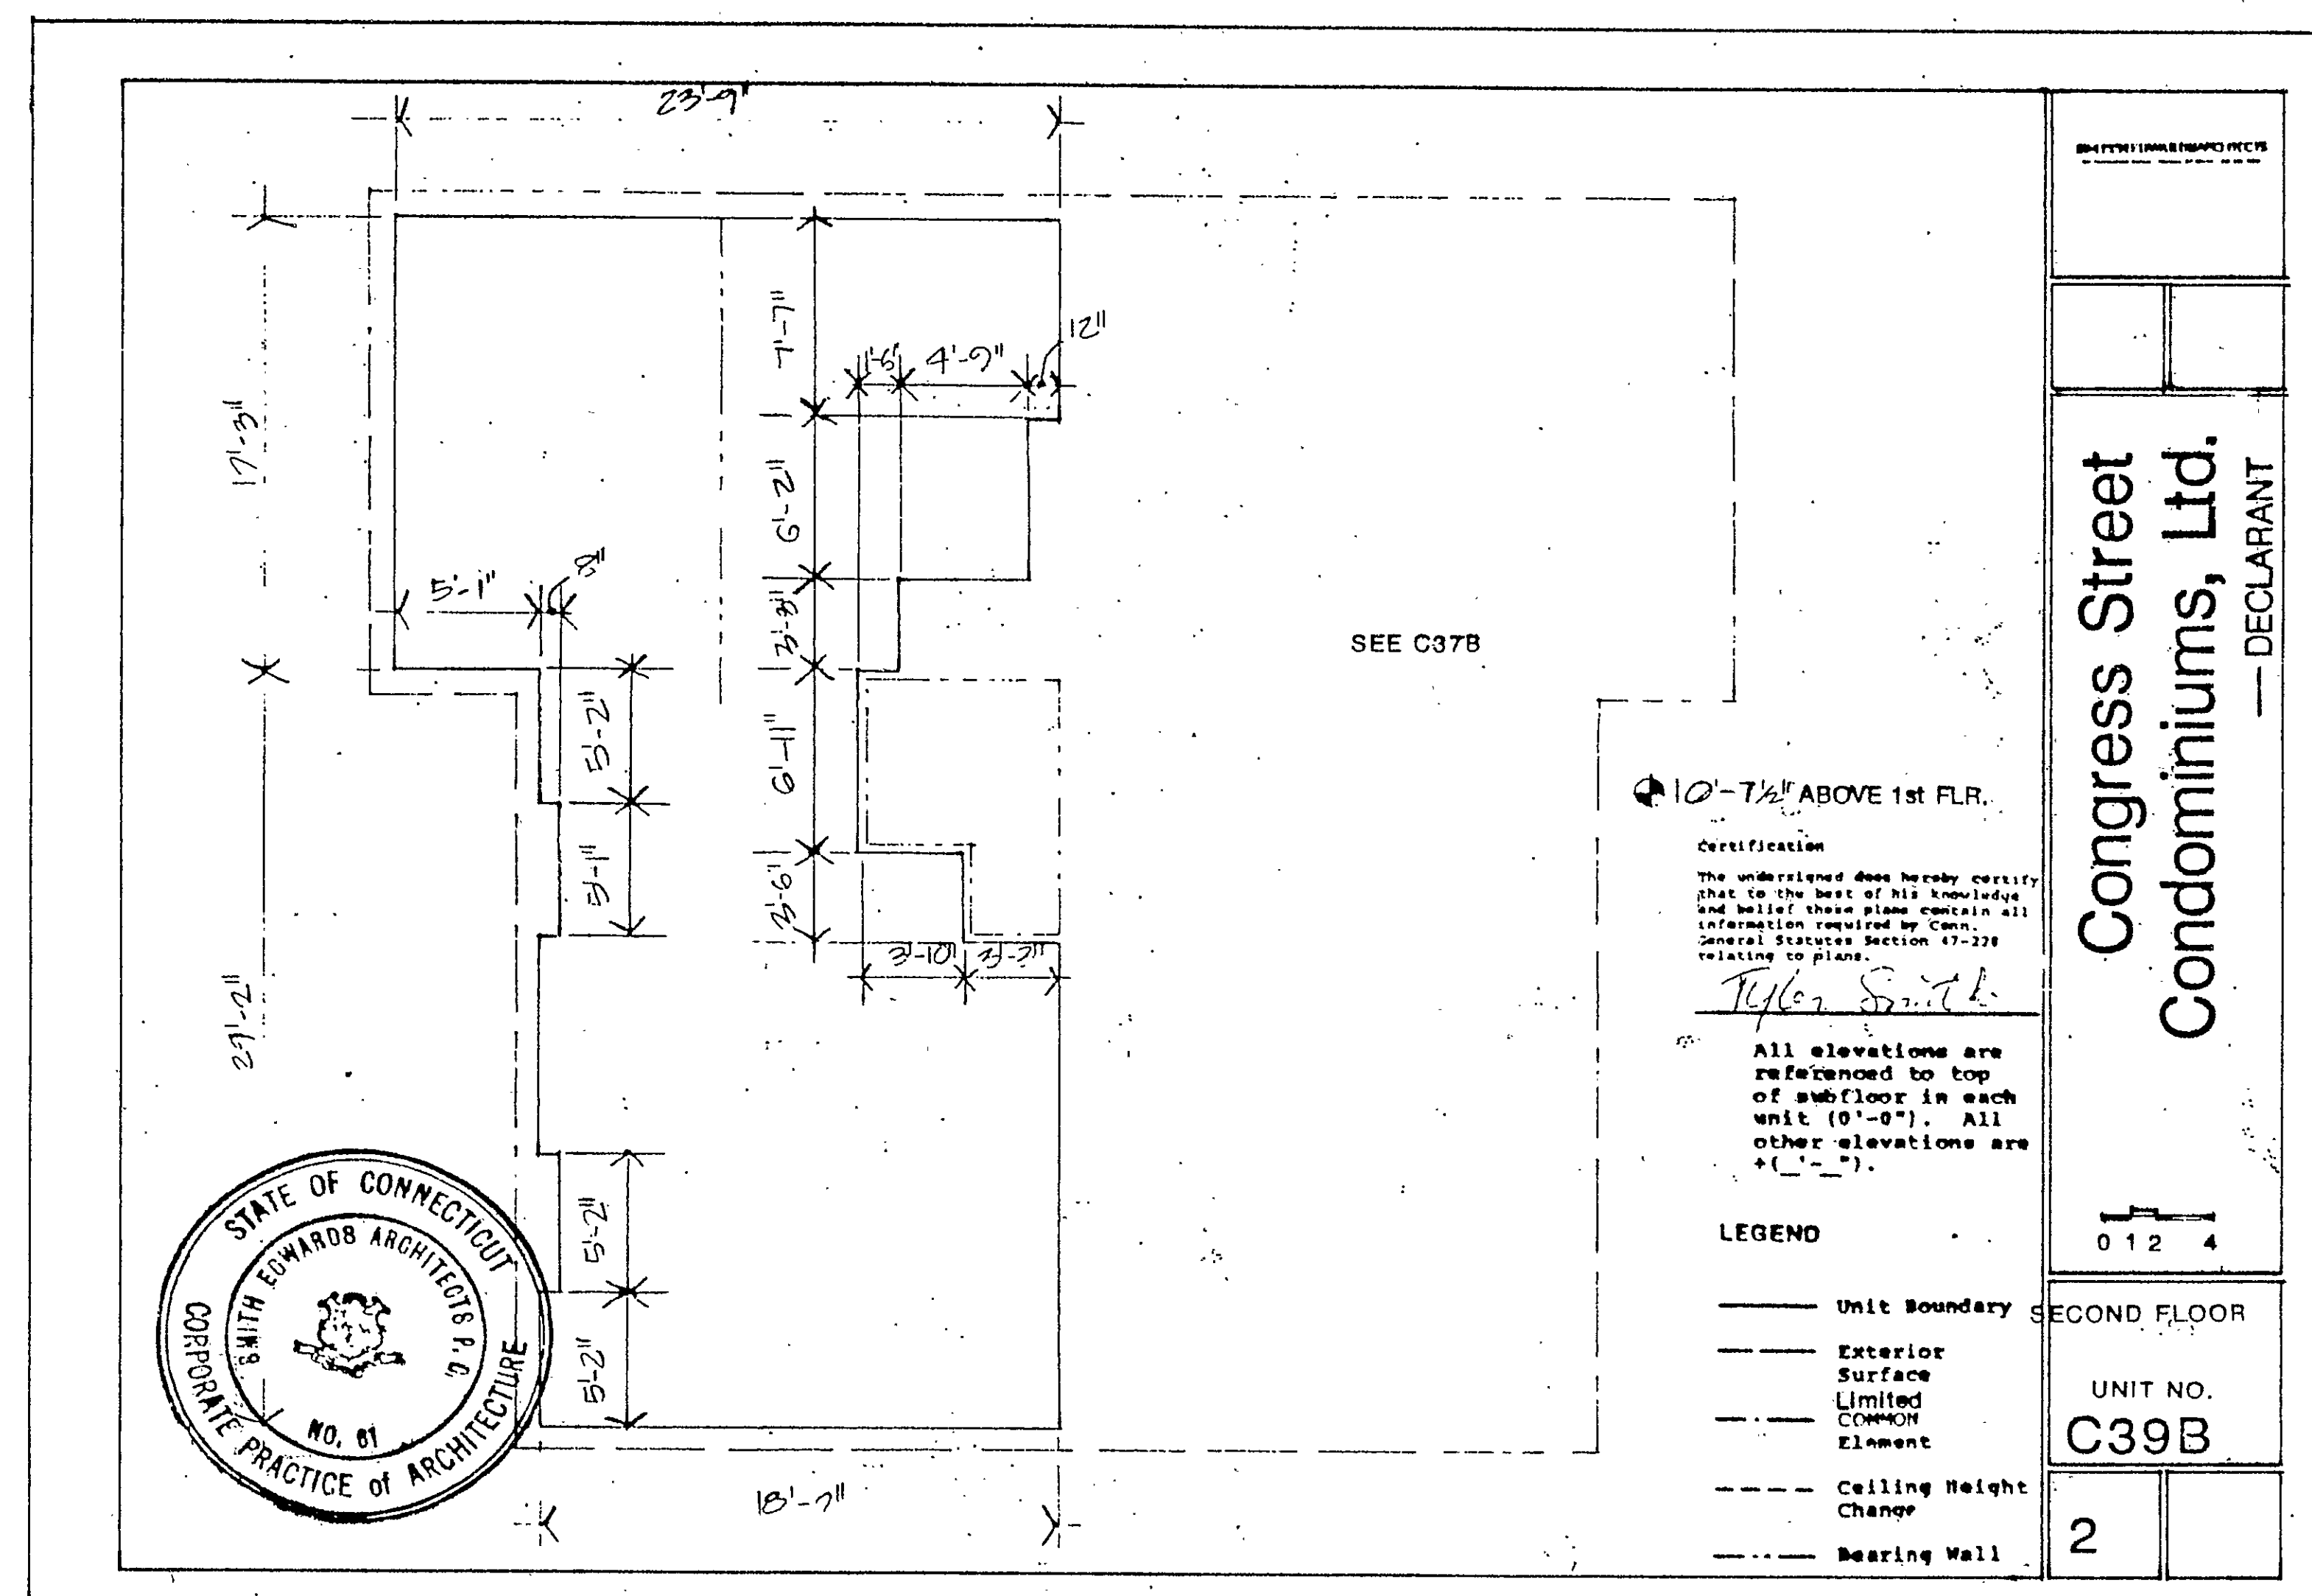

VOLUME 1

[illegible]

THE

Condo FF88

