


88

88-3

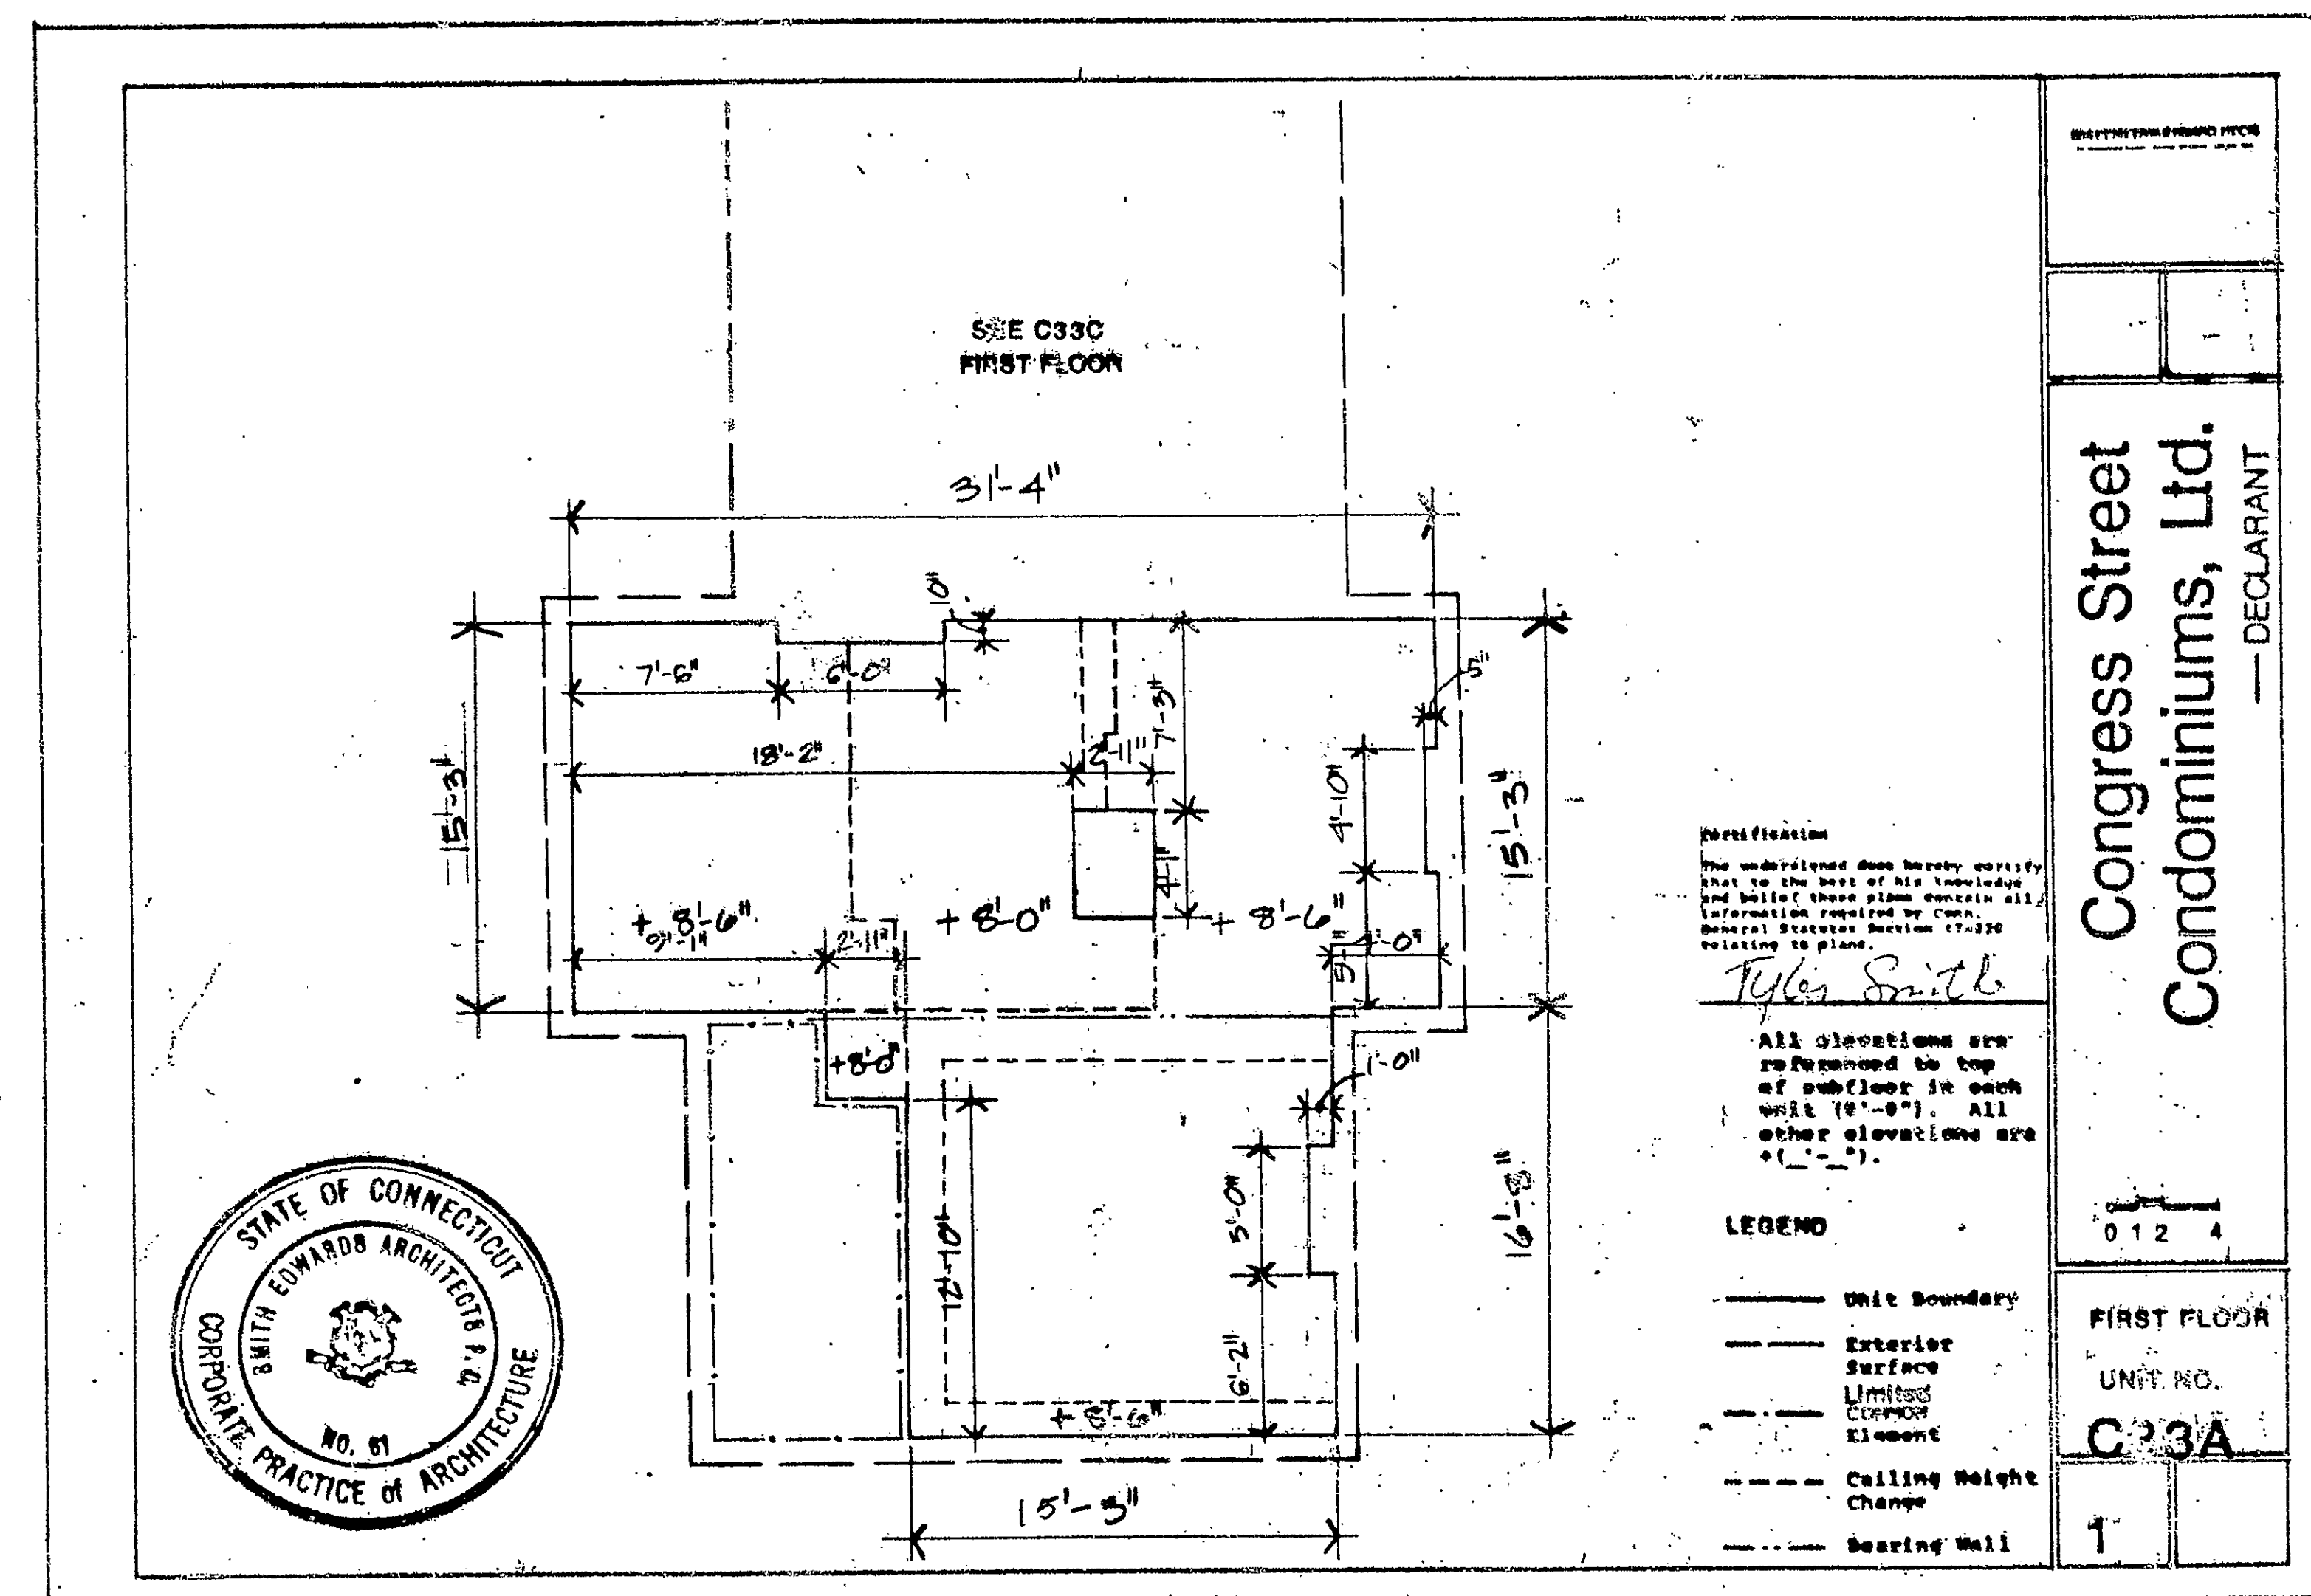





100

1

Condo #88

