




OCT 13 11 27 AM '07
 TOWN OF GREEN
 HARTFORD
 VOL. _____ PAGE _____

Conds # 88

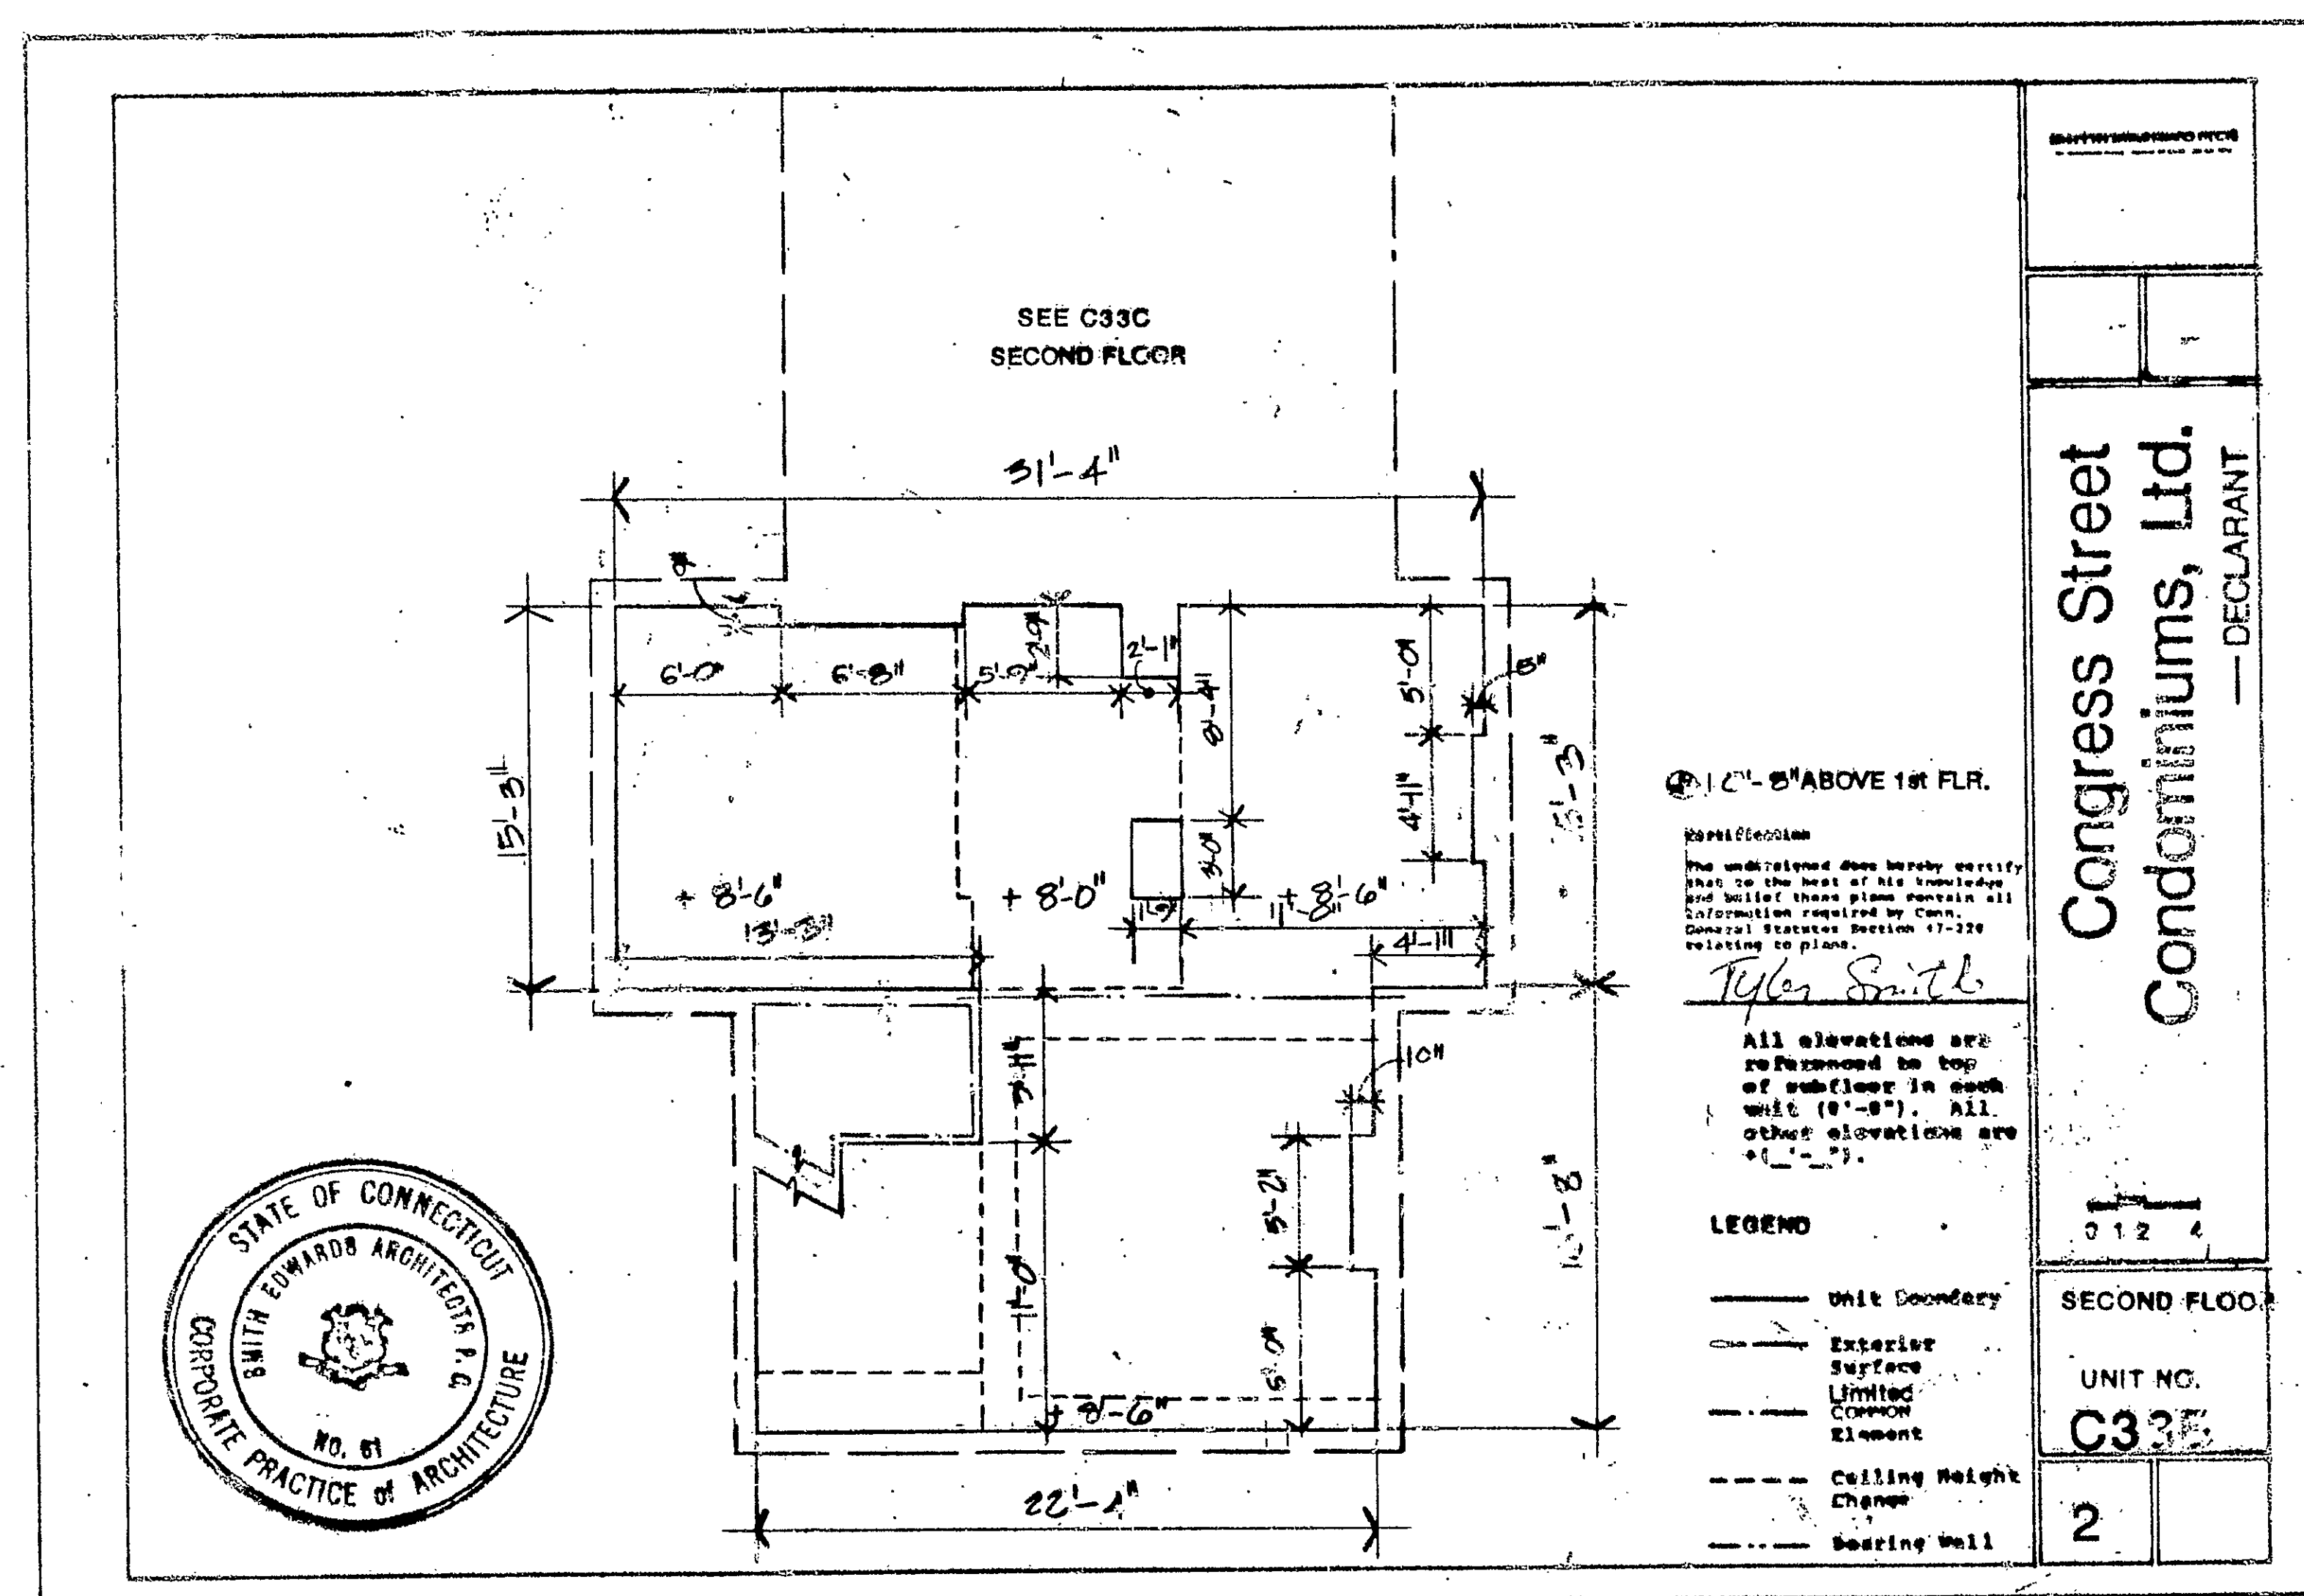