


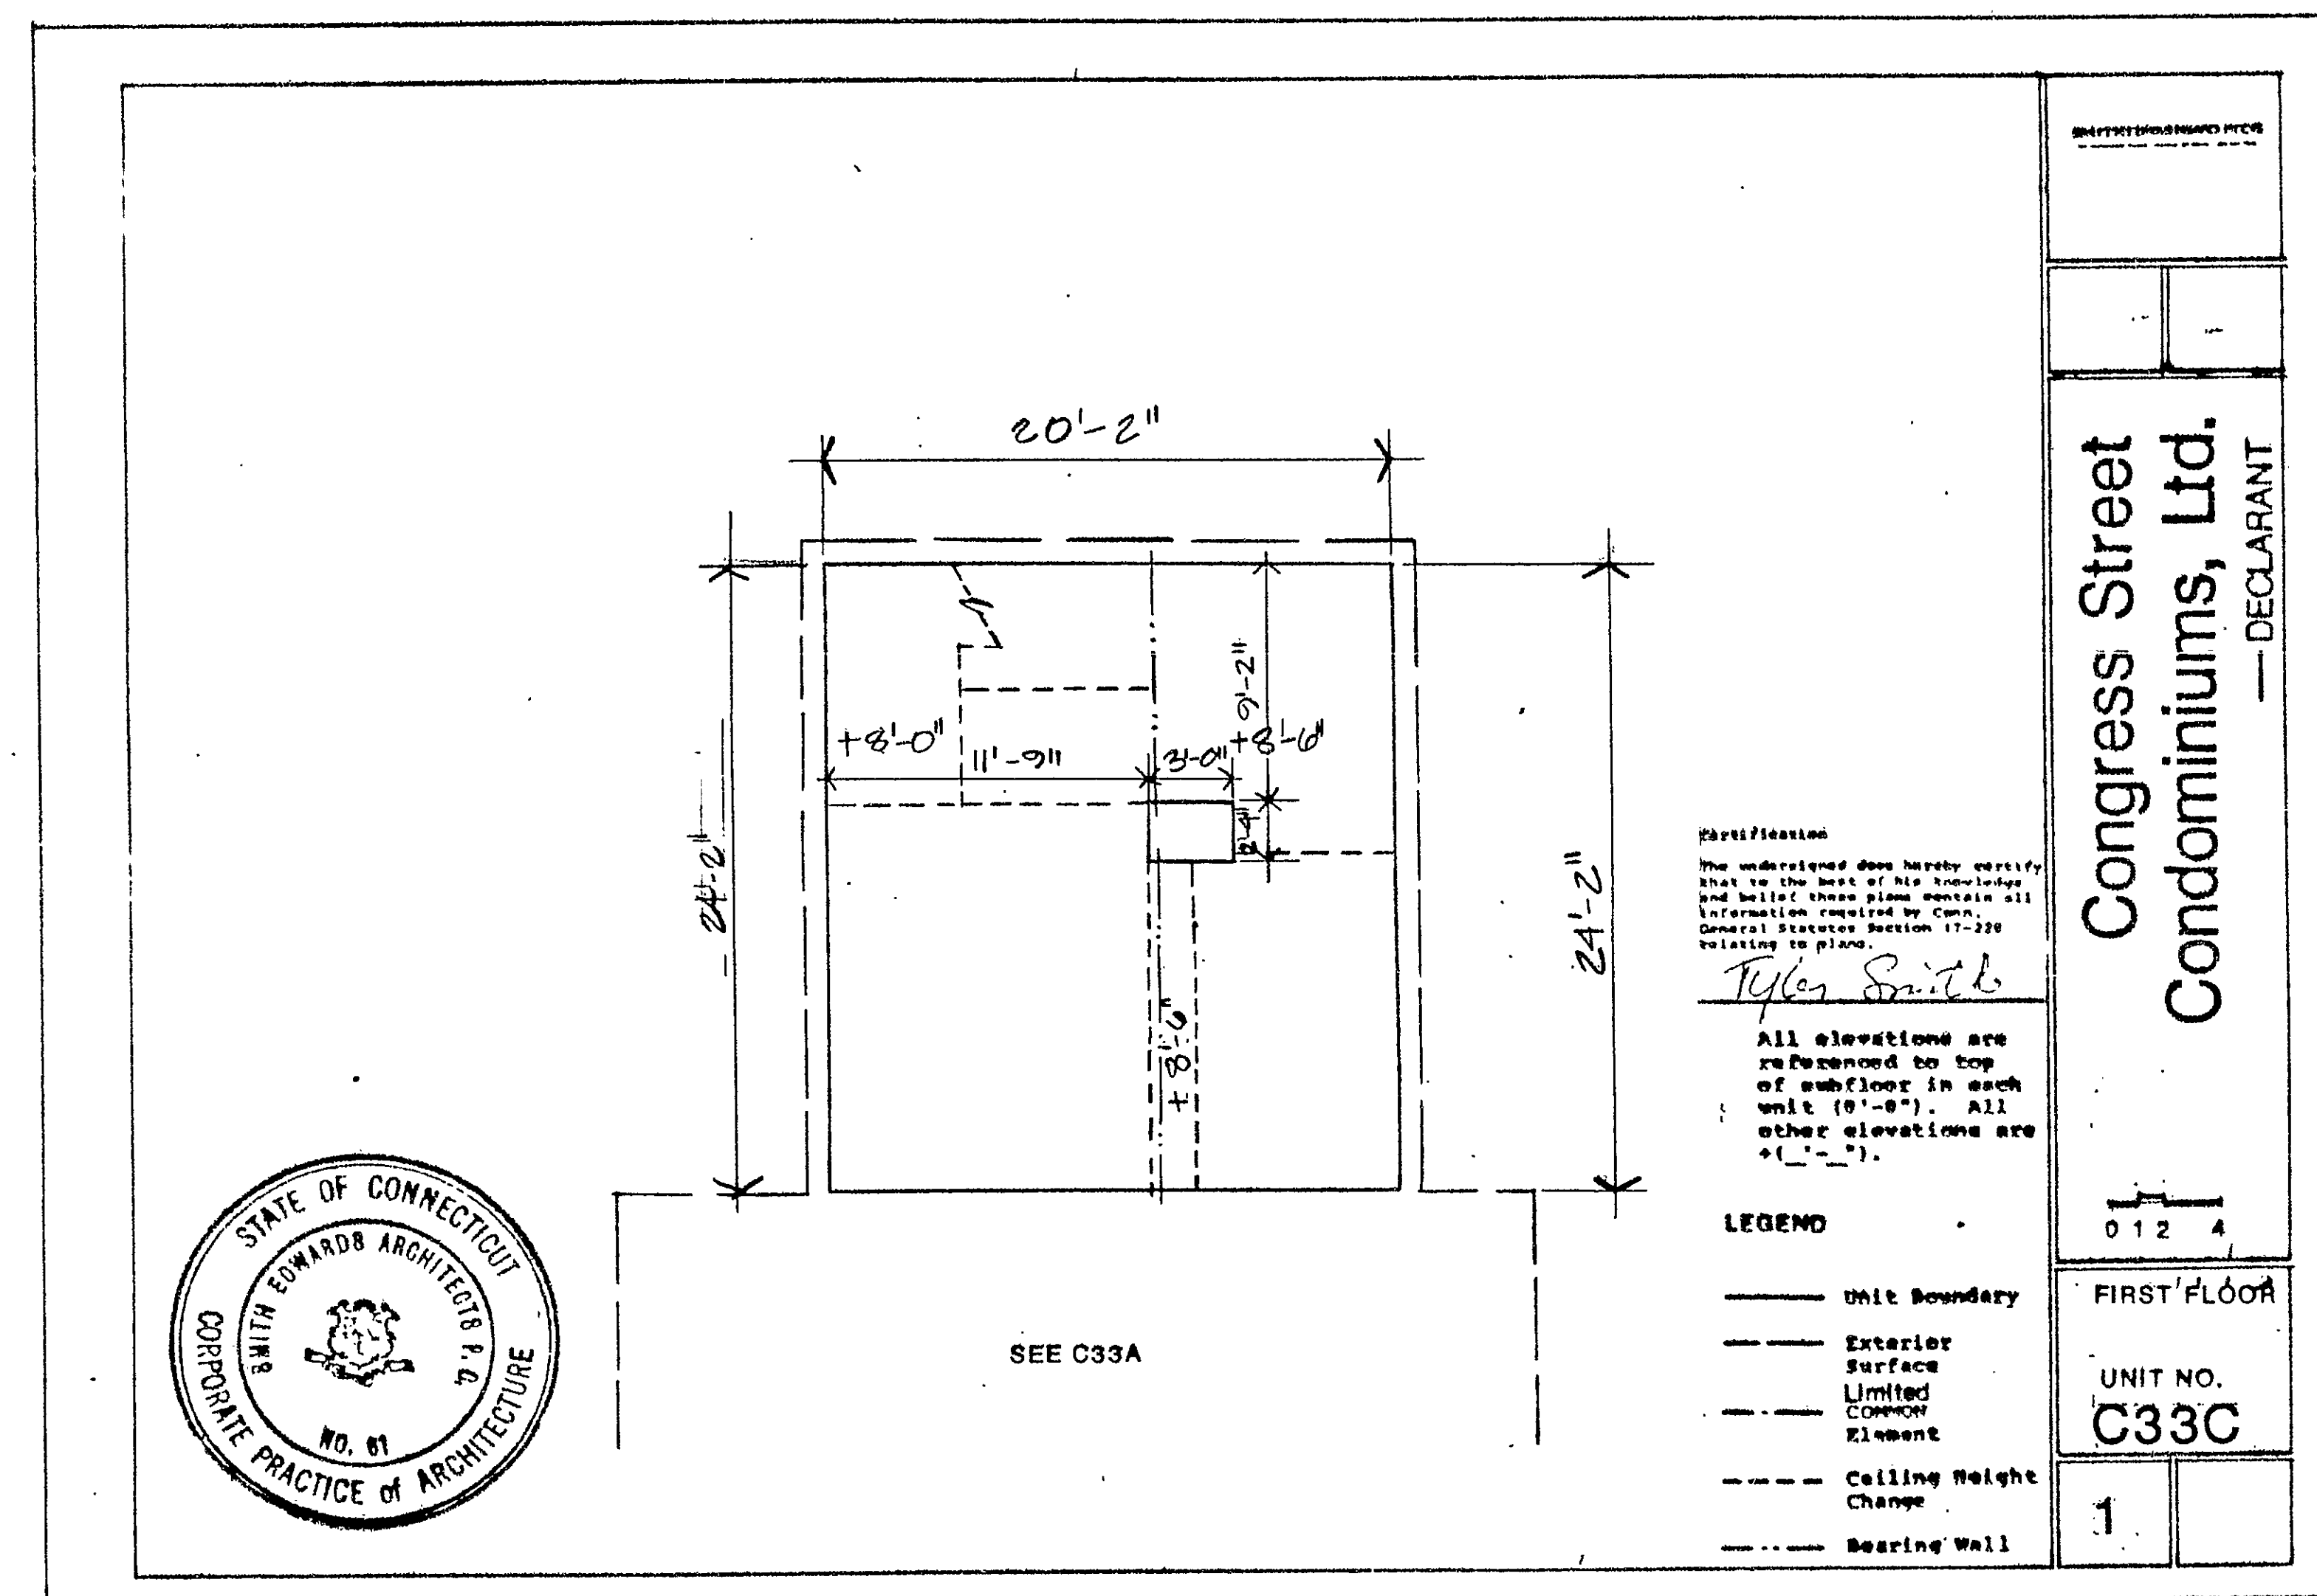

*Condo #88*

