


88

88-8

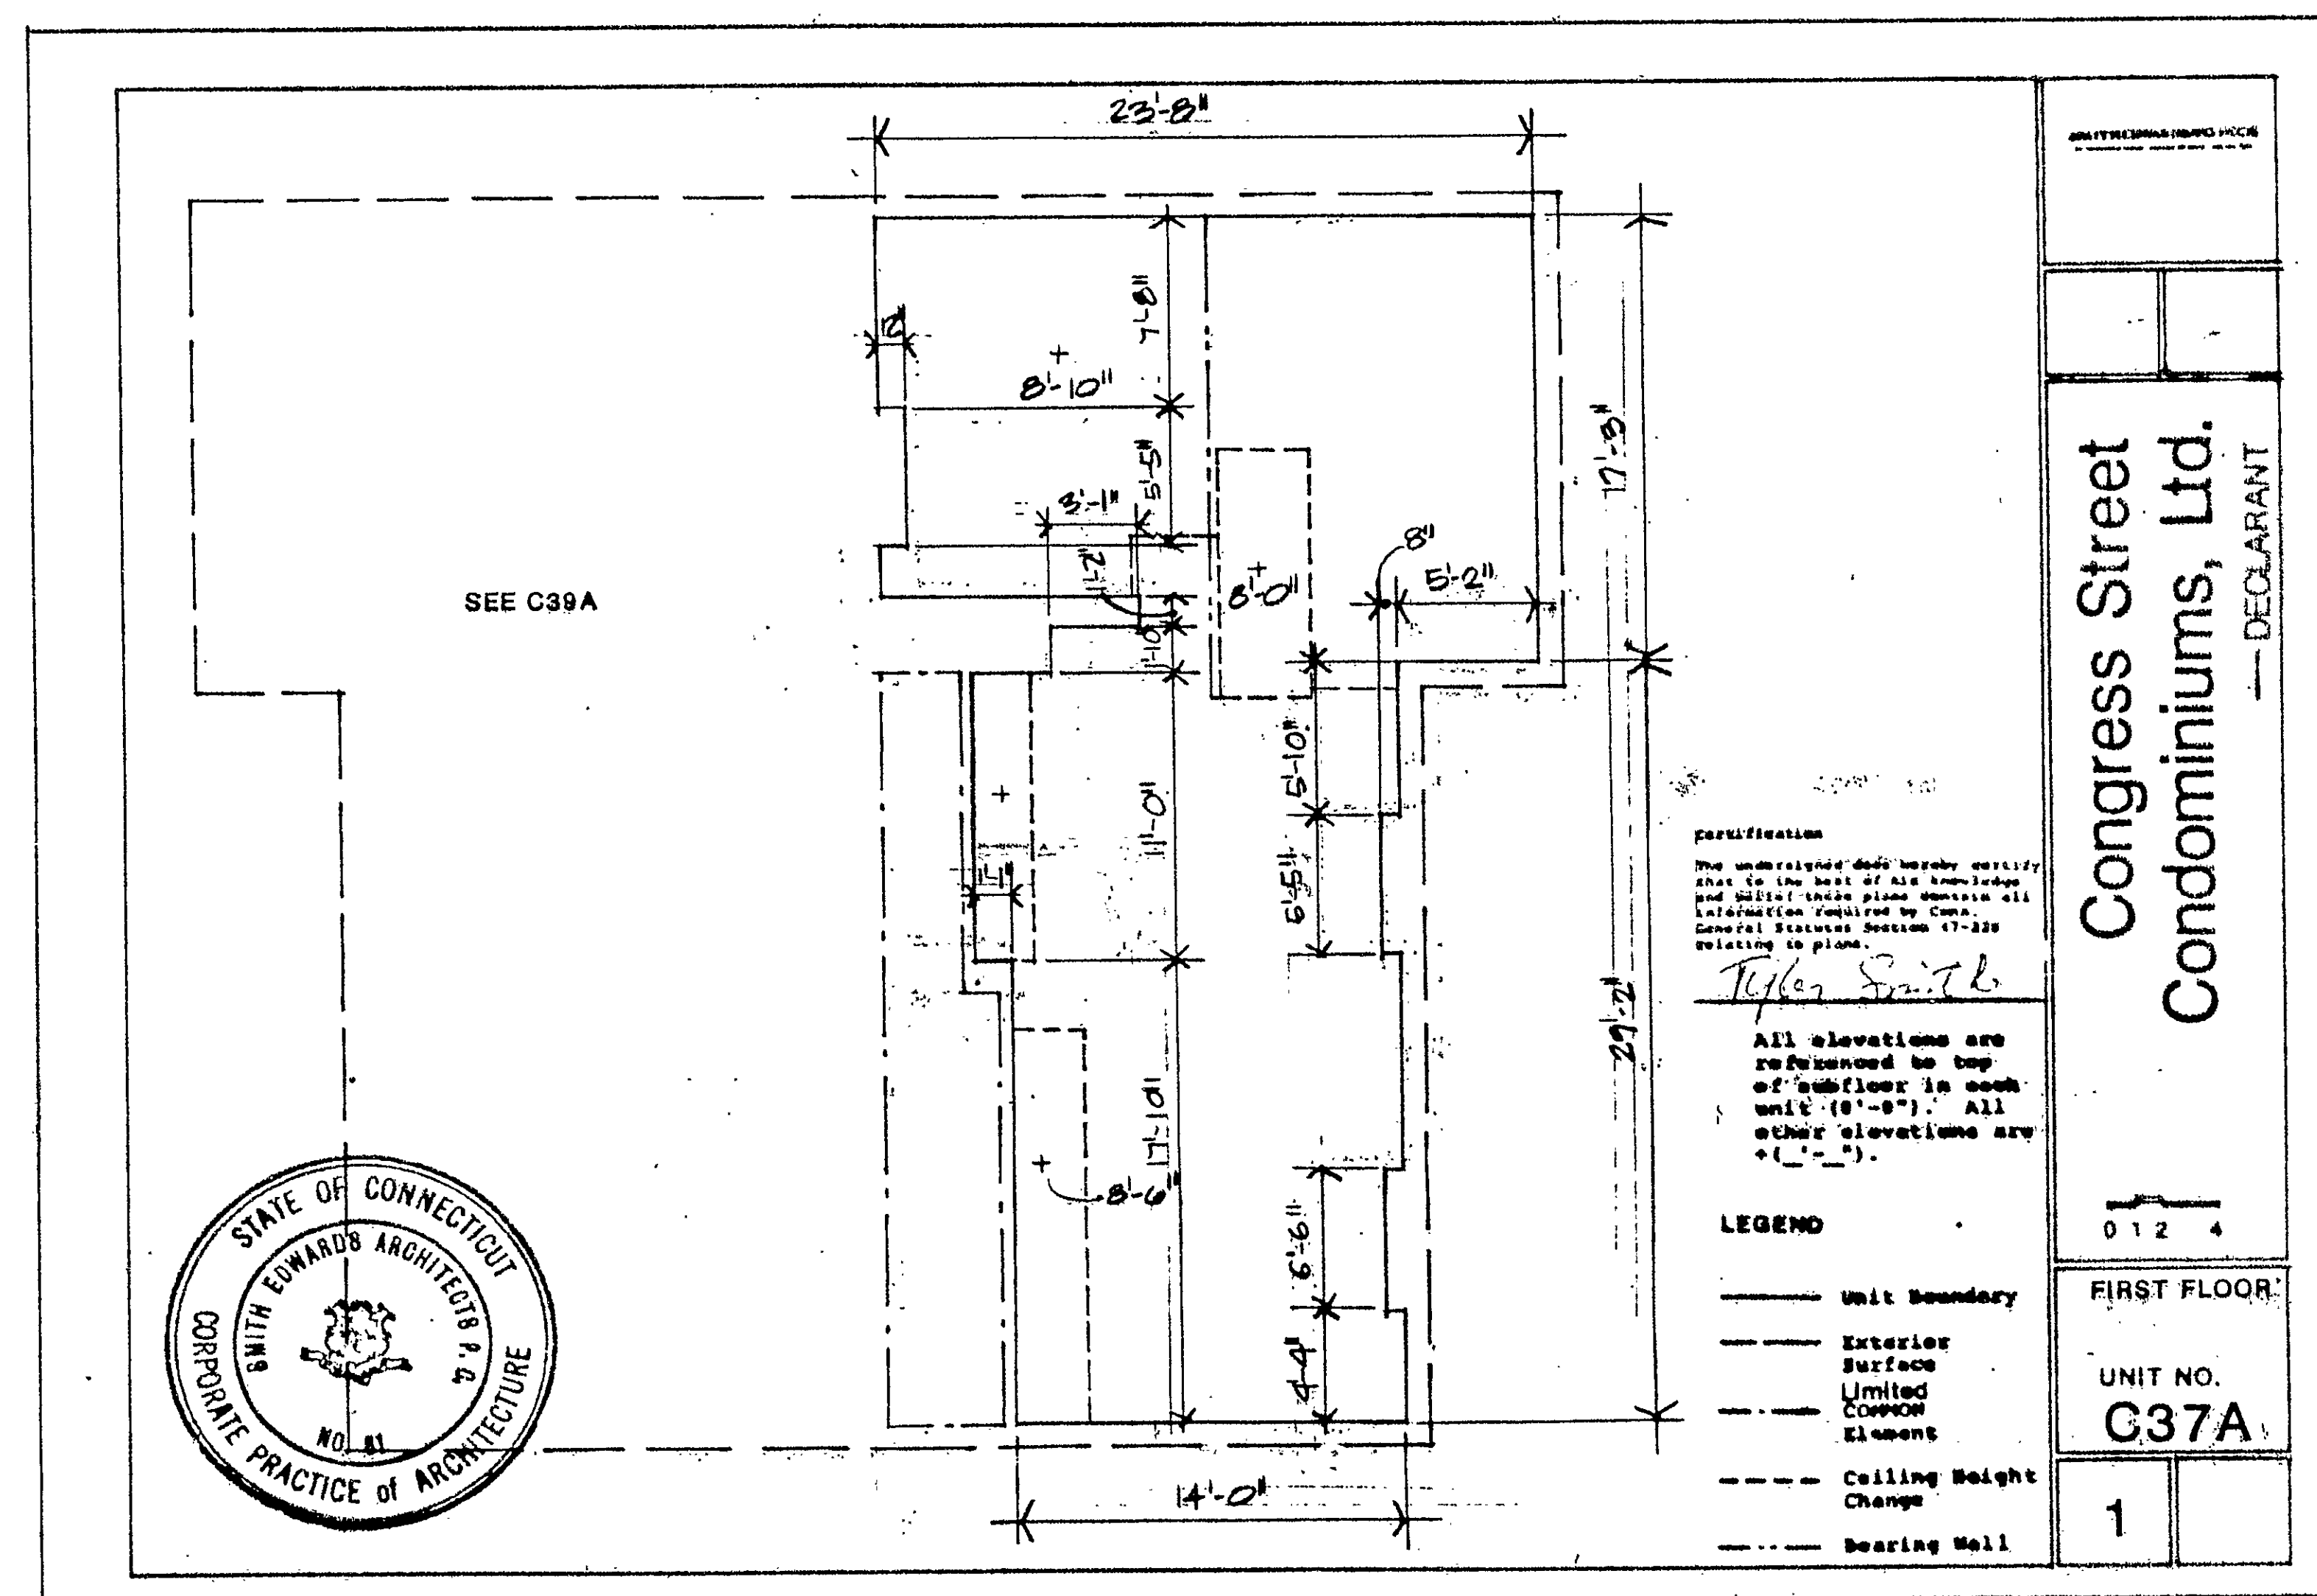

PAGE _____

11-29-67

Condo #88

