


88

88-12

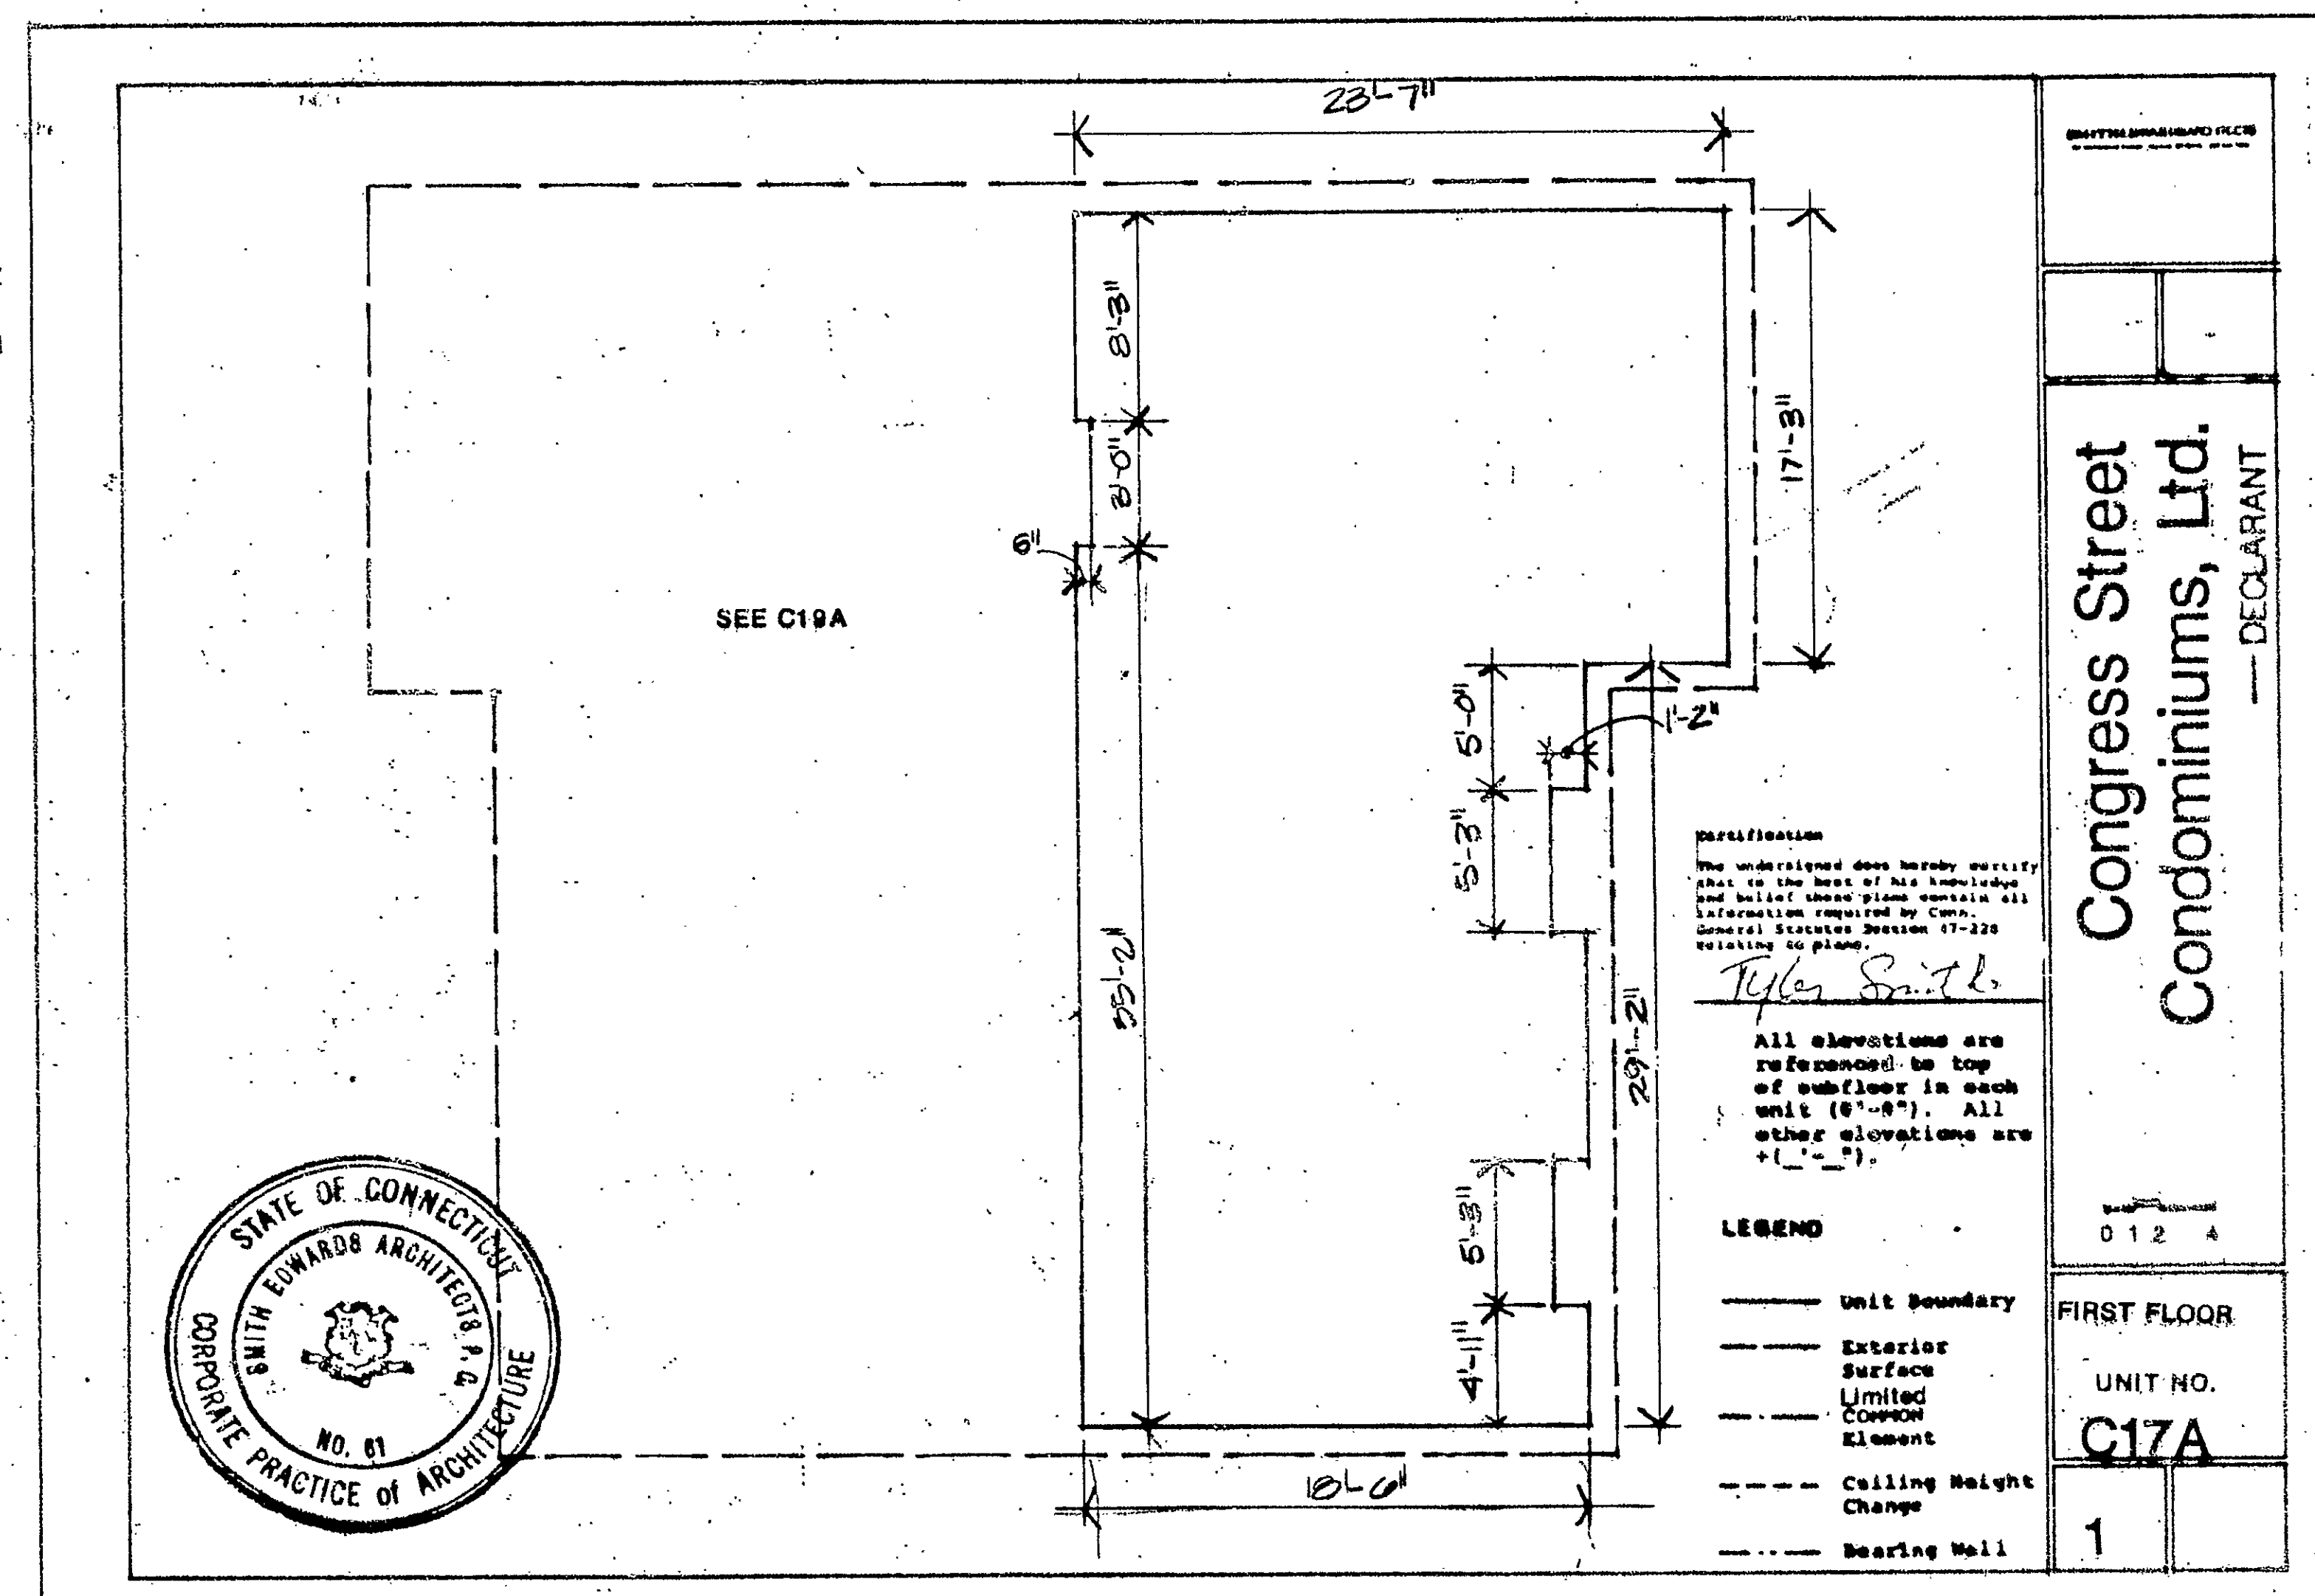

Oct 13 11 16 AM '87
HARTFORD
VOL. _____ PAGE _____

Condo # 88

