




Oct 13 11 16 AM '07
 TOWN ENGINEER
 HARTFORD

Condo #88

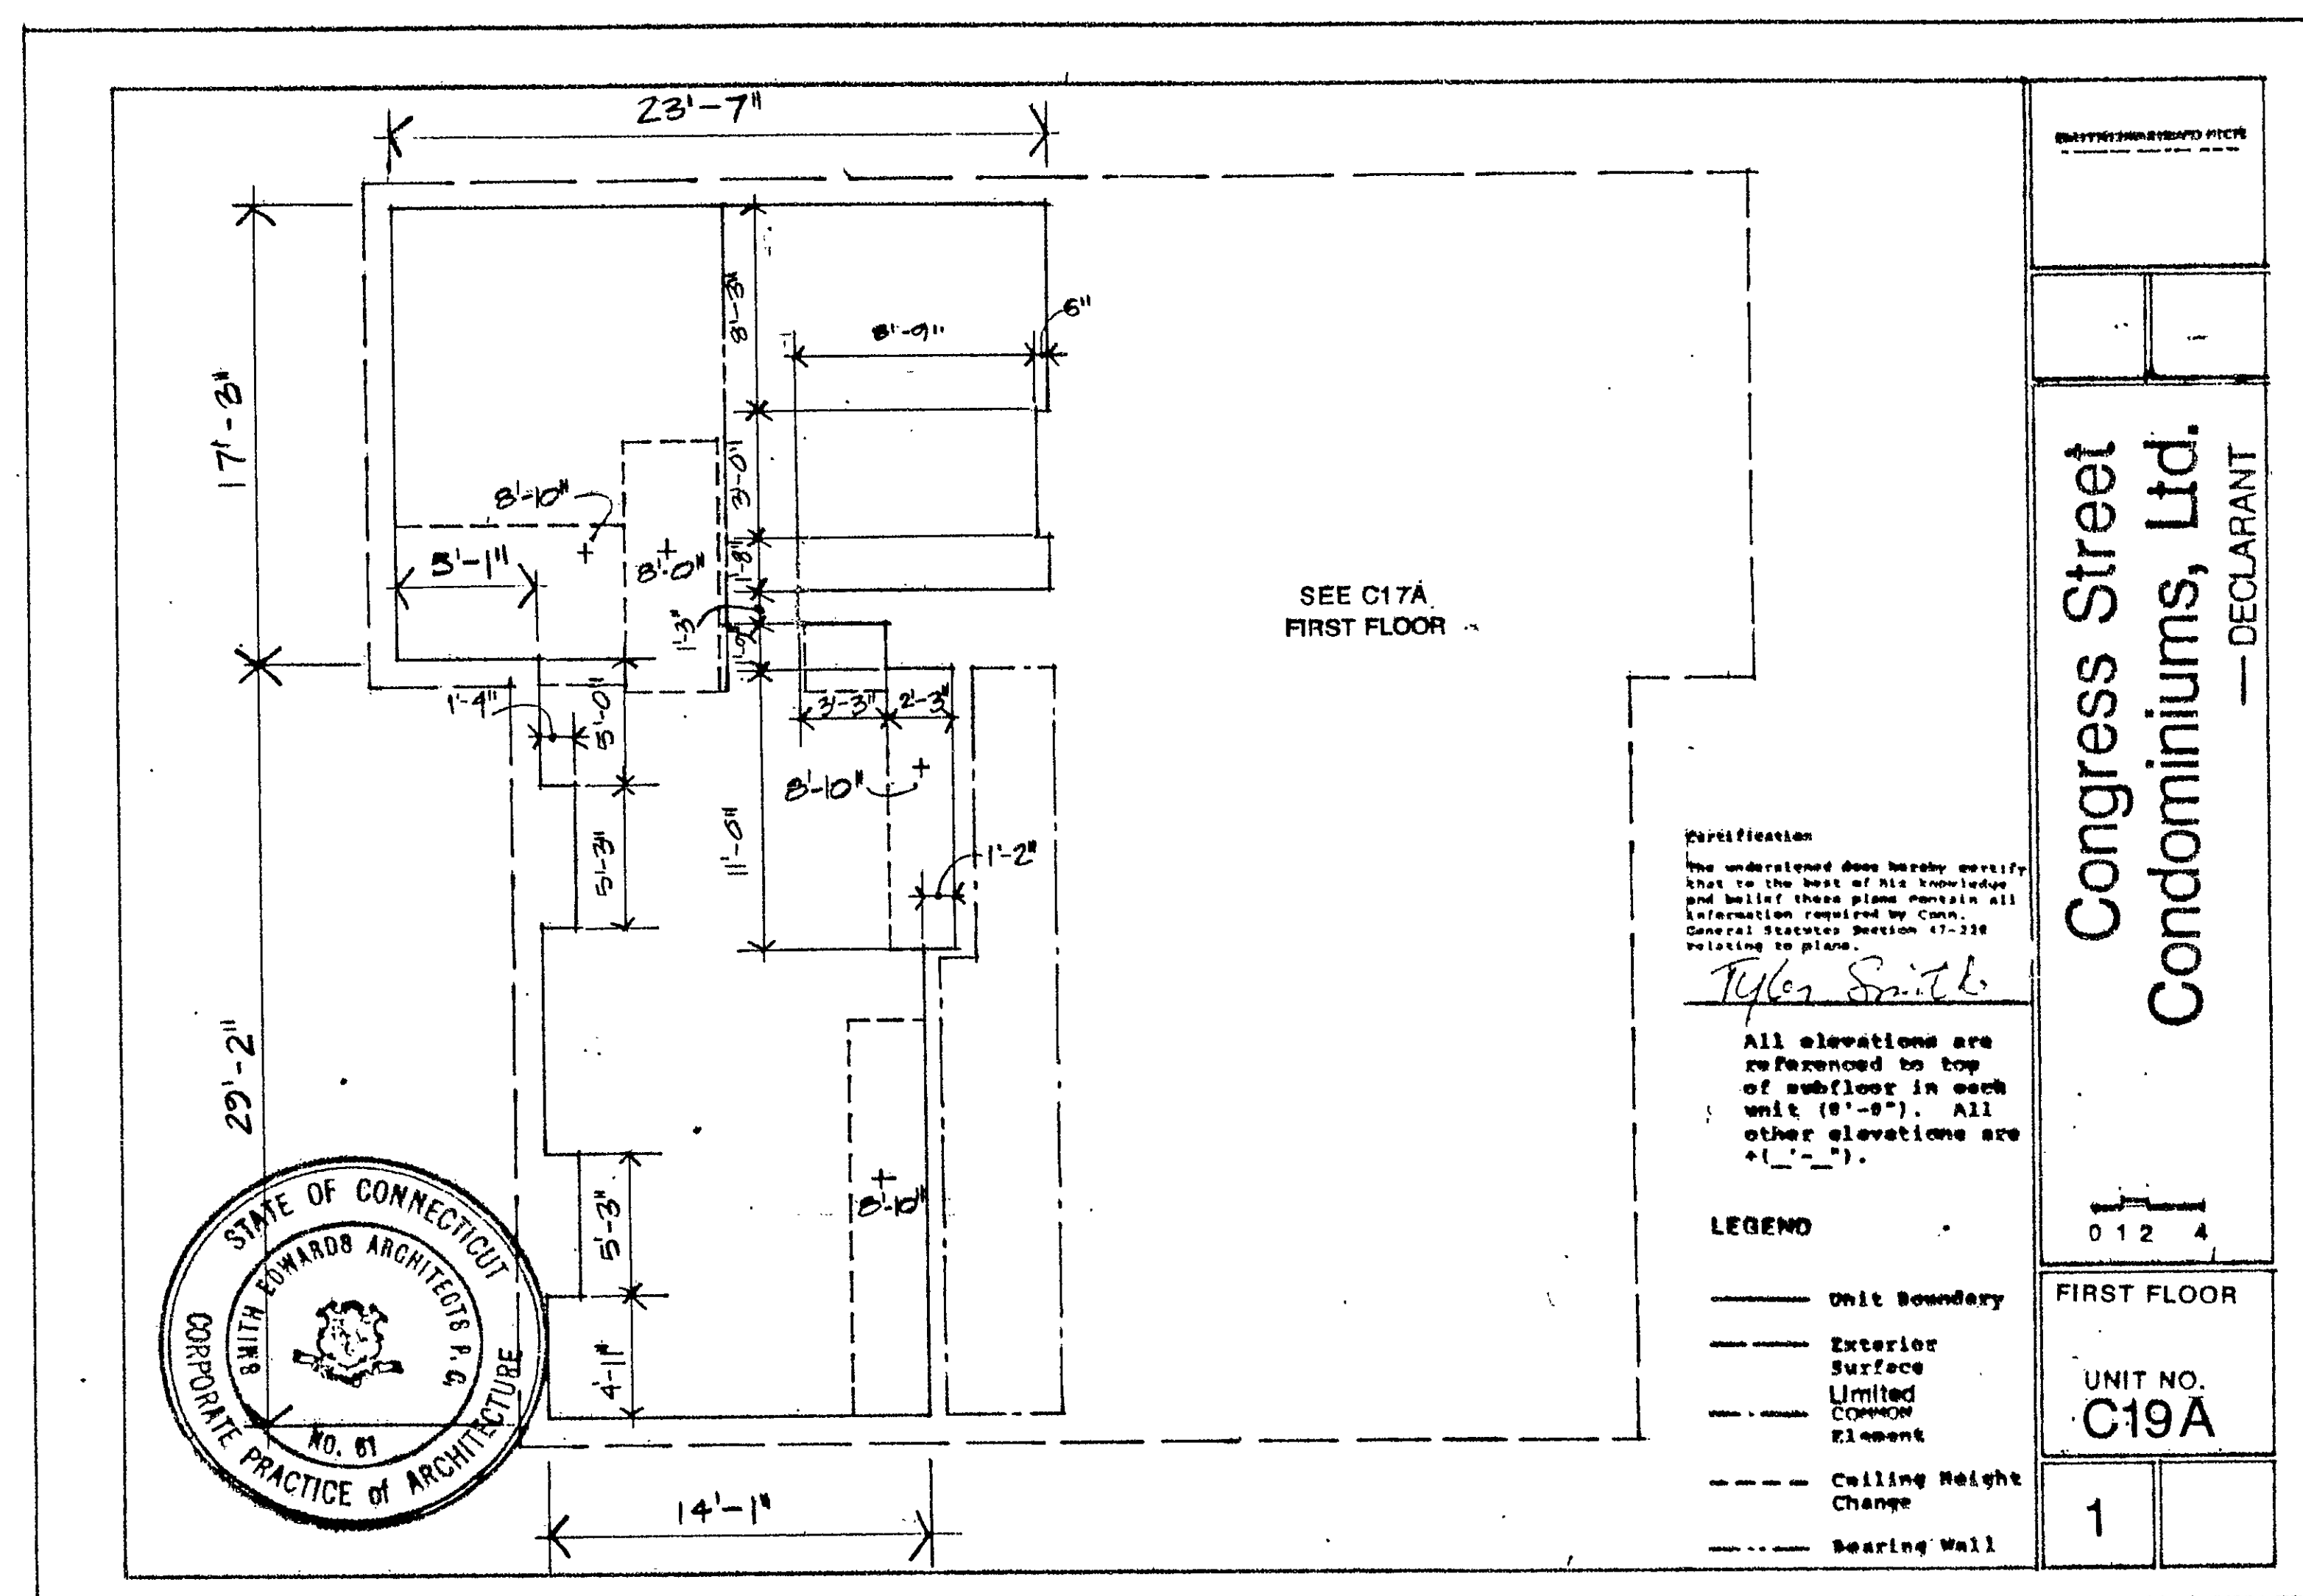