


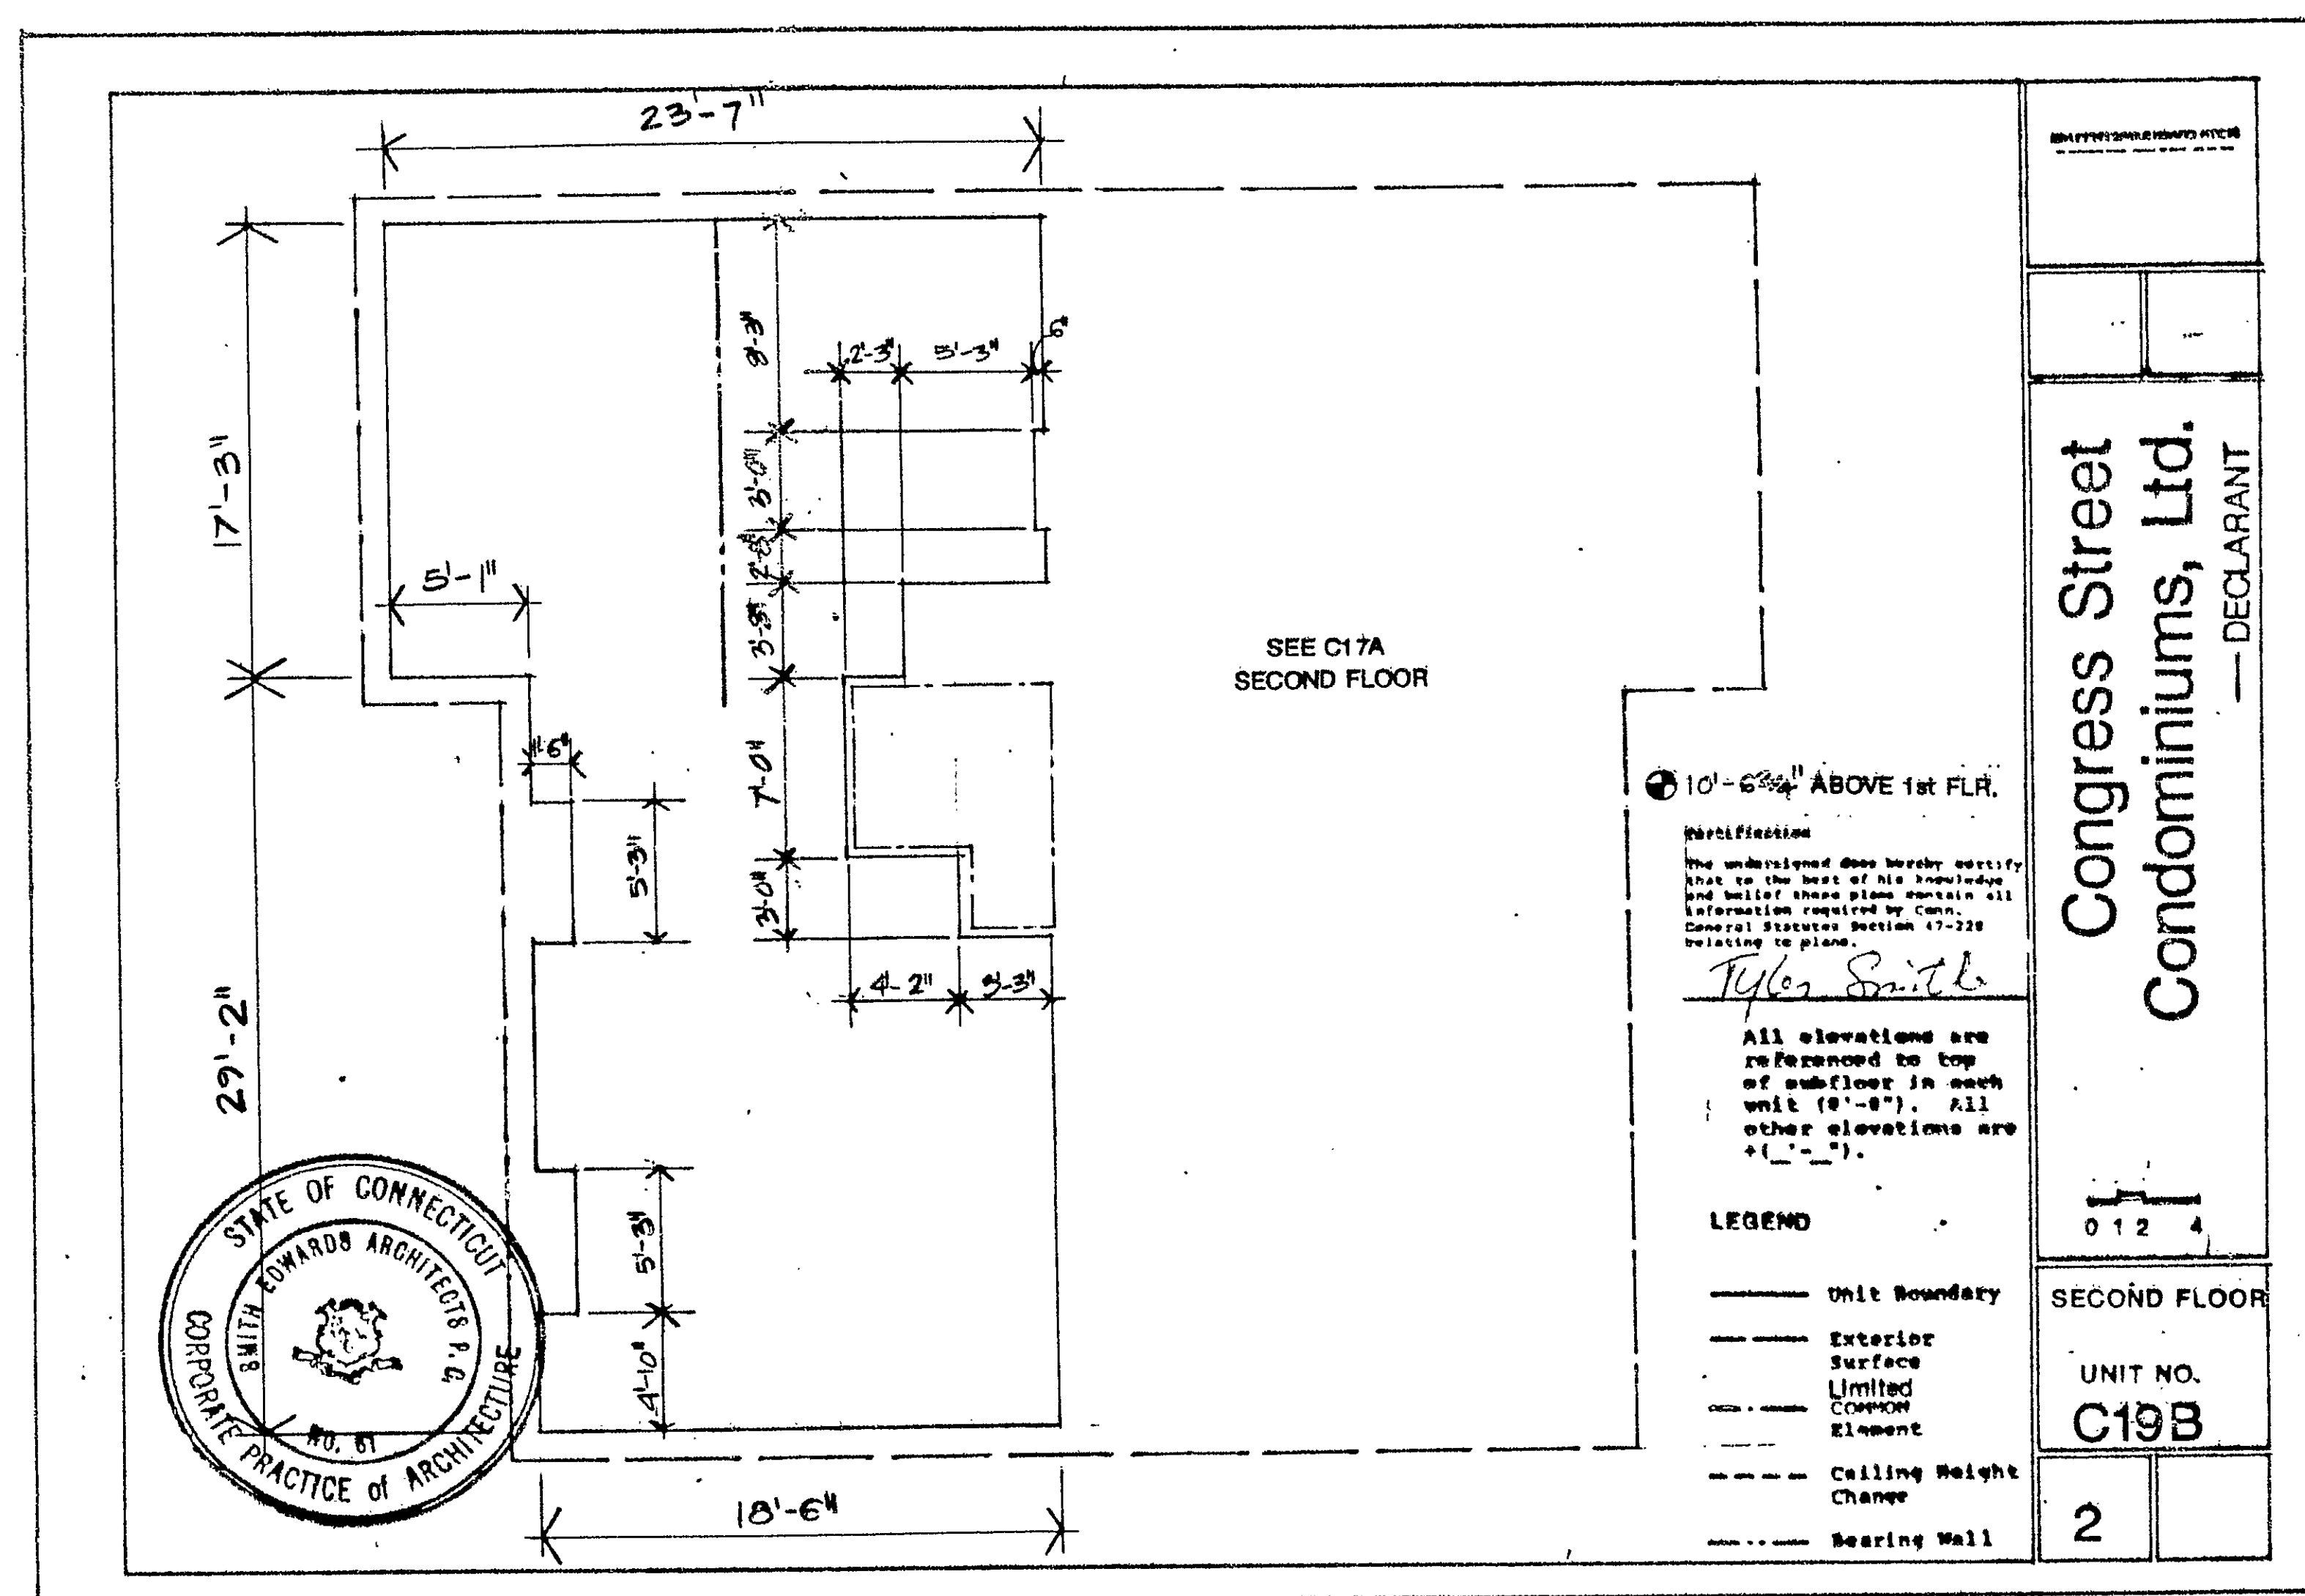

VOL. _____ PAGE _____

Oct 13 11 16 AM '87


RECORDS

Condo #88

