


EASI FILE CORP. IRVINE, CA		BPM 74	
88			

88-18

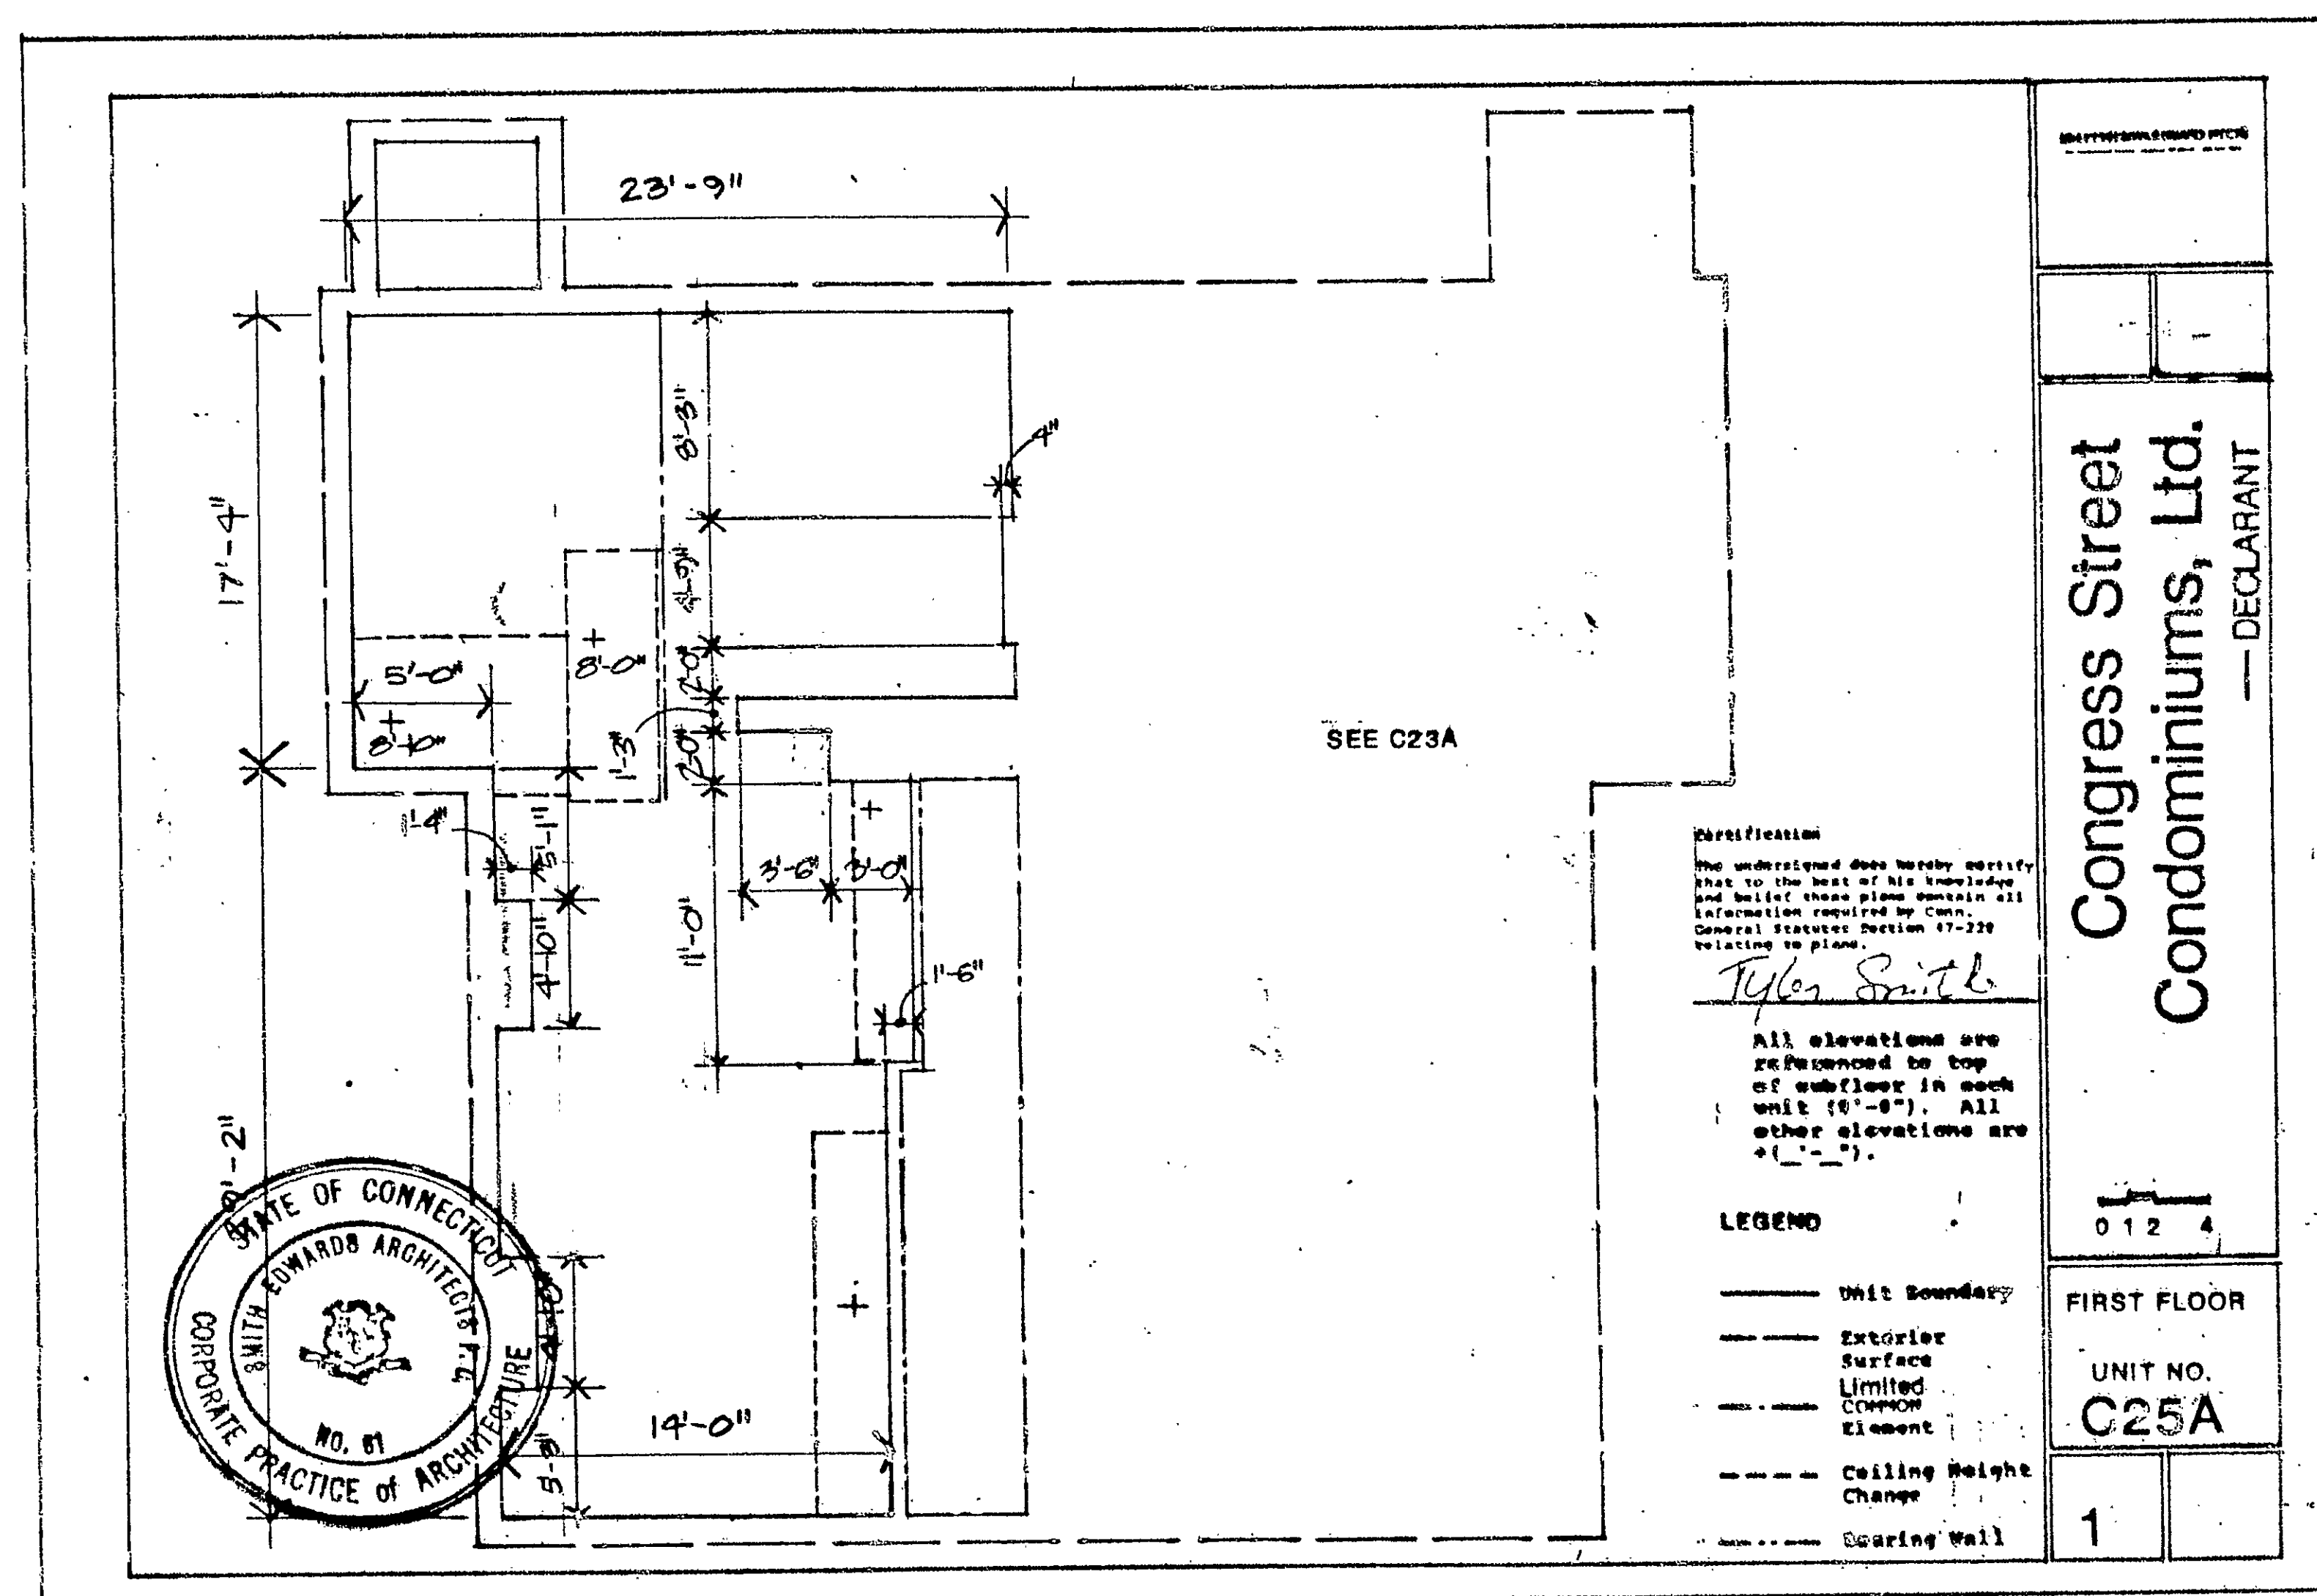

Oct 13 11 17 AM '87
TECH. & ARCH. DIV.
HARTFORD

Condo #88

