


Des. 10 10 91 AM '91

APT. 101
1050 S.F.

APT. 102
950 S.F.

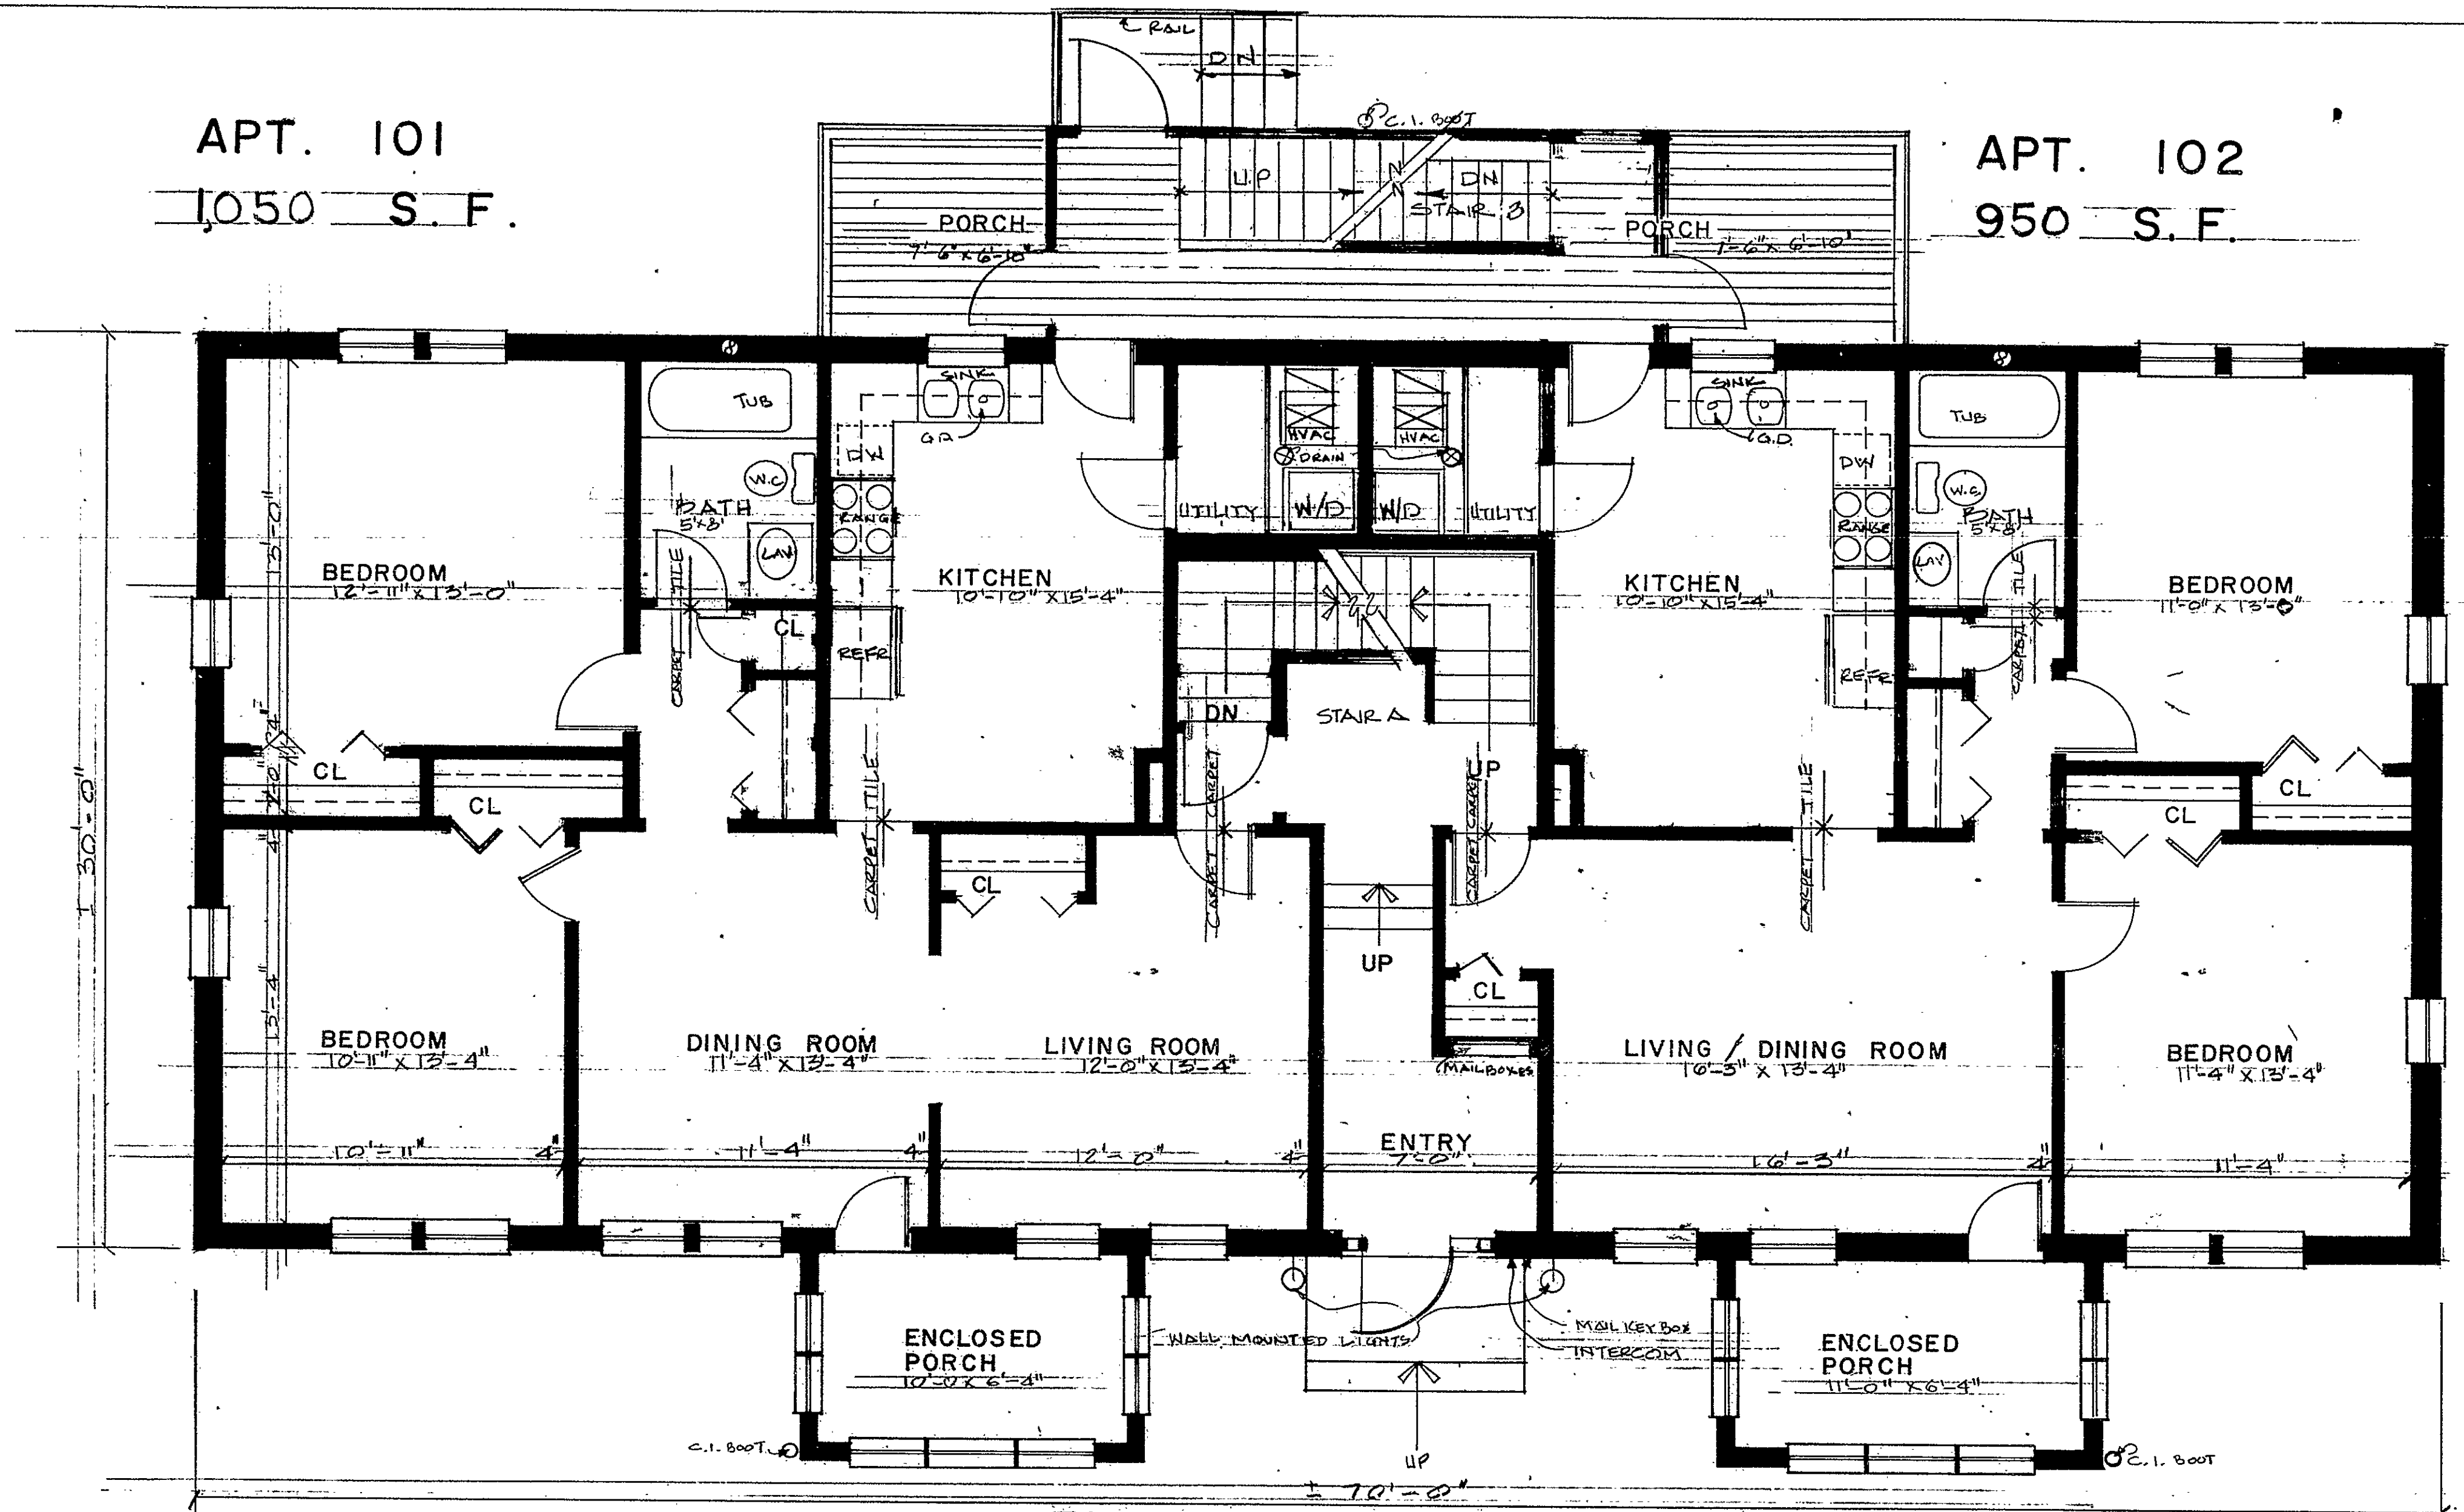

FIRST FLOOR

1/4" = 1' - 0"

CLEVELAND AVENUE CONDOS

89

Condo 89

