



90	EPH 24

90-36

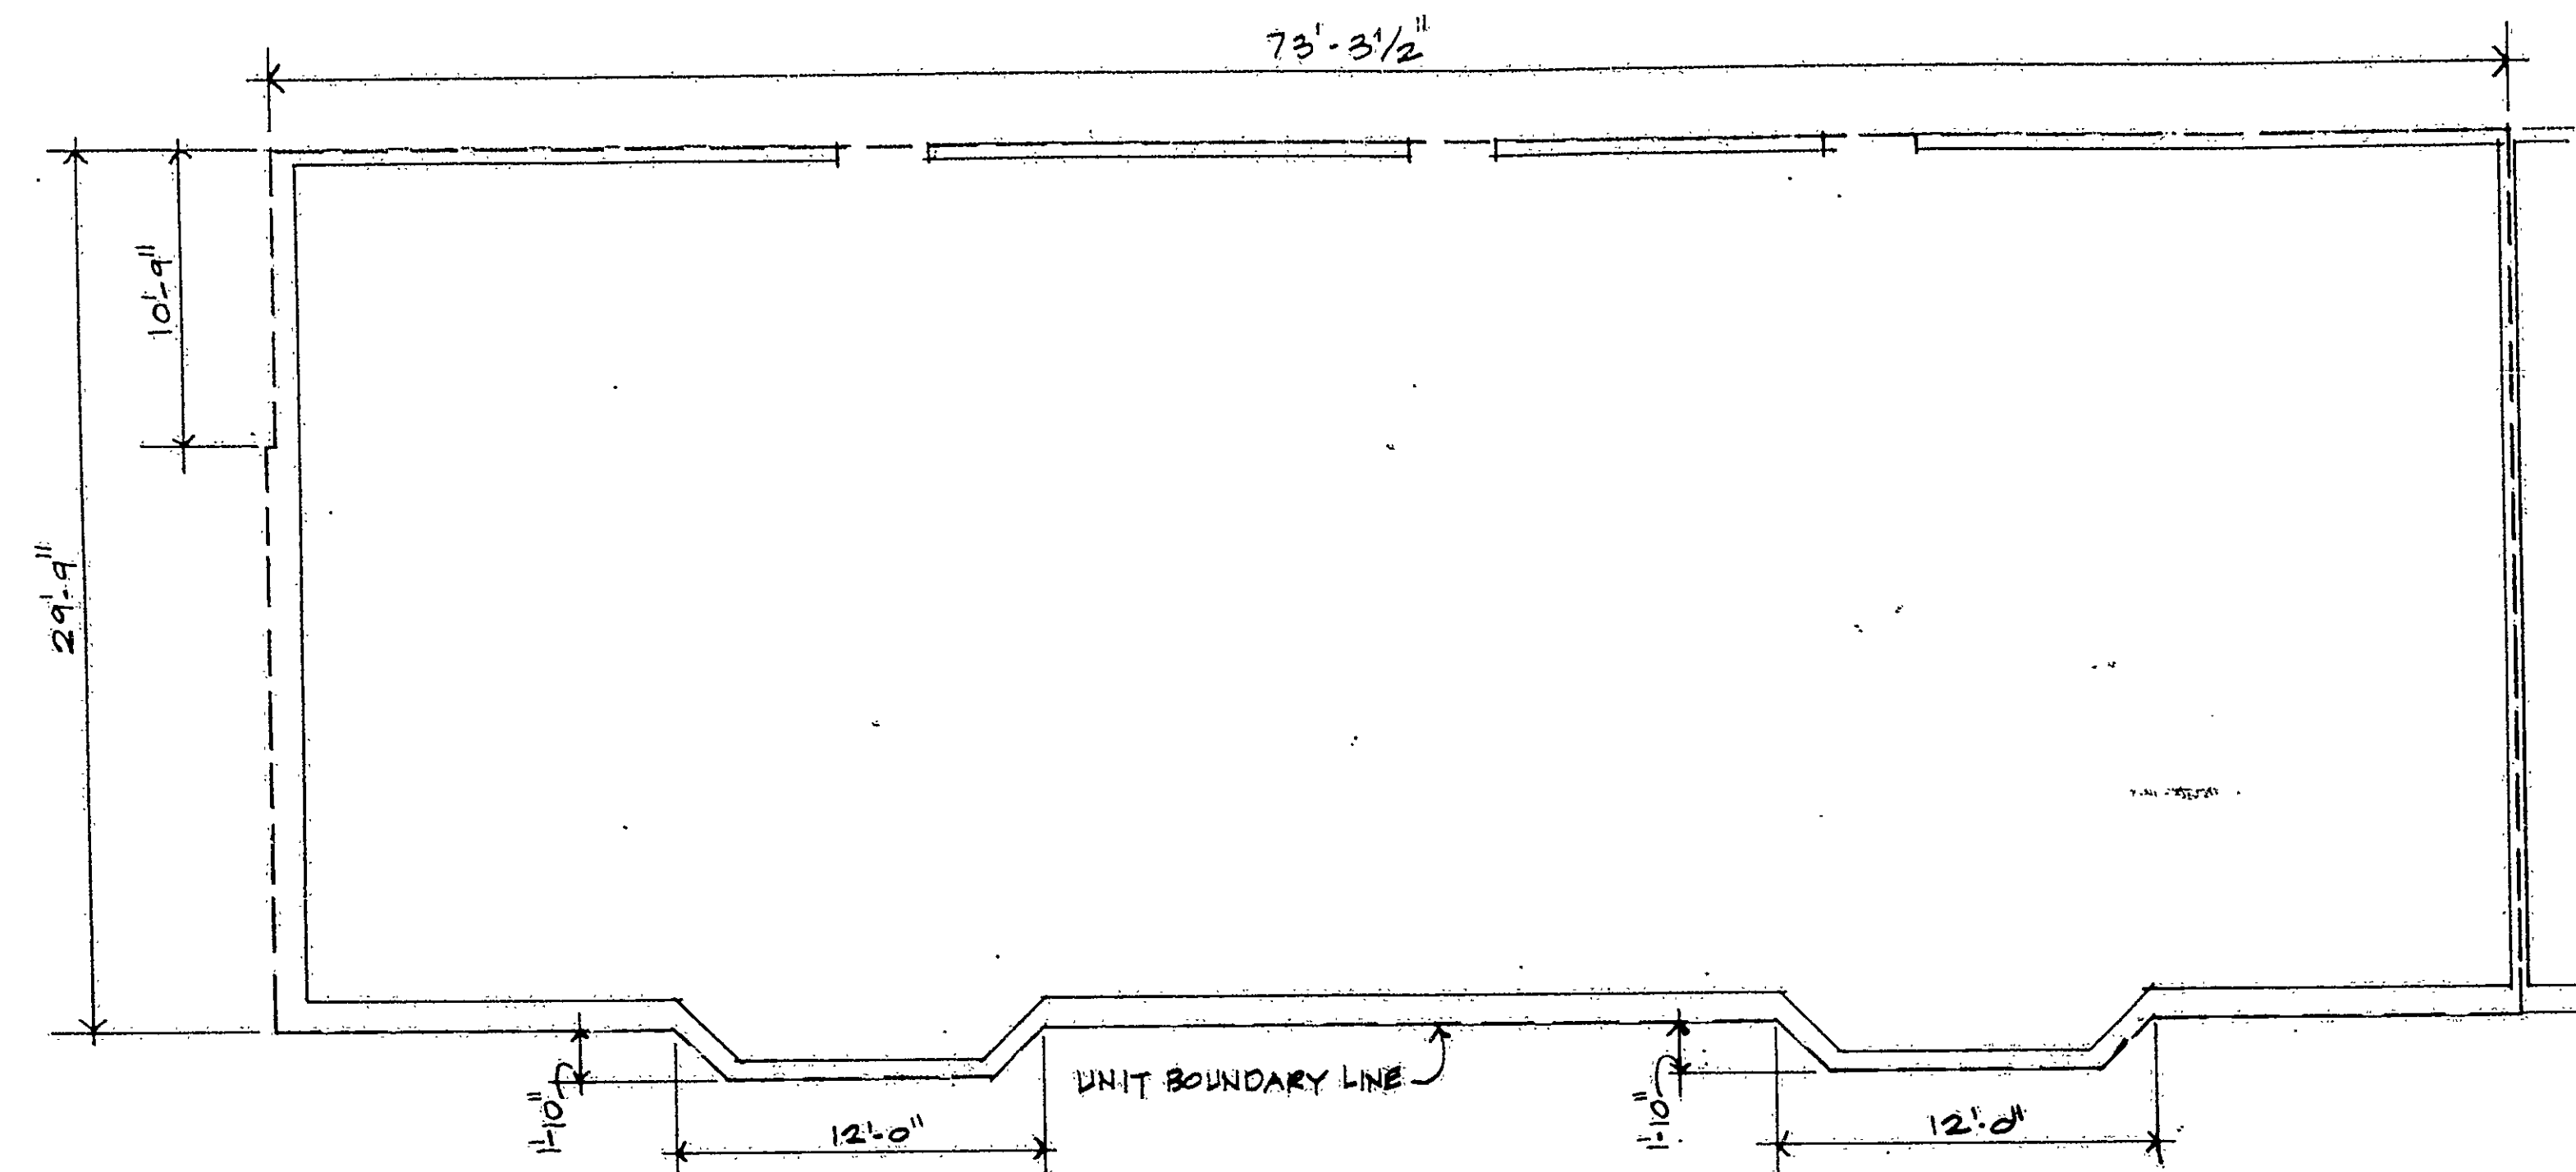

FLOOR PLAN - UNIT 21
 SQUARE FEET = 2205
 FLOOR ELEVATION - 69.92 FEET
 CEILING ELEVATION - 79.50 FEET
 ELEVATION BASED ON M.D.C. DATUM

RECEIVED
 MAY 13 11 54 AM '88
 TOWN ENGINEER
 HARTFORD, CT
 VOL. _____ PAGE _____

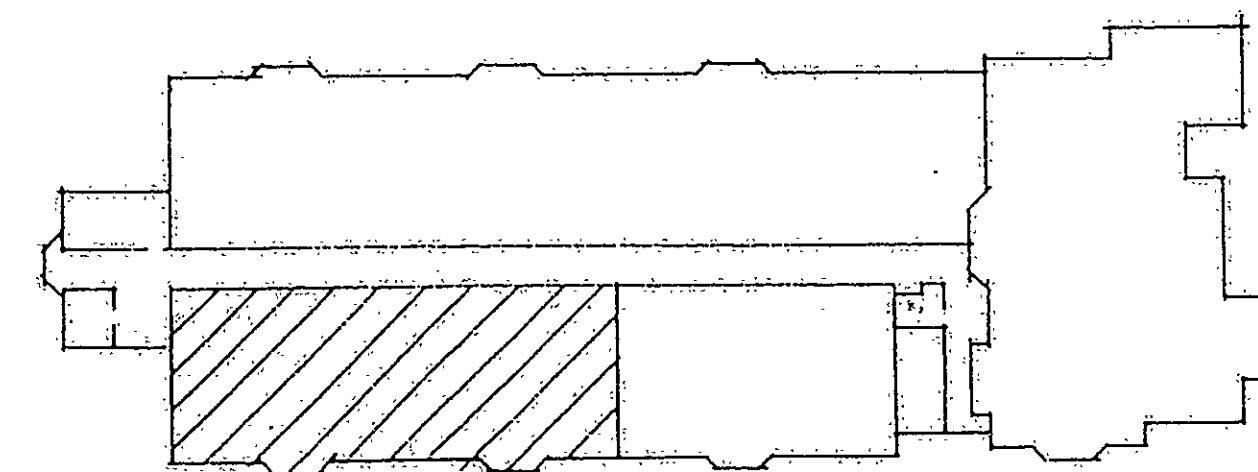

KEY PLAN - 2ND FLOOR

Certification:

"I certify that these plans contain all the information required by Section 47-228 of the Connecticut General Statutes relating to plans."



James E. Vance, Jr. 2934

James E. Vance, Jr. R.A. License No.

The word 'certify' is an expression of professional opinion which is based on the architect's best knowledge, information and belief, and as such it constitutes neither a guarantee or warranty, expressed or implied.

Exhibit A-4

Declaration of Woodland Medical Center by Woodland Street Associates, Inc., Hartford, Connecticut.

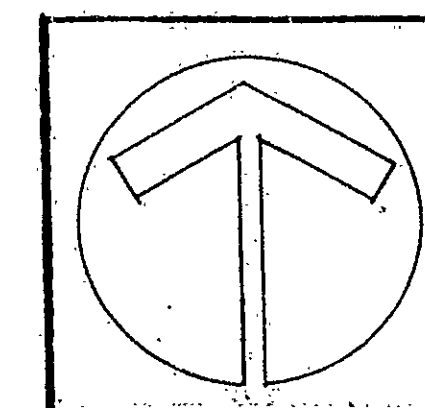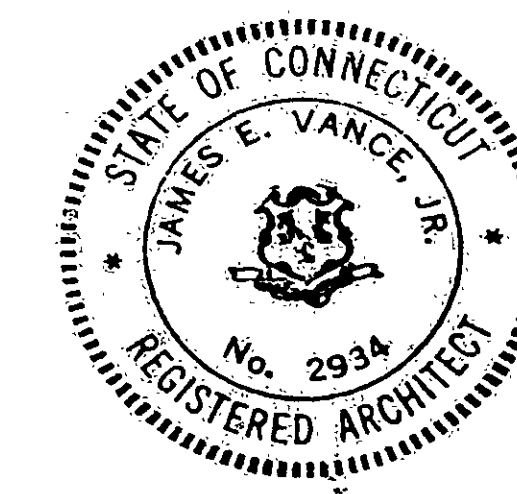

DATE: 5-9-88
 SCALE: 1/8" = 1'-0"

UNIT 21
WOODLAND MEDICAL CENTER

James E. Vance and Associates Architects
 57 Gilett Street
 Hartford, Connecticut

A-9

Floor Plan # 90

