

May 9 4 37 PM '85
PAGE

Certification:


"I certify that these plans contain all the information required by Section 47-228 of the Connecticut General Statutes relating to plans."

James E. Vance, Jr. 2934
James E. Vance, Jr. R.A. License No.



The word 'certify' is an expression of professional opinion which is based on the architect's best knowledge, information and belief, and as such it constitutes neither a guarantee or warranty, expressed or implied.

Exhibit A-4

Declaration of Woodland Medical Center by Woodland Street Associates, Inc., Hartford, Connecticut.

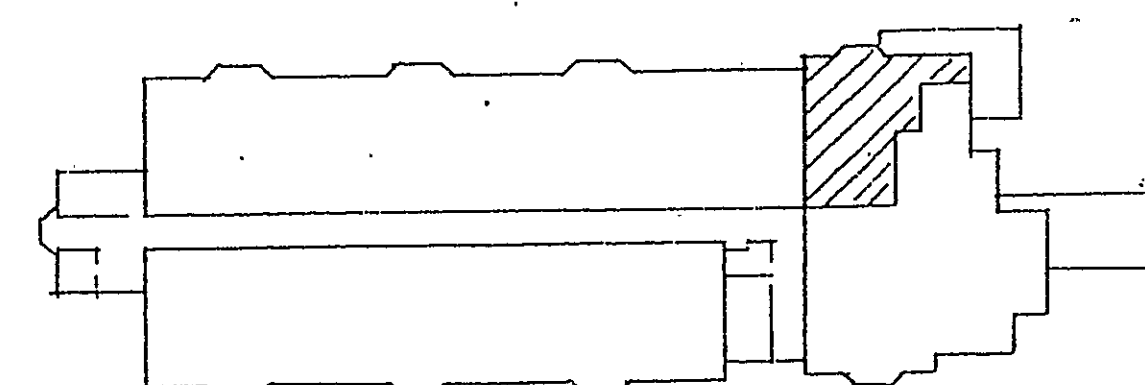

KEY PLAN - 3RD FLOOR

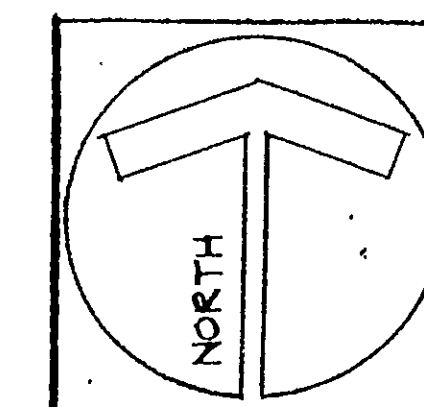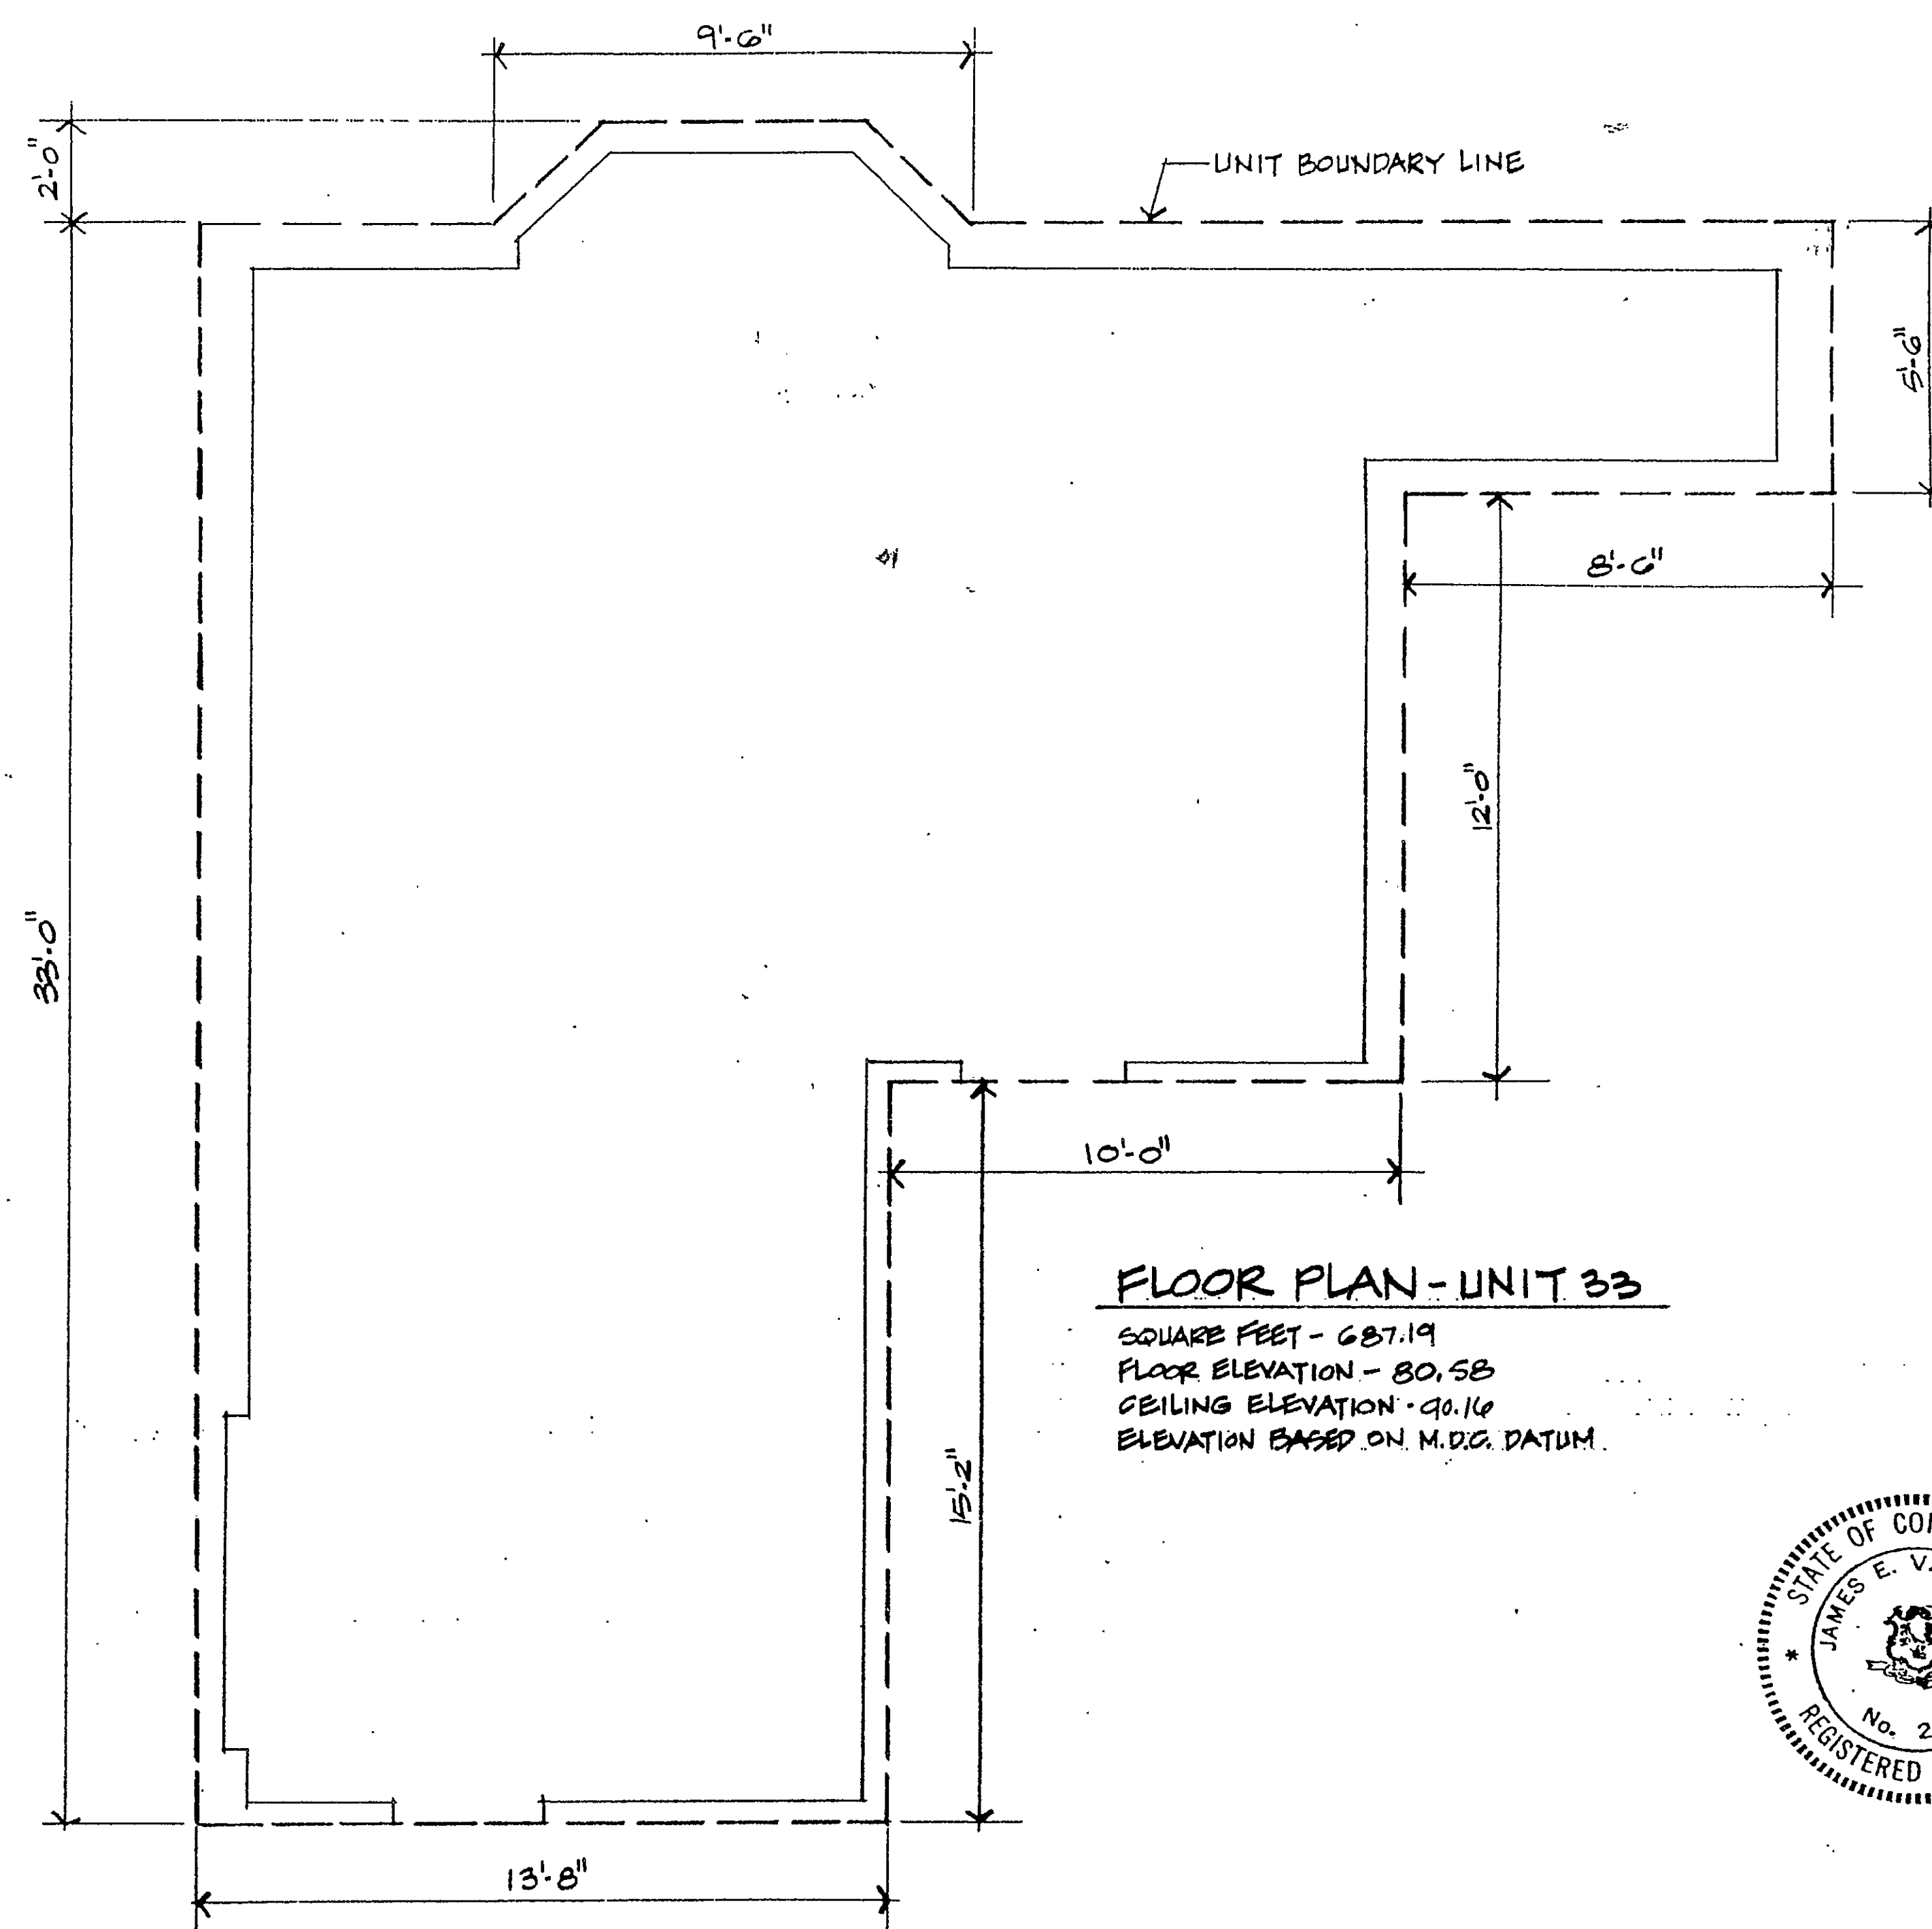


DATE: 11-3-85

SCALE: 1/4" = 1'-0"

UNIT 33
WOODLAND MEDICAL CENTER

Condo # 90

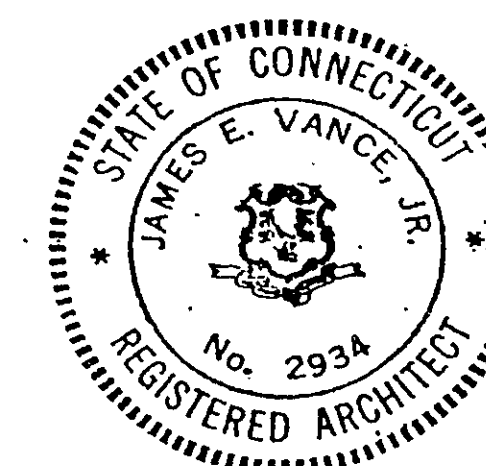

James E. Vance and Associates Architects
57 Gilbert Street
Hartford, Connecticut

A-19

