

EASI FILE CORP. IRVINE, CA	
EPH 34	
90	


90-53

RECEIVED BY
2/1/90

DEC 11 3 37 PM '89


TO

VOL

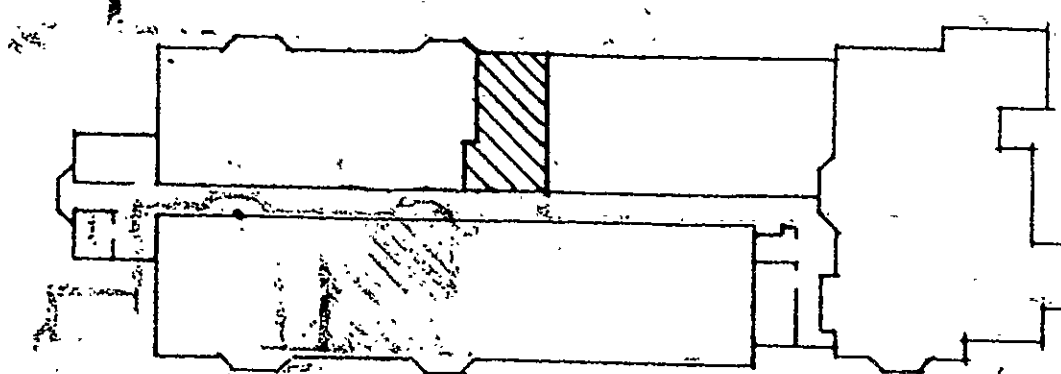

KEY PLAN - 1ST FLOOR

KEY PLAN - 1ST FLOOR

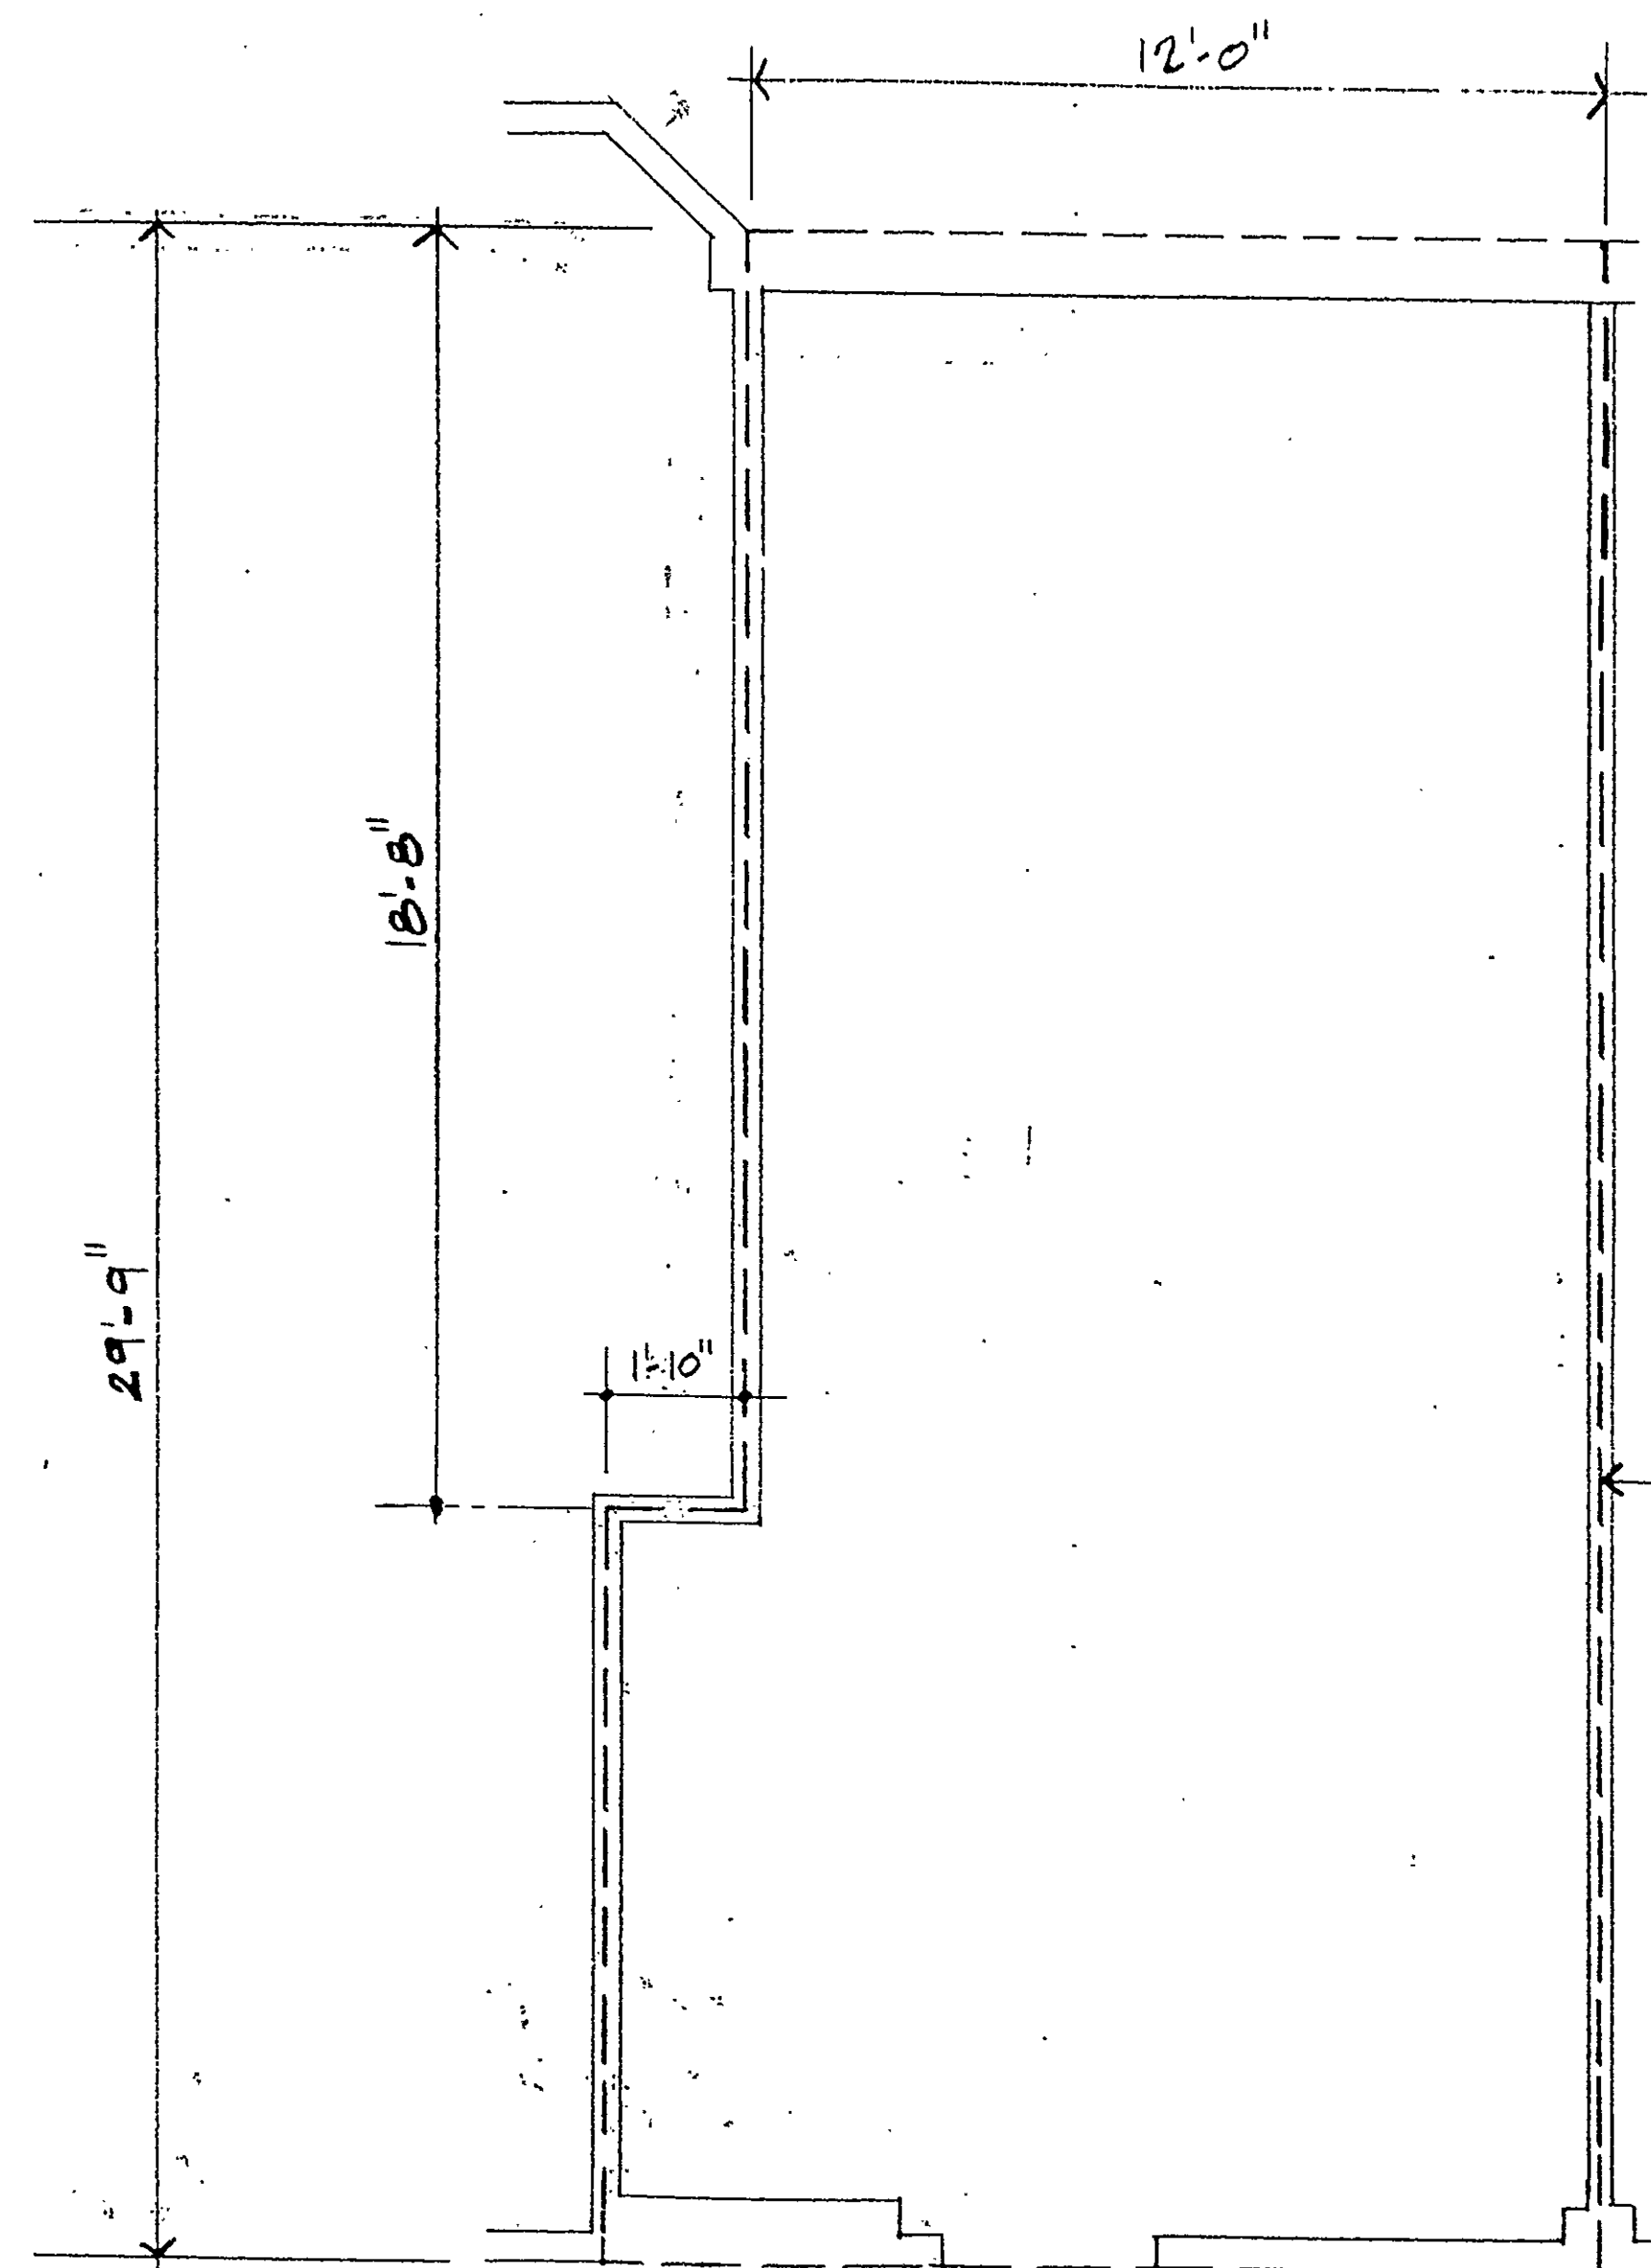

FLOOR PLAN - UNIT 13A

SQUARE FEET = 374.82

FLOOR ELEVATION - 55.26

CEILING ELEVATION - 68.84

ELEVATION BASED ON M.D.C. DATUM

Certification:

"I certify that these plans contain all the information required by Section 47-228 of the Connecticut General Statutes relating to plans."

James E. Vance, Jr. 2934



James E. Vance, Jr.

R.A. License No.

The word 'certify' is an expression of professional opinion which is based on the architect's best knowledge, information and belief, and as such it constitutes neither a guarantee or warranty, expressed or implied.

Exhibit A-4

Declaration of Woodland Medical Center by Woodland Street Associates, Inc., Hartford, Connecticut.

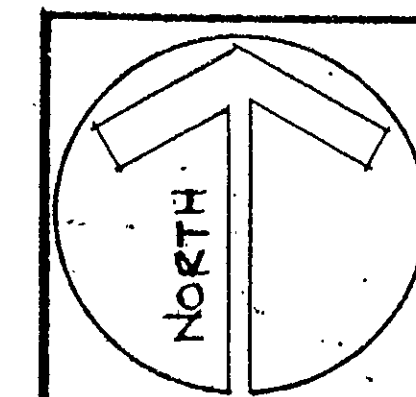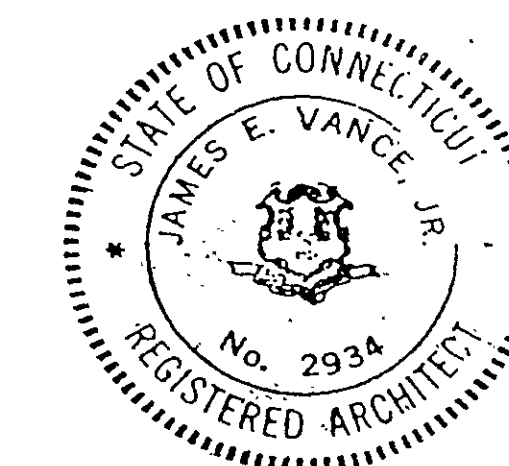

DATE: 12-11-90

SCALE: 1/4" = 1'-0"

UNIT 13A
WOODLAND MEDICAL CENTER

James E. Vance and Associates Architects
57 Gilbert Street
Hartford, Connecticut

UNIT 13A
A26

