



THE BERWICK - A CONDOMINIUM
PLANS PREPARED FOR
K.P. ASSOCIATES
 BY PAUL T. FRANZA, ARCHITECT, P.O. BOX 122 MANCHESTER, CT. 06040
PROPERTY KNOWN AS 18 CONGRESS STREET
HARTFORD, CONNECTICUT
 SEPTEMBER 16, 1988

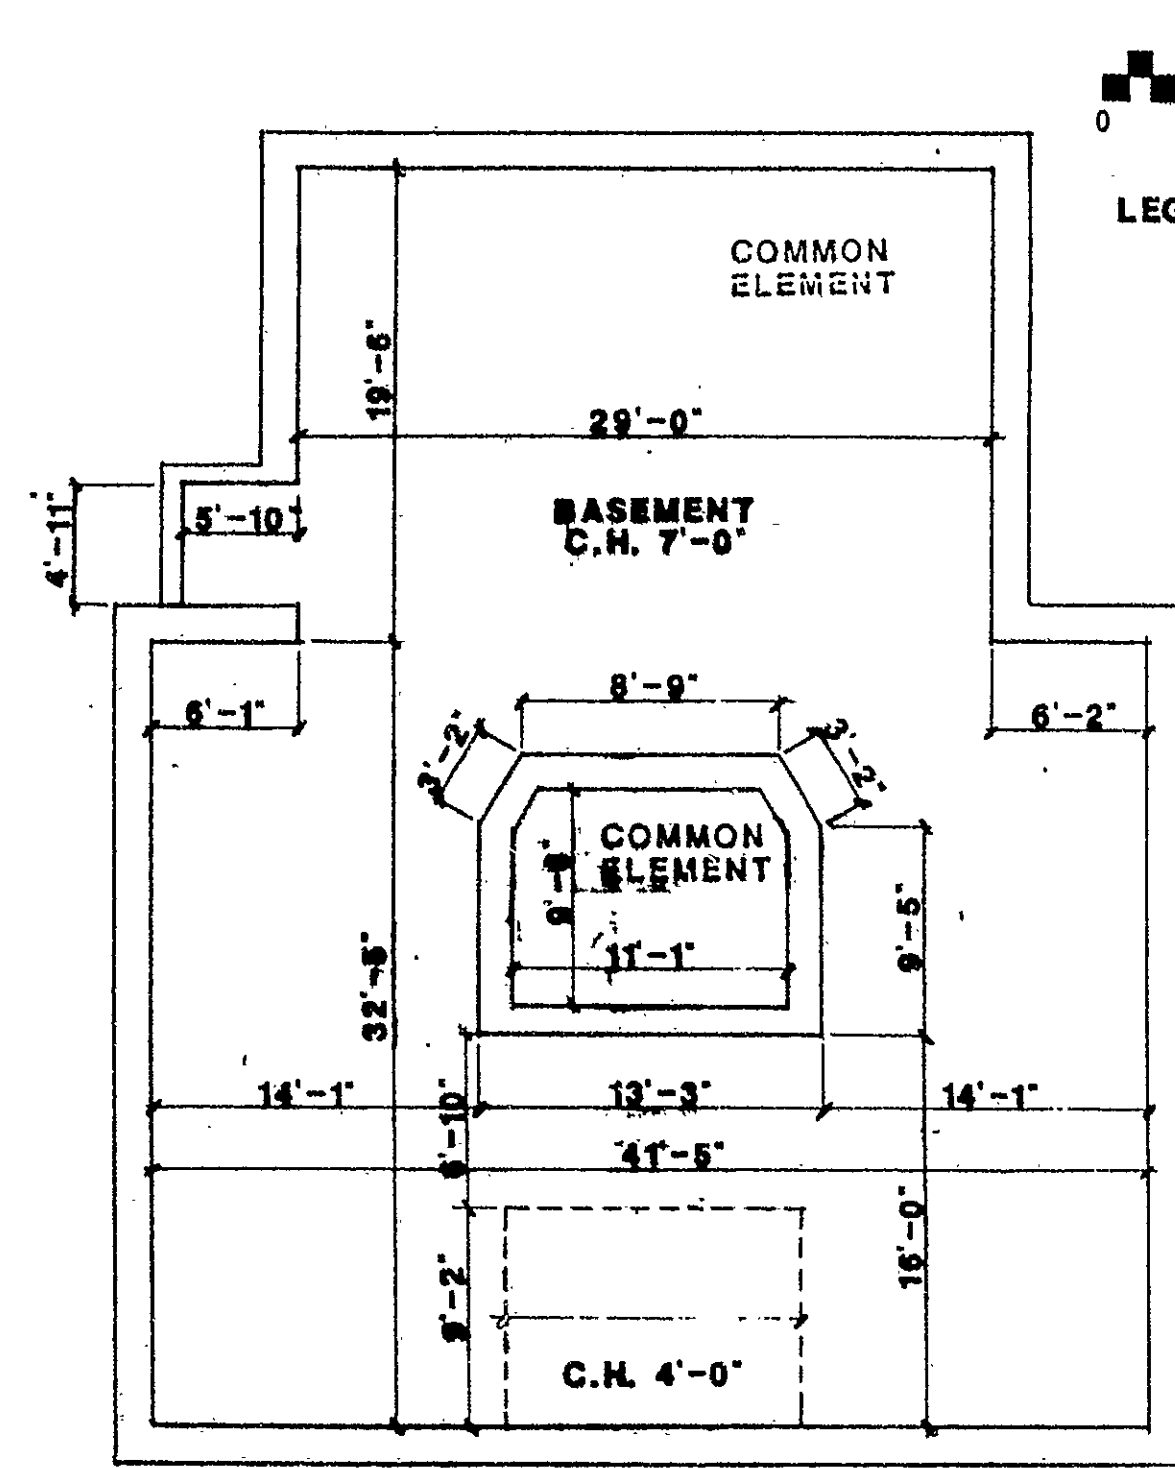


BASEMENT LEVEL

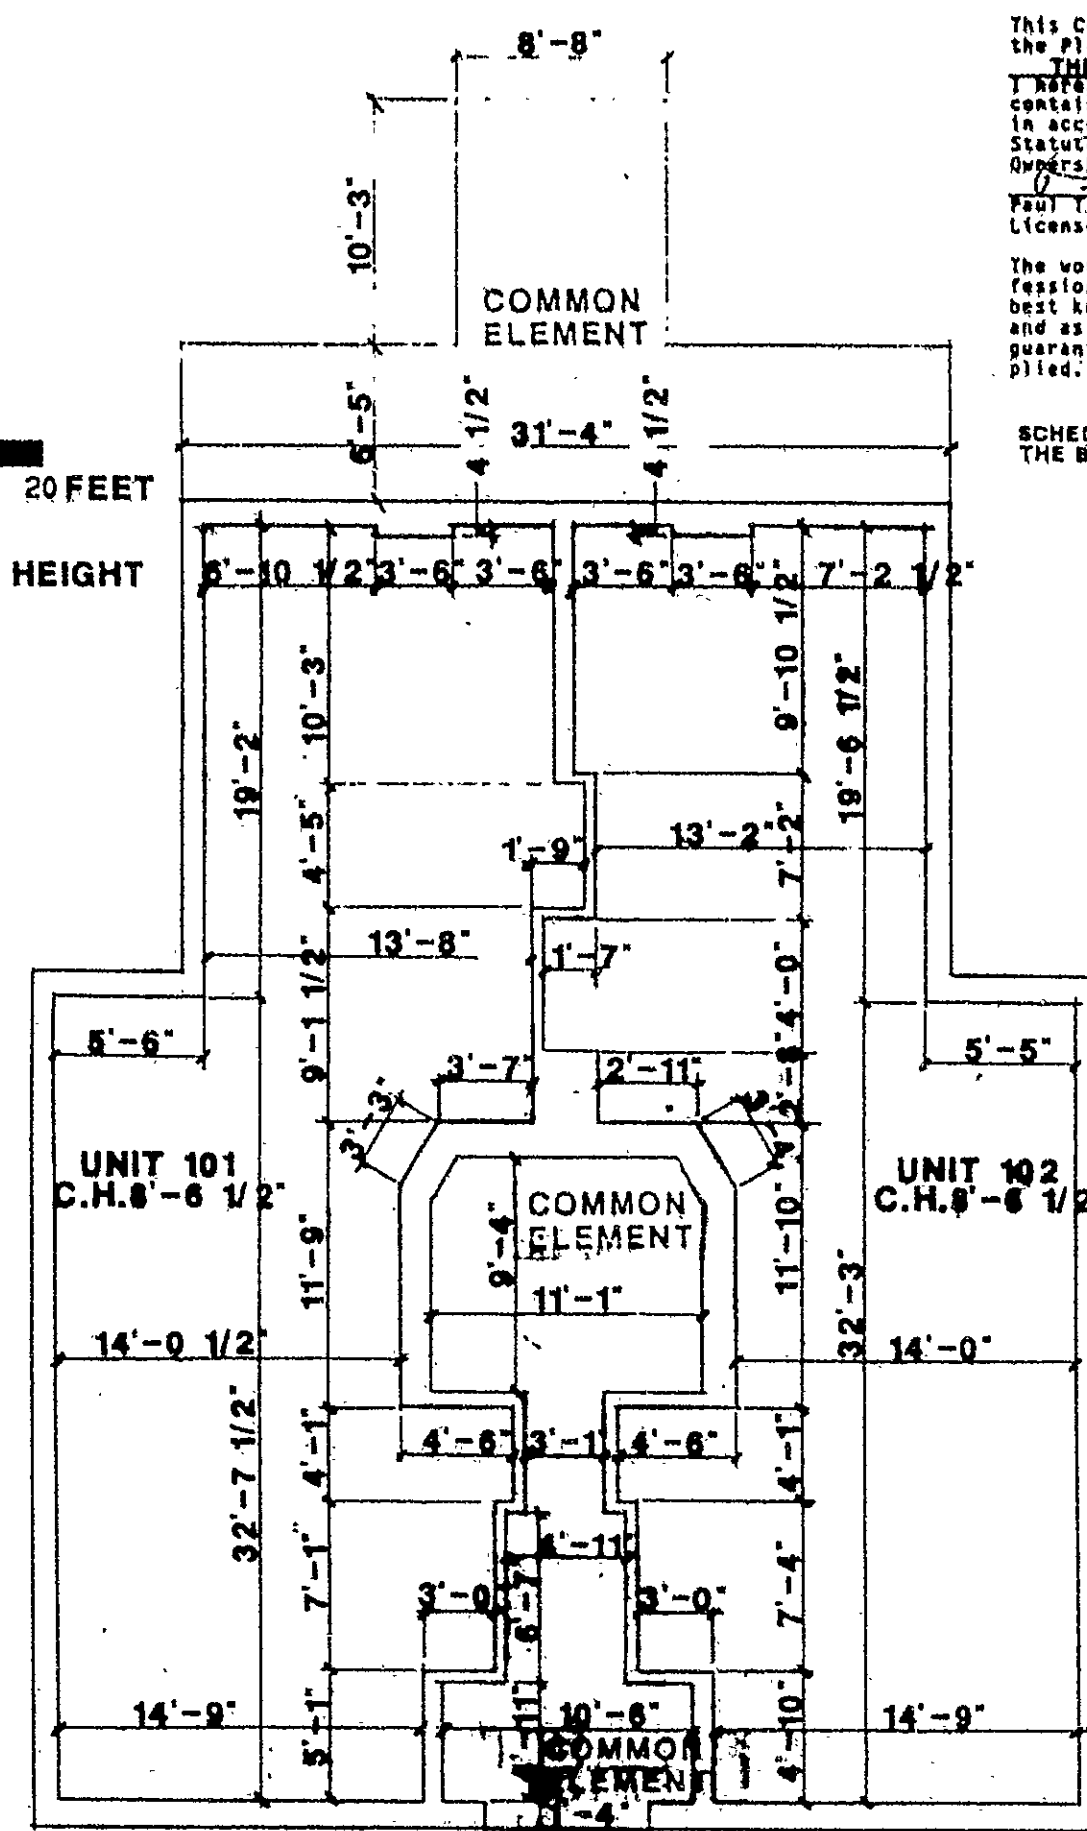

FIRST FLOOR PLAN C.H. 11'-0" (ENTRY)

CERTIFICATE
 This Certificate is given with regard to the Plans entitled **THE BERWICK - A CONDOMINIUM** prepared by **PAUL T. FRANZA, ARCHITECT**, License No. 6552. The word certify is an expression of professional opinion which is based on his best knowledge, information and belief, and as such it constitutes neither a guarantee nor a warranty expressed or implied.


SCHEDULE A-4 TO THE DECLARATION OF: **THE BERWICK**

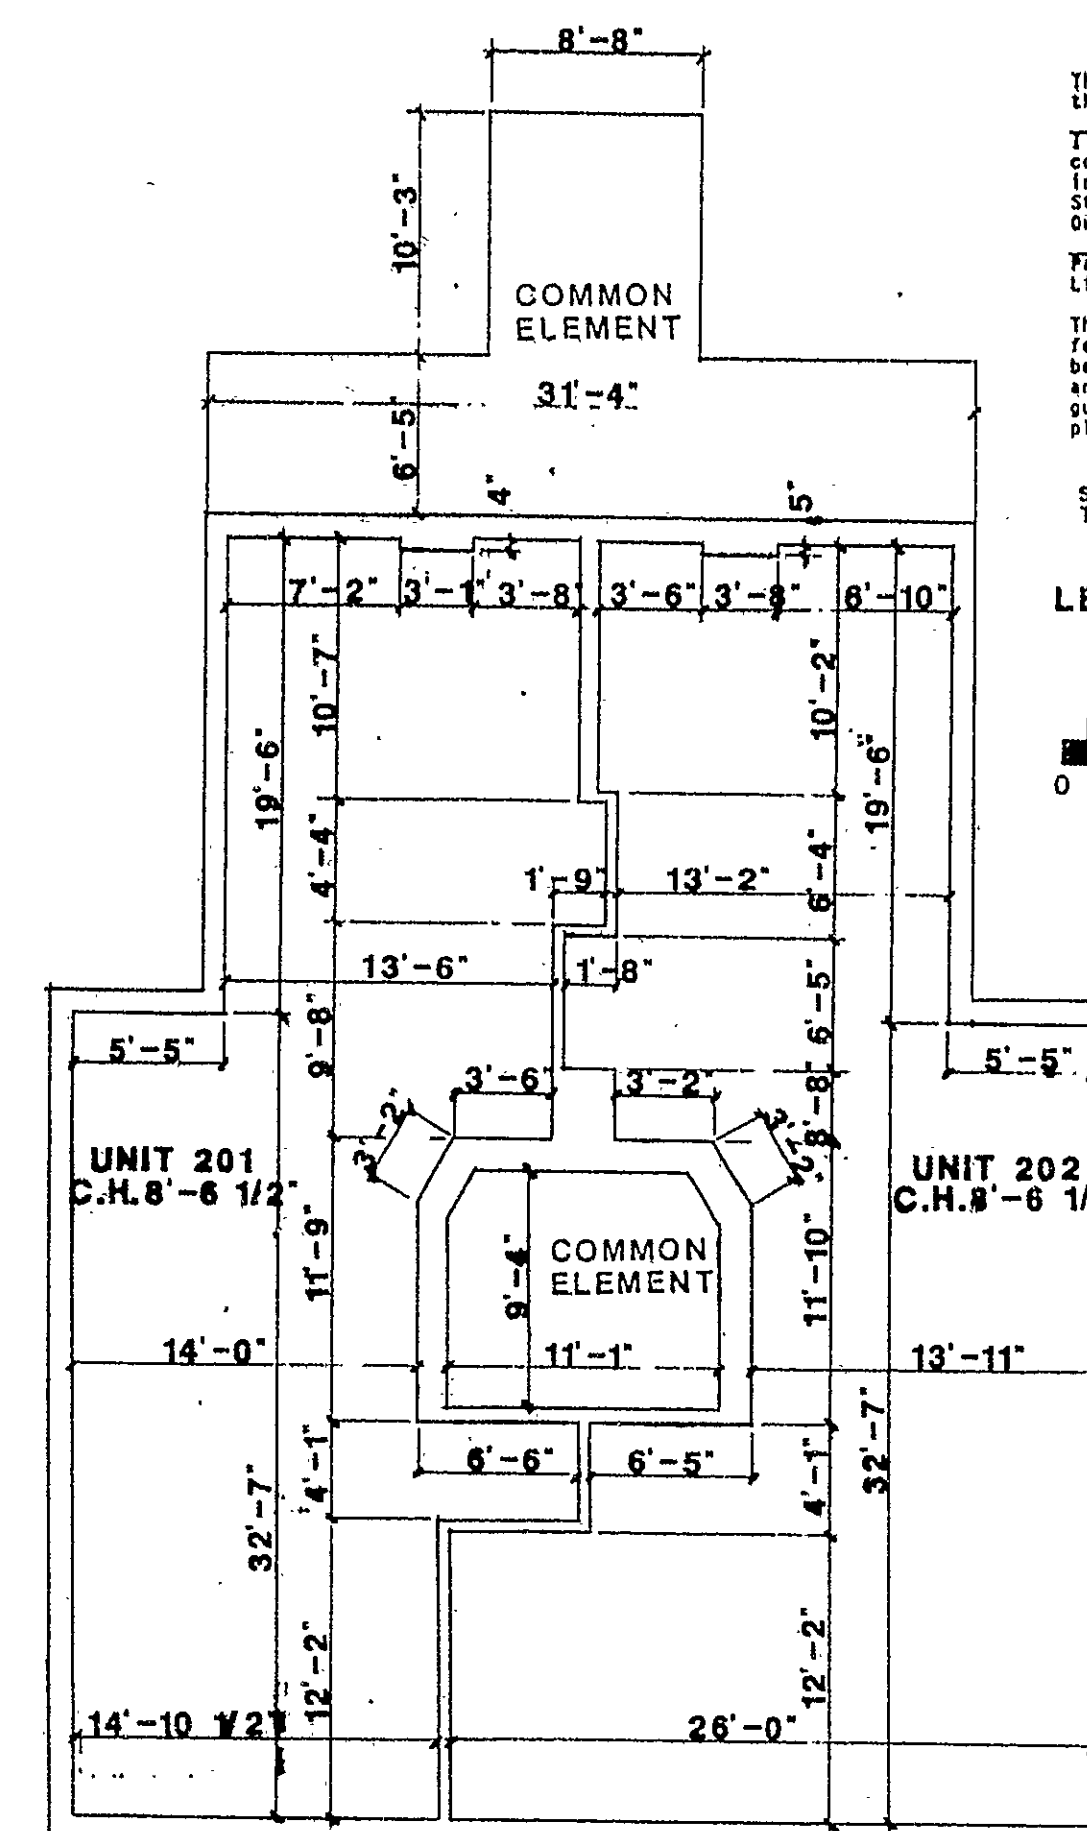

SECOND FLOOR PLAN

CERTIFICATE
 This Certificate is given with regard to the Plans entitled **THE BERWICK - A CONDOMINIUM** prepared by **PAUL T. FRANZA, ARCHITECT**, License No. 6552. The word certify is an expression of professional opinion which is based on his best knowledge, information and belief, and as such it constitutes neither a guarantee nor a warranty expressed or implied.

SCHEDULE A-4 TO THE DECLARATION OF: **THE BERWICK**

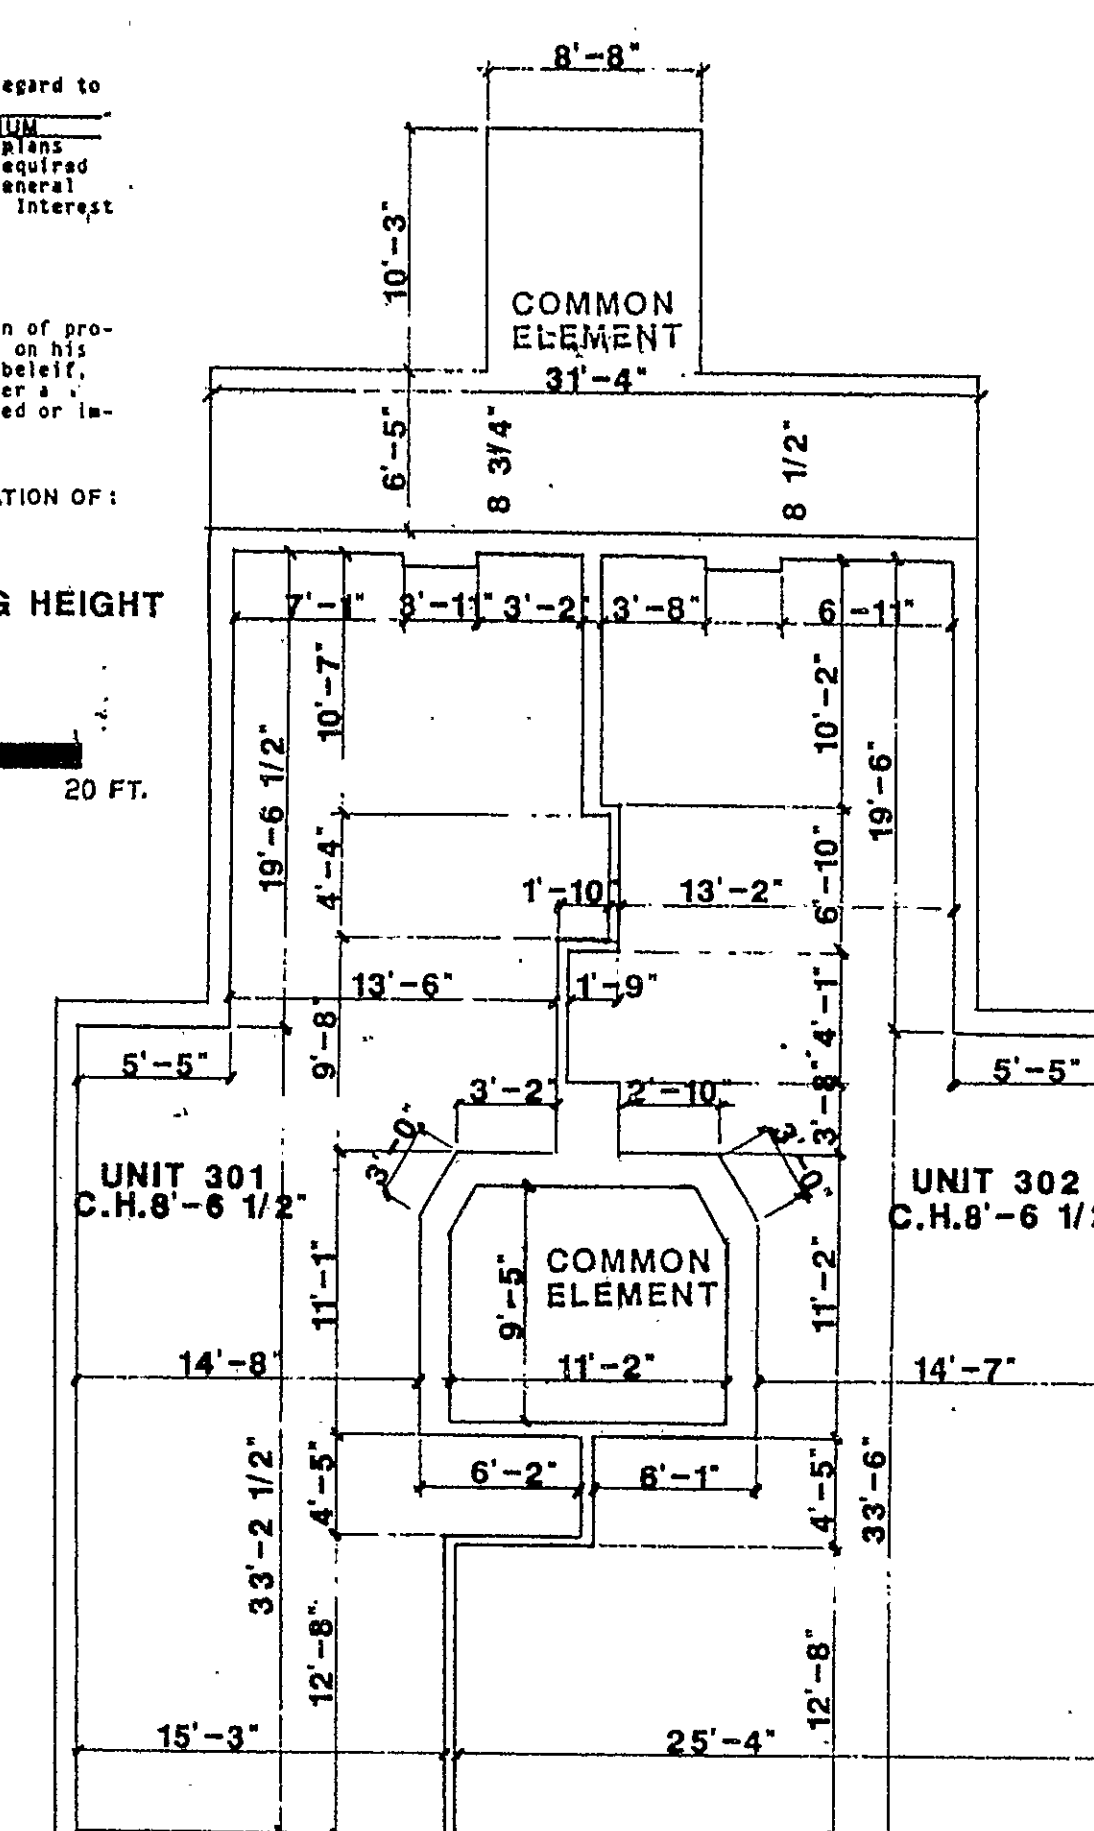


THIRD FLOOR PLAN

THE BERWICK - A CONDOMINIUM
 PLANS PREPARED FOR
K.P. ASSOCIATES
 BY PAUL T. FRANZA, ARCHITECT, P.O. BOX 122 MANCHESTER, CT. 06040
PROPERTY KNOWN AS 18 CONGRESS STREET
HARTFORD, CONNECTICUT
 SEPTEMBER 16, 1988

SHEET 2 OF 3

SHEET 1 OF 3

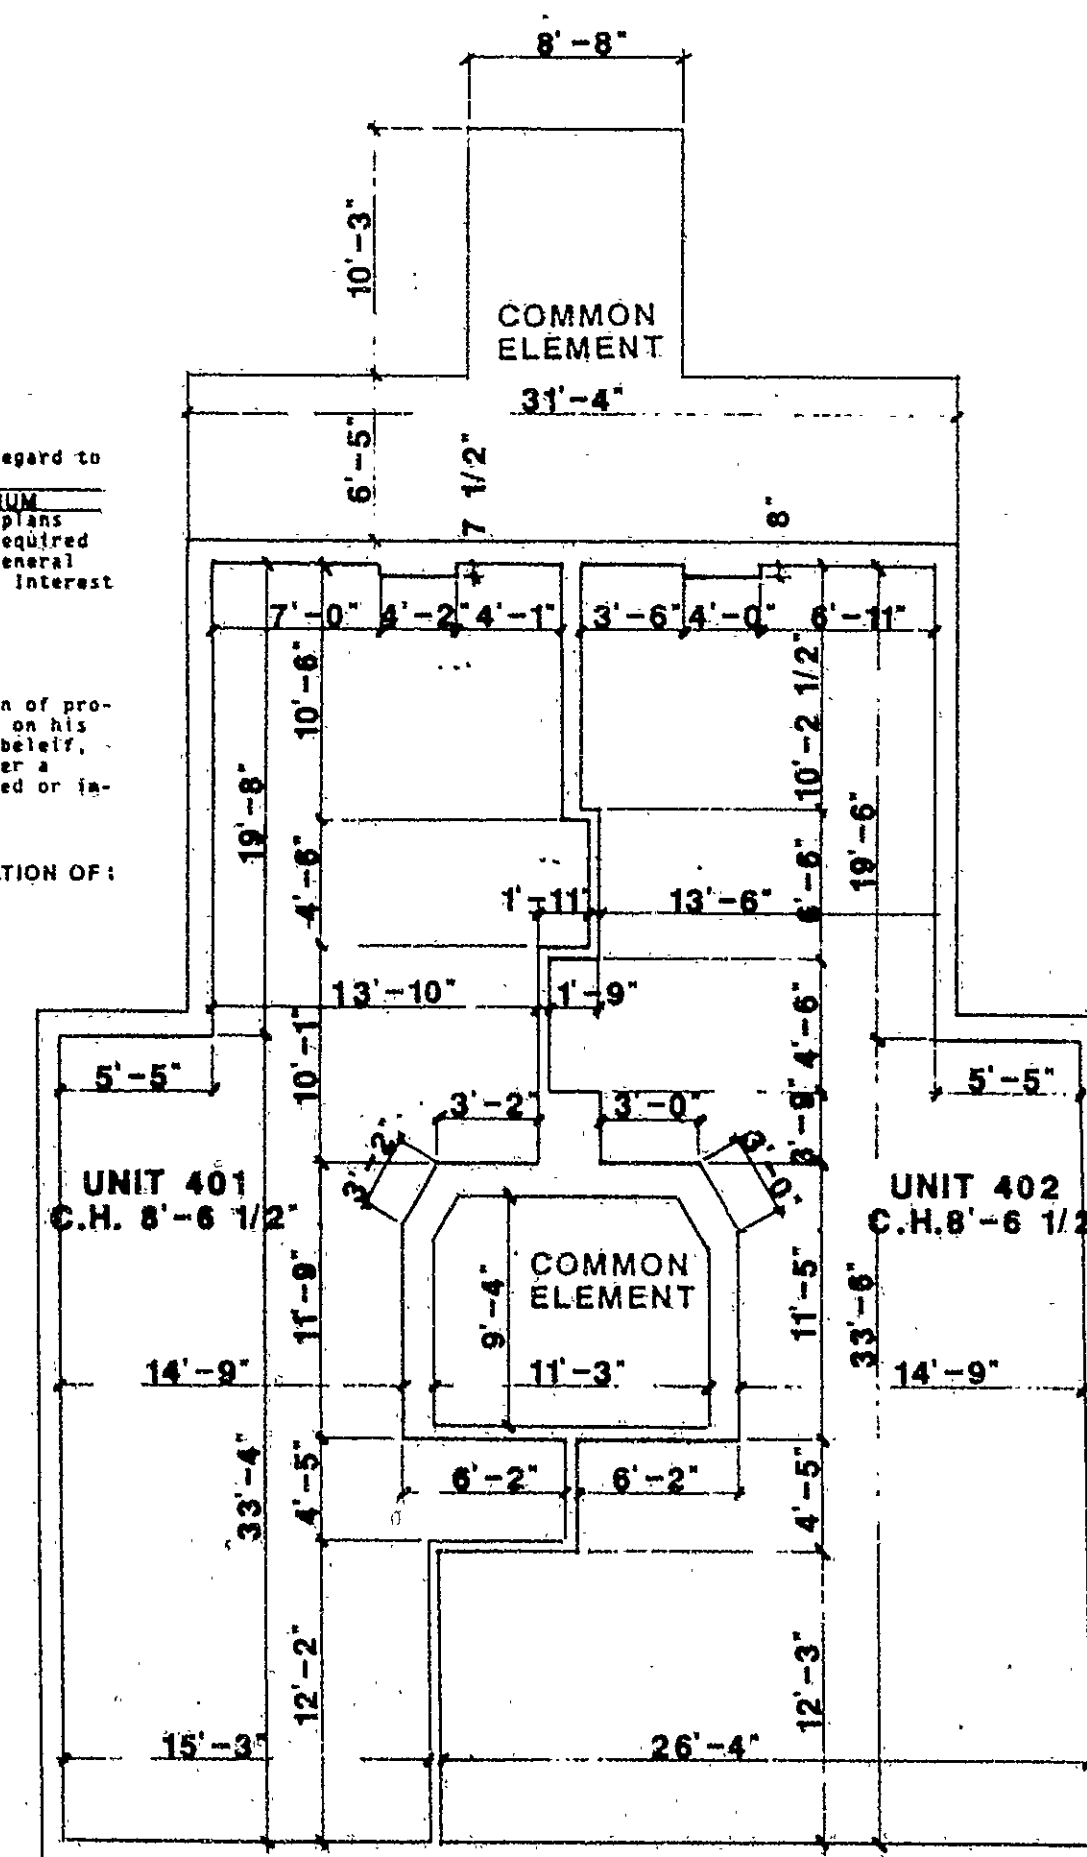

FOURTH FLOOR PLAN

CERTIFICATE
 This Certificate is given with regard to the Plans entitled **THE BERWICK - A CONDOMINIUM** prepared by **PAUL T. FRANZA, ARCHITECT**, License No. 6552. The word certify is an expression of professional opinion which is based on his best knowledge, information and belief, and as such it constitutes neither a guarantee nor a warranty expressed or implied.

SCHEDULE A-4 TO THE DECLARATION OF: **THE BERWICK**

THE BERWICK - A CONDOMINIUM
 PLANS PREPARED FOR
K.P. ASSOCIATES
 BY PAUL T. FRANZA, ARCHITECT, P.O. BOX 122 MANCHESTER, CT. 06040
PROPERTY KNOWN AS 18 CONGRESS STREET
HARTFORD, CONNECTICUT
 SEPTEMBER 16, 1988

SHEET 3 OF 3

Condo Plan # 97

