


RECEIVED
FEB 13 1988
FEB 13 1988

THE ARGYLE - A CONDOMINIUM
PLANS PREPARED FOR
K-P ASSOCIATES
BY PAUL T. FRANZA, ARCHITECT, P.O. BOX 122 MANCHESTER, CT. 06040
PROPERTY KNOWN AS 10-12 CONGRESS STREET
HARTFORD, CONNECTICUT
SEPTEMBER 16, 1988

THIS CERTIFICATE IS GIVEN with regard to the information contained herein, which is based on the information furnished to the architect by the owner, and is not a warranty or representation of the architect's liability for the accuracy of the information furnished to the architect by the owner.


FIRST FLOOR PLAN

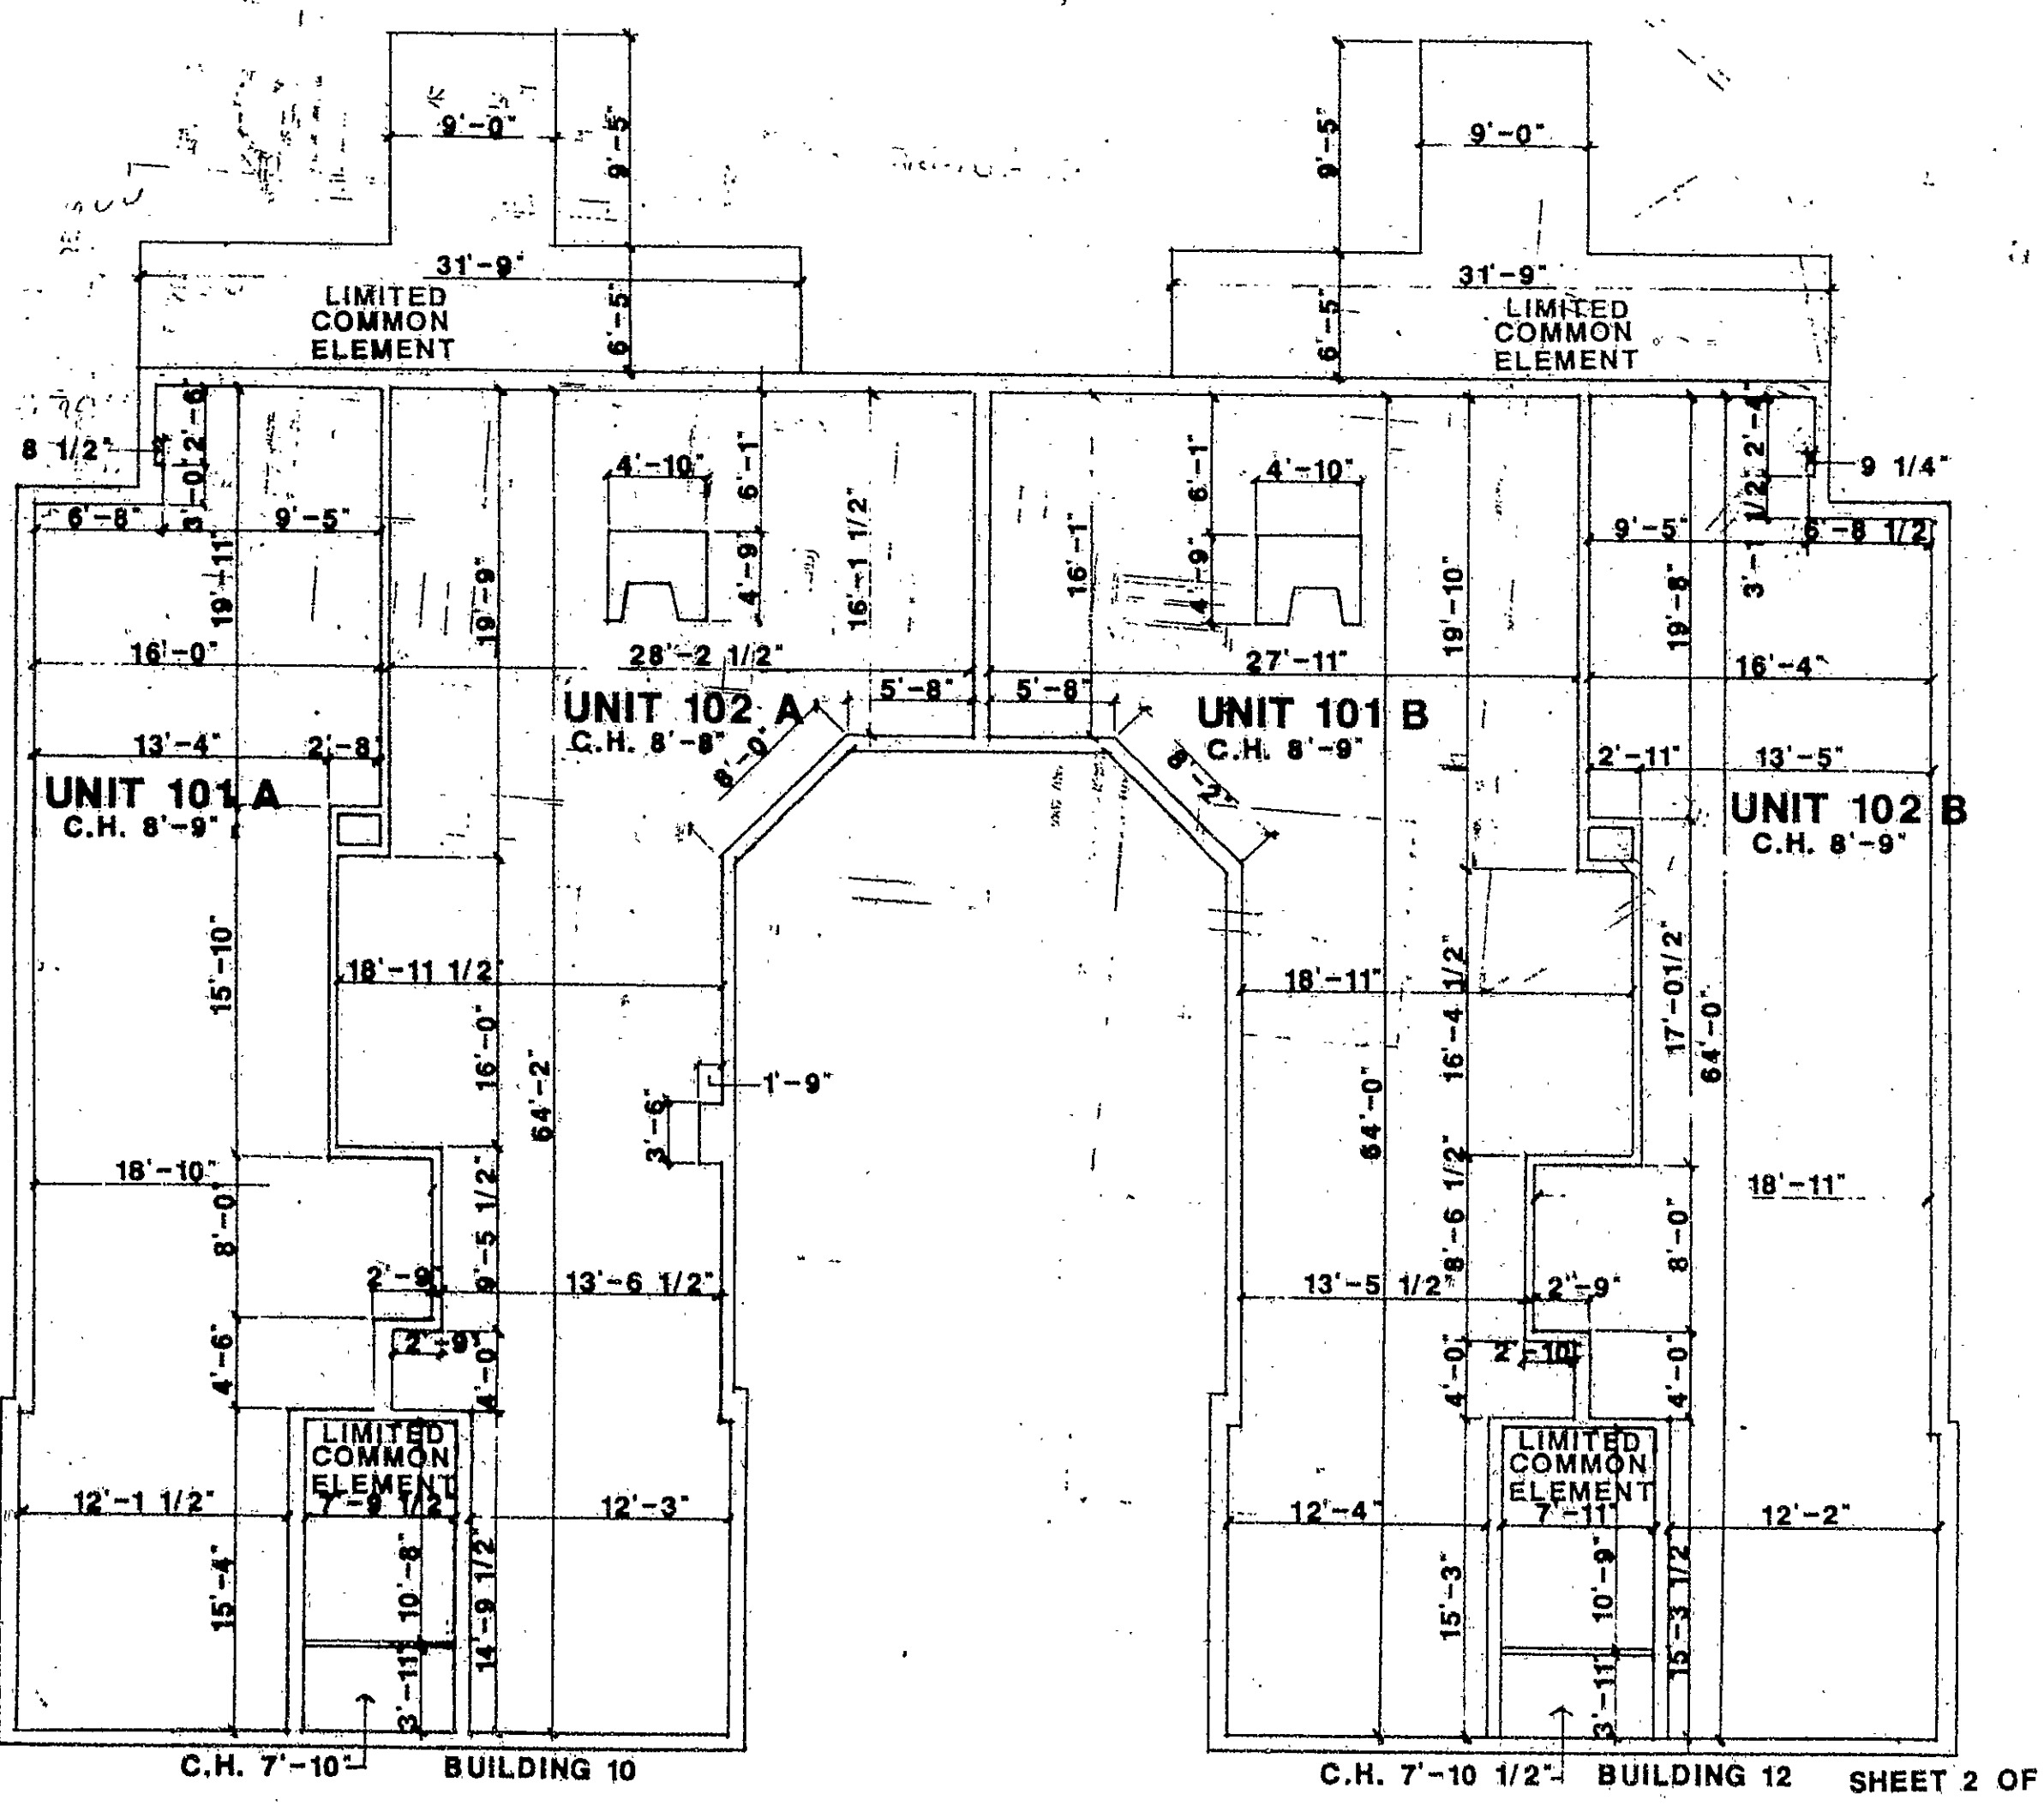

THE ARGYLE - A CONDOMINIUM
PLANS PREPARED FOR
K-P ASSOCIATES
BY PAUL T. FRANZA, ARCHITECT, P.O. BOX 122 MANCHESTER, CT. 06040
PROPERTY KNOWN AS 10-12 CONGRESS STREET
HARTFORD, CONNECTICUT
SEPTEMBER 16, 1988

THIS CERTIFICATE IS GIVEN with regard to the information contained herein, which is based on the information furnished to the architect by the owner, and is not a warranty or representation of the architect's liability for the accuracy of the information furnished to the architect by the owner.


BASEMENT PLAN

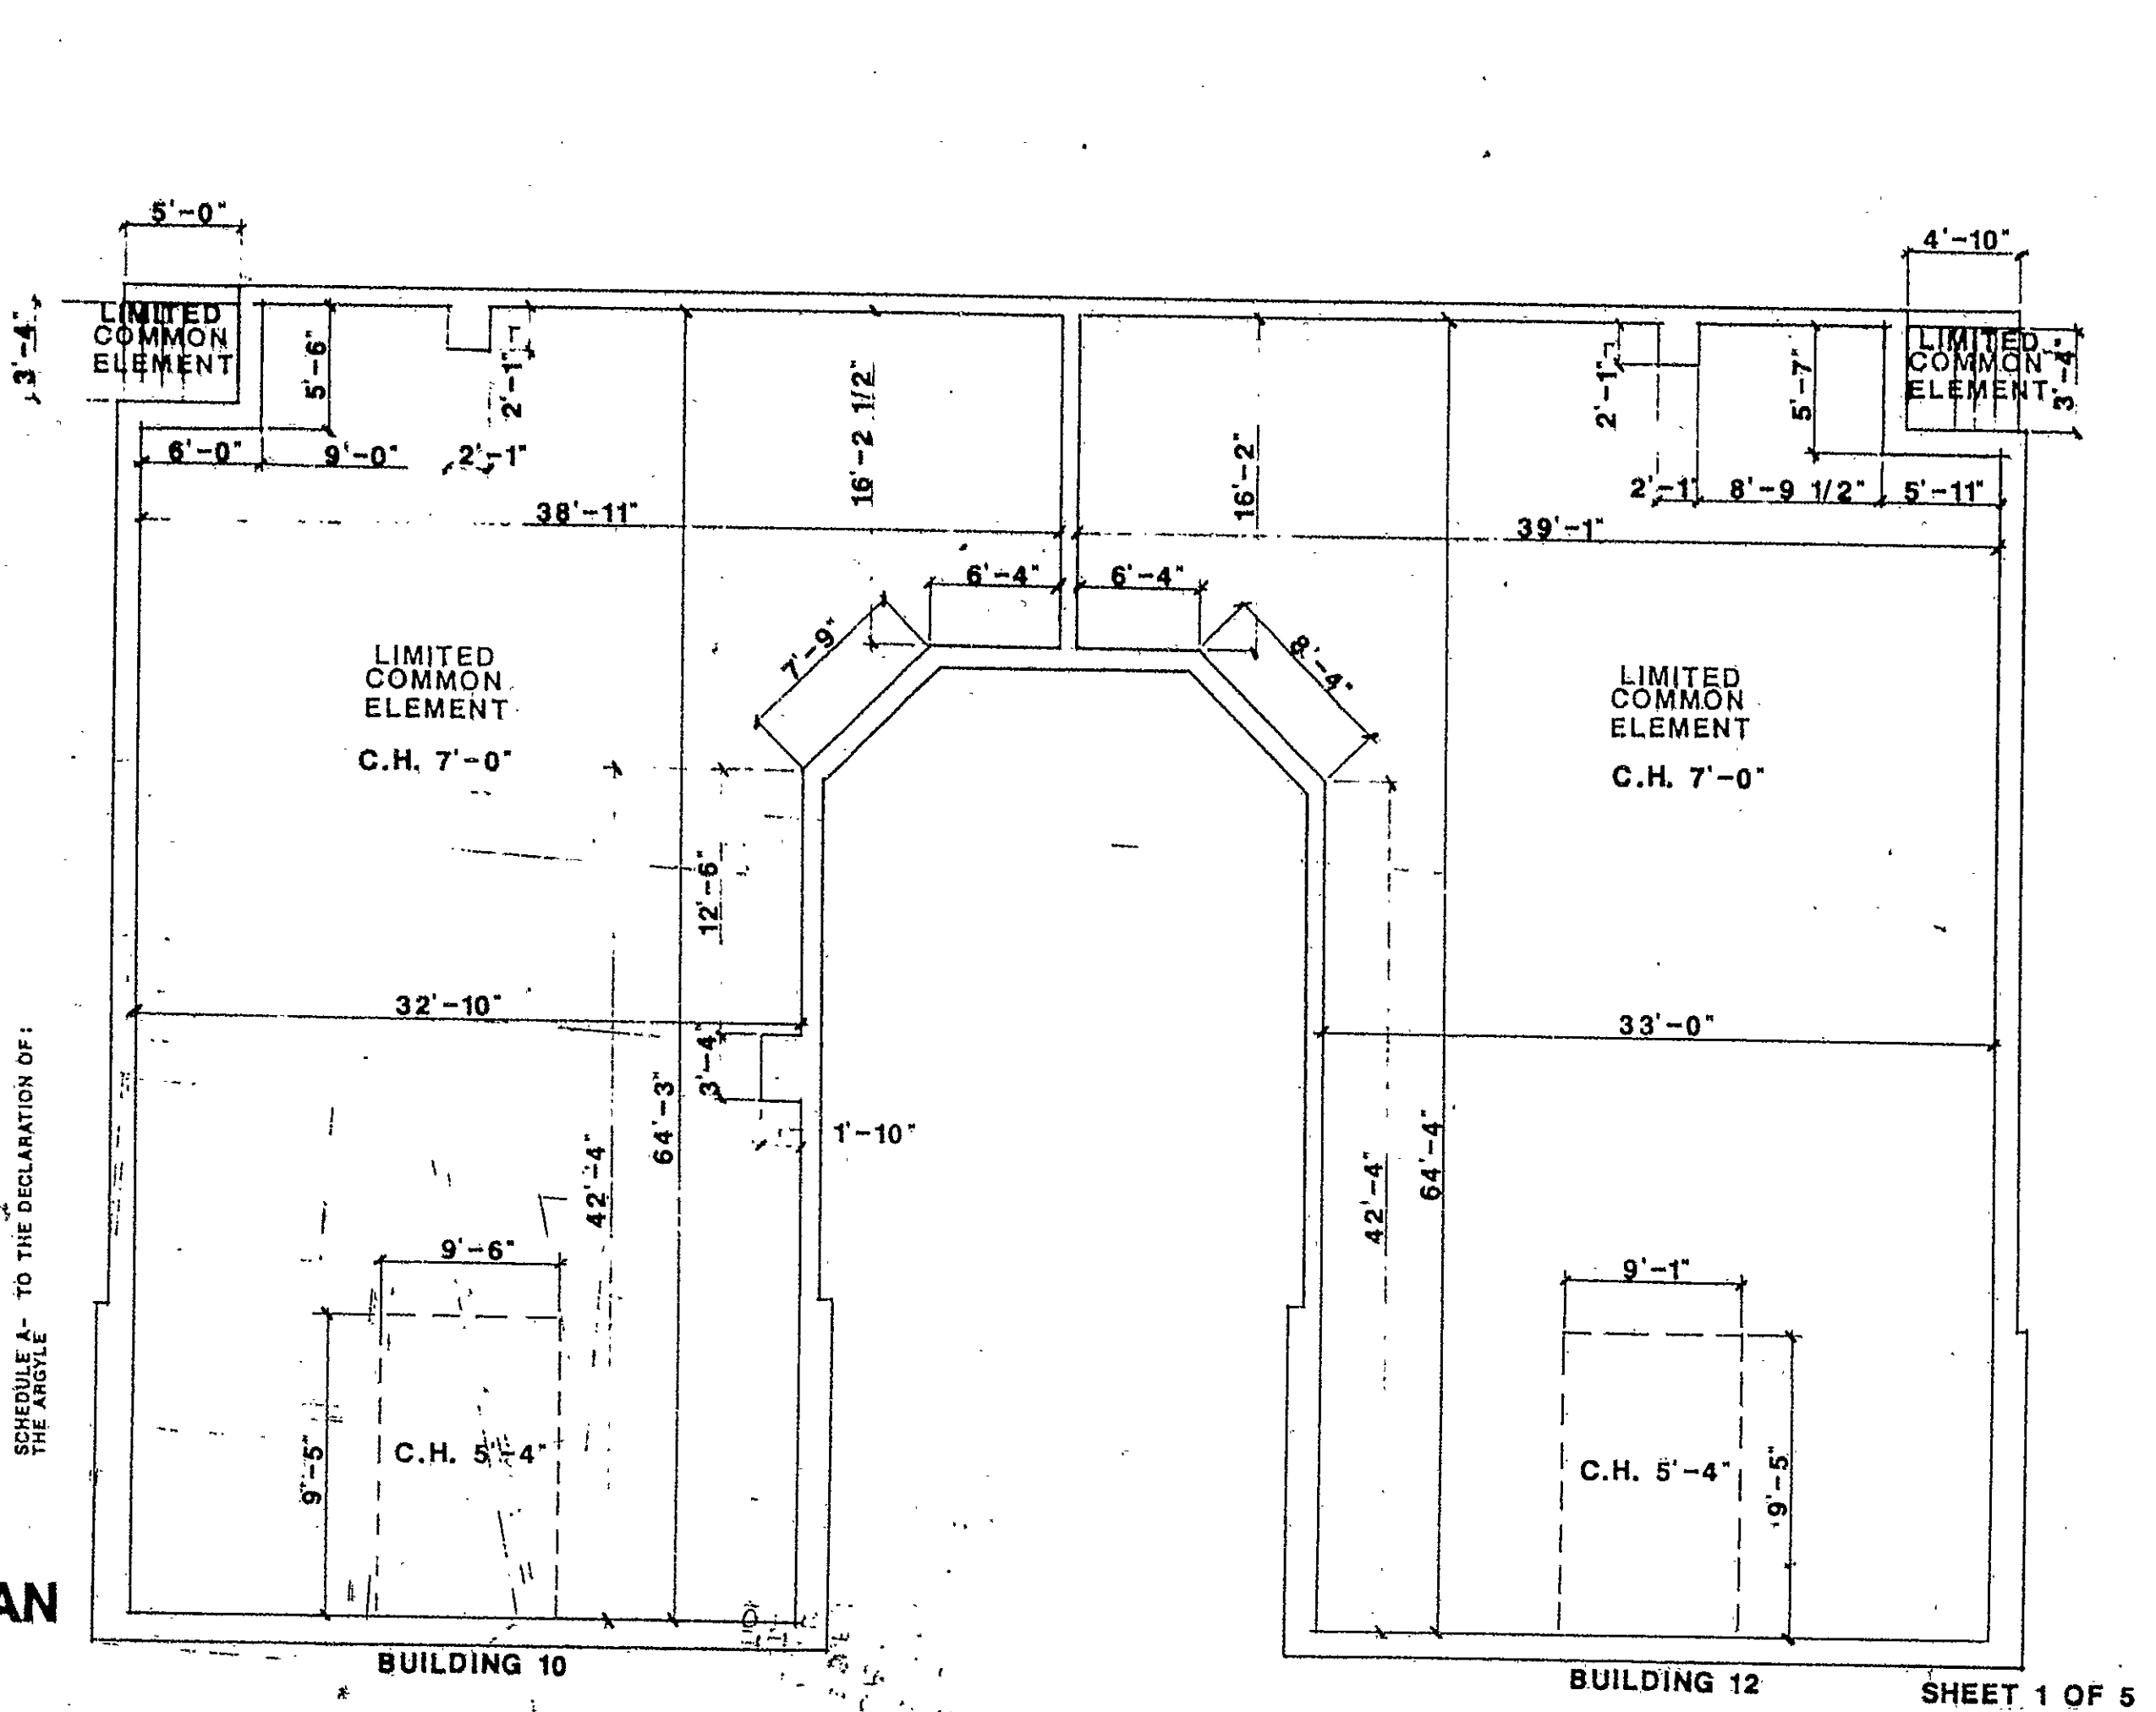

THE ARGYLE - A CONDOMINIUM
PLANS PREPARED FOR
K-P ASSOCIATES
BY PAUL T. FRANZA, ARCHITECT, P.O. BOX 122 MANCHESTER, CT. 06040
PROPERTY KNOWN AS 10-12 CONGRESS STREET
HARTFORD, CONNECTICUT
SEPTEMBER 16, 1988

THIS CERTIFICATE IS GIVEN with regard to the information contained herein, which is based on the information furnished to the architect by the owner, and is not a warranty or representation of the architect's liability for the accuracy of the information furnished to the architect by the owner.

SECOND FLOOR PLAN

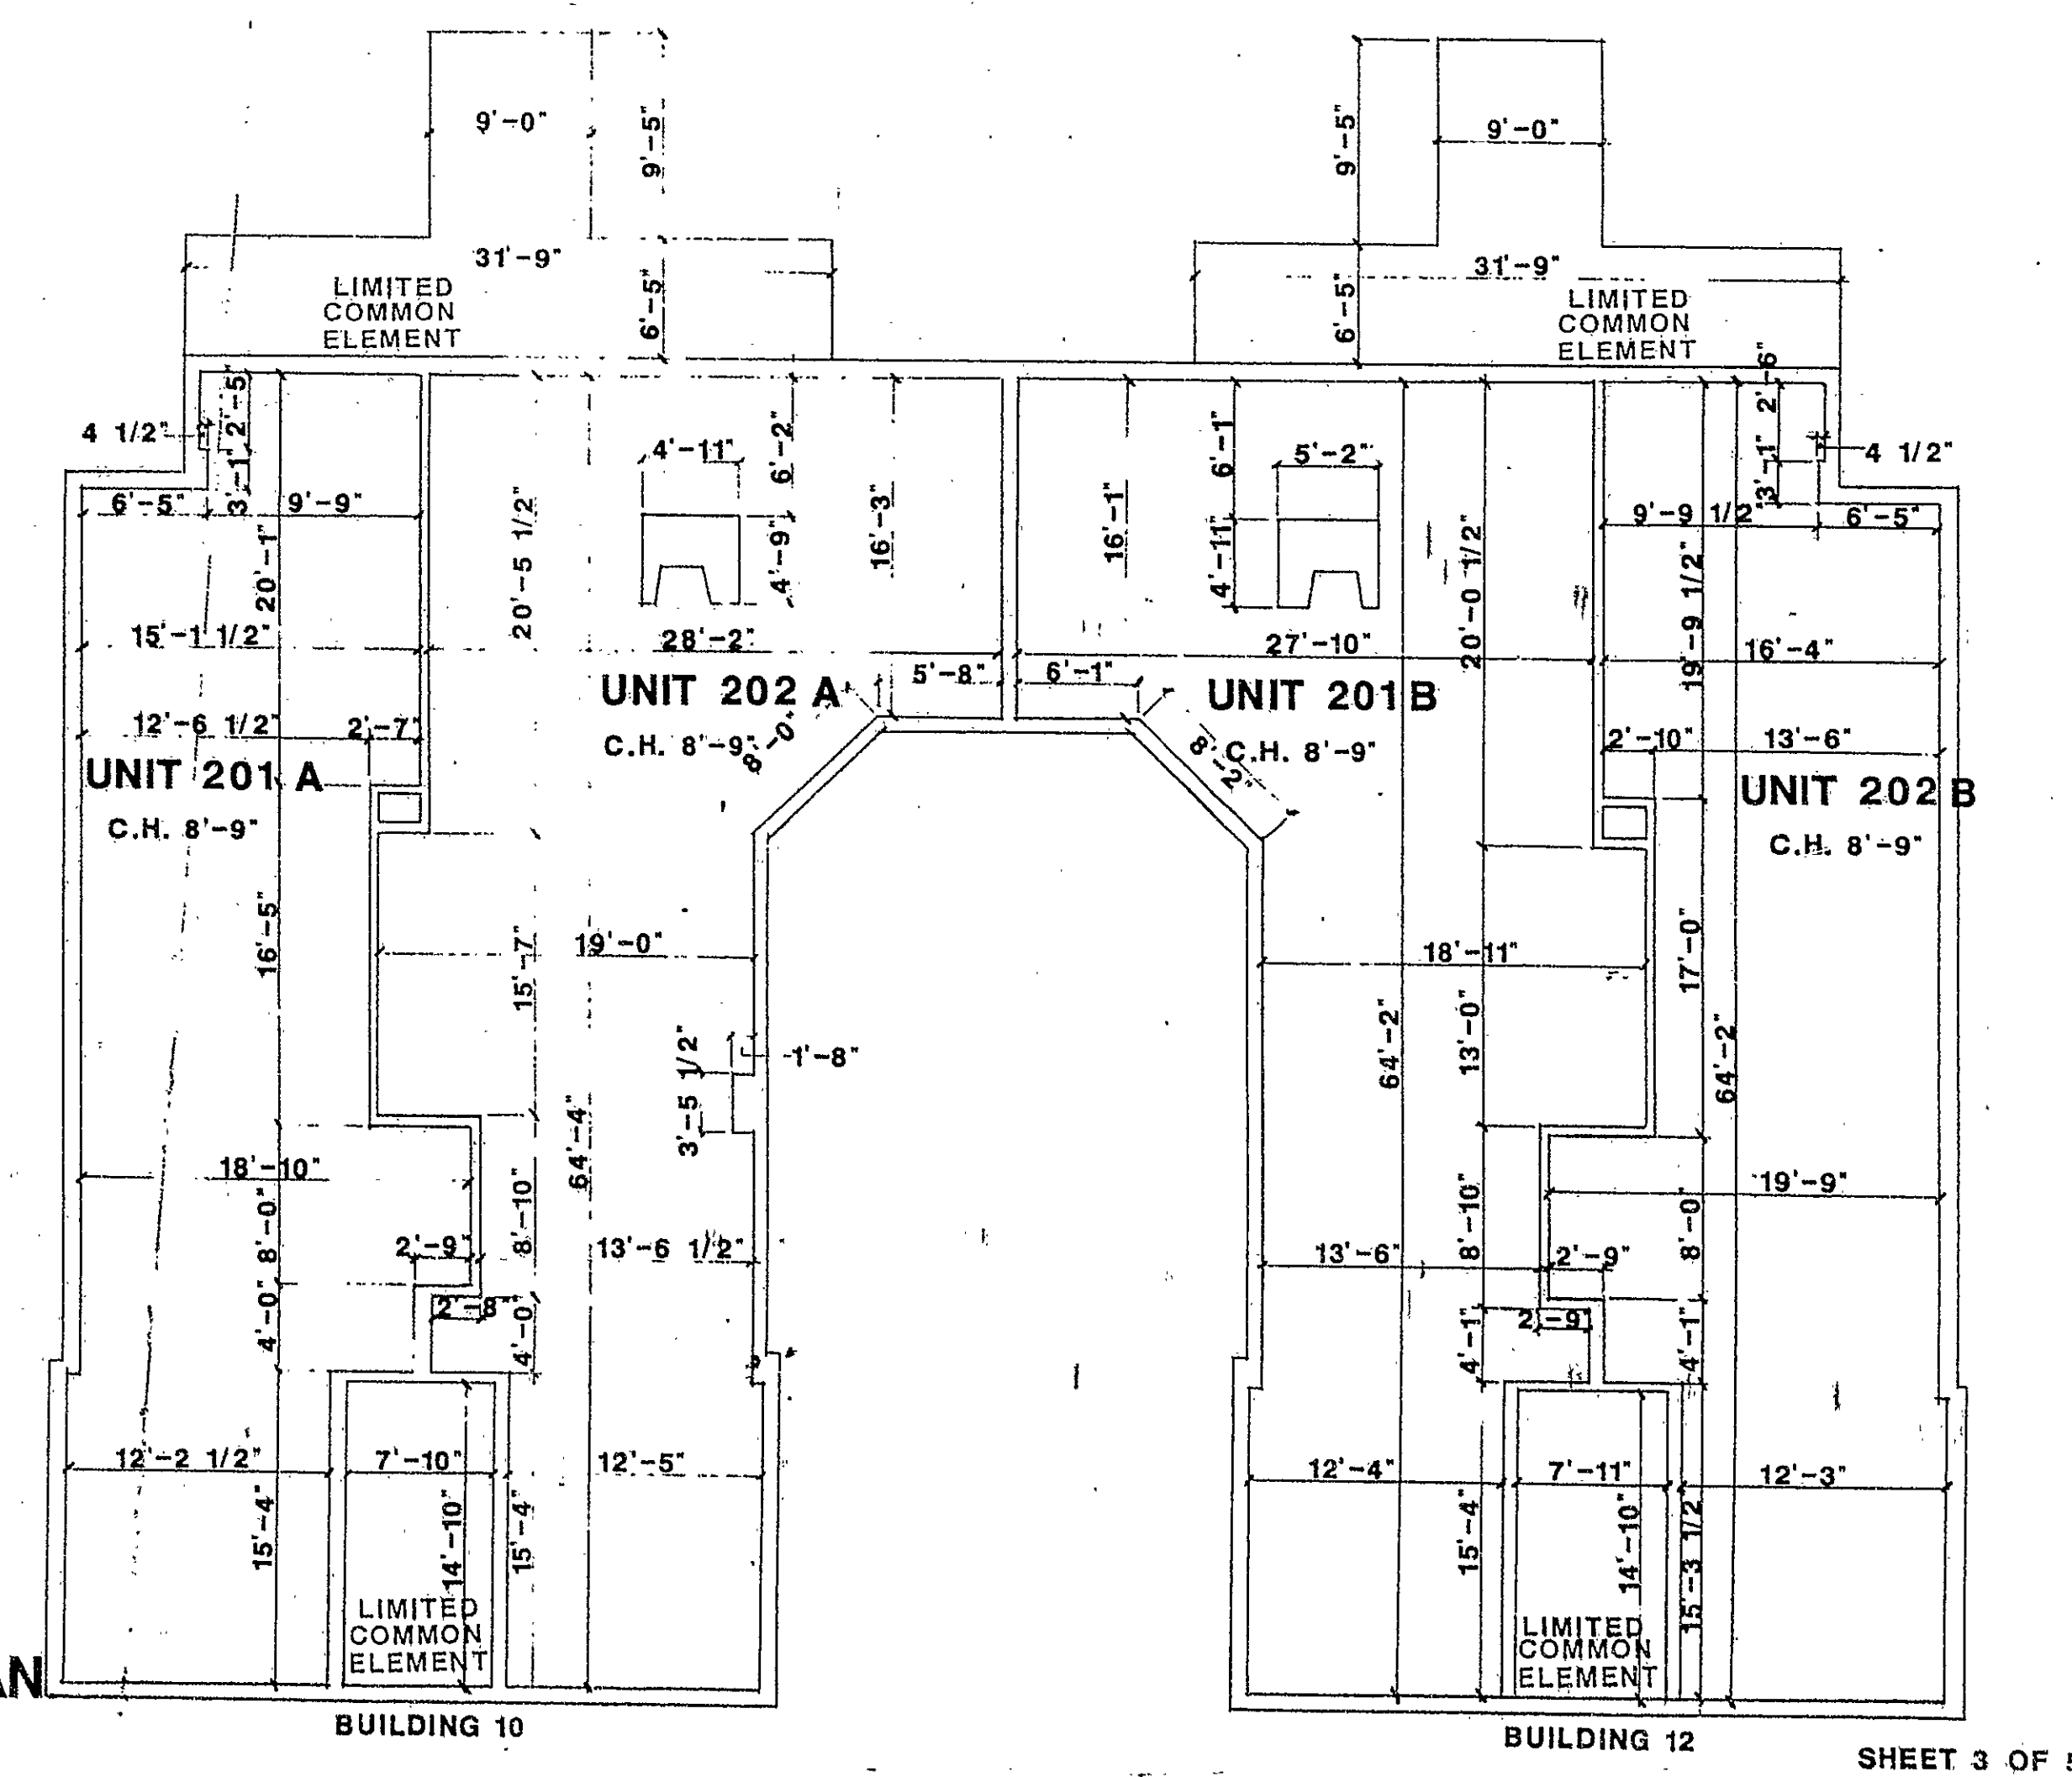

Condo Plan # 98