



RECEIVED BK
JUN 30 5 28 PM '83
A07

EAST FIRE CORP. IRVINE, CA EPH 34
100

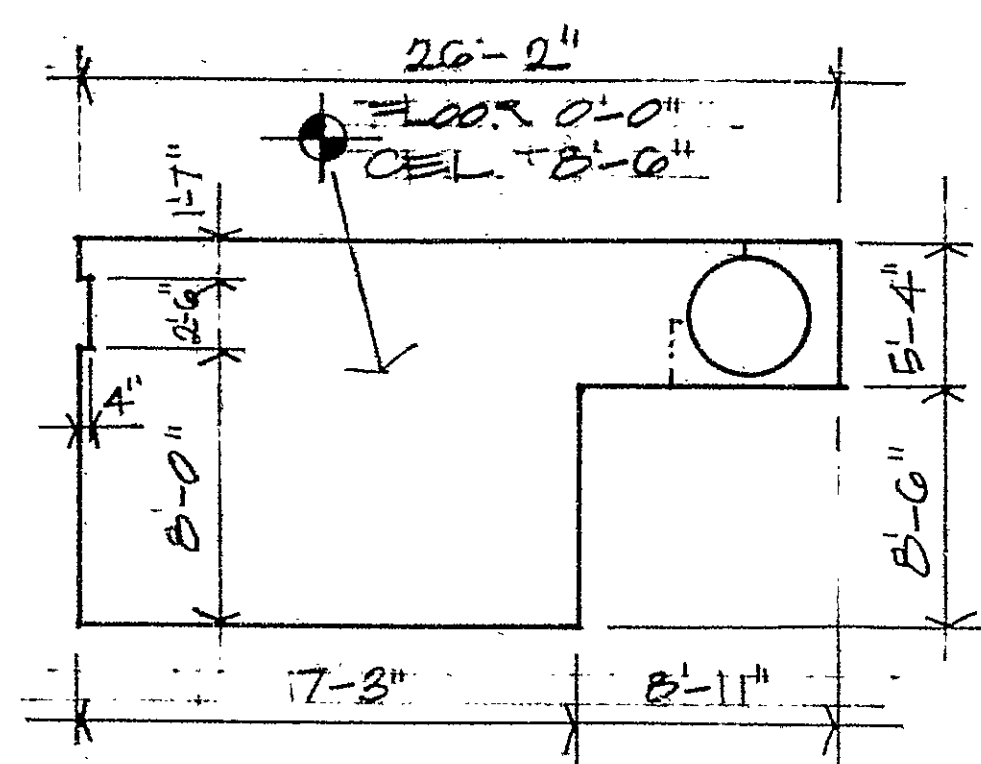

SECOND FLOOR PLAN

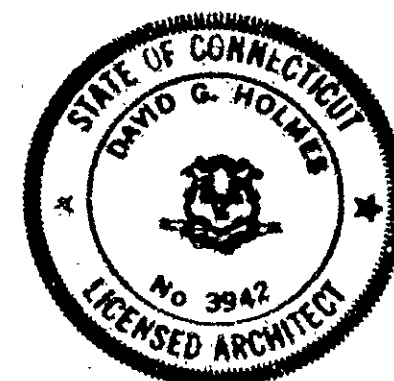


All elevations are referenced to finished floor at each level (0'-0"). All other elevations are ±('- ").

Certification



The undersigned does hereby certify that to the best of his knowledge and belief these plans contain all information required by Connecticut General Statutes Section 47-228 relating to plans.

David G. Holmes

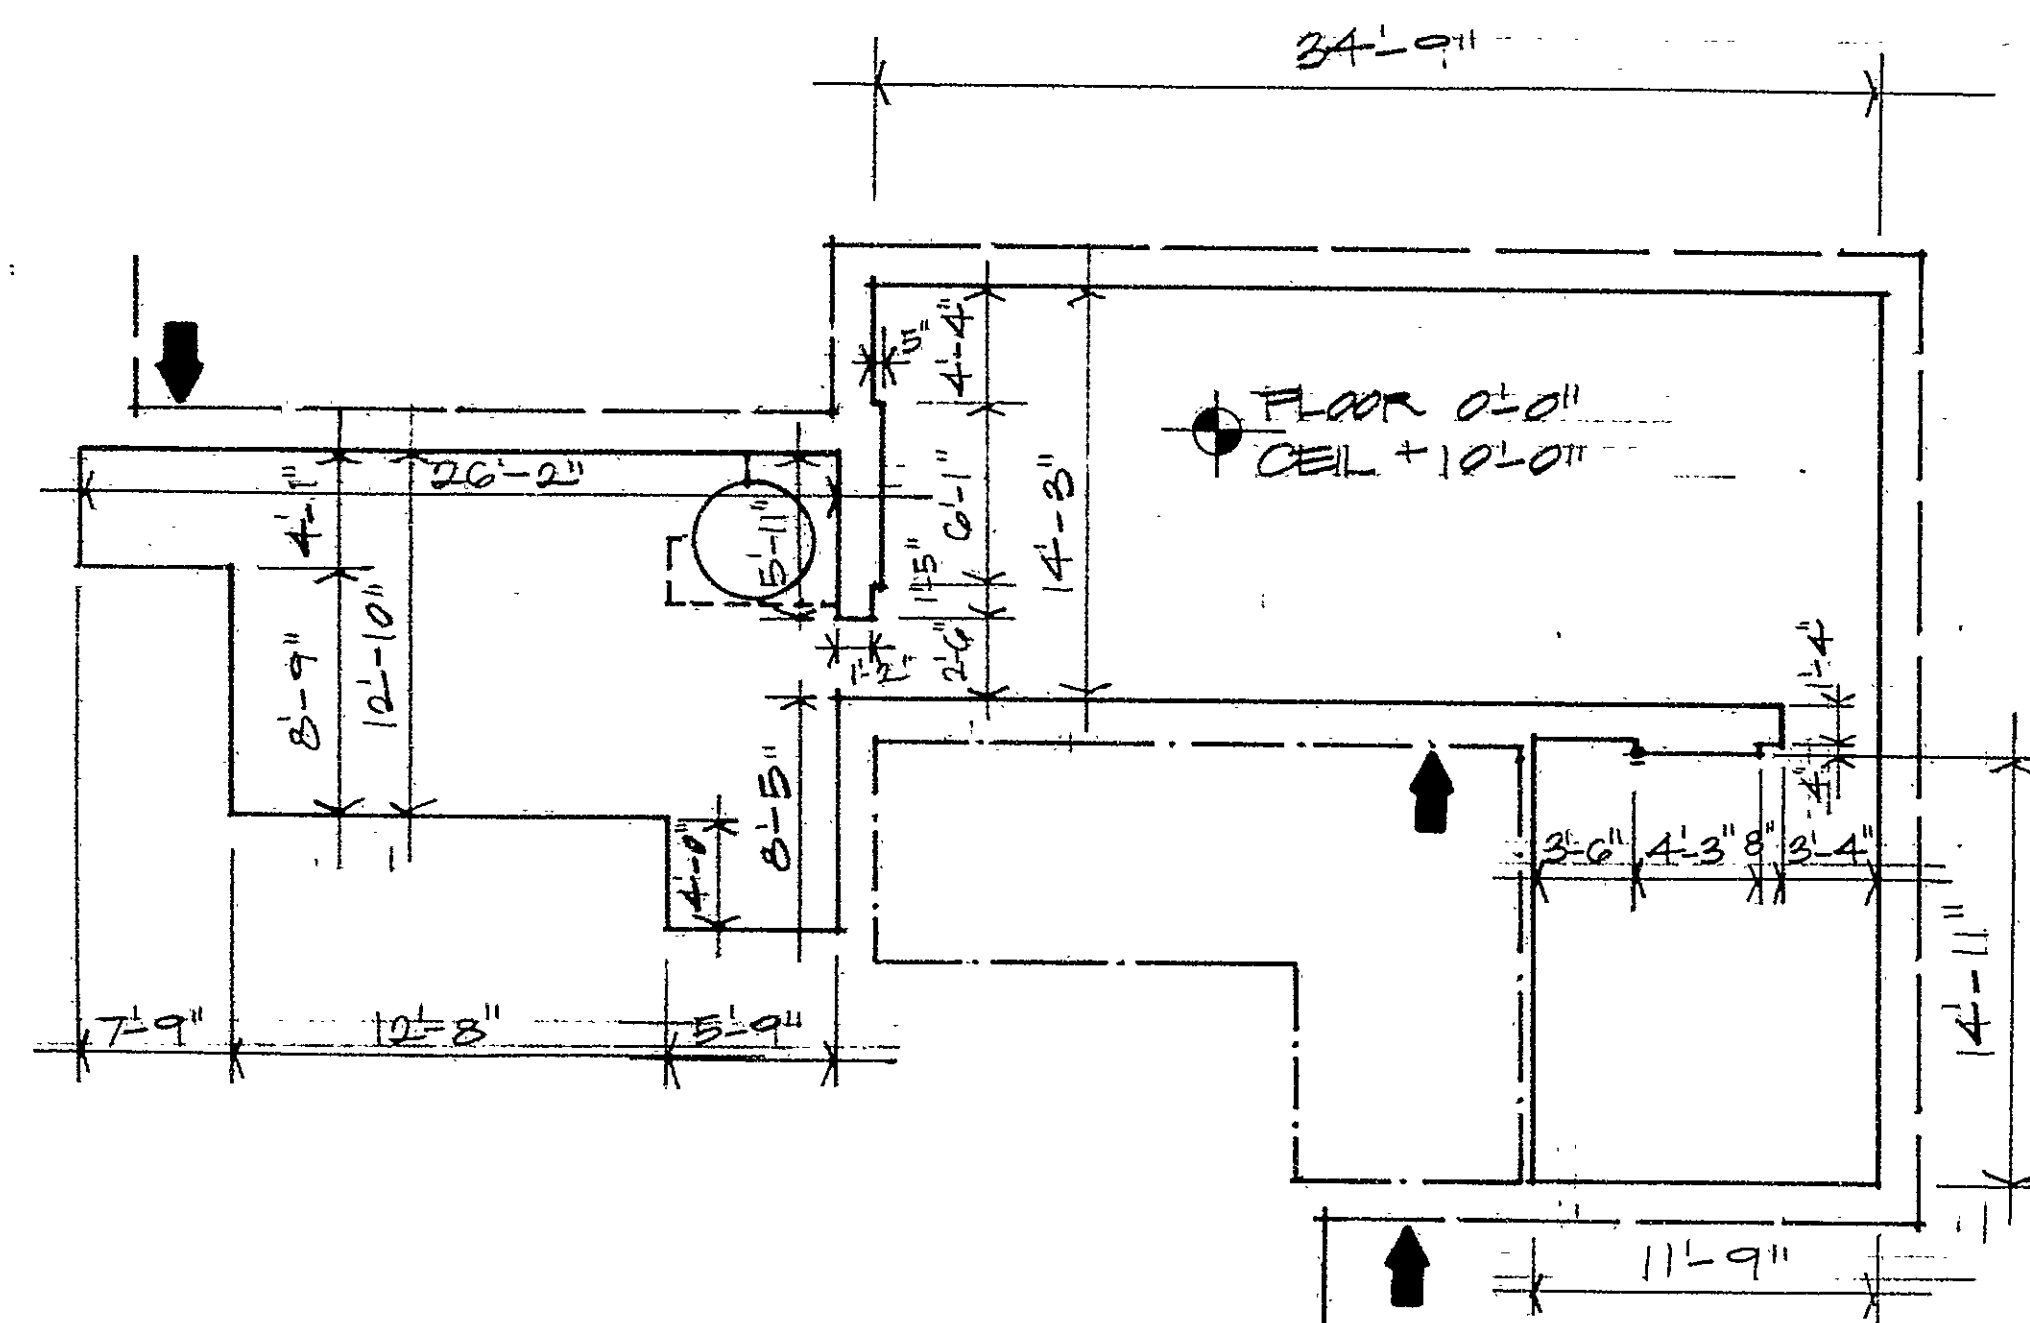

FLOOR PLAN

APPROX. SQUARE FOOTAGE = ± 1254 S.F.

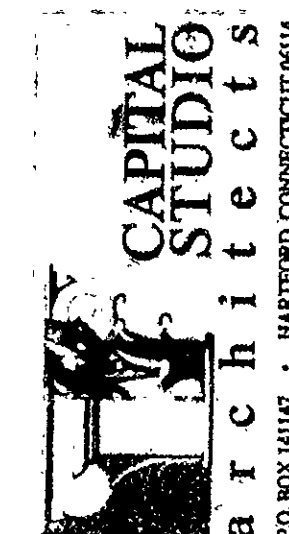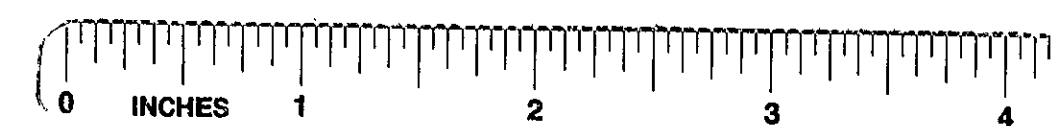

CONDOMINIUMS ON THE PLACE
RENÉ VEILLEUX
DECLARANT

Plan No. 100

LEGEND

- UNIT BOUNDARY
- EXT. SURFACE
- ELEV. CHANGE
- LTD. COMM. ELEM.
- CEIL. HGT. CHANGE
- SLOP. CEL. ABOVE

UNIT 1

SHEET 1

0 2 4 8'

REF. NORTH

