

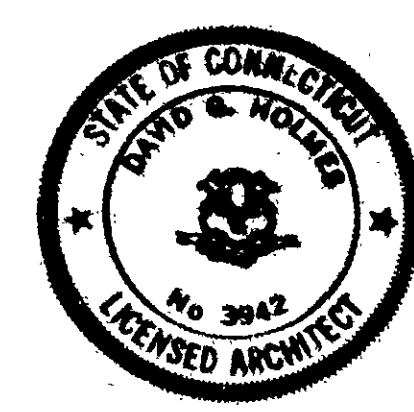


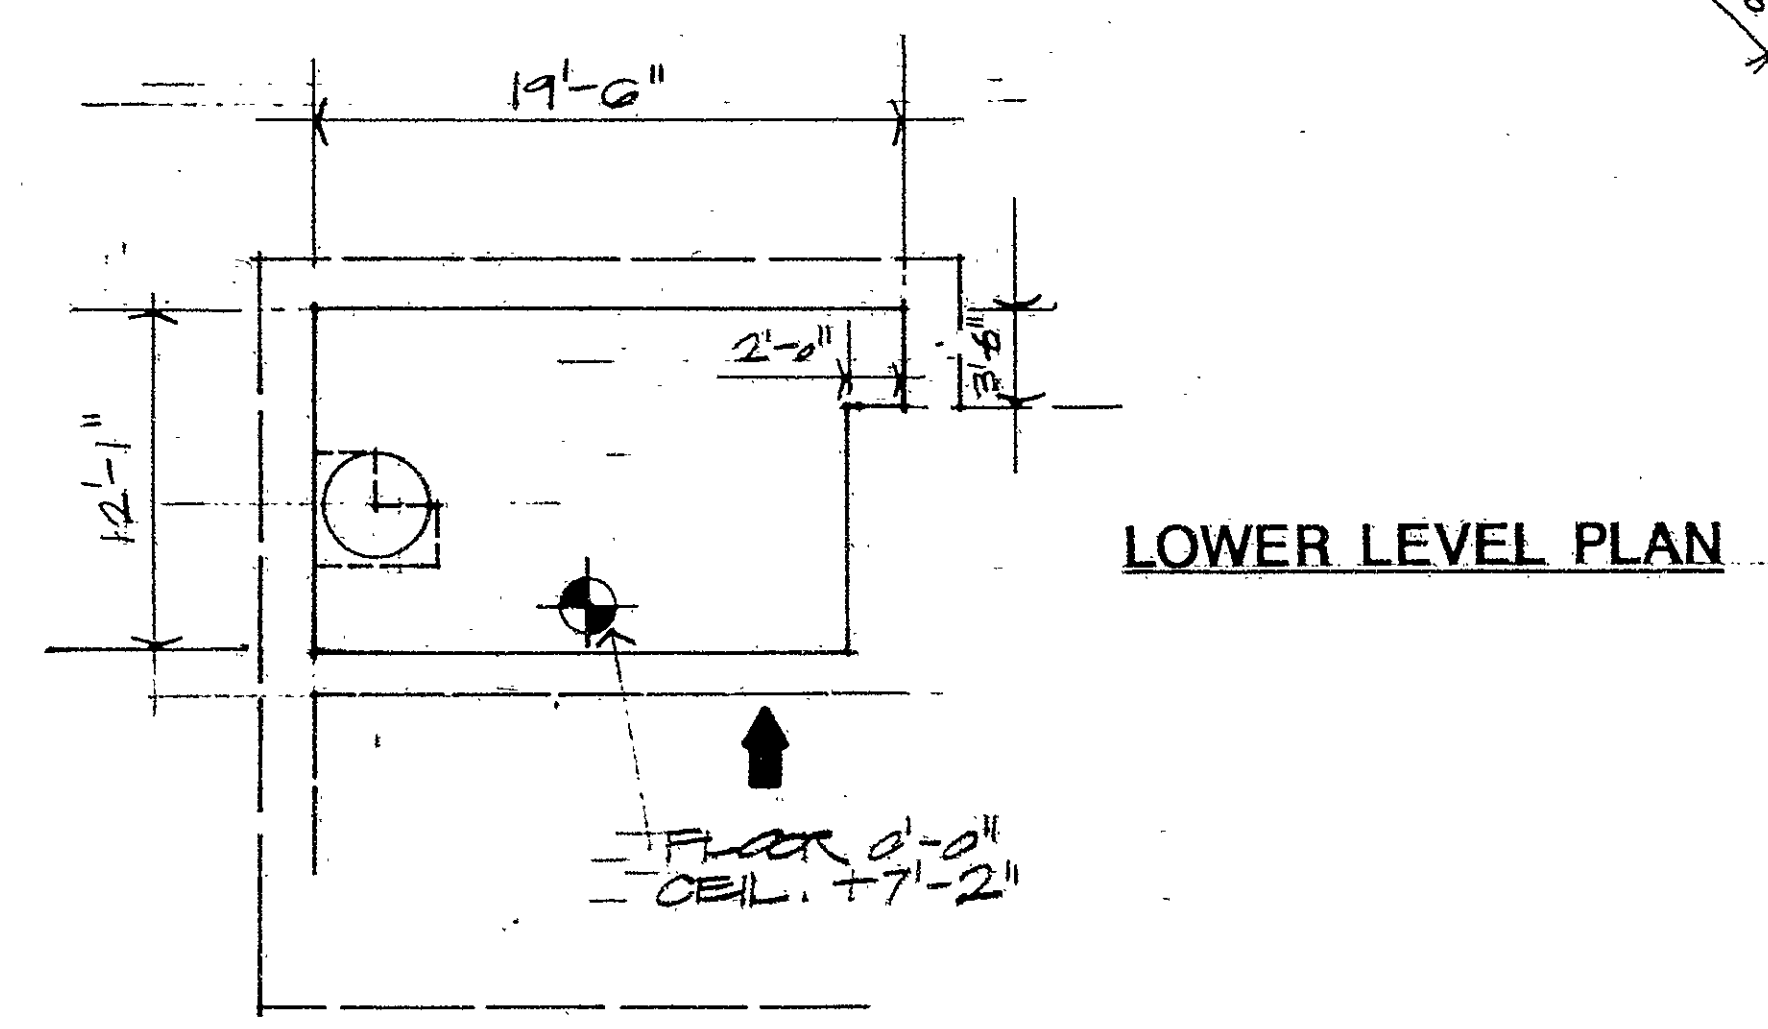

All elevations are referenced to finished floor at each level (0'-0"). All other elevations are ±(1'-0").


Certification
 The undersigned do hereby certify that to the best of his knowledge and belief these plans contain all information required by Connecticut General Statutes Section 47-228 relating to plans.

NOT RECORDED BY
 100 171 100

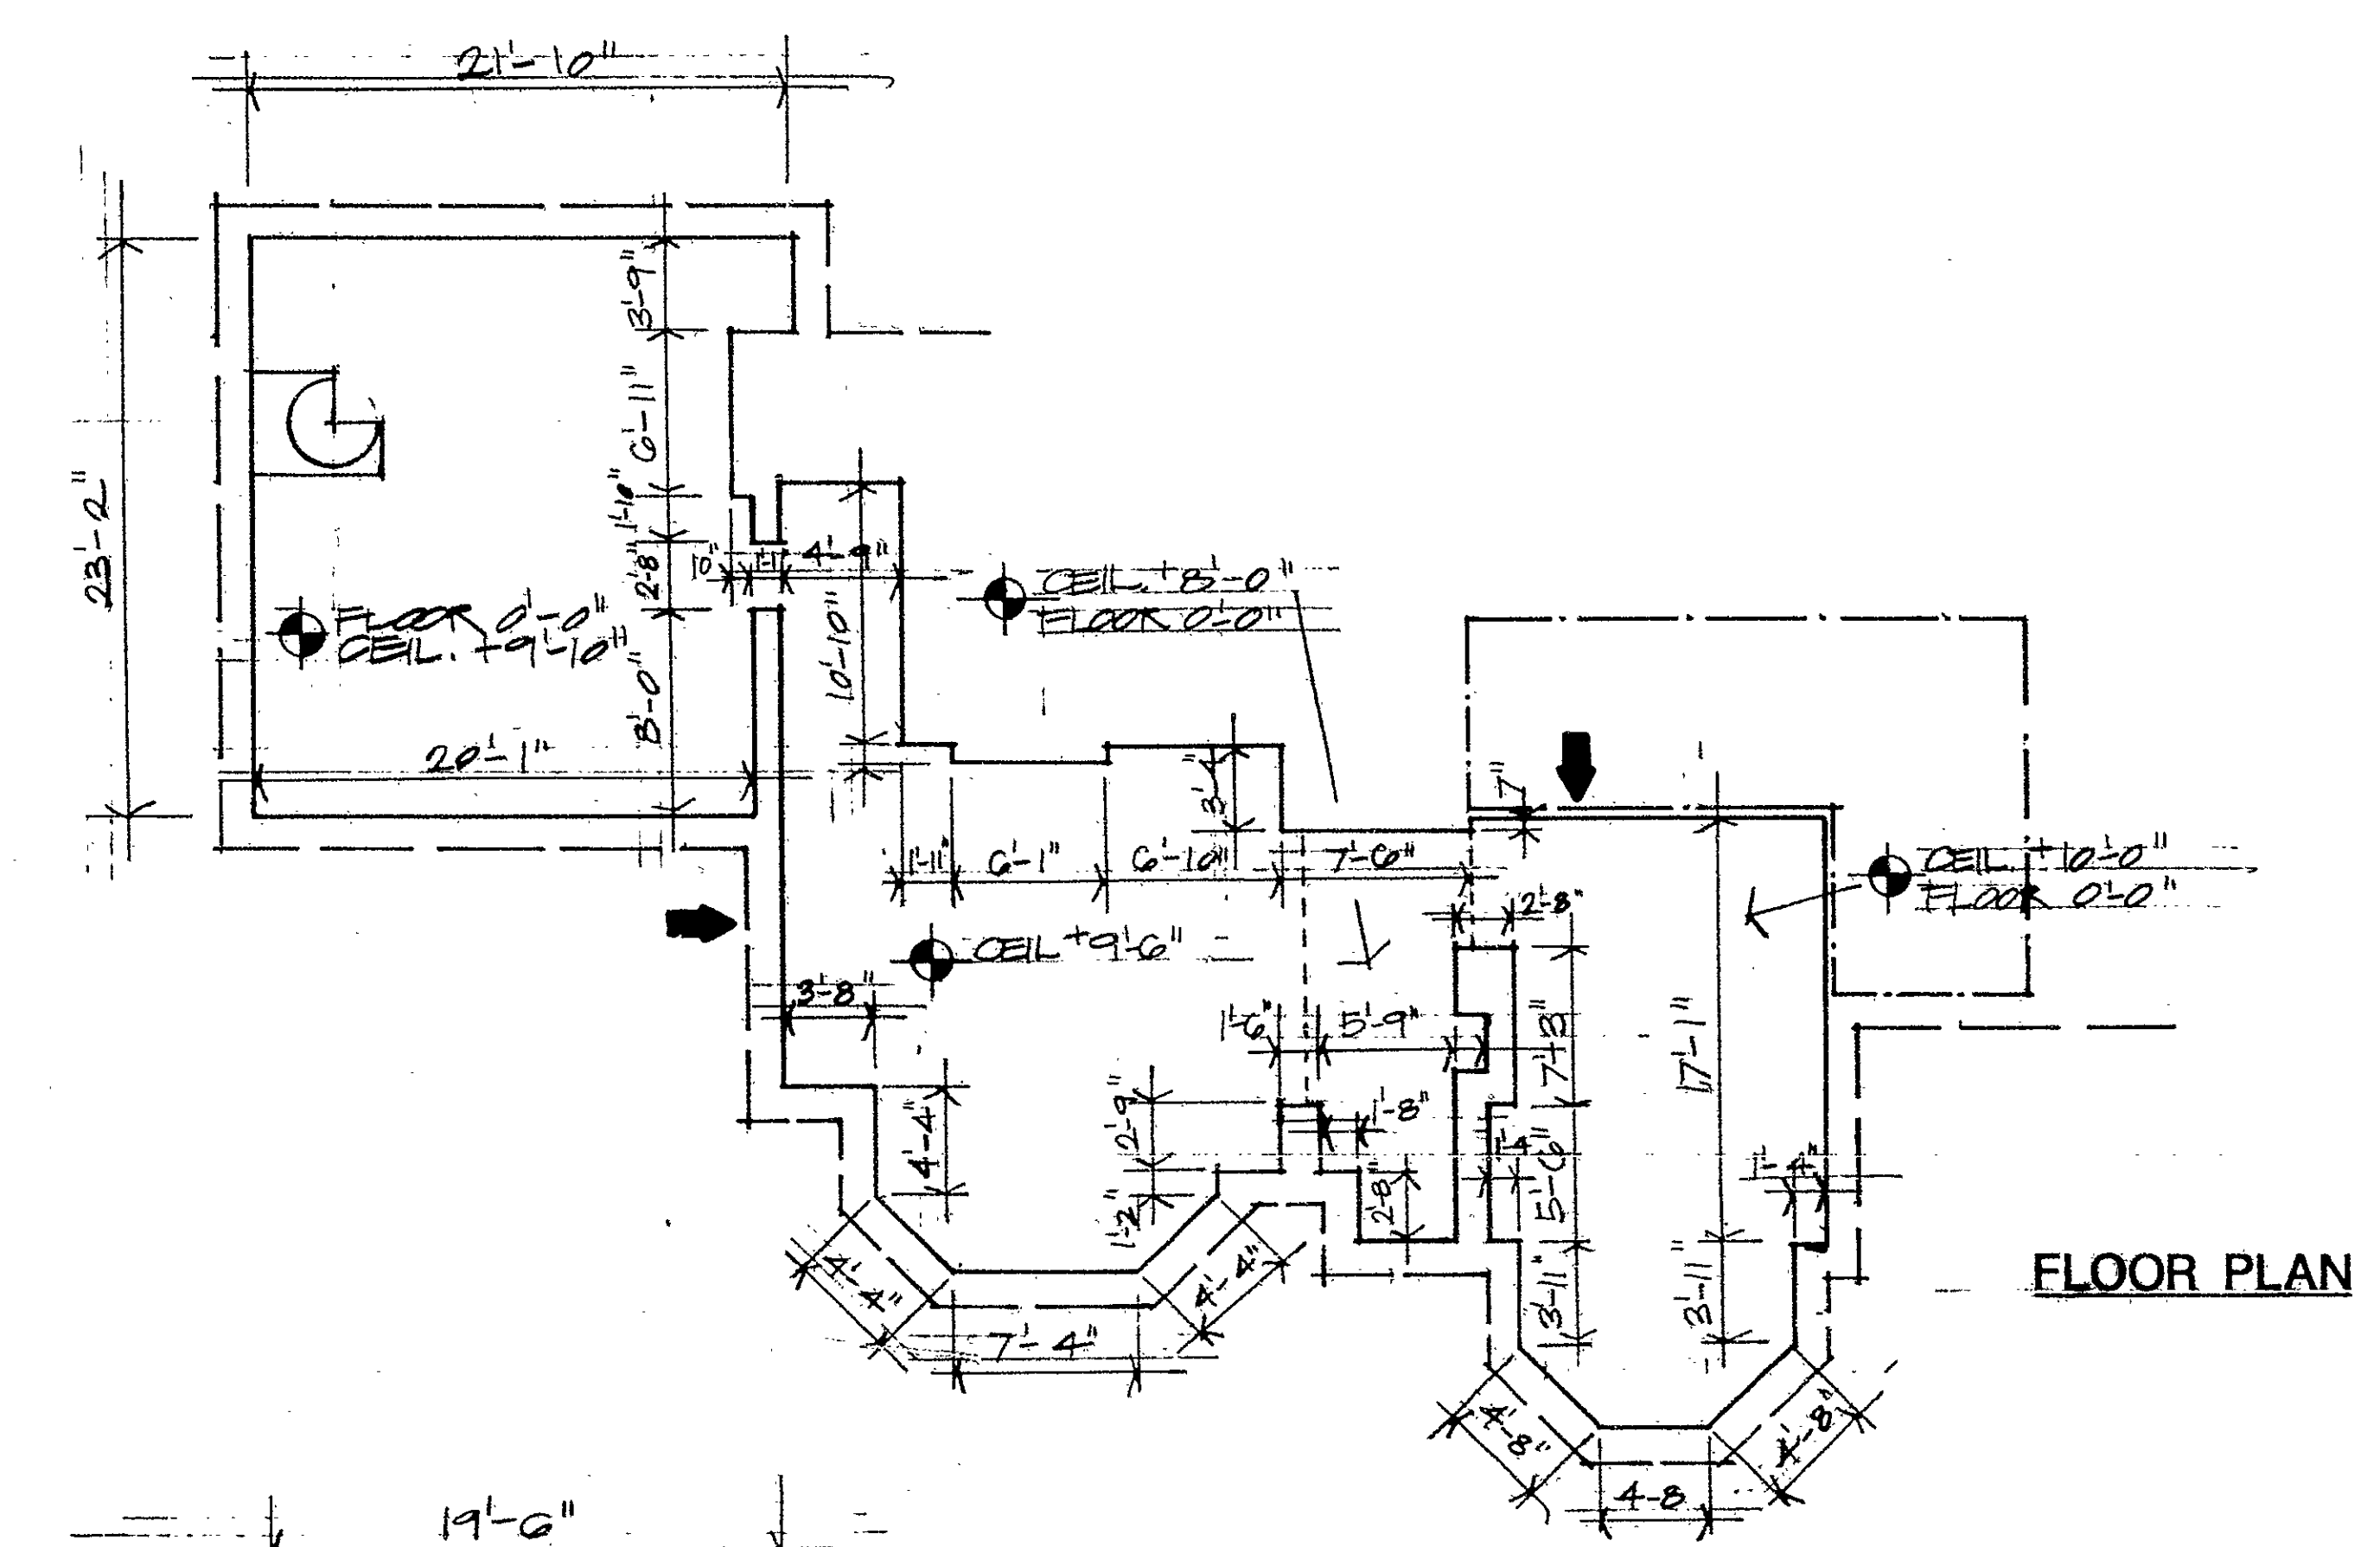

APPROX. SQUARE FOOTAGE = 1,132 SF



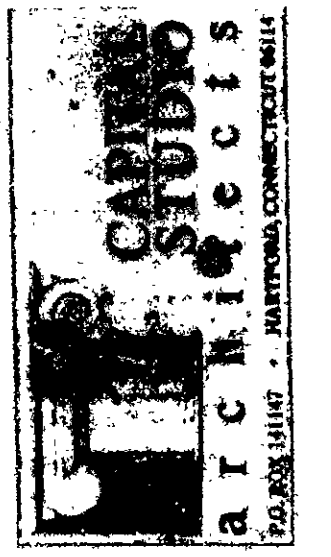

CONDOMINIUMS ON THE PLACE
RENÉ VEILLEUX
DECLARANT

LEGEND


- UNIT BOUNDARY
- EXT. SURFACE
- ELEV. CHANGE
- LTD. COMM. ELEM.
- CEIL.
- HGT. CHANGE
- SLOP.
- CEIL. ABOVE

UNIT **2**

SHEET **2**

0 2 4 8'

REF. NORTH

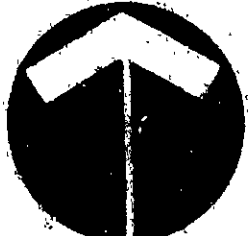

Condo 50100