


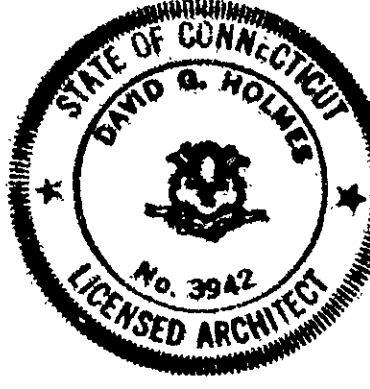


All elevations are referenced to finished floor at each level (0'-0"). All other elevations are +('_ - ").

Certification

The undersigned does hereby certify that to the best of his knowledge and belief these plans contain all information required by Connecticut General Statutes Section 47-228 relating to plans.

David G. Holmes

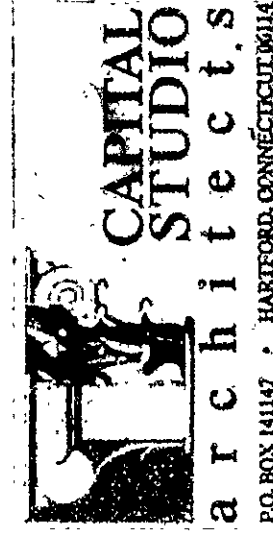


**CONDOMINIUMS ON THE PLACE
RÉNÉ VEILLEUX
DÉCLARANT**

LEGEND



_____	UNIT-BOUNDARY
_____	EXT. SURFACE
_____	ELEV. CHANGE
_____	LTD. COMM. ELEM.
_____	CEIL.
HGT. CHANGE	
	SLOP. CEIL. ABOVE

UNIT. 4

SHEET 4

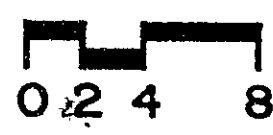

REF. NORTH

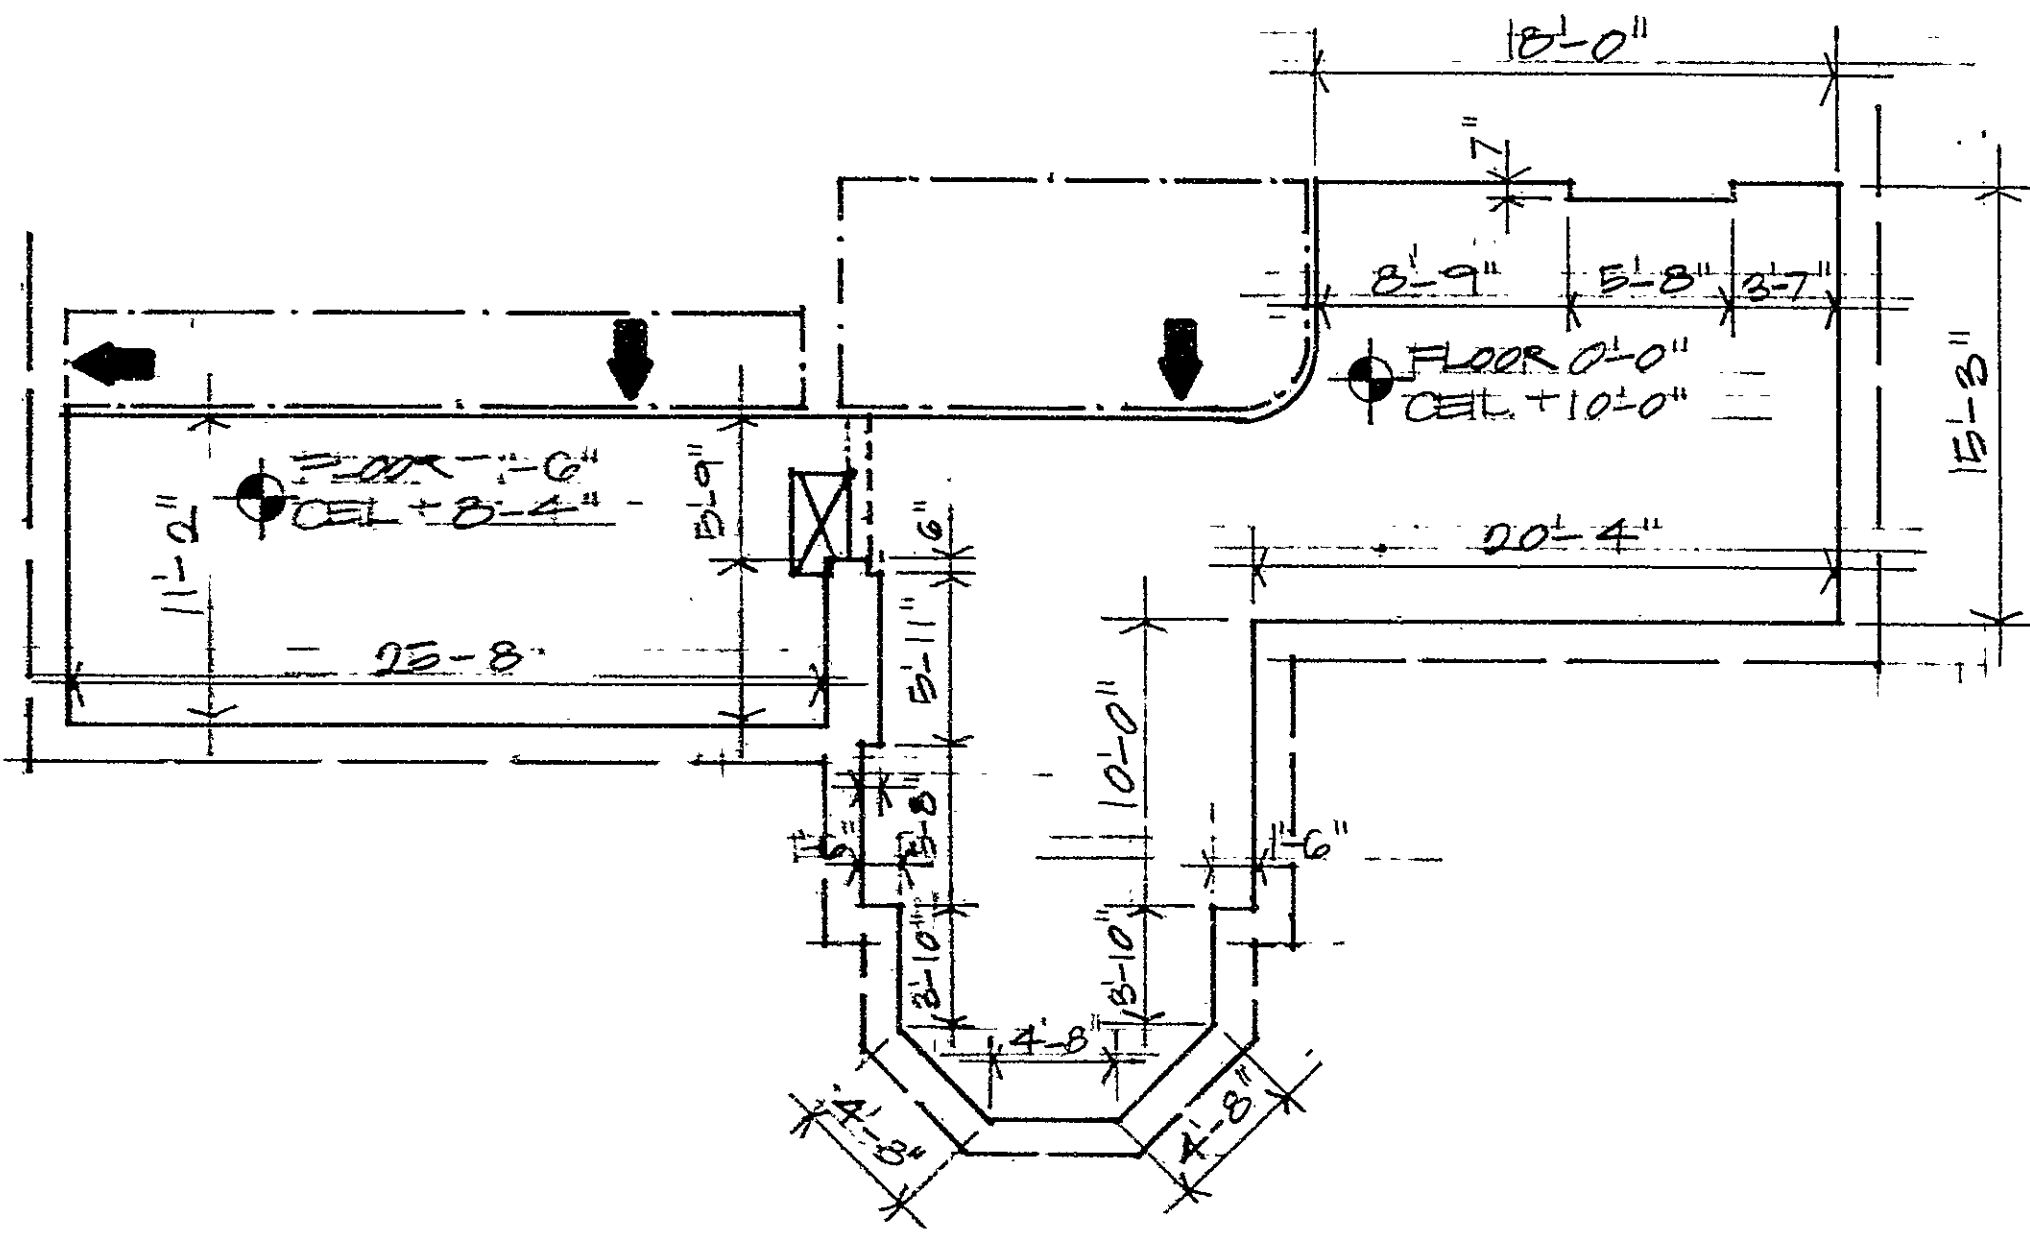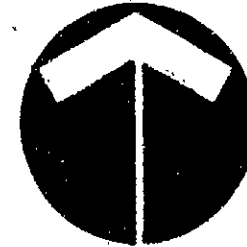

FLOOR PLAN

APPROX. SQUARE FOOTAGE- 2907 S.F.

