



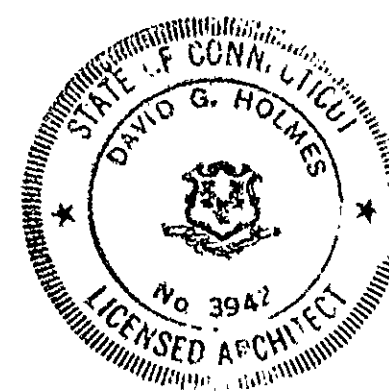


All elevations are referenced to finished floor at each level (0'-0"). All other elevations are $\pm$ (-' - ").

Certification
The undersigned does hereby certify that to the best of his knowledge and belief these plans contain all information required by Connecticut General Statutes Section 47-228 relating to plans.

David G. Holmes

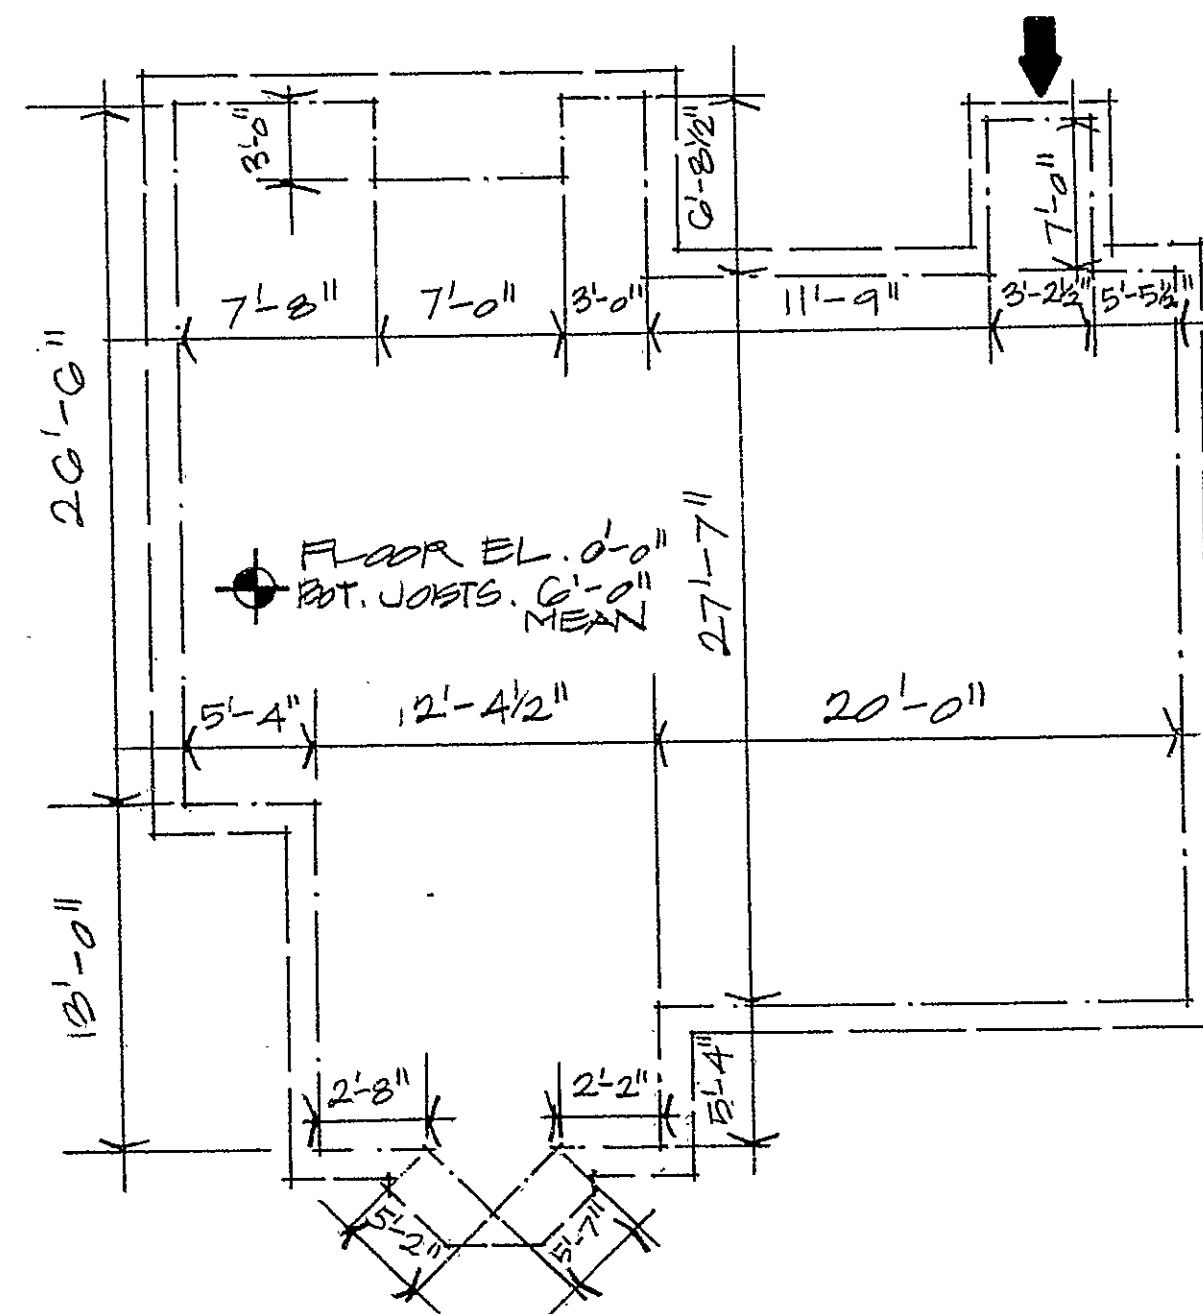

Basement

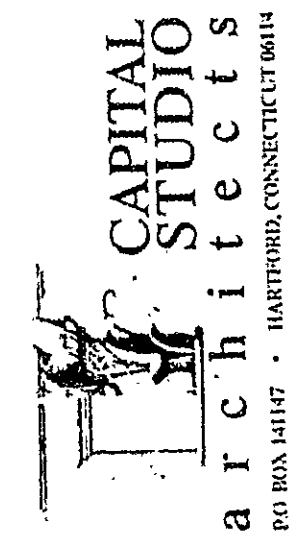

Congress Street
Condominium, Ltd.
Declarant

LEGEND
UNIT
BOUNDARY
EXT.
SURFACE
ELEV.
CHANGE
LTD.
COMM. ELEM.
CEIL.
HGT. CHANGE
SLOP.
CEIL. ABOVE

Sheet 3

A36A, A36B-LTD.
COMMON ELEM.

0 2 4 8'

REF. NORTH



NOT
RECEIVED BY
HAYLEND
LOCAL OFFICE
JUN 30 4 35 PM '88