


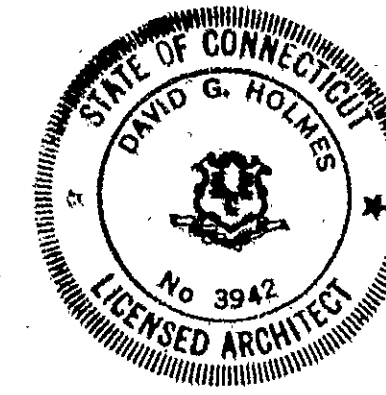


All elevations are
referenced to finished
floor at each level (0'-0").
All other elevations
are ±('- ").

Certification

The undersigned does hereby certify
that to the best of his knowledge
and belief these plans contain all
information required by Connecticut
General Statutes Section 47-228
relating to plans.

David G. Holmes

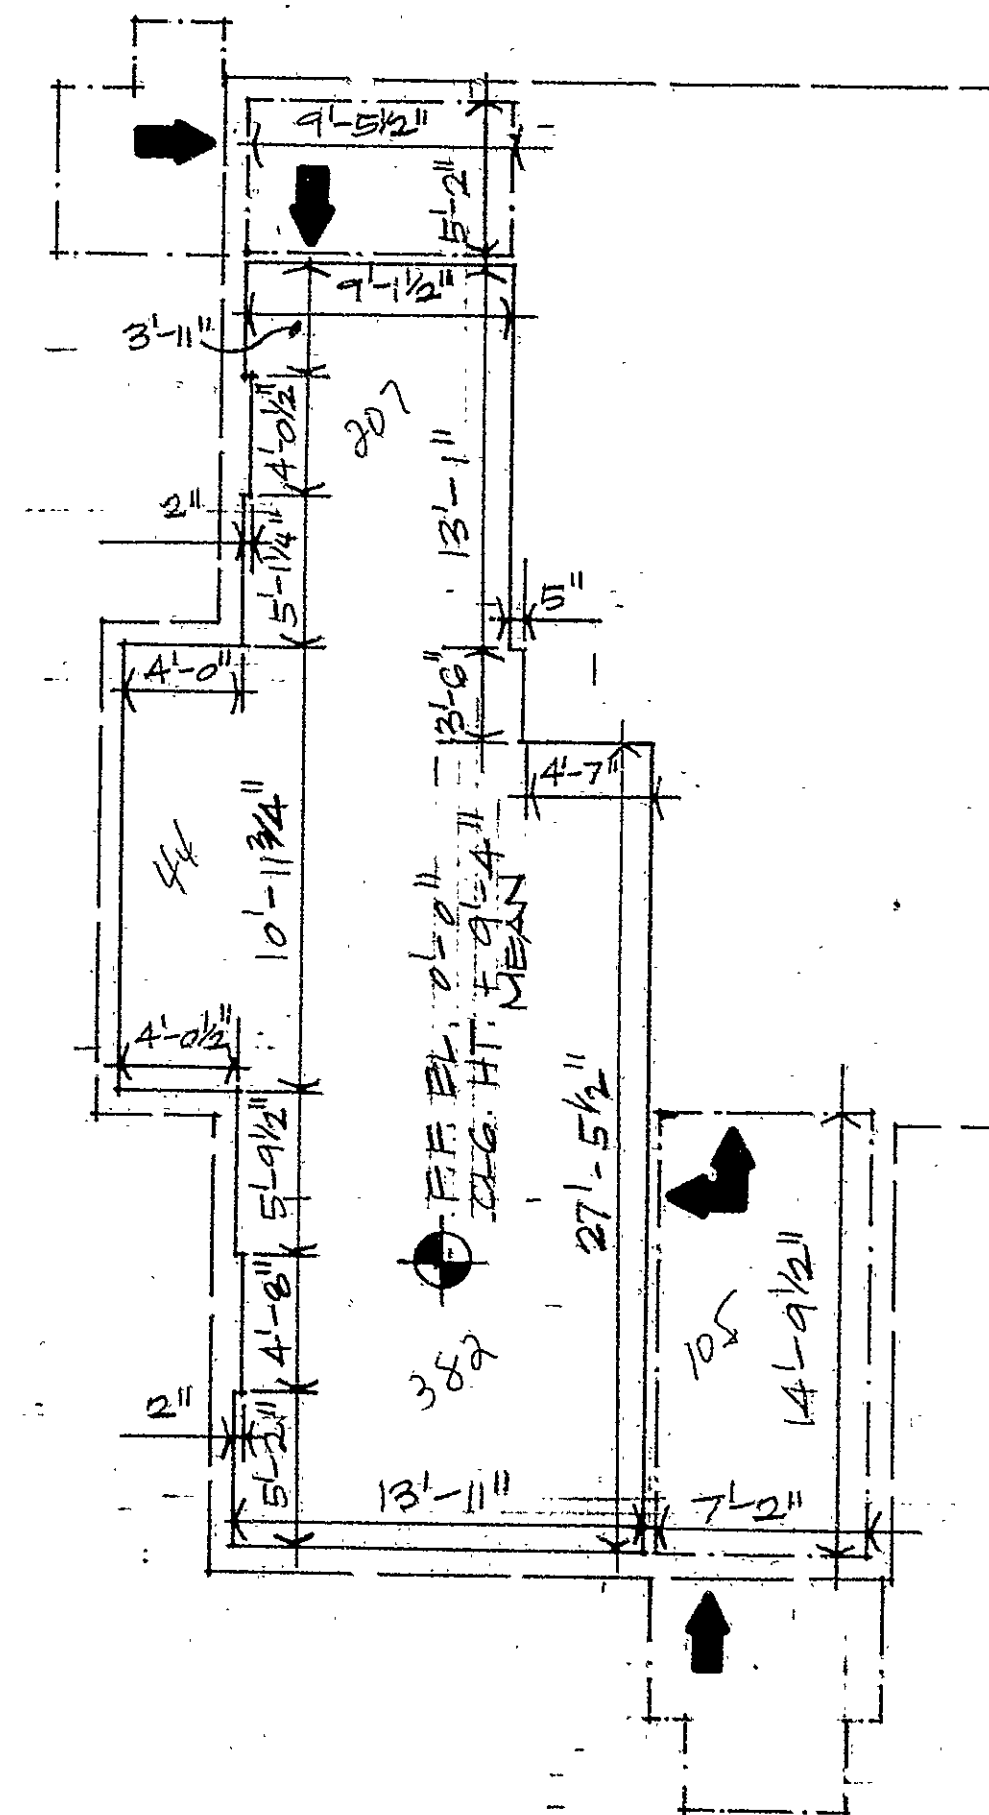

First Floor




Congress Street
Condominium, Ltd.
Declarant

LEGEND	
—	UNIT BOUNDARY
—	EXT. SURFACE
—	ELEV. CHANGE
—	LTD. COMM. ELEM.
—	CEIL.
—	HGT. CHANGE
—	SLOP. CEIL. ABOVE

Sheet #1

Unit A31a

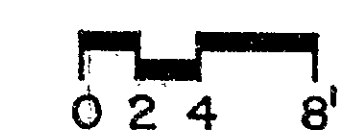

REF. NORTH

