

Certification

The undersigned does hereby certify that to the best of his knowledge and belief these plans contain all information required by Connecticut General Statutes Section 47-228 relating to plans.

relating to plans.

David G. Hansen



Congress Street
Condominium, Ltd.
Declarant

LEGEND


UNIT
BOUNDARY
EXT.
SURFACE
ELEV.
CHANGE
LTD.
COMM. ELEM.
CEIL.
HGT. CHANGE
 SLOP.
CEIL. ABOVE

Sheet #1

Unit A31b


REF. NORTH

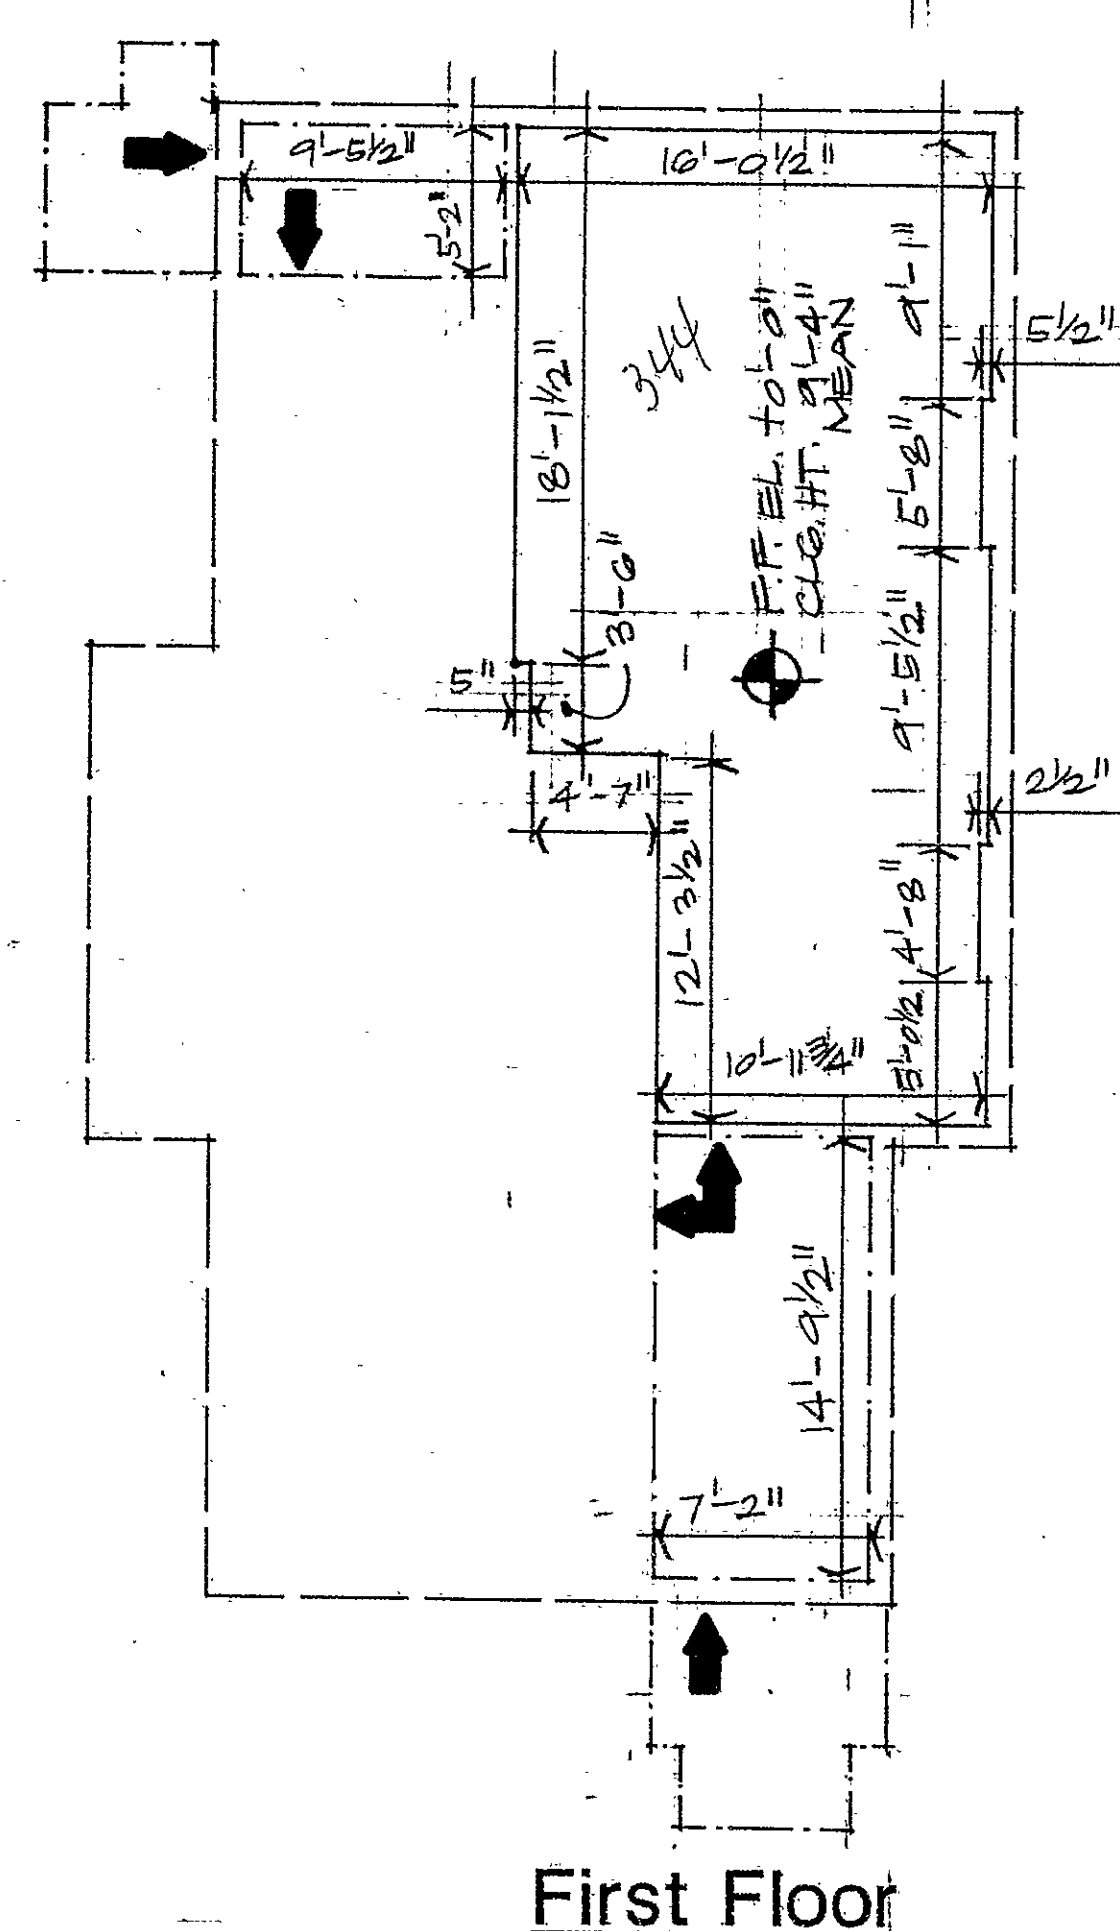

First Floor

RECEIVED SA

