



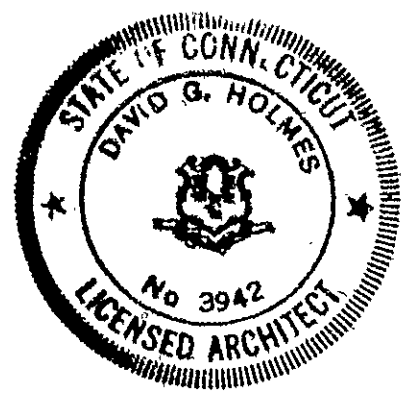

All elevations are referenced to finished floor at each level (0'-0"). All other elevations are ±('-'-").

Certification
The undersigned does hereby certify that to the best of his knowledge and belief these plans contain all information required by Connecticut General Statutes Section 47-228 relating to plans.
David G. Holmes

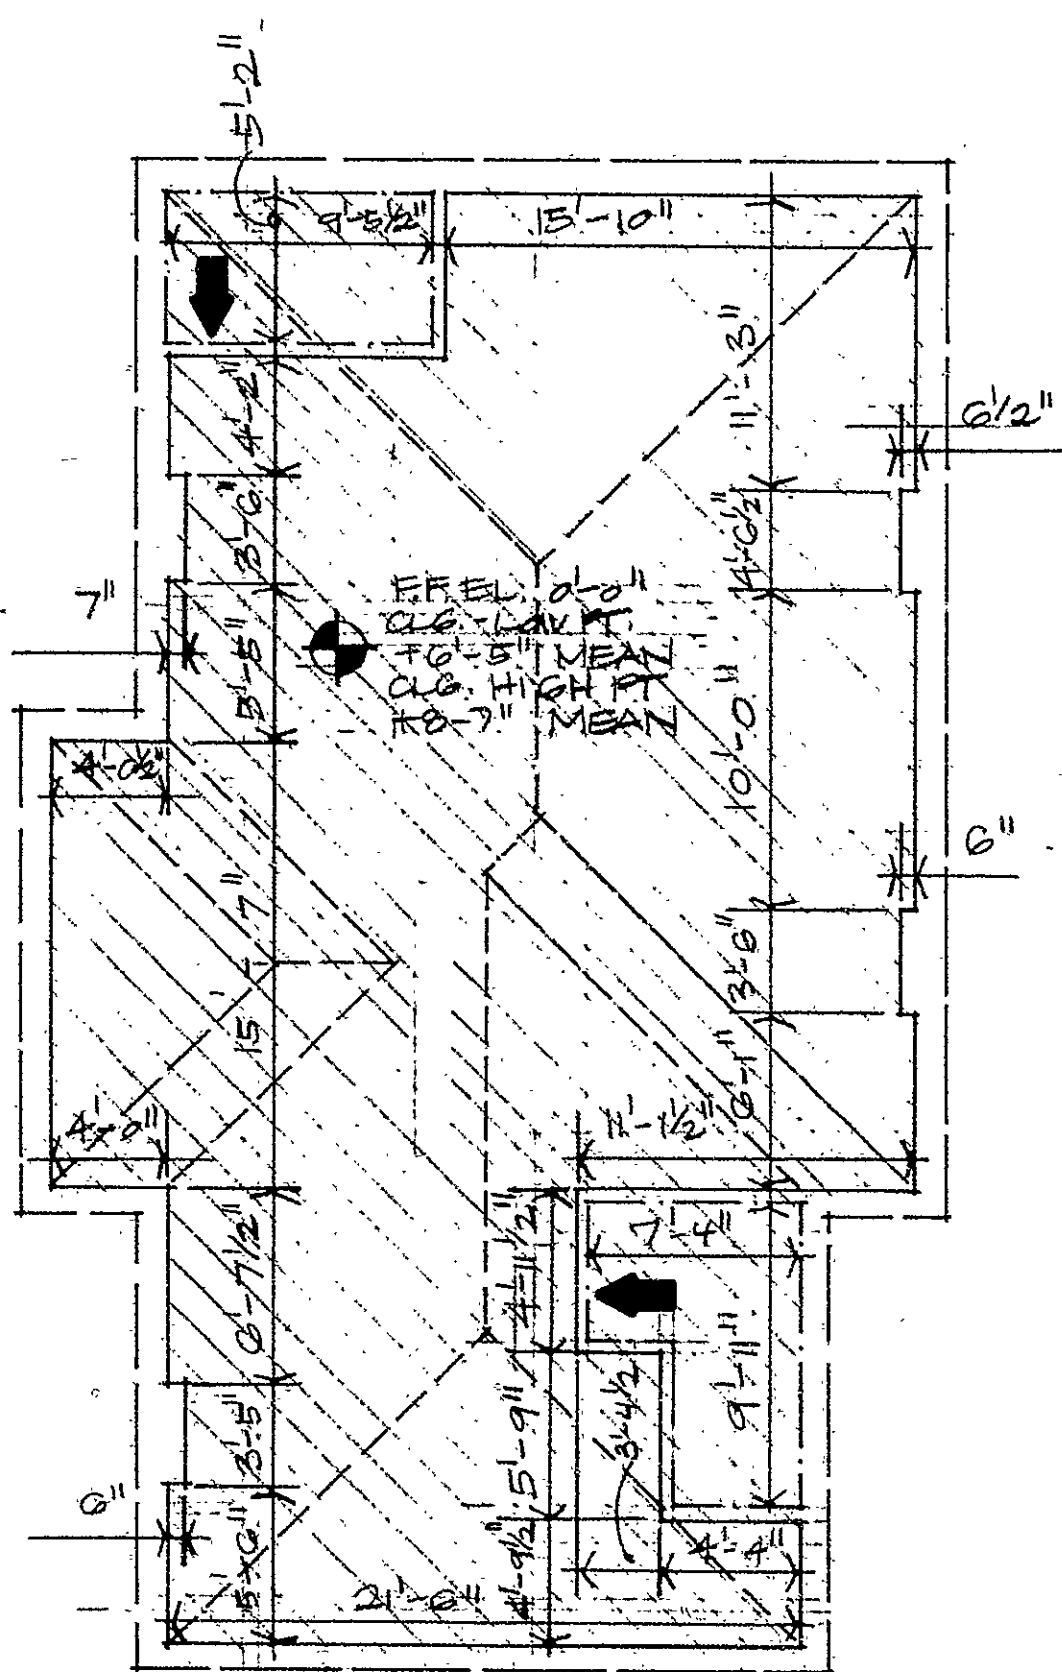

Third Floor



Congress Street
Condominium, Ltd.
Declarant

LEGEND
UNIT BOUNDARY
EXT. SURFACE
ELEV. CHANGE
LTD. COMM. ELEM.
CEIL.
HGT. CHANGE
SLOP. CEIL. ABOVE

Sheet #1

Unit A31d

0 2 4 8'

REF. NORTH

