



EASI FILE CORP. IRVINE, CA		ETH 34
102		

1	0	2	-	4
---	---	---	---	---

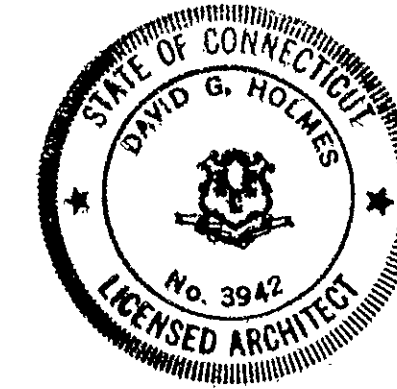


All elevations are referenced to finished floor at each level (0'-0"). All other elevations are ±('- ").

Certification
The undersigned does hereby certify that to the best of his knowledge and belief these plans contain all information required by Connecticut General Statutes Section 47-228 relating to plans.
David G. Holmes

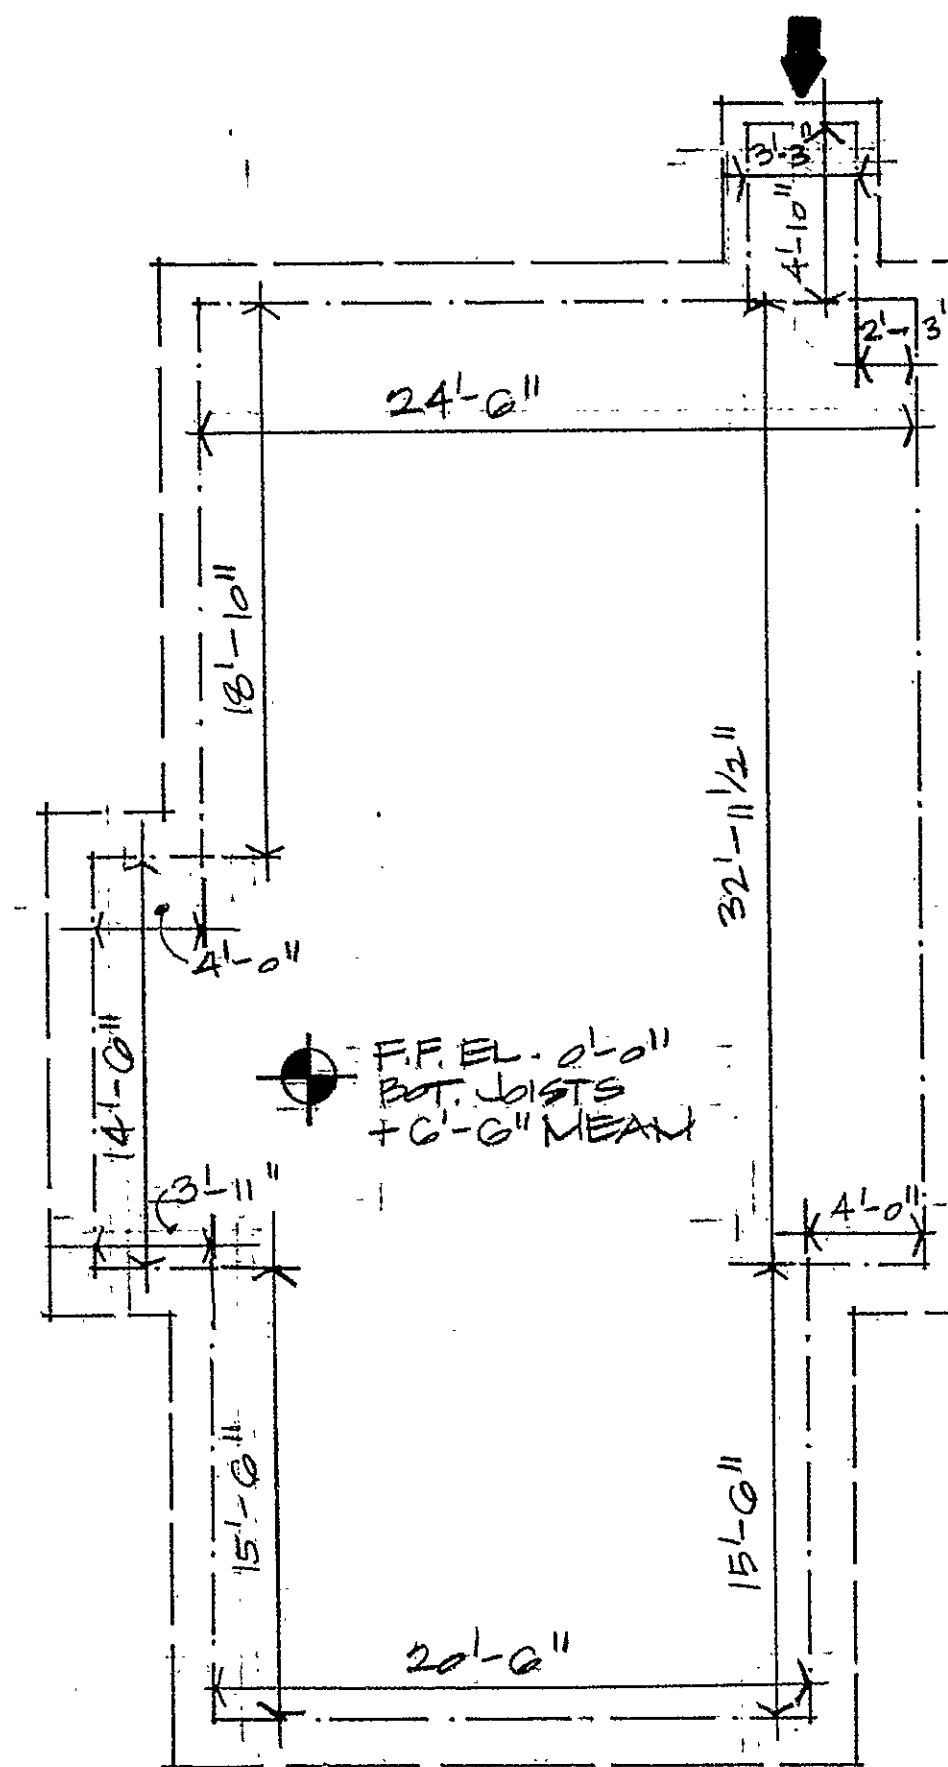

Basement

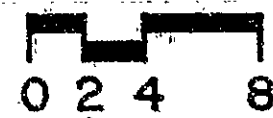 CAPITAL STUDIO architects P.O. Box 141147 • Hartford, Connecticut 06114
Congress Street Condominium, Ltd. Declarant
LEGEND — UNIT BOUNDARY — EXT. SURFACE — ELEV. CHANGE — LTD. COMM. ELEM. — CEIL. HGT. CHANGE ▨ SLOP. CEIL. ABOVE
Sheet #1 UNITS A31a,b,c,d Ltd. Common Element
 REF. NORTH 



RECEIVED BY
10/11/01
10/11/01