



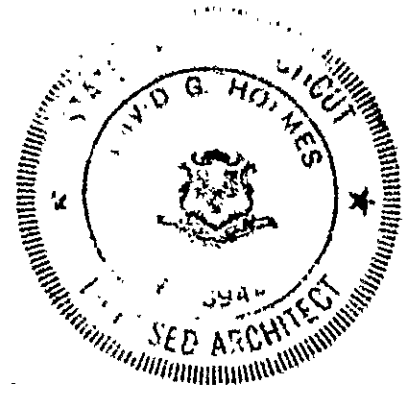


All elevations are referenced to finished floor at each level (0'-0"). All other elevations are ± ("'-").

Certification

The undersigned does hereby certify that to the best of his knowledge and belief these plans contain all information required by Connecticut General Statutes Section 47-228 relating to plans.

David G. Holmes

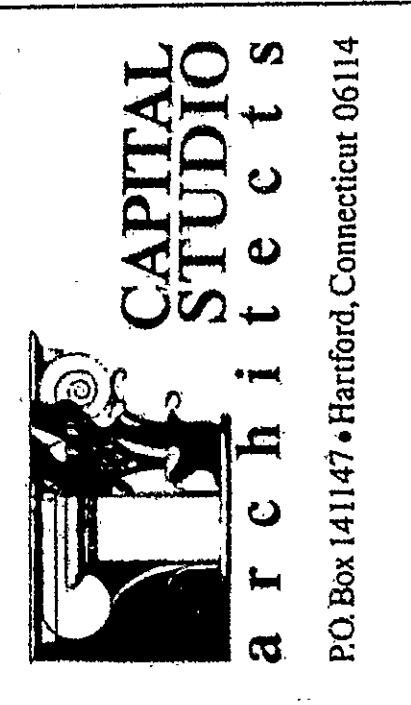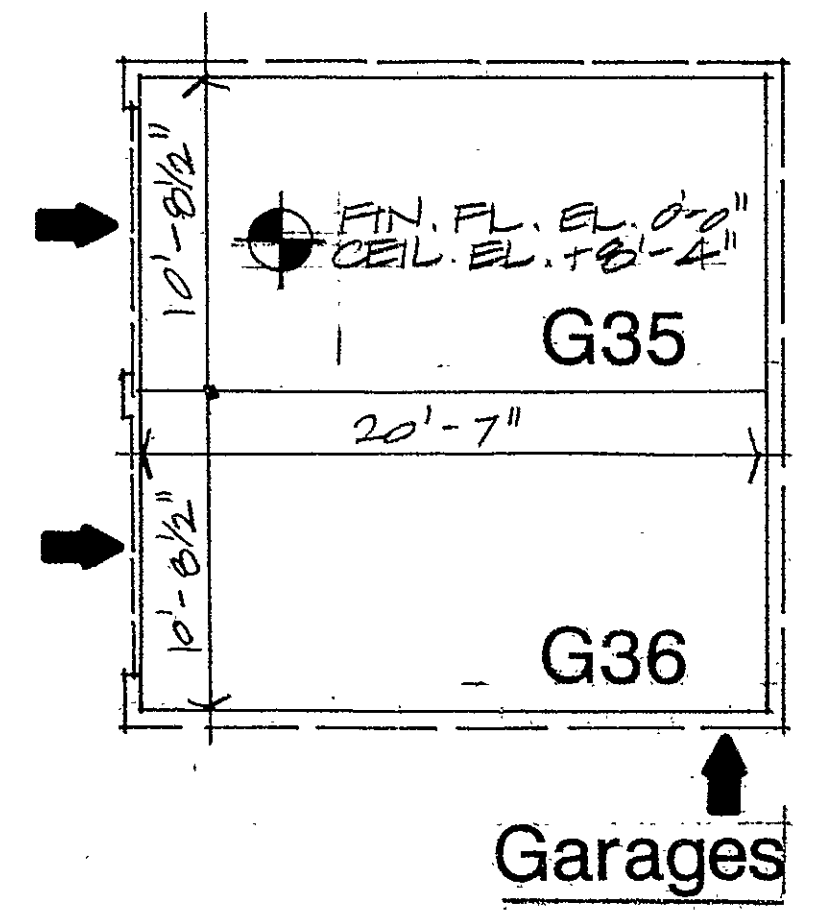


Congress Street
Condominium, Ltd.
Declarant

- LEGEND
- UNIT BOUNDARY
 - EXT. SURFACE
 - ELEV. CHANGE
 - LTD. COMM. ELEM.
 - CEIL.
 - HGT. CHANGE
 - SLOP.
 - CEIL. ABOVE

Sheet #1

G35 & G36

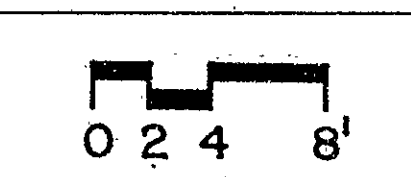

REF. NORTH

