





All elevations are referenced to finished floor at each level (0'-0"). All other elevations are ±(_'- _").

Certification
 The undersigned does hereby certify that to the best of his knowledge and belief these plans contain all information required by Connecticut General Statutes Section 47-228 relating to plans.
David G. Holman

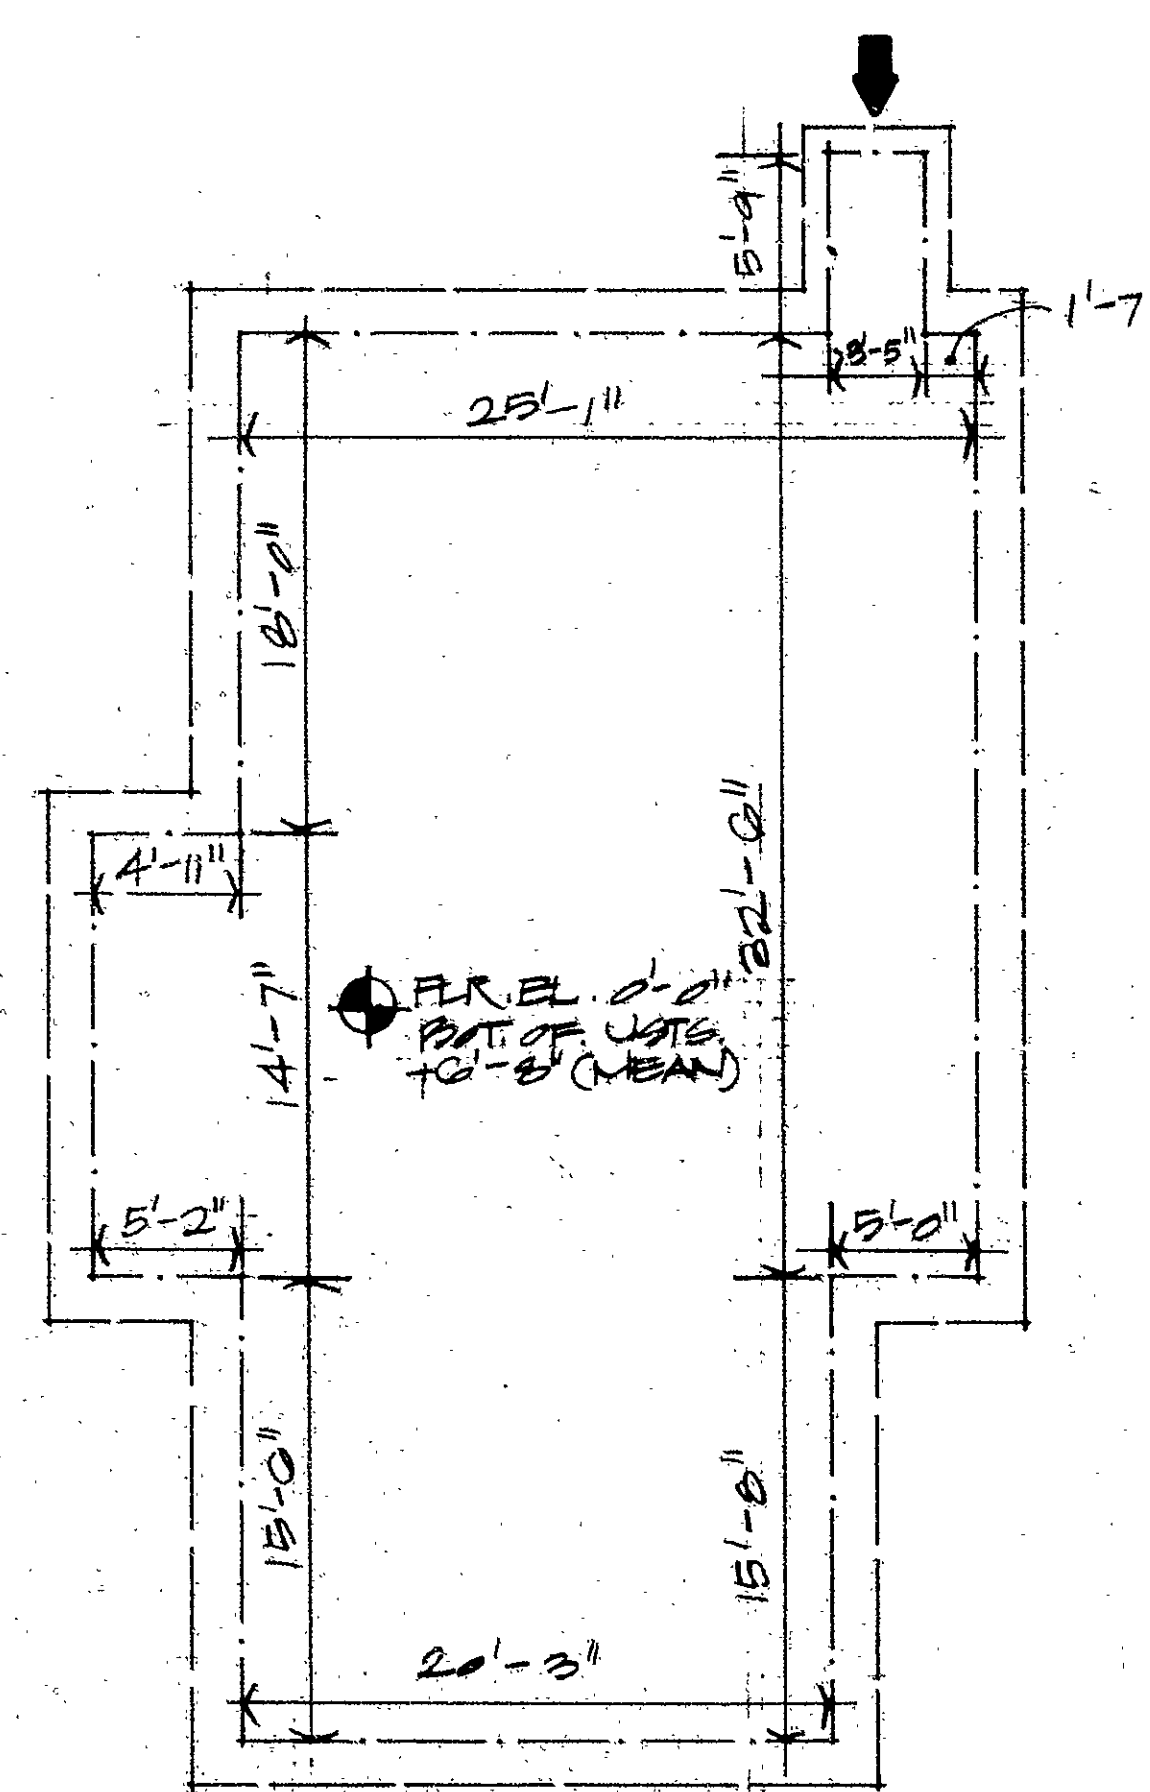

Basement

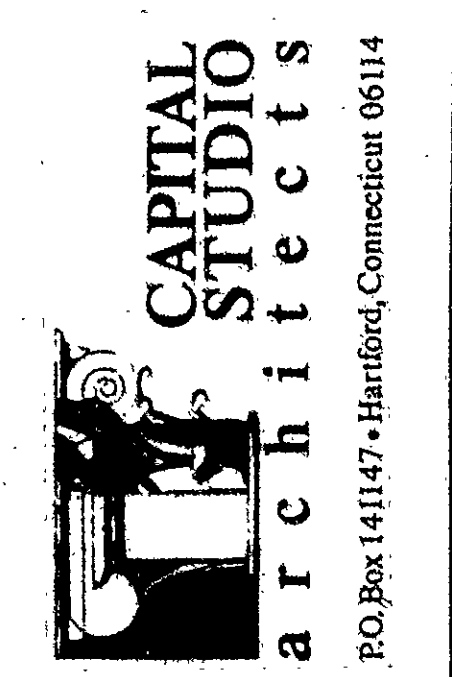


**Congress Street
 Condominium, Ltd.
 Declarant**

LEGEND



---	UNIT
---	BOUNDARY
---	EXT. SURFACE
---	ELEV. CHANGE
---	LTD. COMM. ELEM.
---	CEIL. HGT. CHANGE
---	SLOP. CEIL. ABOVE

Sheet #1

UNITS A43a, b, c, d
 Ltd. Common Element

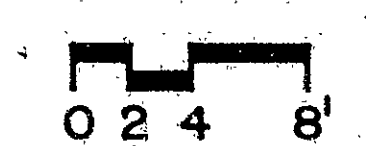

REF. NORTH

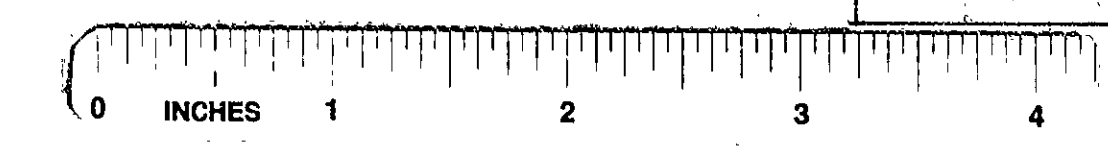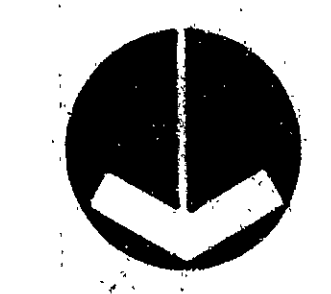

NOTED
 10-22-81
 11-11-81
 RECHECKED RA