


EASI FILE CORR. IRVINE, CA EFW 34
102

102-8

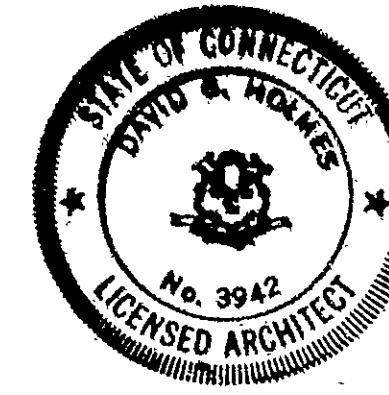


All elevations are
referenced to finished
floor at each level (0'-0").
All other elevations
are ±(_'- _").


Certification

The undersigned does hereby certify
that to the best of his knowledge
and belief these plans contain all
information required by Connecticut
General Statutes Section 47-228
relating to plans.

David G. Hume

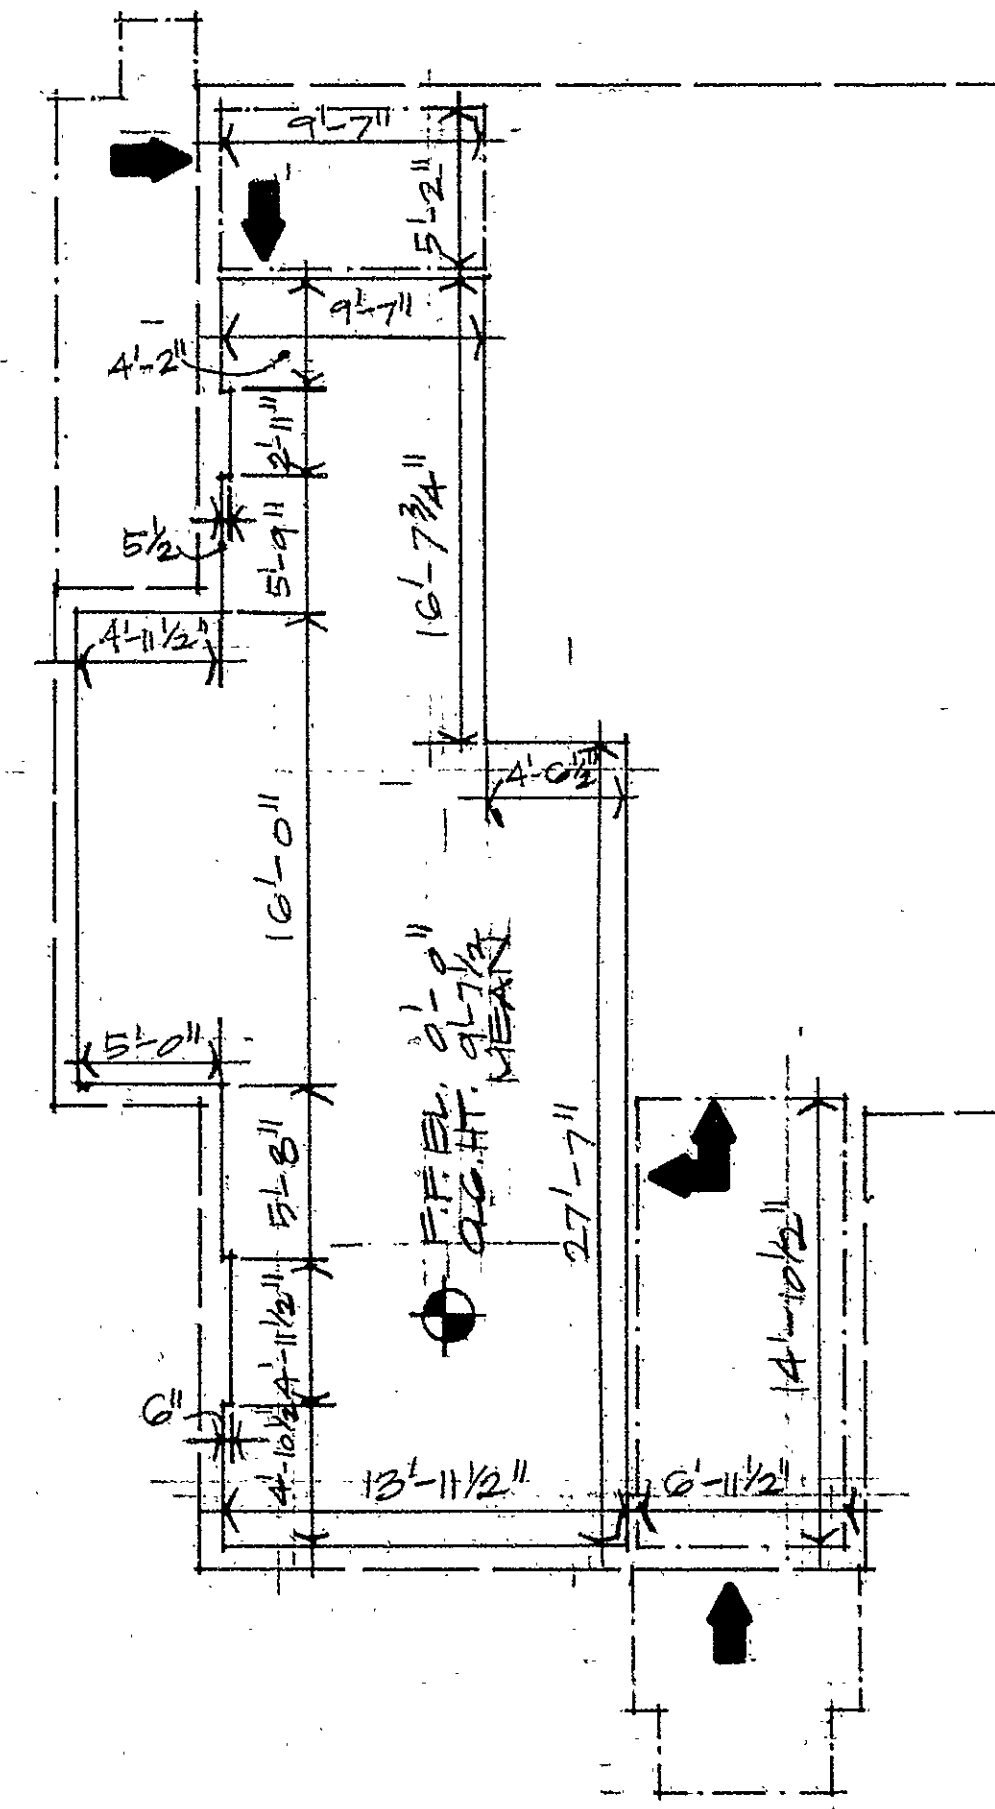

First Floor

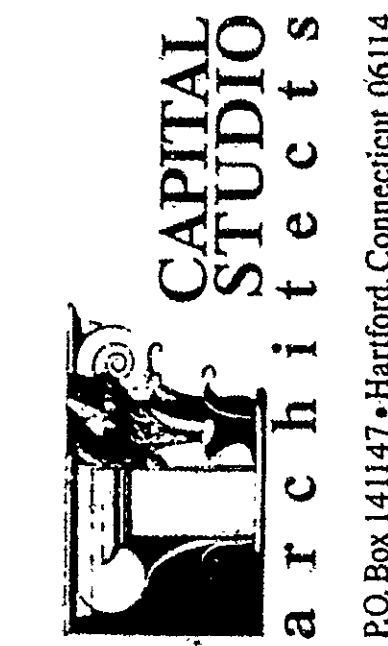

Congress Street
Condominium, Ltd.
Declarant

LEGEND


UNIT
BOUNDARY
EXT.
SURFACE
ELEV.
CHANGE
LTD.
COMM. ELEM.
CEIL.
HGT. CHANGE
SLOP.
CEIL. ABOVE

Sheet #1

Unit A43a

0 2 4 8'

REF. NORTH

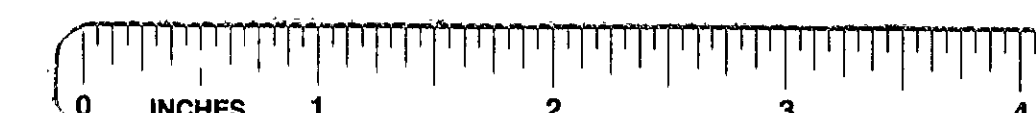

RECEIVED BY
11 11 11
11 11 11
11 11 11

Area # 102