


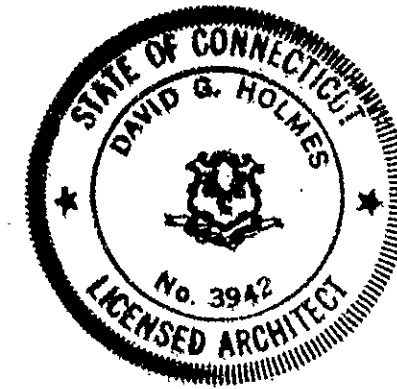


All elevations are referenced to finished floor at each level (0'-0"). All other elevations are $\pm$ ('-"-").

Certification

The undersigned does hereby certify that to the best of his knowledge and belief these plans contain all information required by Connecticut General Statutes Section 47-228 relating to plans.

David G. Holmes

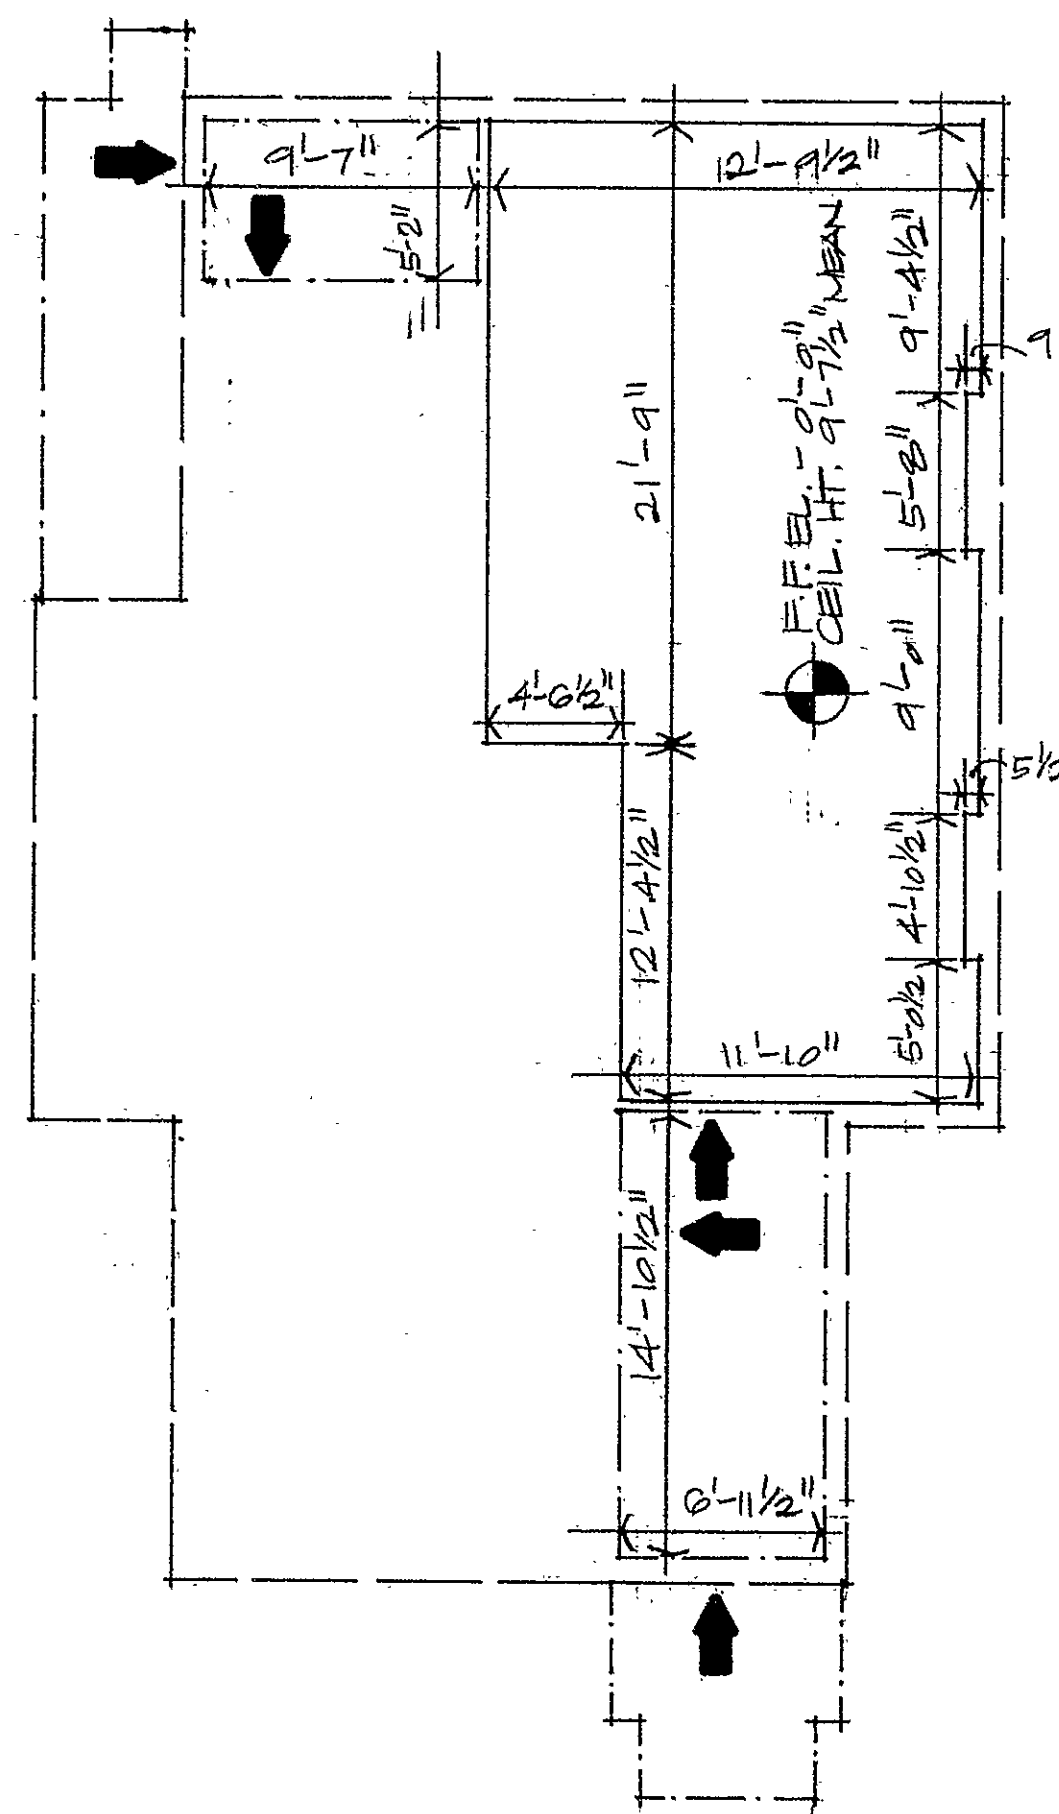

First Floor




Congress Street
Condominium, Ltd.
Declarant


LEGEND
UNIT
BOUNDARY
EXT.
SURFACE
ELEV.
CHANGE
LTD.
COMM. ELEM.
CEIL.
HGT. CHANGE
SLOP.
CEIL. ABOVE

Sheet #1

Unit A43b

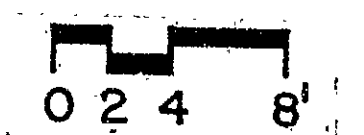

REF. NORTH

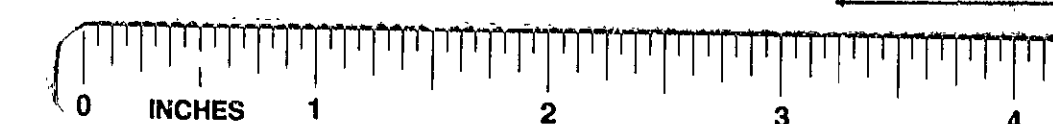

RECEIVED BY
DATE
10/17/11
11:17 AM
10/17/11
11:17 AM
10/17/11
11:17 AM