


Certification

The undersigned does hereby certify that to the best of his knowledge and belief these plans contain all information required by Connecticut General Statutes Section 47-228 relating to plans.

David J. Hoban

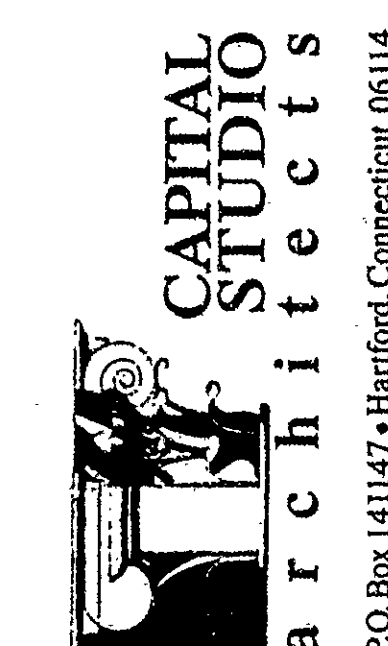

Congress Street
Condominium, Ltd.
Declarant

LEGEND

_____ UNIT
BOUNDARY

_____ EXT.
SURFACE

_____ ELEV.
CHANGE

_____ LTD.
COMM. ELEM.

_____ CEIL.

HGT. CHANGE

 SLOP.


CEIL. ABOVE

Sheet #1

Unit A43c


REF. NORTH

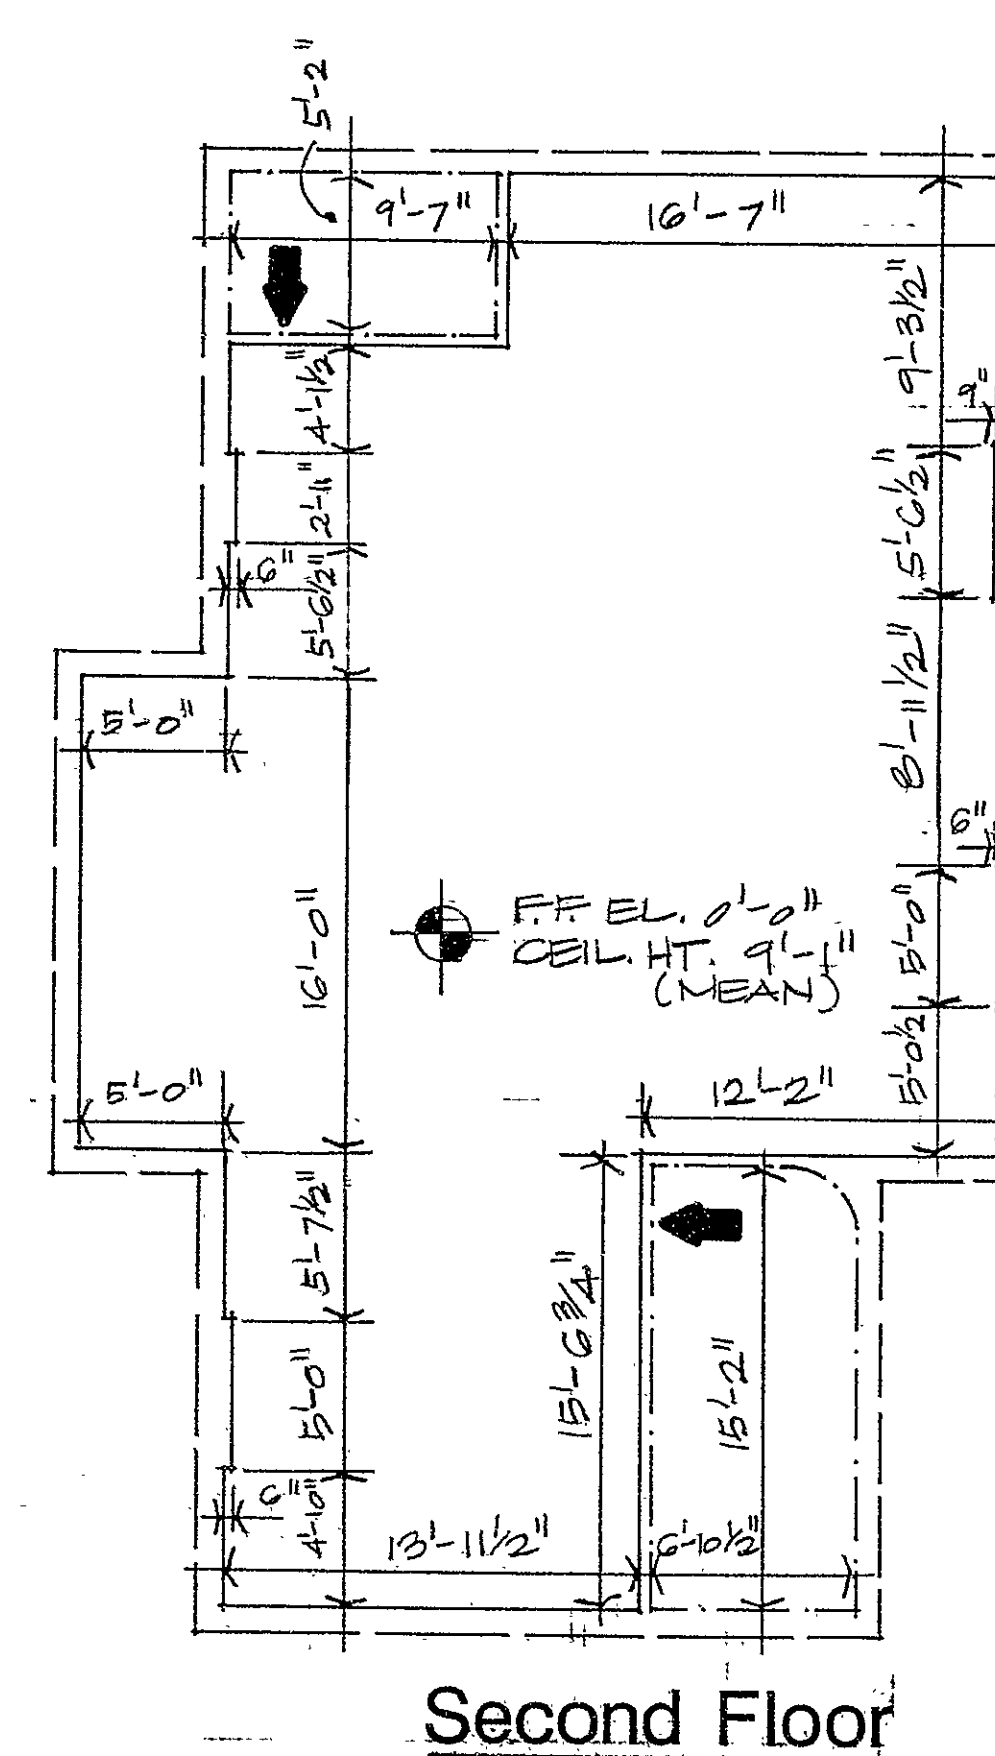

RECEIVED BA

